

# CREUS Engineering

Civil Engineers & Project Managers  
 SUITE 200-901 16TH ST WEST, NORTH VANCOUVER BC, V7P1R2  
 PH: 604-987-9070 WEBSITE: www.creus.ca


**PROJECT:**

## THE RIDGE AT PEMBERTON PHASE 1 OFFSITE SEWER & WATER

### PEMBERTON, BC

**CLIENT:**



## 580049 BC LTD.

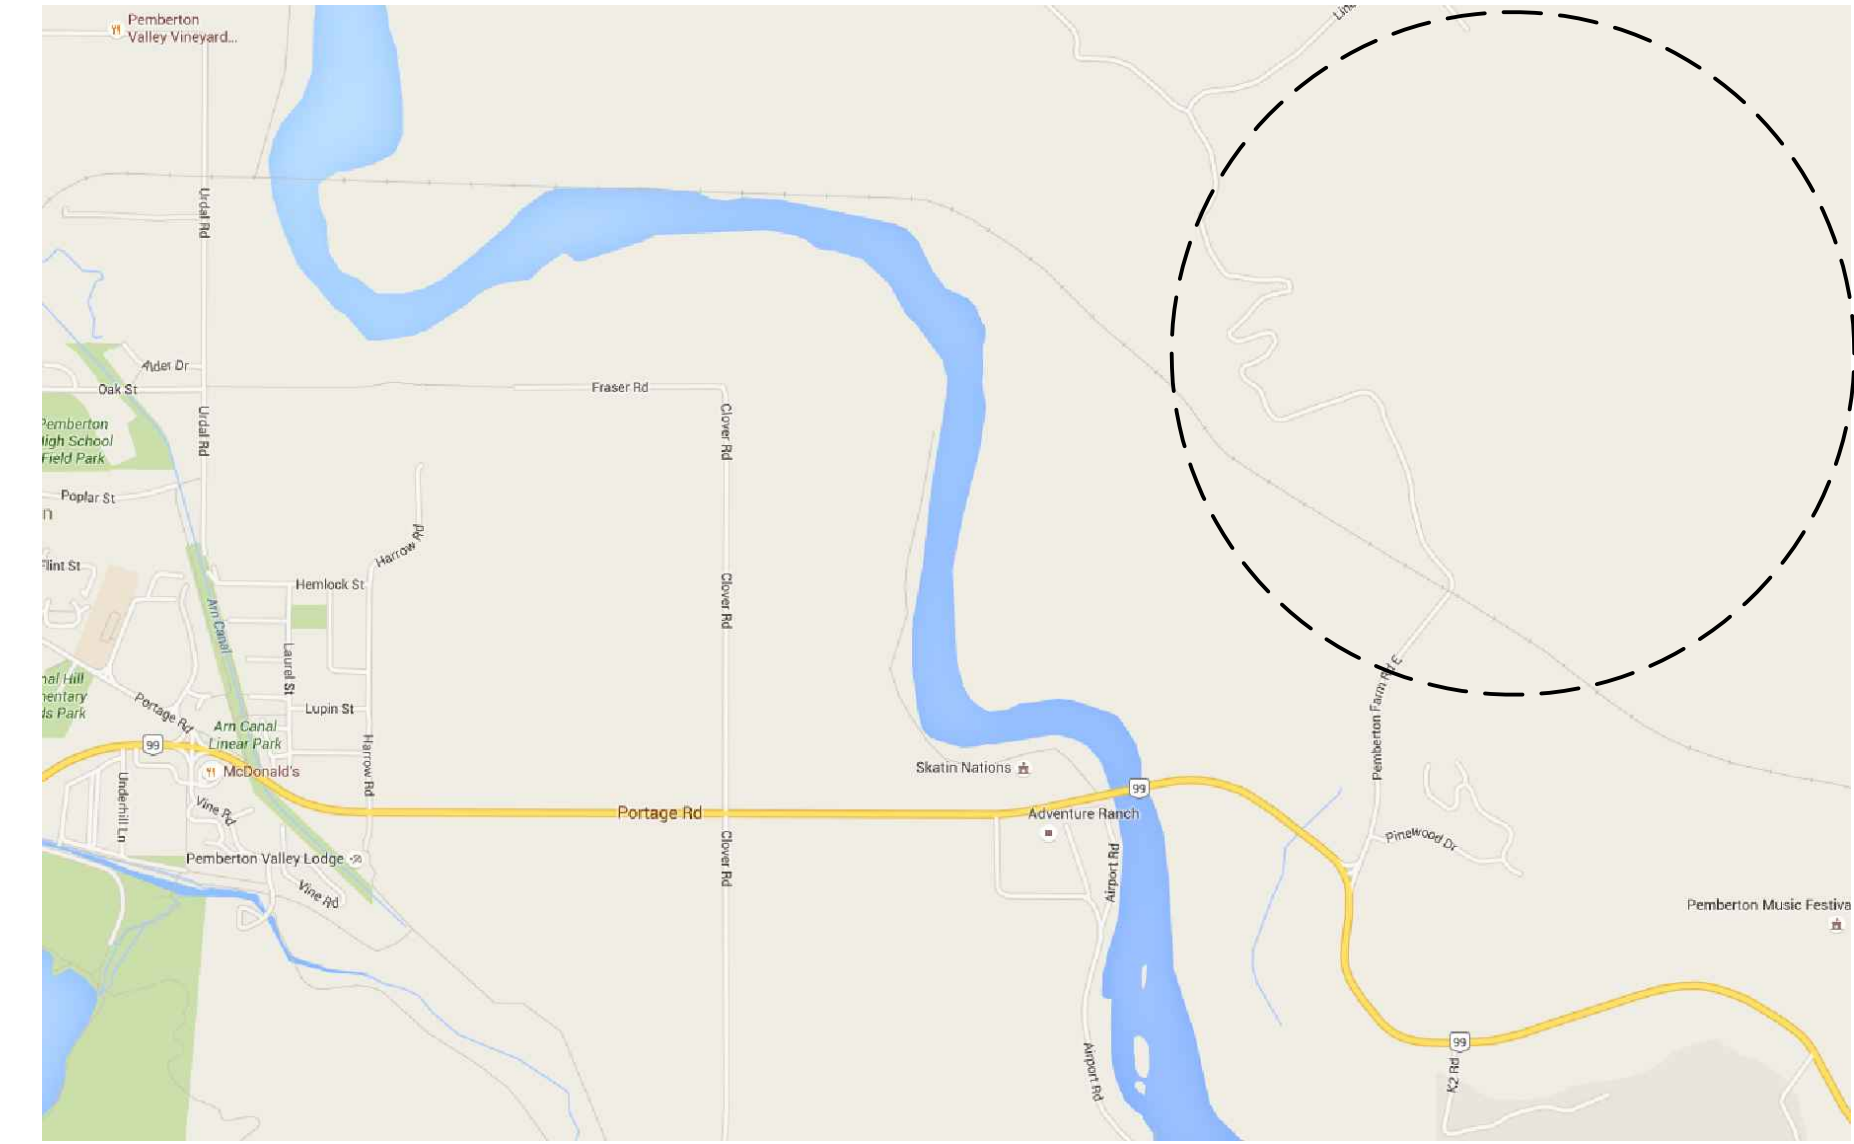

DRAWING LIST			
DWG NO.			REVISION
KEY-1	KEY PLAN		29
KEY-2	KEY PLAN	PHASE 1	28
SMP-2	STORMWATER MANAGMENT	WEIR	4
R-A-1	ROADWORKS	ROAD A (STA 0+100-0+310)	18
R-OS-1	ROADWORKS	OFFSITE ROAD (STA 0+100-0+310)	15
R-OS-2	ROADWORKS	OFFSITE ROAD (STA 0+300-0+630)	14
R-OS-3	ROADWORKS	OFFSITE ROAD (STA 0+540-0+700)	2
LP-2	SIGNAGE & LINE PAINTING	OFFSITE	10
CN-1-A	ROADWORKS	CN RAIL CROSSING	14
CN-1-B	ROADWORKS	CN RAIL CROSSING	14
CN-2	CN RAL CROSSING	WATER CROSSING	11
CN-3	CN RAIL CROSSING	SANITARY CROSSING	10
D-2	STORMWORKS	LANE 1 TO ROAD B	13
W-A-1	WATERWORKS	ROAD A (STA 0+100-0+310)	17
W-OS-1	WATERWORKS	OFFSITE ROAD (STA 0+110-0+310)	15
W-OS-2	WATERWORKS	OFFSITE ROAD (STA 0+300-0+620)	15
W-OS-3	WATERWORKS	OFFSITE ROAD (STA 0+610-0+920)	15
W-OS-4	WATERWORKS	OFFSITE ROAD (STA 0+910-1+220)	16
S-A-1	SANITARY	ROAD A (STA 0+100-0+310)	16
S-B-1	SANITARY	ROAD B (STA 0+090-0+300)	18
S-B-2	SANITARY	MH B13 TO MH B23	12
S-B-3	SANITARY	MH B1 TO MH B12	15
S-OS-1	SANITARY	OFFSITE ROAD (STA 0+120-0+370)	13
S-OS-2	SANITARY	OFFSITE ROAD (STA 0+360-0+610)	13
S-OS-3	SANITARY	OFFSITE ROAD (STA 0+600-0+800)	18
X-OS-1	CROSS SECTIONS	OFFSITE ROAD (STA 0+100-0+120)	12
X-OS-2	CROSS SECTIONS	OFFSITE ROAD (STA 0+140-0+160)	11
X-OS-3	CROSS SECTIONS	OFFSITE ROAD (STA 0+180-0+200)	11
X-OS-4	CROSS SECTIONS	OFFSITE ROAD (STA 0+220-0+240)	10
X-OS-5	CROSS SECTIONS	OFFSITE ROAD (STA 0+260-0+280)	12
X-OS-6	CROSS SECTIONS	OFFSITE ROAD (STA 0+300-0+320)	10
X-OS-7	CROSS SECTIONS	OFFSITE ROAD (STA 0+340-0+400)	12
X-OS-8	CROSS SECTIONS	OFFSITE ROAD (STA 0+420-0+460)	11
X-OS-9	CROSS SECTIONS	OFFSITE ROAD (STA 0+480-0+500)	11
X-OS-10	CROSS SECTIONS	OFFSITE ROAD (STA 0+520-0+540)	11
X-OS-11	CROSS SECTIONS	OFFSITE ROAD (STA 0+560-0+580)	11
DET-1	DETAILS		17
DET-2	DETAILS		18
DET-3	DETAILS		19
DET-6	DETAILS		13
DET-10	DETAILS		2
DET-11	DETAILS		2

**2018-02-06**  
**PROJECT RECORD DRAWINGS**



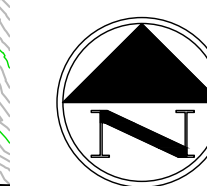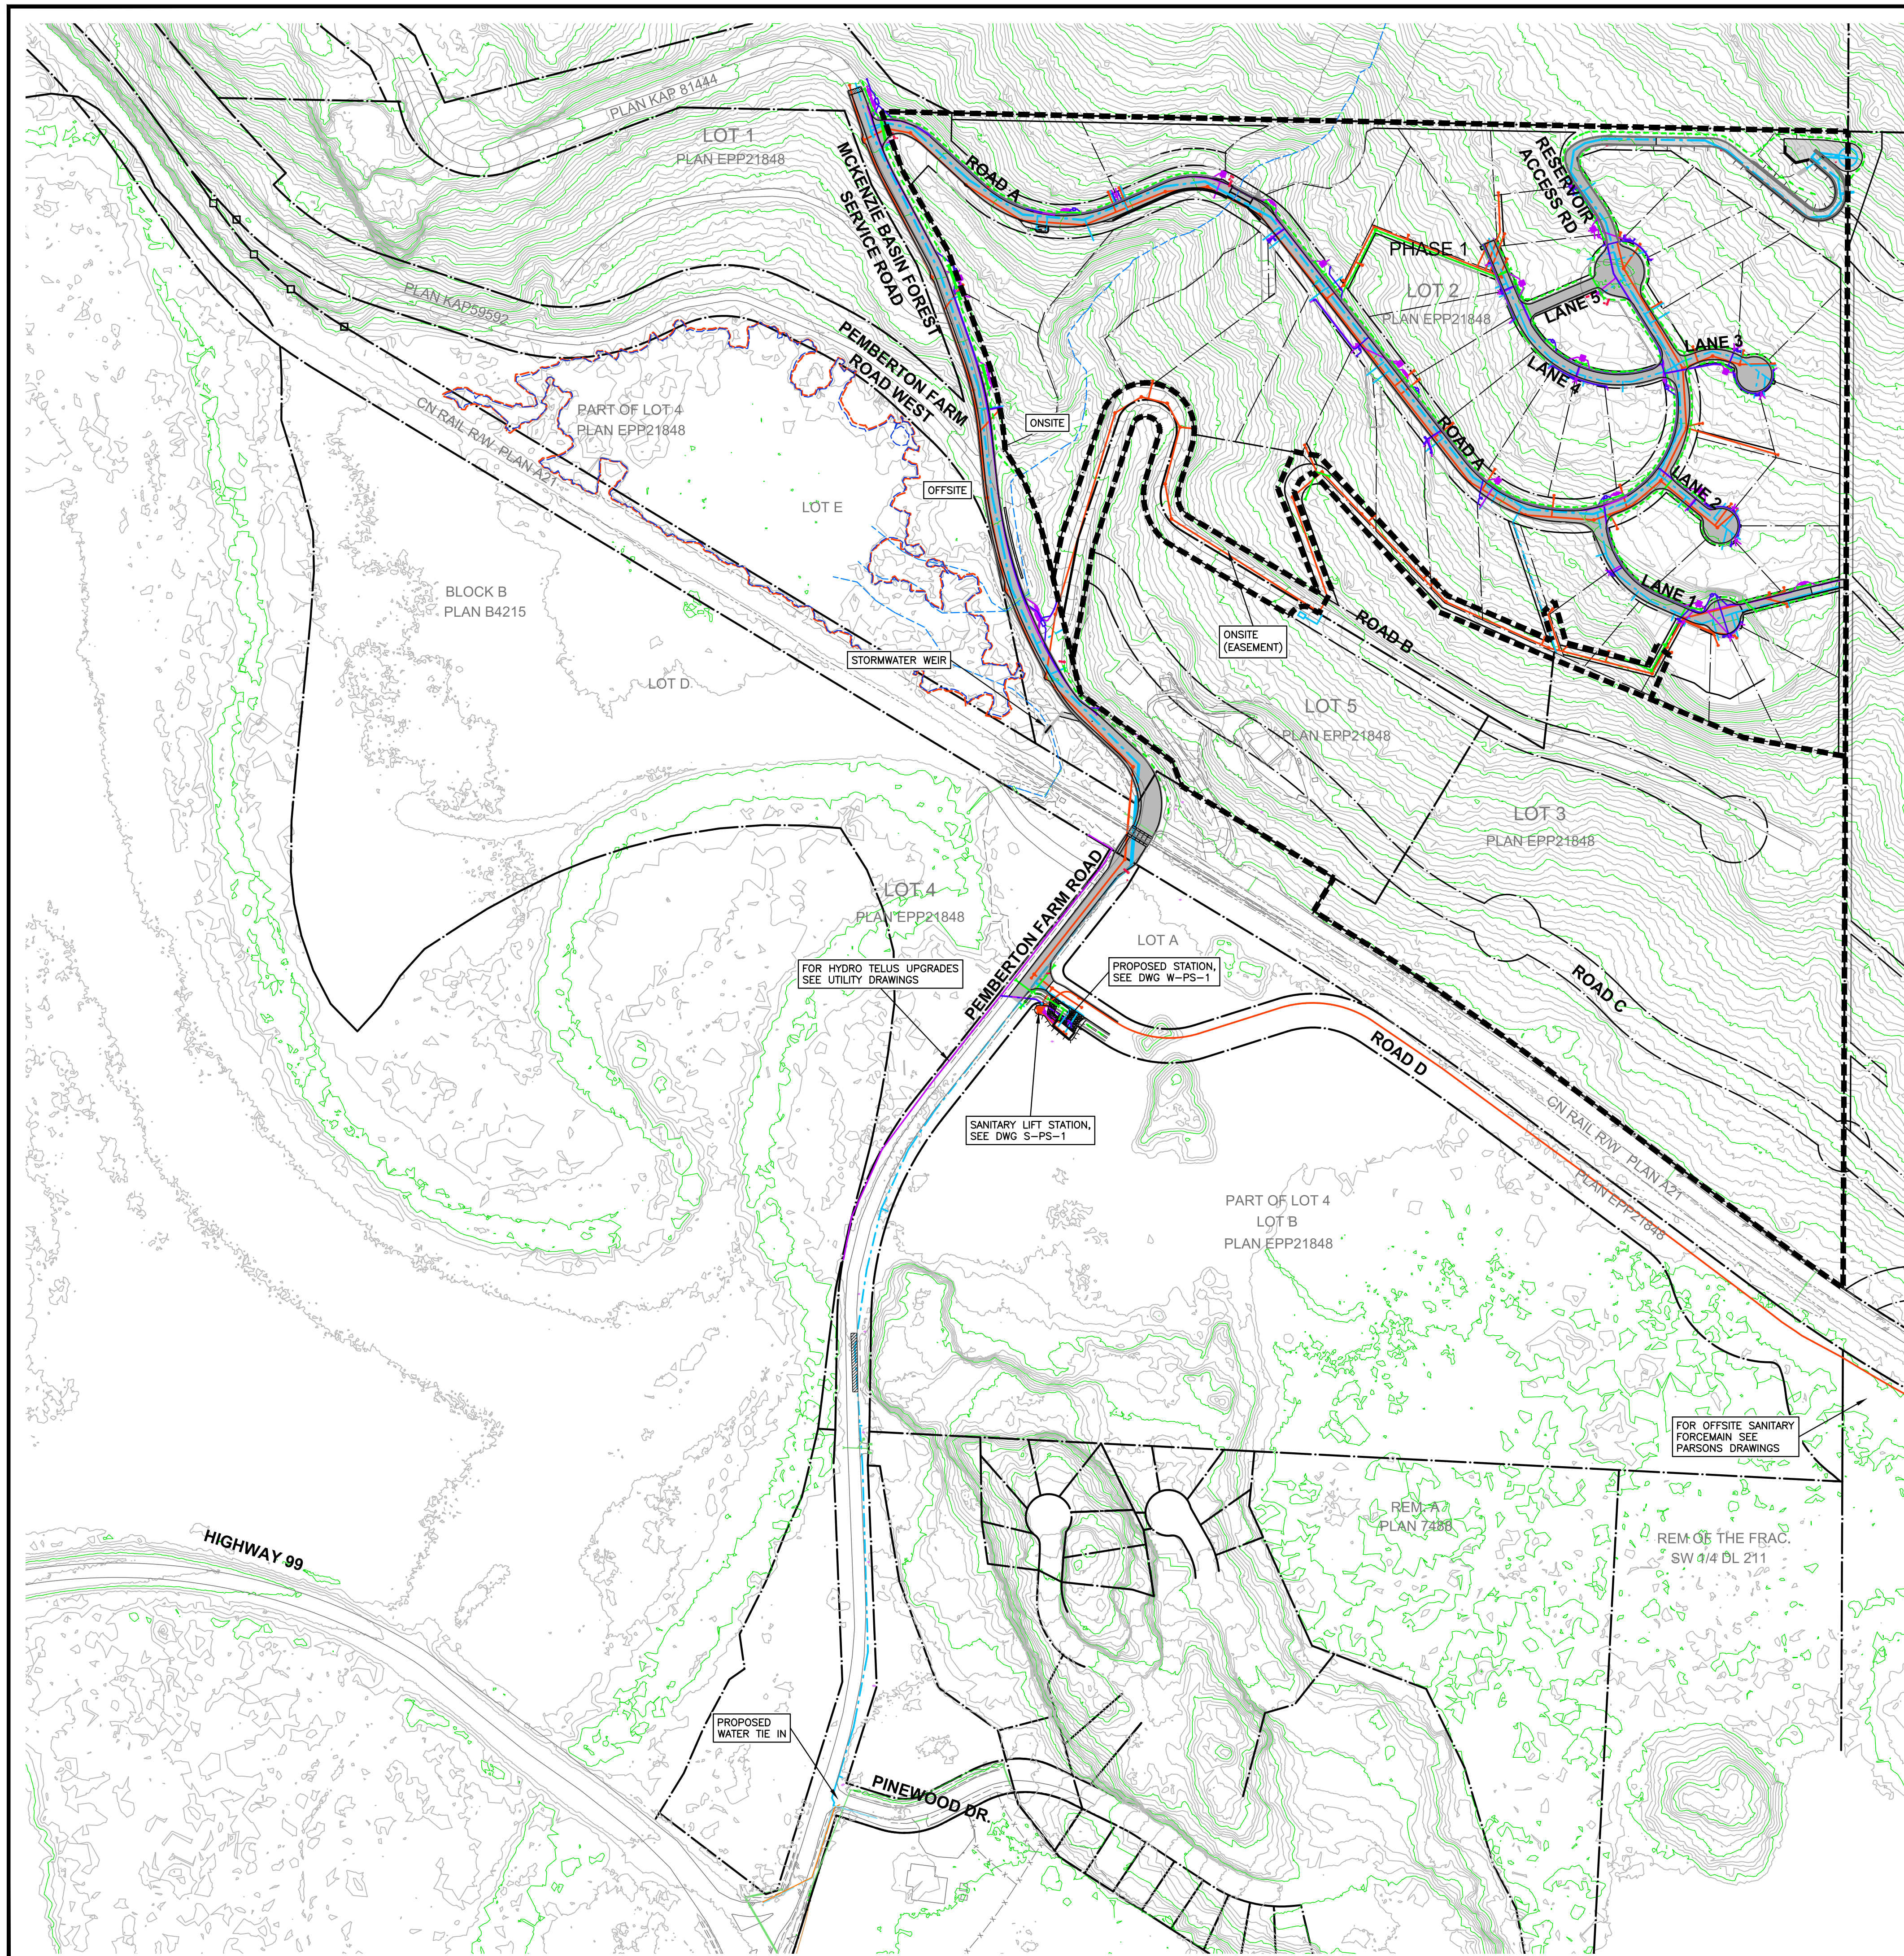

**LEGAL DESCRIPTION**

SUBDIVISION PLAN OF LOT '2,3', DL. 211, PLAN EPP21848

**BENCHMARK CONTROL**

ELEVATIONS ARE TO GEODETIC DATUM NAD83, AND ARE DERIVED FROM DUAL FREQUENCY GNSS OBSERVATIONS TO WHISTLER ACTIVE CONTROL POINT (GEODETIC CONTROL MONUMENT 967000) AND ARE REFERRED TO THE CENTRAL MERIDIAN OF UTM ZONE 10.

**GENERAL NOTES**

1. THE CONTRACTOR SHALL ENSURE THAT ALL APPROVALS REQUIRED FOR THE PROPOSED WORK HAVE BEEN OBTAINED PRIOR TO COMMENCEMENT OF ANY CONSTRUCTION.
2. A PRE-CONSTRUCTION MEETING BETWEEN ENGINEER, THE CONTRACTOR, AND THE VILLAGE OF PEMBERTON IS REQUIRED PRIOR TO COMMENCEMENT OF CONSTRUCTION. MEETING TO BE COORDINATED BY THE CONTRACTOR.
3. CONTRACTOR TO PROVIDE EMERGENCY CONTACT LIST, INSURANCE AND SURETY DOCUMENTATION AND PROPOSED SCHEDULE OF WORK TO THE ENGINEER AT THE PRE-CONSTRUCTION MEETING.
4. THE CONTRACTOR MUST NOTIFY ENGINEER THEN THE VILLAGE OF PEMBERTON, 48 HOURS PRIOR TO STARTING CONSTRUCTION TO ESTABLISH AN INSPECTION SCHEDULE.
5. ALL CONSTRUCTION IN THE VILLAGE OF PEMBERTON (VOP) ROAD R.O.W. MUST CONFORM TO THE MASTER MUNICIPAL CONSTRUCTION DOCUMENTS (MMD) AND THE VILLAGE OF PEMBERTON SUBDIVISION AND DEVELOPMENT BYLAW #6772011 SCHEDULE B SUPPLEMENTARY SPECIFICATIONS AND STANDARD DETAIL DRAWINGS. ALL MATERIALS AND PRODUCTS TO BE IN ACCORDANCE WITH MMD ACCEPTED MATERIAL AND PRODUCTS.
6. ALL CONSTRUCTION WITHIN THE PROPERTY MUST CONFORM TO THE MASTER MUNICIPAL SPECIFICATIONS, B.C. BUILDING CODE & B.C. PLUMBING CODE.
7. THE CONTRACTOR WILL CONSTRUCT ALL WORKS TO THE SATISFACTION OF THE INSPECTORS FROM THE ENGINEER AND THE REGULATORY AUTHORITY. IF APPLICABLE ADDITIONALLY, THE TELLUS WORKS UNDER THE DIRECTION AND TO THE SATISFACTION OF THE TELLUS INSPECTOR, HYDRO WORKS TO SATISFACTION OF THE BC HYDRO INSPECTOR, FORTIS WORKS TO SATISFACTION OF THE FORTIS INSPECTOR, SHAW WORKS TO SATISFACTION OF THE SHAW INSPECTOR. THE CONTRACTOR WILL FORWARD TO THE ENGINEER CERTIFICATION OF ACCEPTANCE OR APPROVAL FROM THE ABOVE NOTED INSPECTORS ON COMPLETION OF THE WORK. ELECTRICAL WORKS, IF APPLICABLE TO ALSO BE UNDER PERMIT WITH BC ELECTRICAL SAFETY BRANCH WITH A COPY OF PERMIT AND SIGN OFF TO BE FORWARDED BY THE CONTRACTOR. CONTRACTOR TO GIVE MINIMUM 48 HOURS NOTICE TO RELEVANT INSPECTOR TO ALLOW FOR INSPECTION ON WORKS AND UPDATE ENGINEER ON SAME.
8. THE CONTRACTOR WILL PERFORM AT HIS OWN COST ALL TESTING REQUIRED BY THE REGULATORY AUTHORITY, MMD AND THE ENGINEER. TESTING SHALL BE DONE BY AN INDEPENDENT SPECIALTY TESTING FIRM. CONTRACTOR TO GIVE ENGINEER 48 HOURS' NOTICE ON ALL TESTS. COPIES OF TESTS TO BE FORWARDED DIRECTLY BY THE TESTING FIRM TO ENGINEER AND GEOTECHNICAL ENGINEER BY EMAIL.
9. LOCATIONS OF EXISTING UNDERGROUND SERVICES HAVE BEEN DETERMINED FROM UTILITY AS-CONSTRUCTED DRAWINGS AND THIRD PARTY SURVEY. CONTRACTOR TO CONTACT BC ONE CALL AND PROVIDE COPIES TO ENGINEER AND VERIFY THE LOCATION OF ALL EXISTING SERVICES AND TO NOTIFY ENGINEER OF ANY DISCREPANCIES, CONFLICTS OR OMISSIONS PRIOR TO BEGINNING OF CONSTRUCTION.
10. THE CONTRACTOR SHALL USE EXTREME CARE WHEN WORKING NEAR EXISTING SERVICES AND ANY SERVICES DISTURBED ARE TO BE REPLACED TO THE SATISFACTION OF THE APPROVING AUTHORITY, THE ENGINEER AND/OR APPROPRIATE UTILITY CORPORATION.
11. ALL CUTS IN EXISTING ASPHALT REQUIRED FOR TRENCHING SHALL BE VERTICAL, MINIMUM 80 MM DEEP, WITH A DIAMOND SAW & REPLACED WITH MINIMUM 80 MM ASPHALT OR MATCHING EXISTING WHICHEVER IS GREATER UNLESS OTHERWISE NOTED. AFTER BACKFILL AND COMPACTION. ALL PAVEMENTS, BOULEVARDS, DRIVEWAYS, FENCES ETC. ARE TO BE RESTORED TO ORIGINAL OR BETTER CONDITION WHEN NO IMPROVEMENT IS PROPOSED UNDER THIS CONTRACT. ALL PAVEMENT JOINTS TO INCLUDE TOP LIFT LAP JOINT AS PER MMD STD DWG G5
12. WHEN NO IMPROVEMENTS ARE PROPOSED UNDER THIS CONTRACT, THE EXISTING SECTION(S) OF ROADWAY, BOULEVARD OR LANDSCAPE SHALL BE KEPT CLEAN AND CLEAR FOR THE DURATION OF CONSTRUCTION AND LEFT IN SAME CONDITION AS PRIOR TO CONSTRUCTION.
13. THE CONTRACTOR'S SURVEYOR WILL RECORD AND CERTIFY ALL INFORMATION REQUIRED FOR THE ENGINEER TO PROVIDE A COMPLETE SET OF AS-CONSTRUCTED DRAWINGS INCLUDING CENTERLINE, FOG LINE, EDGE OF ASPHALT, SIGNS, INVERTS, RIMS, PIPE SIZES AND ALL APPURTENANCES. SEE SUPPLEMENTAL SPECIFICATION FOR DETAILS.
14. TRAFFIC CONTROL PER APPROVED TRAFFIC MANAGEMENT PLAN & THE MINISTRY OF TRANSPORTATION 'TRAFFIC MANUAL FOR WORK ON ROADWAYS' TRANSPORTATION ASSOCIATION OF CANADA 'MANUAL OF UNIFORM TRAFFIC CONTROL DEVICES'. CONTRACTOR TO INFORM ENGINEER AND VOP IMMEDIATELY OF ANY FORESEEN OR UNFORESEEN CHANGES TO THE SCHEDULE.
15. VEHICULAR ACCESS TO EXISTING DWELLINGS AND BUSINESS' TO BE MAINTAINED BY THE CONTRACTOR FOR THE DURATION OF THE CONTRACT.
16. PEDESTRIANS SHALL BE PROTECTED AT ALL TIMES. ANY CLOSURES OF THE SIDEWALK OR LANES TO BE COORDINATED WITH AND APPROVED BY THE ENGINEER AND A PERMIT FROM REGULATORY AUTHORITY OBTAINED BY THE CONTRACTOR AND FORWARDED TO ENGINEER. CONTRACTOR TO PROVIDE REQUIRED NOTICES.
17. RESIDENTS AND BUSINESSES DIRECTLY AFFECTED BY CONSTRUCTION OF THIS PROJECT SHALL BE GIVEN 48 HOURS WRITTEN NOTICE OF THE PROPOSED START OF CONSTRUCTION. IF CONSTRUCTION ENTERS ONTO PRIVATE PROPERTY, THE CONTRACTOR OR DEVELOPER'S AGENT WILL REQUIRED WRITTEN AUTHORIZATION FROM THE PRIVATE PROPERTY OWNER. ENGINEER TO BE FORWARDED COPY OF AUTHORIZATION.
18. RETAINING DESIGNATED TREES IS OF PRIME IMPORTANCE. WHEN WORKING IN PROXIMITY TO A DESIGNATED TREE OR WHEN ROOTS ARE ENCOUNTERED, THE CONTRACTOR SHALL CONSULT A CERTIFIED ARBORIST BEFORE PROCEEDING TO PREVENT DAMAGE TO TREES.
19. THE CONTRACTOR SHALL TAKE ALL STEPS NECESSARY TO ENSURE THAT NO SILT IS DISCHARGED TO THE STORM DRAINAGE SYSTEM, ROADWAYS OR ADJACENT PROPERTIES DURING THE COURSE OF CONSTRUCTION IN ACCORDANCE WITH DFO/MOELP'S 'LAND DEVELOPMENT GUIDELINES FOR THE PROTECTION OF AQUATIC HABITAT'. IT IS THE RESPONSIBILITY OF THE CONTRACTOR TO INSTALL & MAINTAIN ALL EROSION & SEDIMENT CONTROL WORKS.
20. FOR BC HYDRO, TELLUS, AND FORTIS INSTALLATION, SEE APPROPRIATE UTILITY COMPANY DRAWINGS AND SPECIFICATIONS. CONTRACTOR TO NOTIFY ENGINEER IMMEDIATELY SHOULD SITE CONDITIONS BECOME ALTERED FROM EXPECTATION.
21. SEE ELECTRICAL ENGINEER DRAWINGS FOR STREETLIGHT.
22. IT IS THE CONTRACTOR'S RESPONSIBILITY TO ENSURE THEY ARE WORKING FROM THE MOST UP TO DATE DESIGN PACKAGE INCLUDING DRAWINGS AND REPORTS.
23. A PORTION OF THE CONTRACT DOCUMENTS IS INCLUDED BY REFERENCE. COPIES OF THESE DOCUMENTS HAVE BEEN REFERENCED IN THE TENDER PACKAGE. IT IS THE CONTRACTOR'S RESPONSIBILITY TO ENSURE THAT CURRENT RELEVANT COPIES OF ALL DRAWINGS AND CONTRACT DOCUMENTS ARE FORWARDED TO SURVEYORS, TESTING AGENCIES, SUBCONTRACTORS, SUPERINTENDENTS, ESTIMATORS, PROJECT MANAGERS, SITE STAFF AND ANY OTHER RELEVANT PARTIES. CONTRACTOR CONFIRMS THEY HAVE REVIEWED SAME PRIOR TO SUBMITTING TENDER.
24. SUB-CONTRACTORS SHALL NOT COMMUNICATE WITH THE ENGINEERS OR OWNER DIRECTLY ON ANY CONTRACTUAL OR TECHNICAL ISSUE. THEY SHALL DIRECT THEIR ISSUES TO THE CONTRACTOR DIRECTLY WHOSE RESPONSIBILITY IT TO DEAL WITH THESE ISSUES ON THEIR BEHALF WITH THE ENGINEER. REVIEW AND APPROVAL OF ANY CONTRACTUAL MATTER INCLUDING PROGRESS PAYMENT, CHANGE ORDER, PAYMENT OF HOLDBACK, FINAL PAYMENT, INSURANCE AND WARRANTY, ETC. SHALL DIRECTED TO THE ENGINEER. CONTRACTOR MUST ONLY TAKE DIRECTION FROM THE ENGINEER IN REGARDS TO CHANGES TO DESIGN OR EXTRA WORKS.
25. UNLESS OTHERWISE SPECIFIED IN THE CONTRACT DOCUMENTS OR NOTIFIED TO THE CONTRARY BY THE ENGINEER, THE CONTRACTOR IS THE PRIME CONTRACTOR FOR THE PURPOSE OF ALL APPLICABLE LAWS RELATIVE TO OCCUPATIONAL HEALTH AND SAFETY, INCLUDING THE DISCHARGE OF ALL DUTIES OF THE 'PRIME CONTRACTOR' UNDER THE WORKERS COMPENSATION ACT (BRITISH COLUMBIA), NOTWITHSTANDING THAT THE ENGINEER, THE OWNER OR ANOTHER CONTRACTOR MAY PROVIDE FROM TIME TO TIME SOME OF THE SERVICES NORMALLY PROVIDED BY SUCH 'PRIME CONTRACTOR'. IN THIS SECTION 'PRIME CONTRACTOR' MEANS THE CONTRACTOR SO DEFINED UNDER THE WORKERS COMPENSATION ACT (BRITISH COLUMBIA).
26. THE CONTRACTOR SHALL BECOME FAMILIAR WITH THE GEOTECHNICAL REPORT PREPARED BY EXP DATED AUGUST 18, 2016 AND BUILD TO THE REQUIREMENTS OF THE REPORT AND INSTRUCTIONS OF THE GEOTECHNICAL ENGINEER AND REPRESENTATIVES.
27. ALL DIMENSION IN METERS UNLESS OTHERWISE NOTED

**DRAWING LEGEND**

LEGAL LINE	EXISTING	PROP.	TO BE REMOVED
EASMENT	---	---	---
WATERMAIN	---	---	---
SANITARY	---	---	---
STORM	---	---	---
HYDRO	---	---	---
TEL	---	---	---
STREETLIGHT	---	---	---
GAS	---	---	---

EXISTING	PROP.	TO BE REMOVED
FIRE HYDRANT	○	○
GATE VALVE	○	○
AIR VALVE	○	○
REDUCER	○	○
INSPECTION CHAMBER	○	○
CATCHBASIN (STD/SI)	○	○
CAP	○	○
MANHOLE	○	○
POWER POLE	○	○
STREETLIGHT	○	○

approved  
 client  
**580049 BC LTD.**

project  
**THE RIDGE AT PEMBERTON  
 PHASE 1  
 PEMBERTON, BC**


title  
**KEY PLAN**

no.	(y/m/d)	revision	ch/k/v
29	18-02-06	PROJECT RECORDS OFFSITE	KBH
28	18-02-06	PROJECT RECORDS - PUMP STATIONS	KBH
27	18-02-06	PROJECT RECORDS ONSITE	KBH
26	17-10-17	PROJECT RECORDS OFFSITE	ZM
25	17-05-02	REISSUED FOR CONSTRUCTION PUMP STATION	KBH
24	17-03-07	REISSUED FOR CONSTRUCTION OFFSITE	KBH
23	17-02-27	ISSUED FOR CONSTRUCTION ONSITE	KBH
22	17-02-03	ISSUED FOR VOP APPROVAL	KBH

copyright reserved. THIS DRAWING AND DESIGN ARE, AND AT ALL TIMES REMAIN THE EXCLUSIVE PROPERTY OF CREUS ENGINEERING LTD. AND CANNOT BE USED, REPRODUCED OR DISTRIBUTED WITHOUT WRITTEN CONSENT.  
 ©2016 CREUS ENGINEERING LTD.

engineer of record: K.B.H. scales: hor:1:2000 vert: -  
 designed by: N.G.B. file no.: **16159**  
 drawn by: R.J.L. drawing no.: **KEY-1**  
 date: 2016-05-13



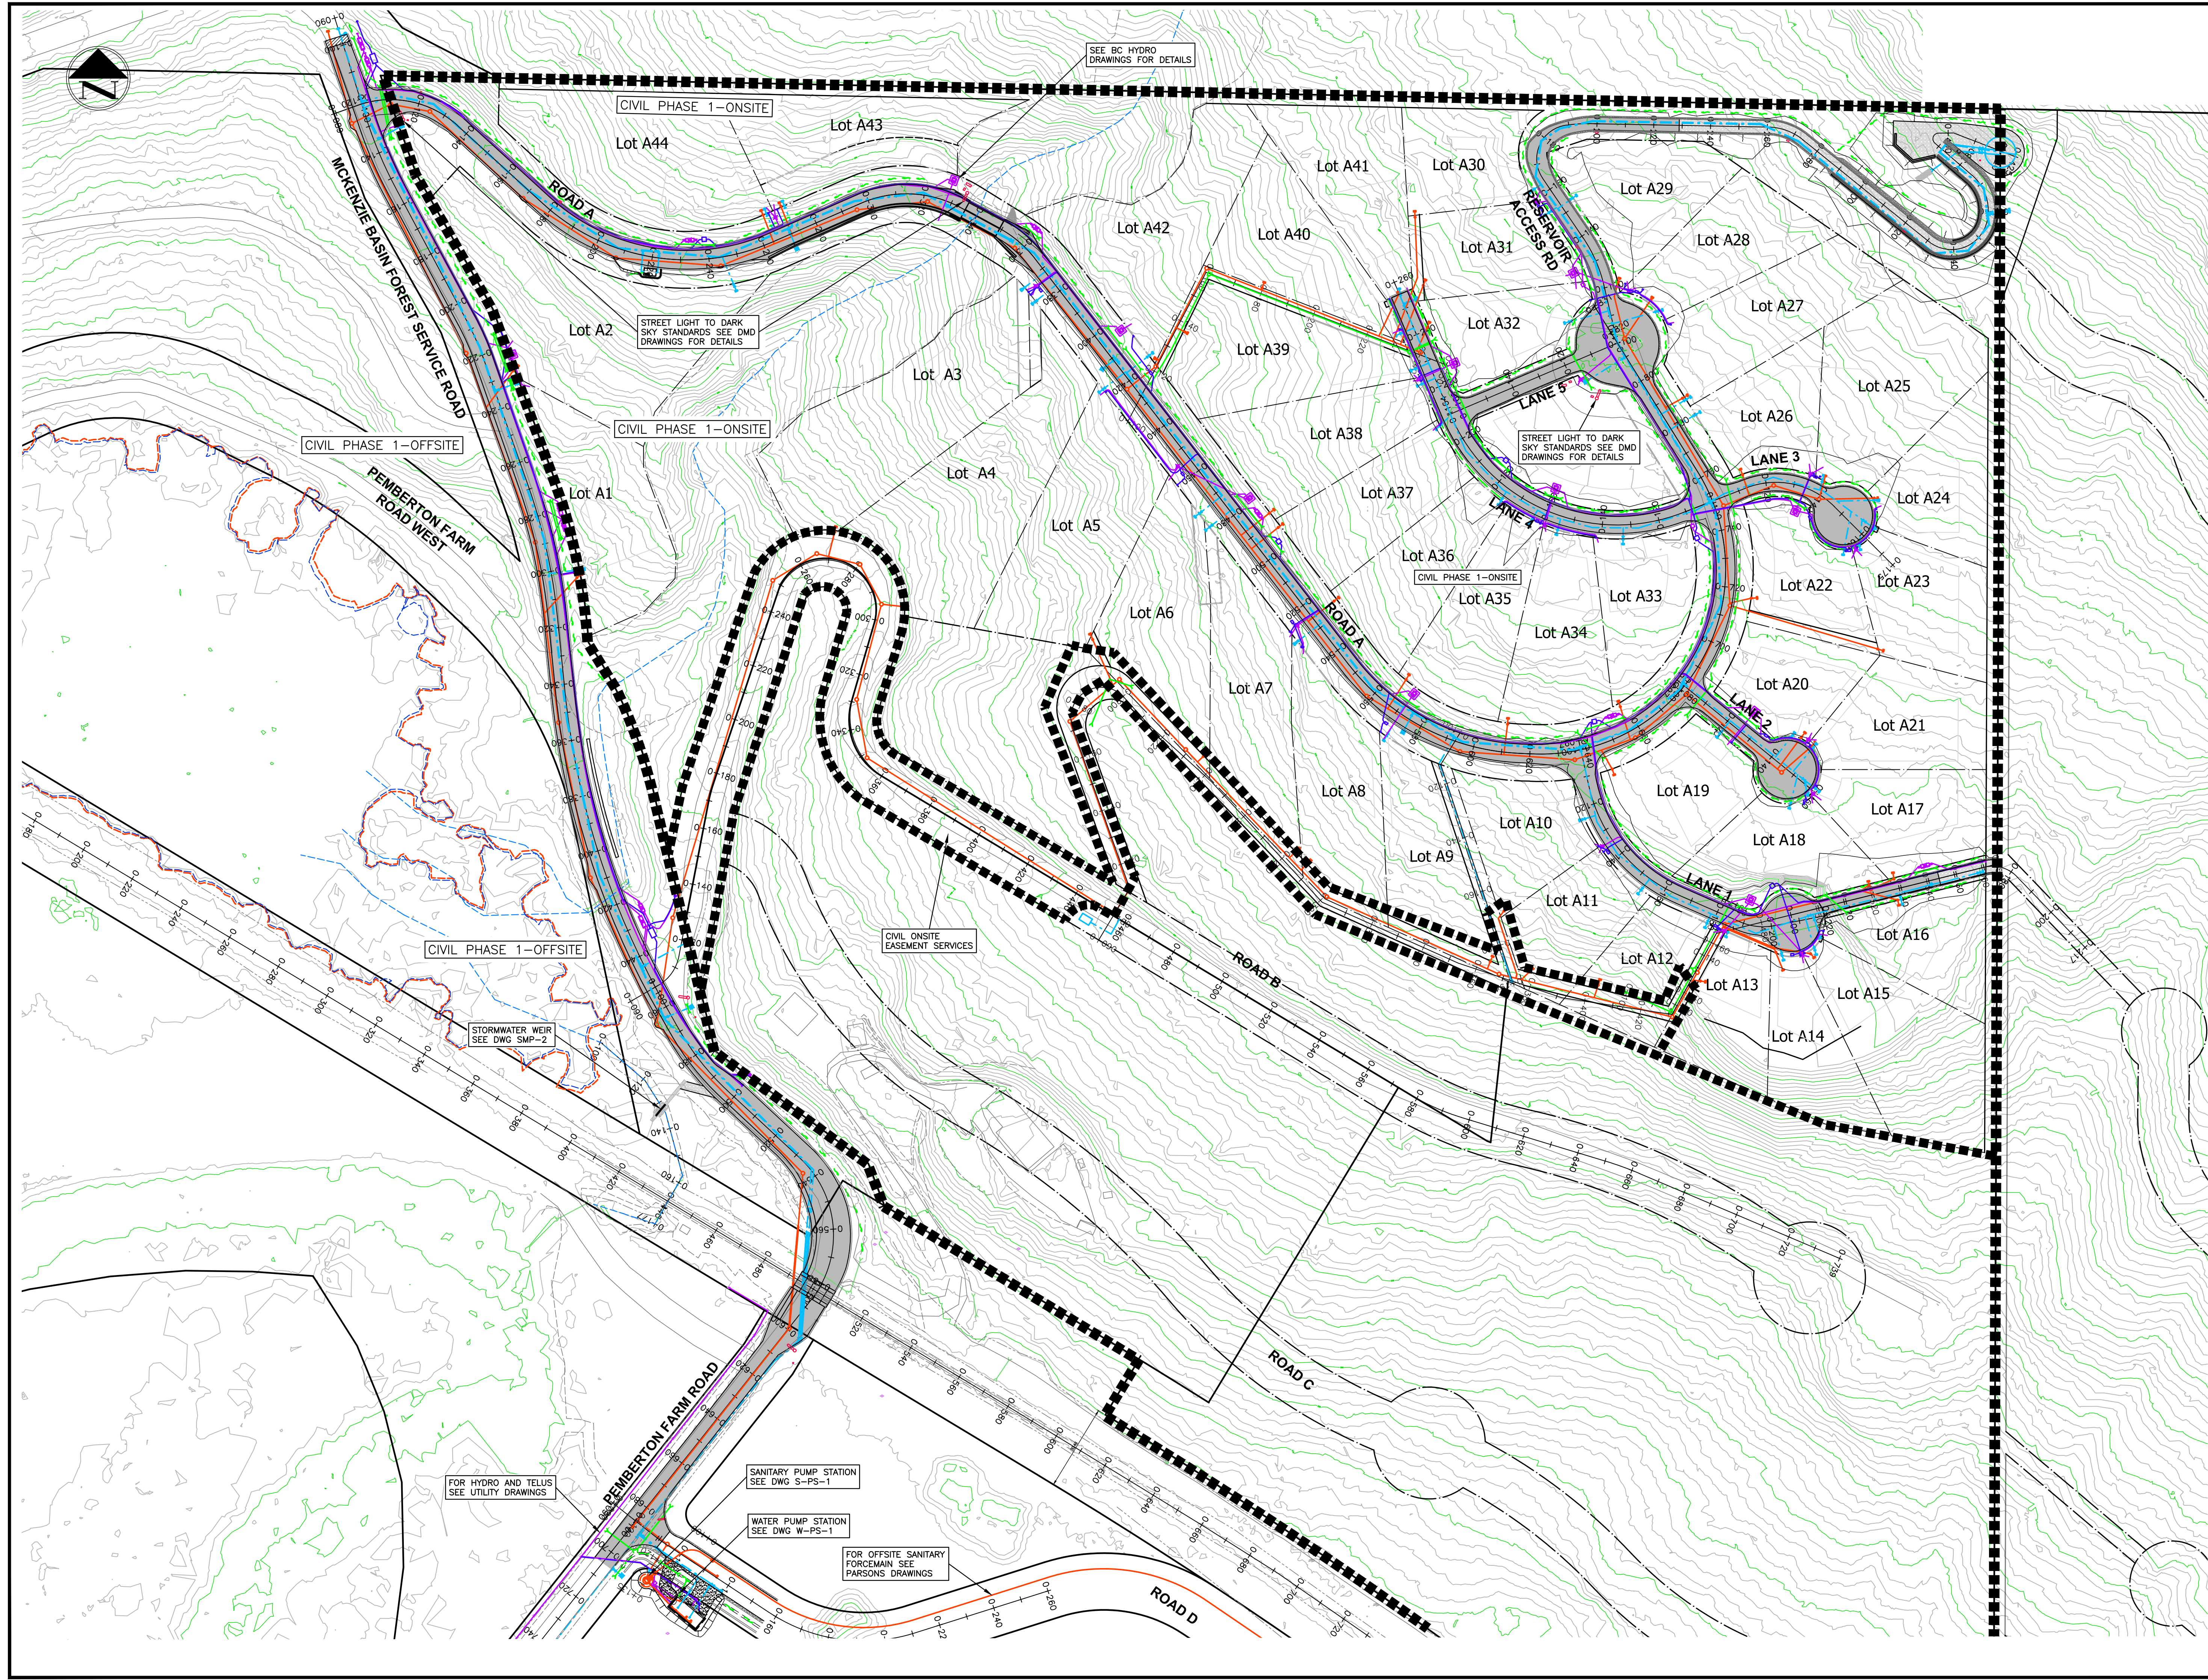

# CREUS Engineering

Civil Engineers & Project Managers  
 SUITE 200-901 16TH ST WEST, NORTH VANCOUVER BC, V7P1R2  
 PH: 604-987-0070 WEBSITE: www.creus.ca

## DRAWING LEGEND

	EXISTING	PROP.	TO BE REMOVED
LEGAL LINE EASEMENT	---	---	---
WATERMAIN	---	---	---
SANITARY	---	---	---
STORM	---	---	---
HYDRO	---	---	---
TEL	---	---	---
STREETLIGHT	---	---	---
GAS	---	---	---
	EXISTING	PROP.	TO BE REMOVED
FIRE HYDRANT	○	○	○
GATE VALVE	○	○	○
AIR VALVE	○	○	○
REDUCER	○	○	○
INSPECTION CHAMBER	○	○	○
CATCHBASIN (STD/SI)	○	○	○
MANHOLE	○	○	○
POWER POLE	○	○	○
STREETLIGHT	○	○	○

approved \_\_\_\_\_  
 client \_\_\_\_\_




580049 BC LTD.

project THE RIDGE AT PEMBERTON  
 PHASE 1  
 PEMBERTON, BC

title KEY PLAN  
 PHASE 1

no.	(y/m/d)	revision	chk'd
28	18-02-06	PROJECT RECORDS - OFFSITE	KBH
27	18-02-06	PROJECT RECORDS - PUMP STATIONS	KBH
26	18-02-06	PROJECT RECORDS ONSITE	KBH
25	17-12-01	HYDRO & TELUS PROJECT RECORDS	ZM
24	17-10-17	PROJECT RECORDS OFFSITE	ZM
23	17-05-02	REISSUED FOR CONSTRUCTION PUMP STATION	ZM
22	17-03-07	REISSUED FOR CONSTRUCTION OFFSITE	KBH
21	17-02-27	ISSUED FOR CONSTRUCTION ONSITE	KBH
copyright reserved. THIS DRAWING AND DESIGN ARE, AND AT ALL TIMES REMAIN THE EXCLUSIVE PROPERTY OF CREUS ENGINEERING LTD. AND CANNOT BE USED, REPRODUCED OR DISTRIBUTED WITHOUT WRITTEN CONSENT. ©2016 CREUS ENGINEERING LTD.		current rev. #	28
engineer of record	K.B.H.	scales	hor:1:1000 vert: -
designed by	N.G.B.	file no.	16159
drawn by	R.J.L.	drawing no.	KEY-2
date	2016-05-13		



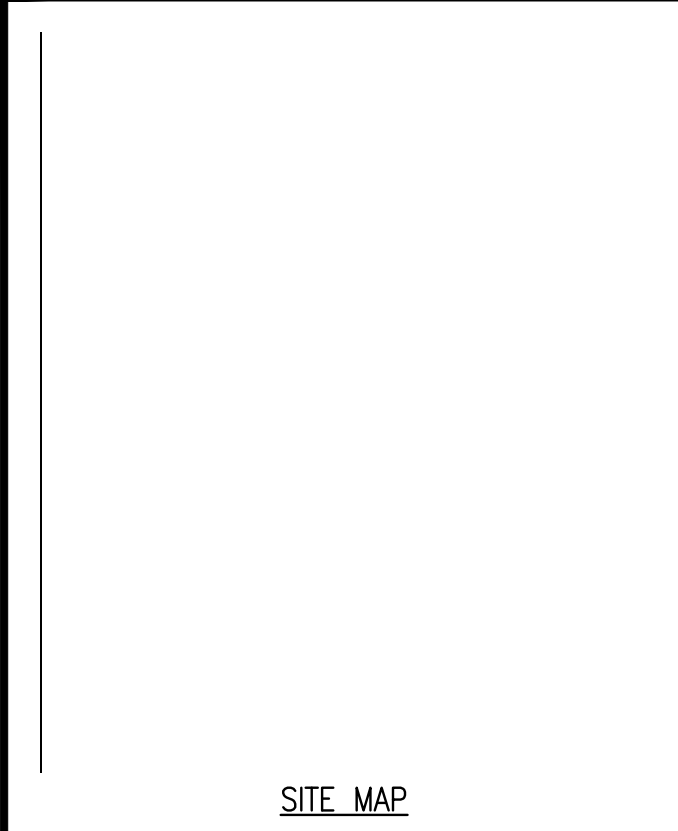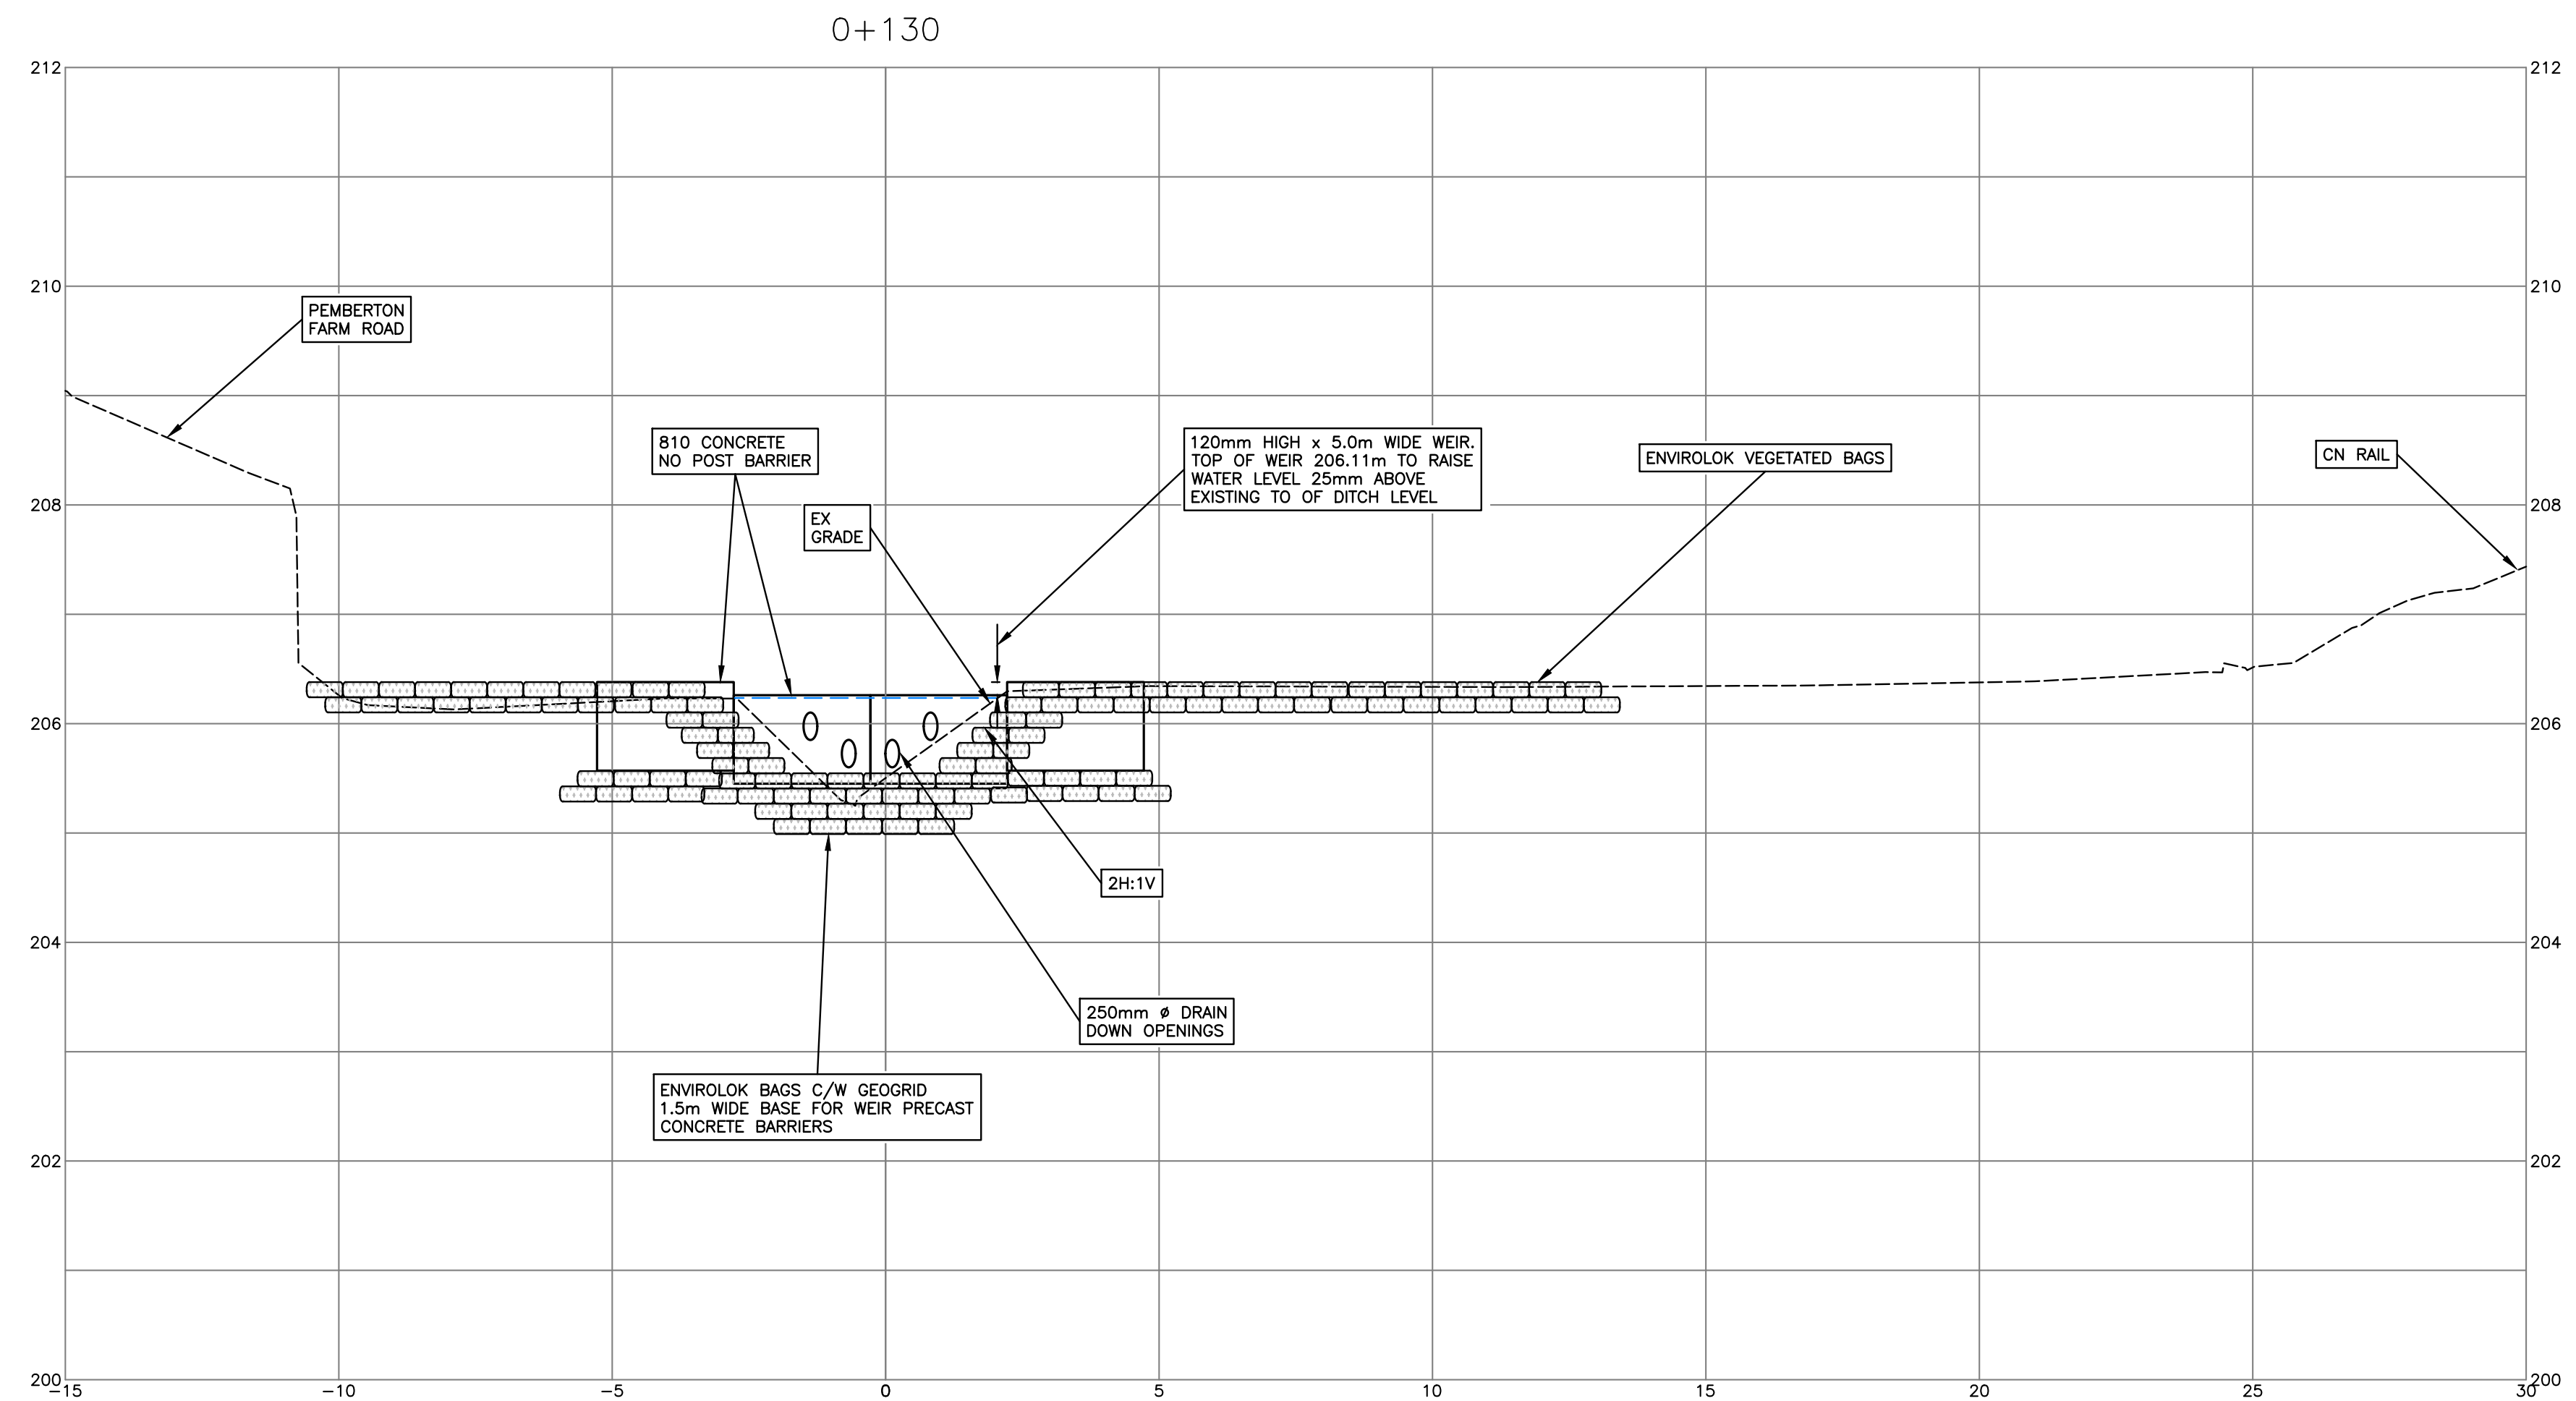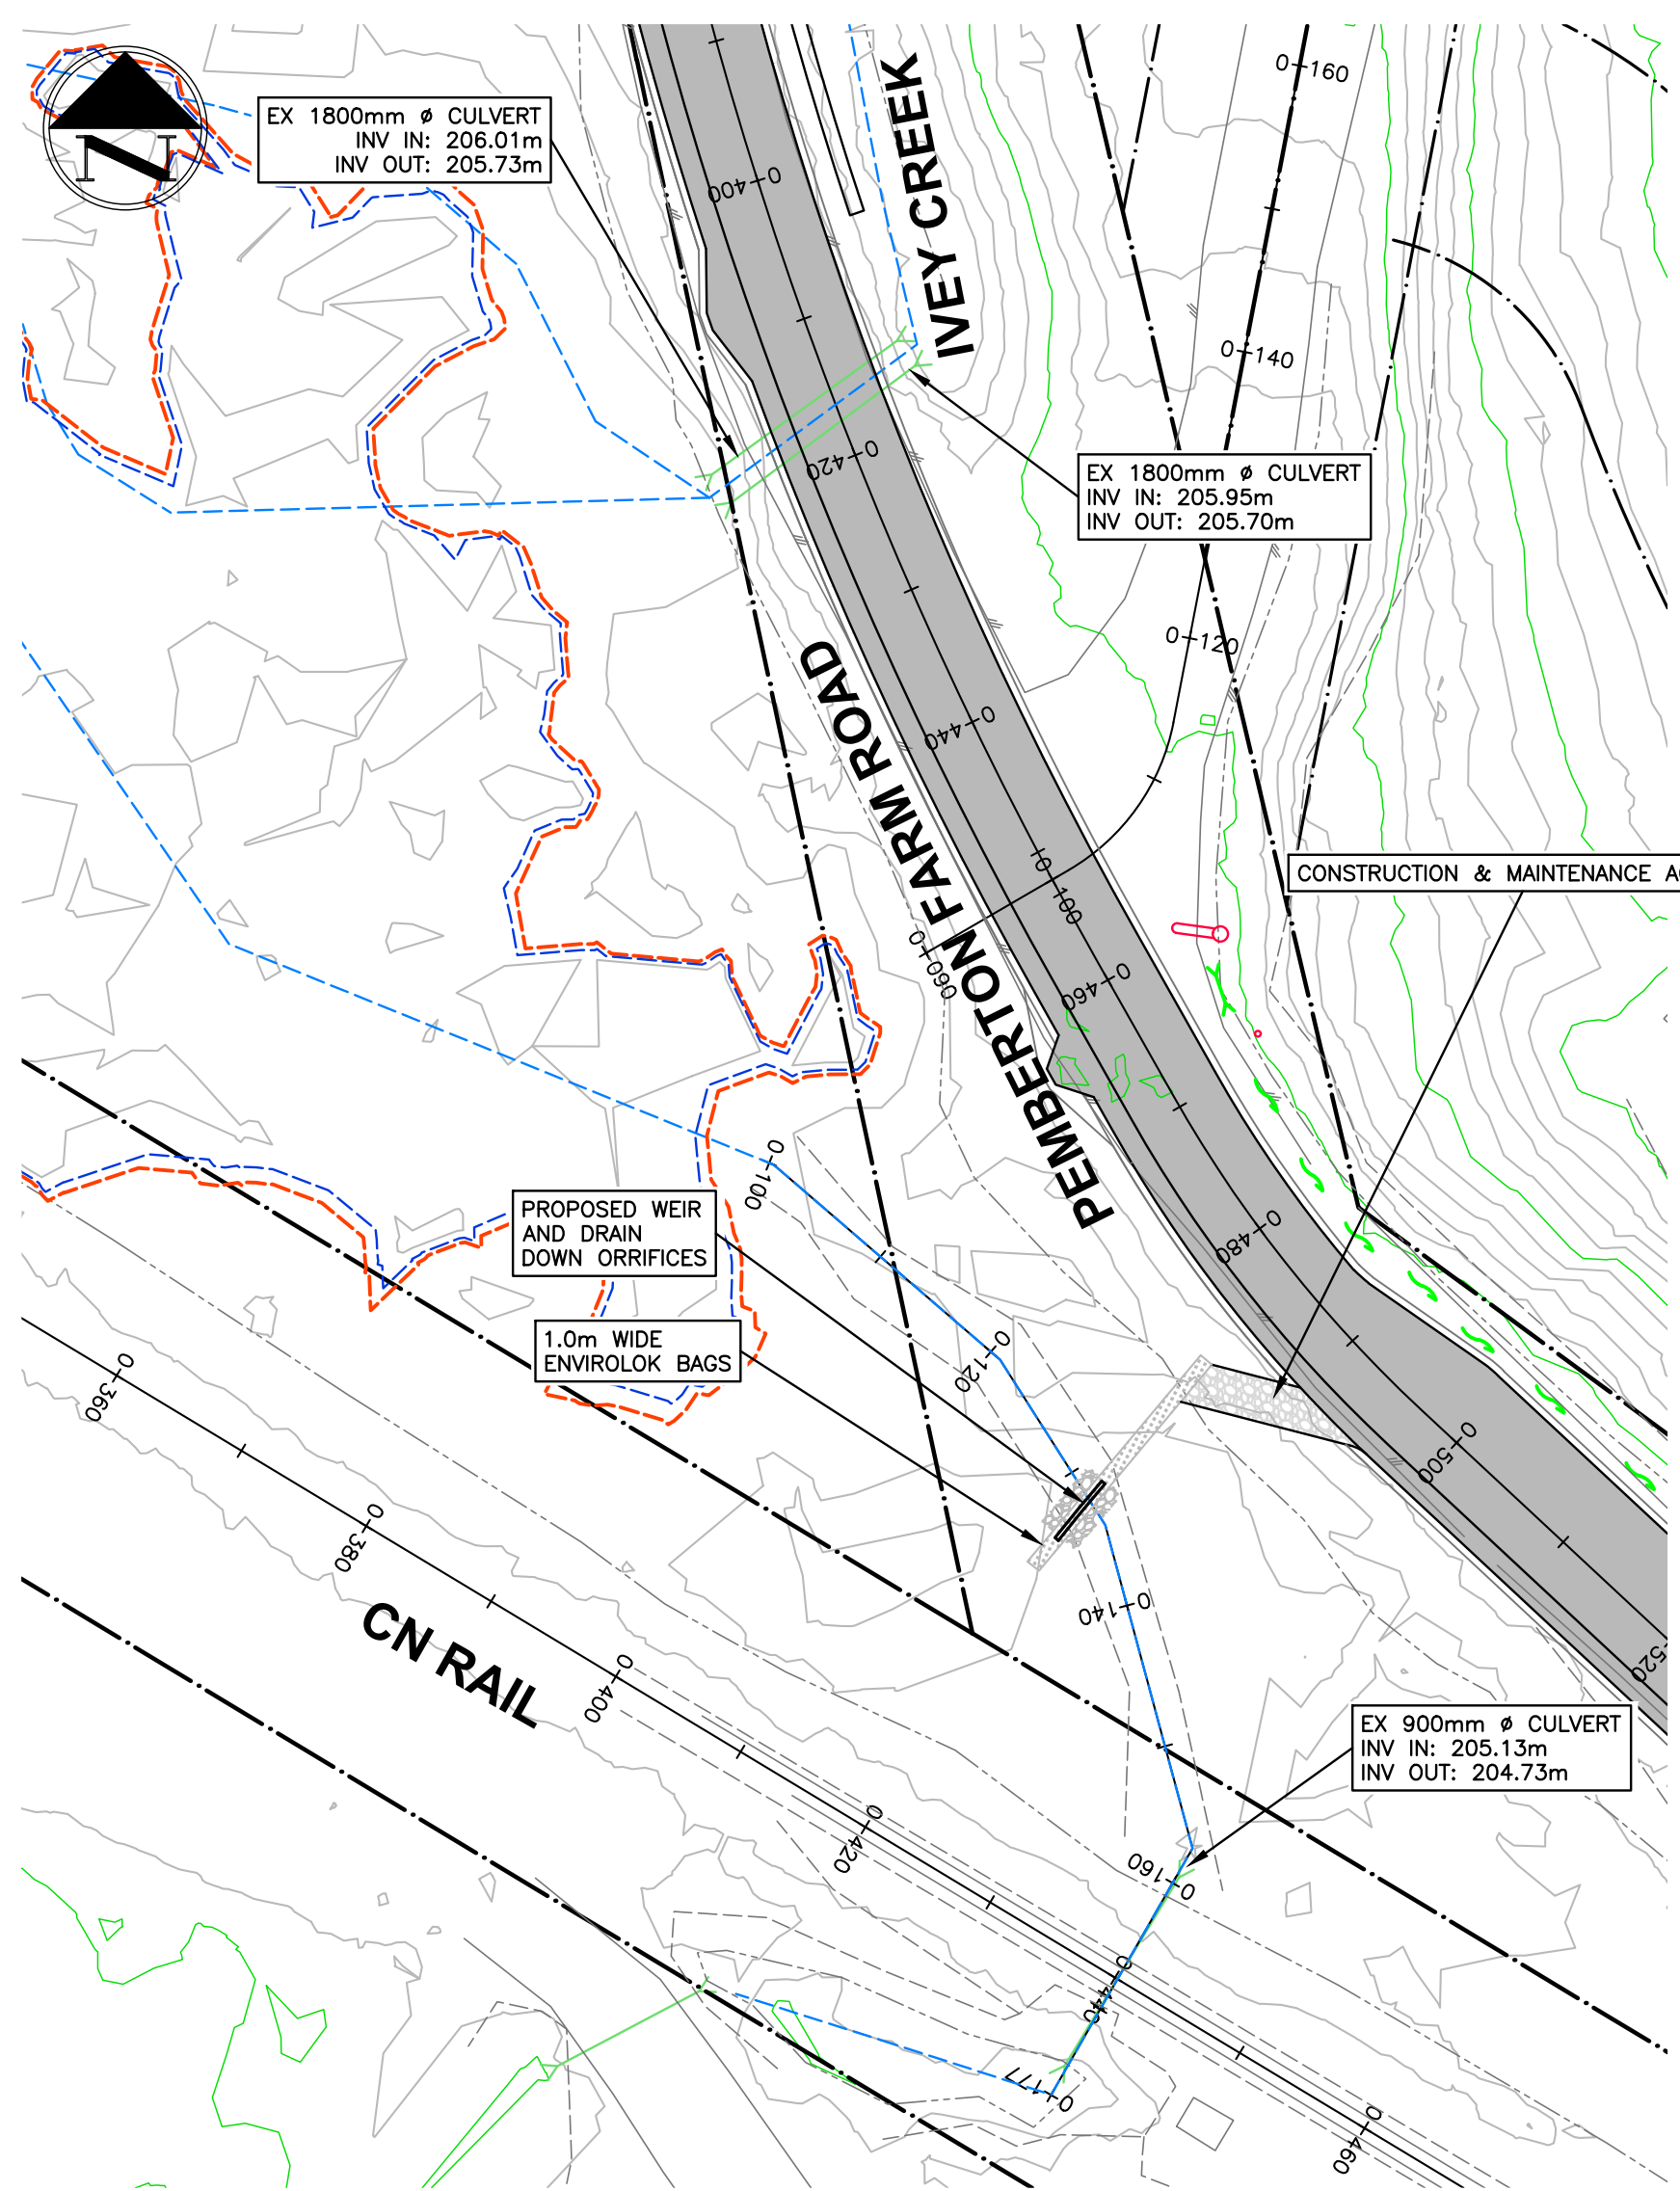

**DRAWING LEGEND**


	EXISTING	PROP.	TO BE REMOVED
LEGAL LINE EASMENT	---	---	---
WATERMAIN	---	---	---
SANITARY	---	---	---
STORM	---	---	---
HYDRO TEL	---	---	---
STREETLIGHT	---	---	---
GAS	---	---	---
<b>EXISTING PROP. TO BE REMOVED</b>			
FIRE HYDRANT	⊗	⊗	⊗
GATE VALVE	⊗	⊗	⊗
AIR VALVE	⊗	⊗	⊗
REDUCER	⊗	⊗	⊗
INSPECTION CHAMBER	⊗	⊗	⊗
CATCHBASIN (STD/SI)	⊗	⊗	⊗
CAP	⊗	⊗	⊗
MANHOLE	⊗	⊗	⊗
POWER POLE	⊗	⊗	⊗
STREETLIGHT	⊗	⊗	⊗

approved

client  
**580049 BC LTD.**

project  
**THE RIDGE AT PEMBERTON PHASE 1 PEMBERTON, BC**

title  
**STORMWATER MANAGEMENT WEIR**

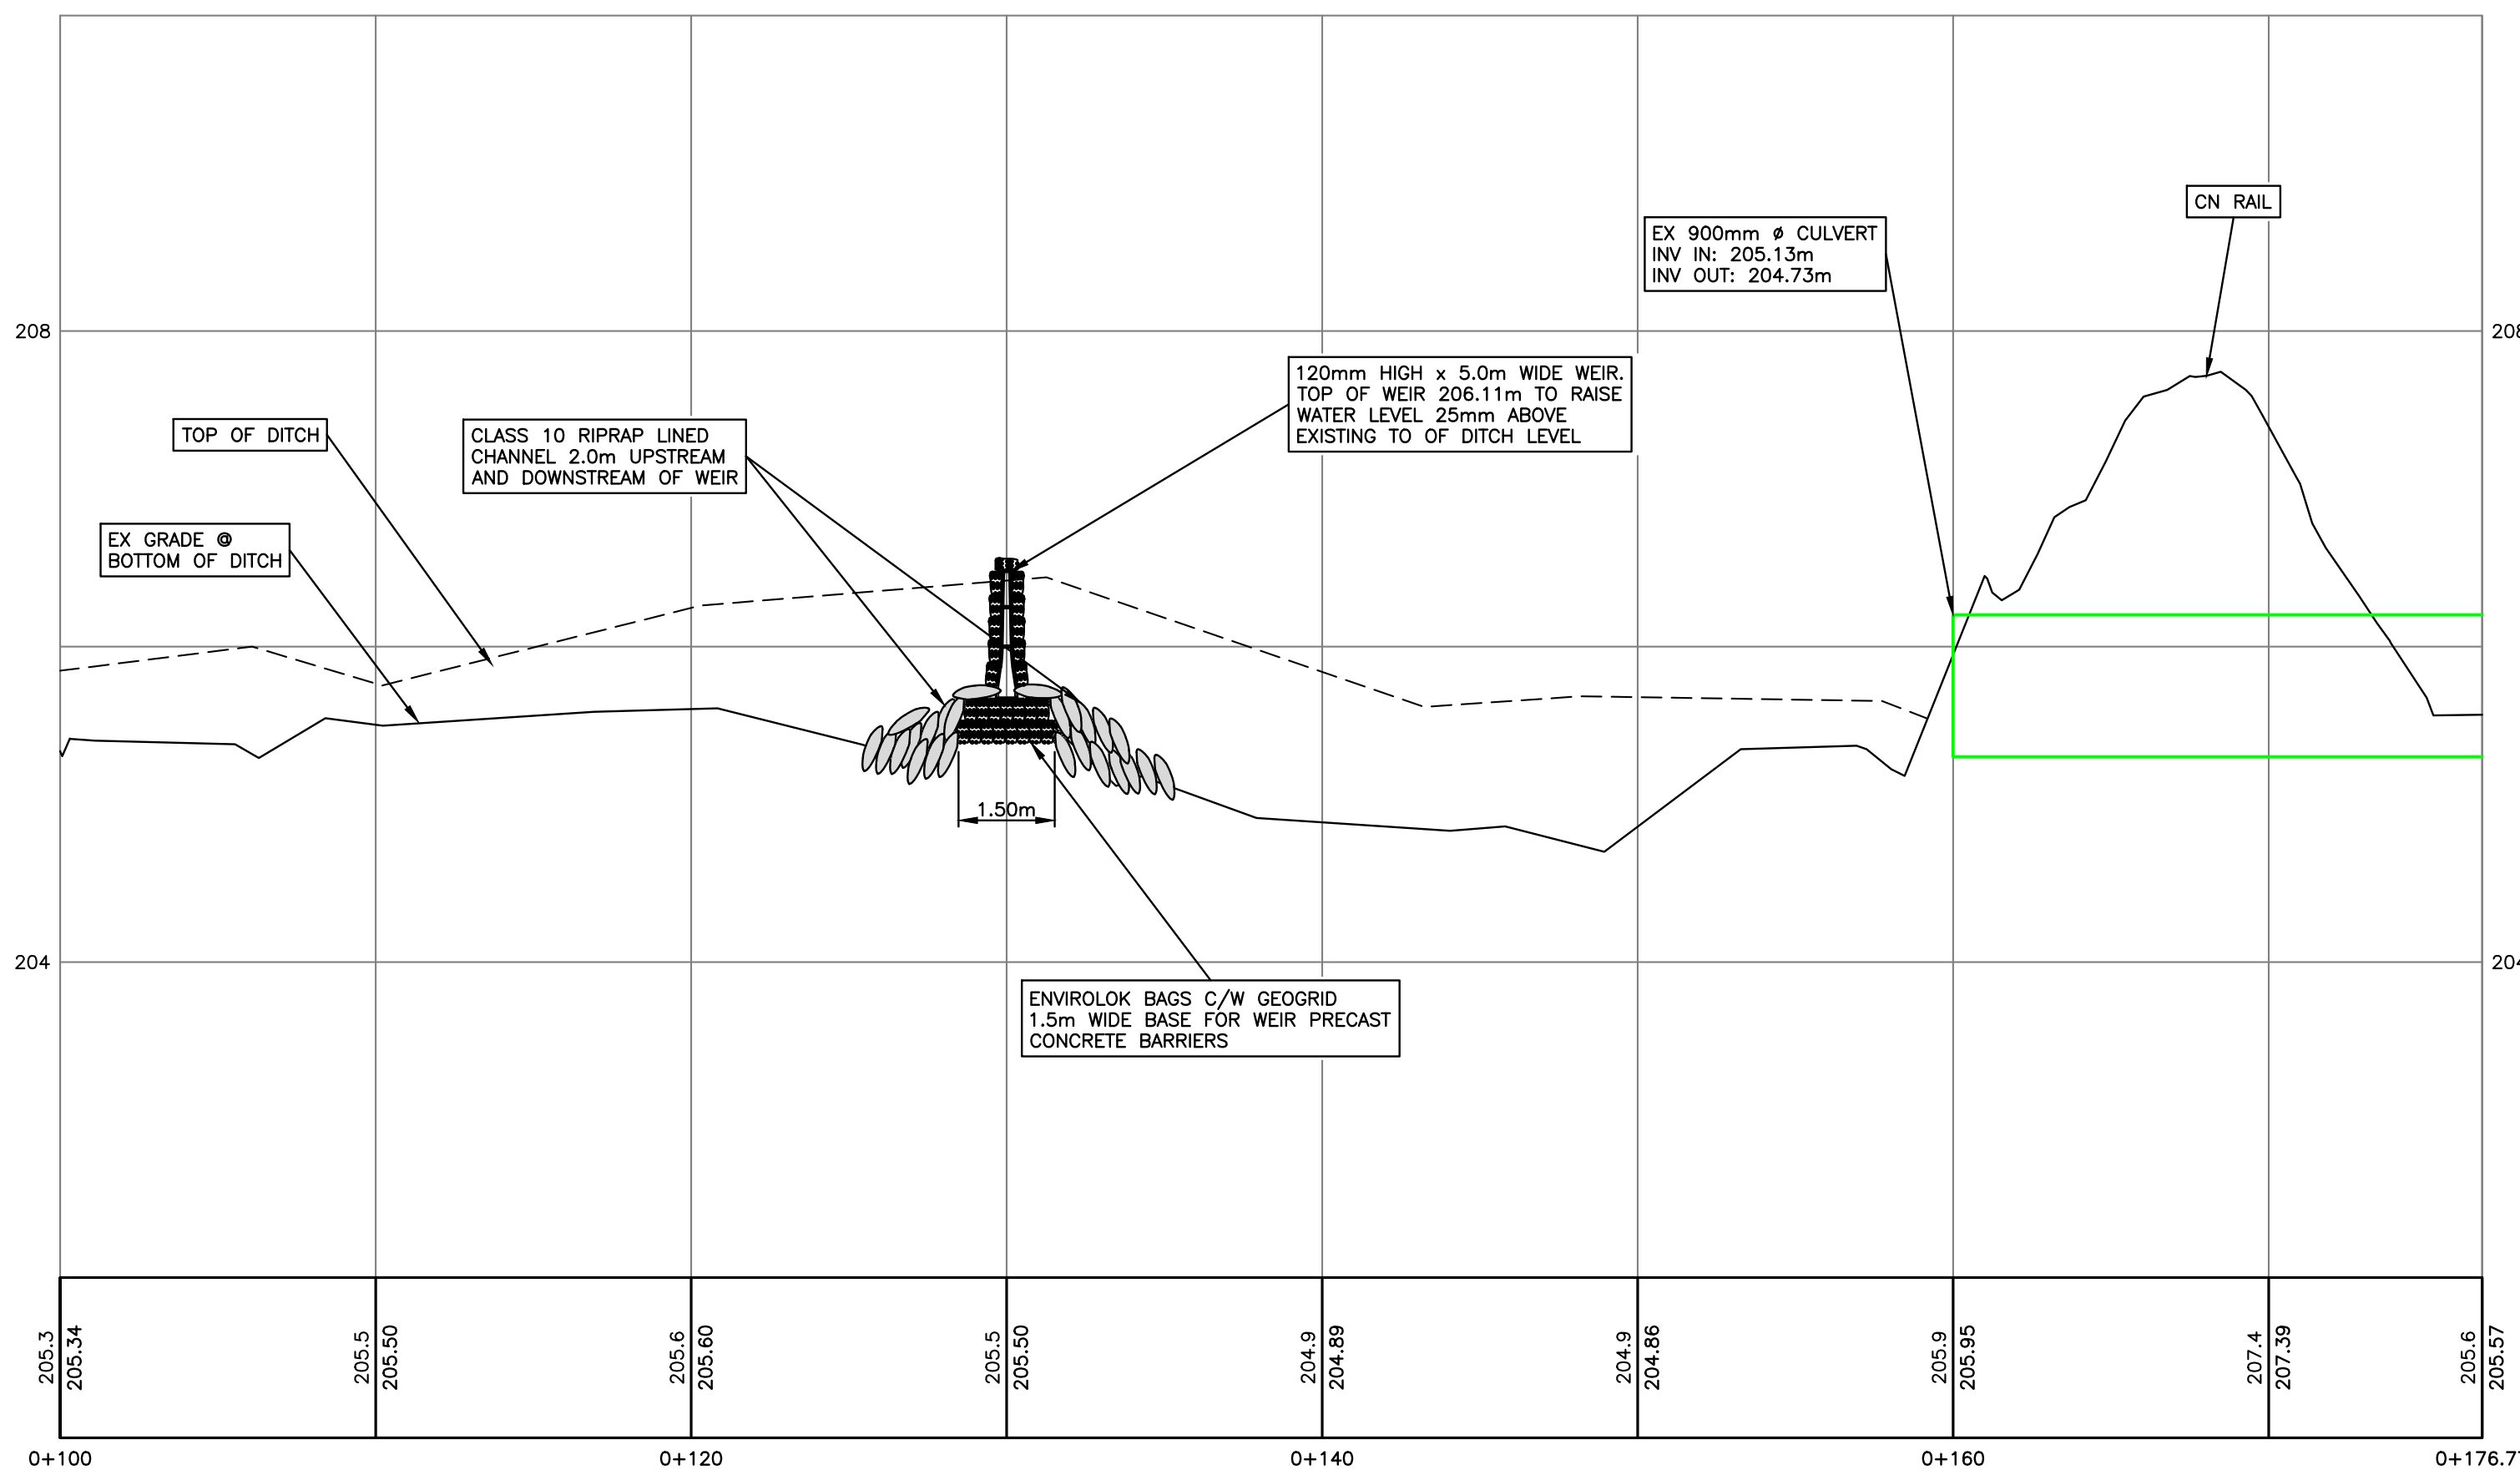

**CATCHMENT A (includes all catchments that flow through the 2-1800 culverts)**

Pre-development	Land Use	AREA(ha):	RUNOFF COEFFICIENT:
	Forest	29.3	0.30
	Forest feeding into MBFSR	27.40	0.30
	Ivey Creek	98.65	0.30
	<b>TOTAL:</b>	<b>155.3</b>	<b>AVERAGE: 0.30</b>

**Pre-development Peak Flows**

Rainfall intensity (I) = 15 mm/hr  
 Time of Concentration = 54 min  
 From Village of P IDF Curve...  
 10 year rainfall intensity = 15 mm/hr  
 10 yr instantaneous Peak flow (Q=CIA) = 1942 l/s

Post-development	Land Use	AREA(ha):	RUNOFF COEFFICIENT:
	Ivey creek forest	98.7	0.30
	Forest feeding into MBFSR	27.4	0.30
	Road	2.6	0.70
	Park	0.2	0.30
	Single Family	9.6	0.45
	Gravel Road	0.3	0.60
	Undeveloped	1.1	0.30
	Reservoir	0.6	0.60
	<b>TOTAL:</b>	<b>155.4</b>	<b>AVERAGE: 0.32</b>

**Post-development Peak Flows**

Rainfall intensity (I) = 15 mm/hr  
 Time of Concentration = 54 min  
 From Village of P IDF Curve...  
 10 year rainfall intensity = 15 mm/hr  
 10 yr instantaneous Peak flow (Q=CIA) = 2056 l/s

10 yr pre development peak flow = 1942 l/s  
 10 yr post development peak flow = 2056 l/s  
 115 l/s

Catchment A Storage Requirement		Rainfall Intensity (mm/hr)	Peak Flow (l/s)	Release Rate (l/s)	Required Storage (m³)
min	Duration	15	2.06	1.942	372
54	3240	13	1.78	1.942	-116
60	3600	11	1.51	1.942	-1261
90	5400	8	1.10	1.942	-3484
120	7200				

Catchment A Storage Requirement = 372 m³

**Rain Barrell Storage**

Total homes = 132 Homes  
 Volume of Storage = 1 m³/barrell  
 Total Storage = 132 m³

**Wetlands Detention**

Storage Required = 240 m³  
 Detention pond Area = 2.6 ha  
 Level raised = 25 mm At top of weir  
 Storage Provided = 650 m³

**Existing Ditch Capacity @ Weir location**

Ditch depth = 0.9 m  
 Left Side slope = 1:1  
 Right Side Slope = 1:1  
 Flow from Hydaflow Express = 949 l/s

Weir To be sized to allow existing ditch flow through while raising the level of the wetlands by 25mm to increase the storage capacity

**Weir & Orifices Sizing**

**Orifices**

Net Head = 0.58 m  
 Orifice Size = 250 mm  
 Flow Through Single Orifice = 103 l/s  
 2 orifices = 205 l/s Upper 2

Net Head = 0.71 m  
 Orifice Size = 250 mm  
 Flow Through Single Orifice = 113 l/s  
 2 orifices = 226 l/s Lower 2

**Weir Flow**

Weir Size = 5.00m long x 120mm deep  
 Flow from Hydaflow Express = 540 l/s  
 Total Flow = 971.7 l/s

no.	(y/m/d)	revision	scale	current rev. #
4	18-02-06	PROJECT RECORDS OFFSITE		KBH
3	17-10-17	PROJECT RECORDS OFFSITE		KBH
2	16-11-01	RE-ISSUED FOR VOP APPROVAL		KBH
1	16-10-21	ISSUED FOR VOP APPROVAL		KBH


Copyright reserved. This drawing and design are, and at all times remain the exclusive property of CREUS ENGINEERING LTD. AND CANNOT BE USED, REPRODUCED OR DISTRIBUTED WITHOUT WRITTEN CONSENT. ©2016 CREUS ENGINEERING LTD.

engineer of record	scale	hor. 1:500	vert. -
K.B.H.			
designed by	file no.	16159	
drawn by	drawing no.	SMP-2	
date		2016-05-13	








AS-CONSTRUCTED INFORMATION  
 CREUS ENGINEERING LTD. CERTIFIES THAT THE WORKS & SERVICES SHOWN ON THESE DRAWINGS WERE CONSTRUCTED IN GENERAL CONFORMANCE WITH THE DRAWINGS & SPECIFICATIONS.  
 AS-CONSTRUCTED SURVEY INFORMATION SHOWN ON THESE DRAWINGS HAVE BEEN PROVIDED BY OTHERS. IT IS THE RESPONSIBILITY OF OTHERS USING THESE DRAWINGS TO CONFIRM THE LOCATION & ELEVATION OF THESE SERVICES.

CURVE TABLE: ROAD A					
CURVE #	RADIUS	LENGTH	I.P.	START POINT	END POINT
C1	35.00	36.58	517119.75, 5574704.16	517100.51, 5574698.11	517134.63, 5574690.55
C2	75.00	86.48	517200.84, 5574630.04	517164.84, 5574662.94	517245.51, 5574649.59
C3	40.00	39.90	517295.71, 5574671.56	517275.75, 5574662.83	517313.88, 5574659.53

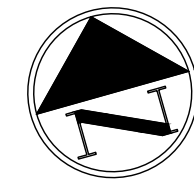


**ROADWORKS NOTES**

- CONTRACTOR TO SUBMIT SEVE TEST AND SOURCE DATA FOR AGGREGATES AND MIX DESIGN FOR ASPHALT AT BEGINNING OF CONTRACT TO ENGINEER FOR REVIEW AND APPROVAL.
- ALL LOOSE AND ORGANIC MATERIAL TO BE EXCAVATED FROM ROADWAY. ALL SUBGRADES TO BE COMPACTED TO 95% MODIFIED PROCTOR DENSITY. CONTRACTOR TO COORDINATE SUBGRADE INSPECTION BY ENGINEER PRIOR TO PLACEMENT OF GRAVEL SUBBASE. ANY WATER SOFTENED SUBGRADE SOIL SHALL BE OVEREXCAVATED AND THE GRADE RESTORED WITH GRANULAR SOILS COMPACTED TO 95% MODIFIED PROCTOR DENSITY.
- THE BASE AND SUBBASE MATERIALS SHALL BE PROPERLY PLACED AND COMPACTED TO A MINIMUM OF 95% OF MODIFIED PROCTOR DRY DENSITY (ASTM D1557).
- THE CONTRACTOR WILL GIVE THE ENGINEER 48 HOURS NOTICE PRIOR TO SUBGRADE PROOF ROLL, BASE COMPACTION AND PAVING.
- THE CONTRACTOR MUST NOTIFY ENGINEER 48 HOURS PRIOR TO STARTING CONSTRUCTION TO ESTABLISH AN INSPECTION SCHEDULE.
- ALL CUTS IN EXISTING ASPHALT REQUIRED FOR TRENCHING SHALL BE VERTICAL & MATCHING EXISTING THICKNESS (MINIMUM 80mm ASPHALT OR DESIGN THICKNESS UNLESS OTHERWISE SPECIFIED) AFTER BACKFILL AND COMPACTION.
- ALL PAVEMENTS, BOULEVARDS, DRIVEWAYS, FENCES, ETC. ARE TO BE RESTORED TO ORIGINAL CONDITION WHEN NO IMPROVEMENT IS PROPOSED UNDER THIS CONTRACT. CONTRACTOR TO ROUGHGRADE THE BOULEVARDS AT THE SAME TIME AS ROAD GRADING.
- CHANGES IN GRADE TO BE FORMED WITH SMOOTH CURVES.
- ALL MANHOLE LIDS, VALVE COVERS, CATCHBASIN RIMS AND LIDS OF OTHER STRUCTURES TO BE SET AT FIRST LIFT ROAD ELEVATIONS AND RAISED WHEN FINAL LIFT INSTALLED.
- COVERS FOR INSPECTION CHAMBERS AND VALVE RISERS IN DRIVEWAYS SHALL BE SUITABLE FOR TRAVELED AREAS.
- PAVING CAN ONLY PROCEED IN THE PRESENCE OF THE ENGINEERS INSPECTOR.
- ENSURE ALL NEW PAVEMENT WORKS ARE KEYED INTO EXISTING ASPHALT AS PER MMCD STANDARD DRAWING G5.

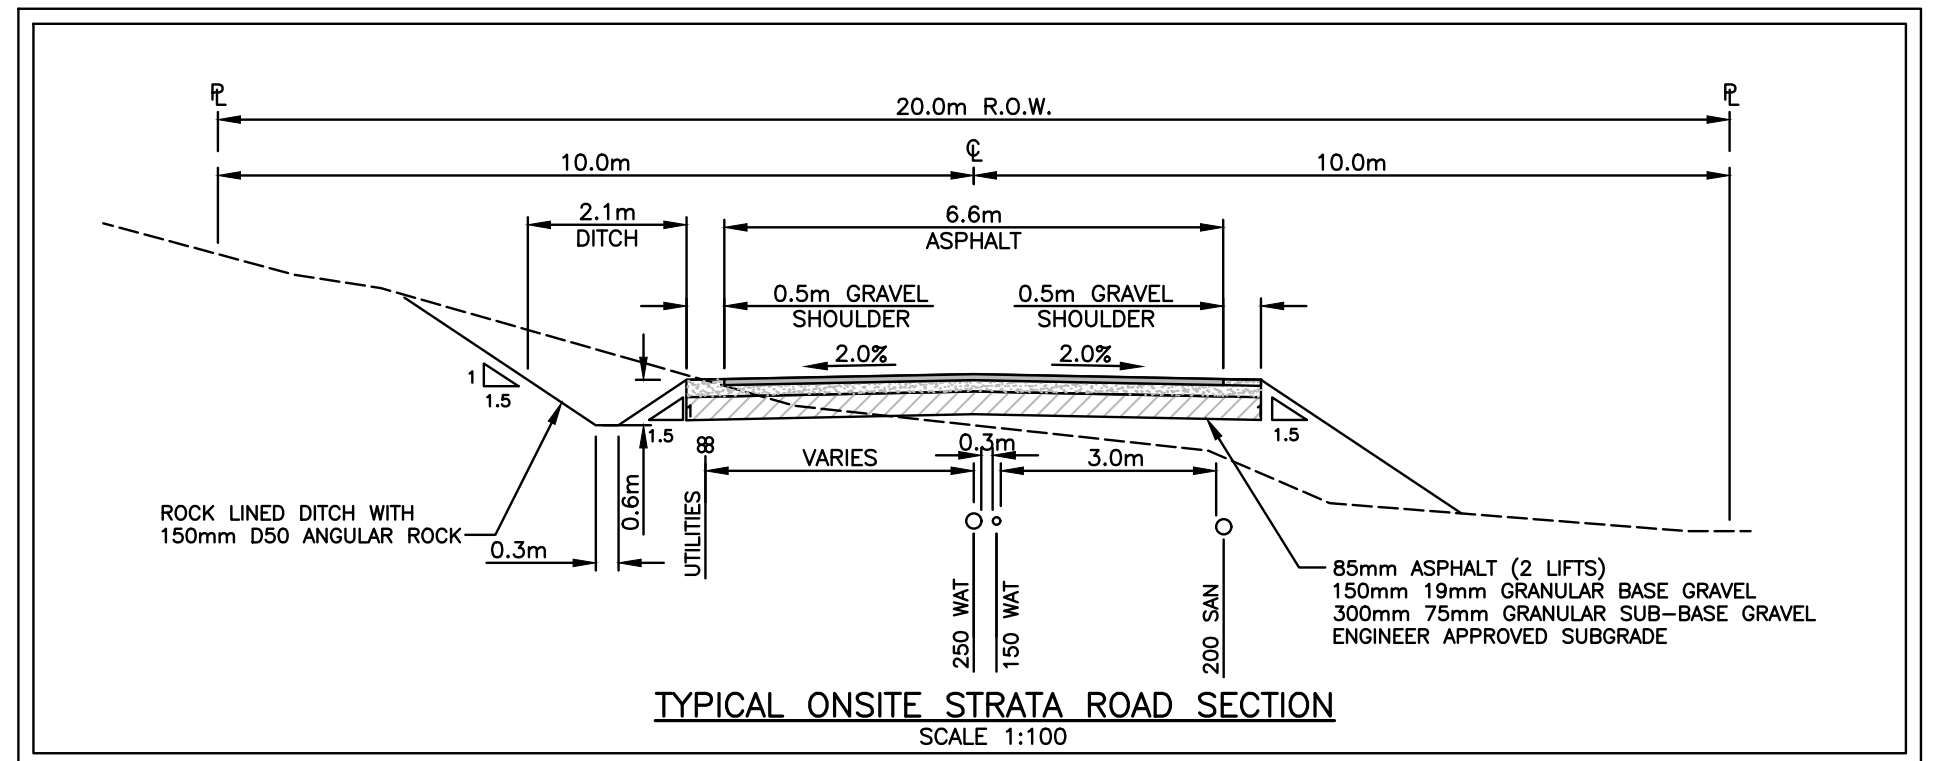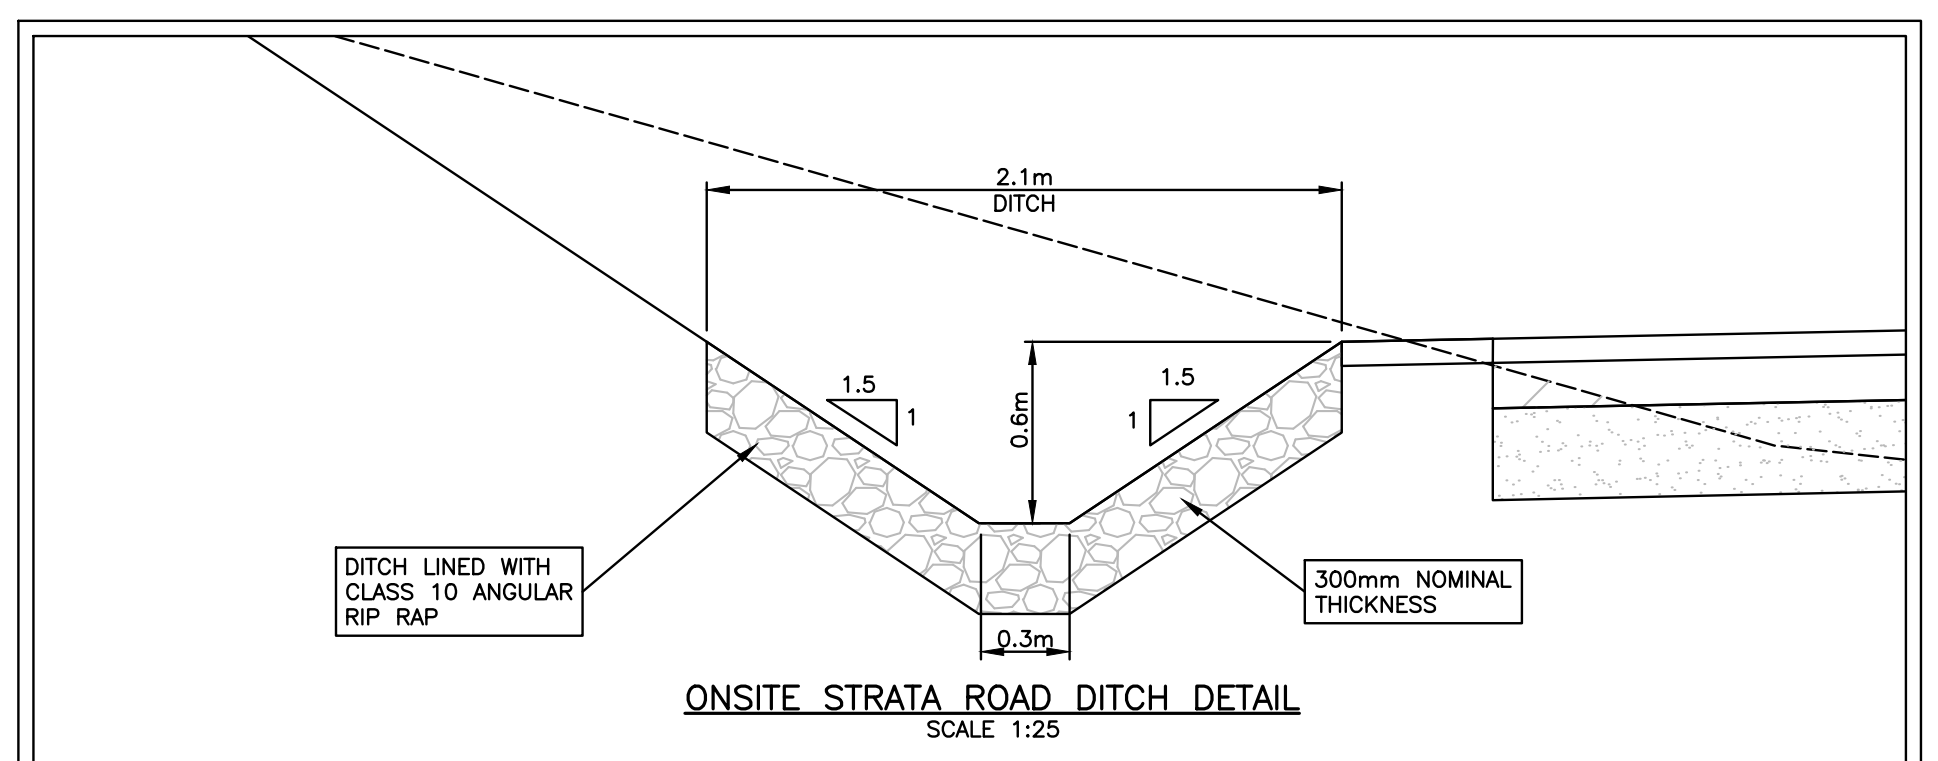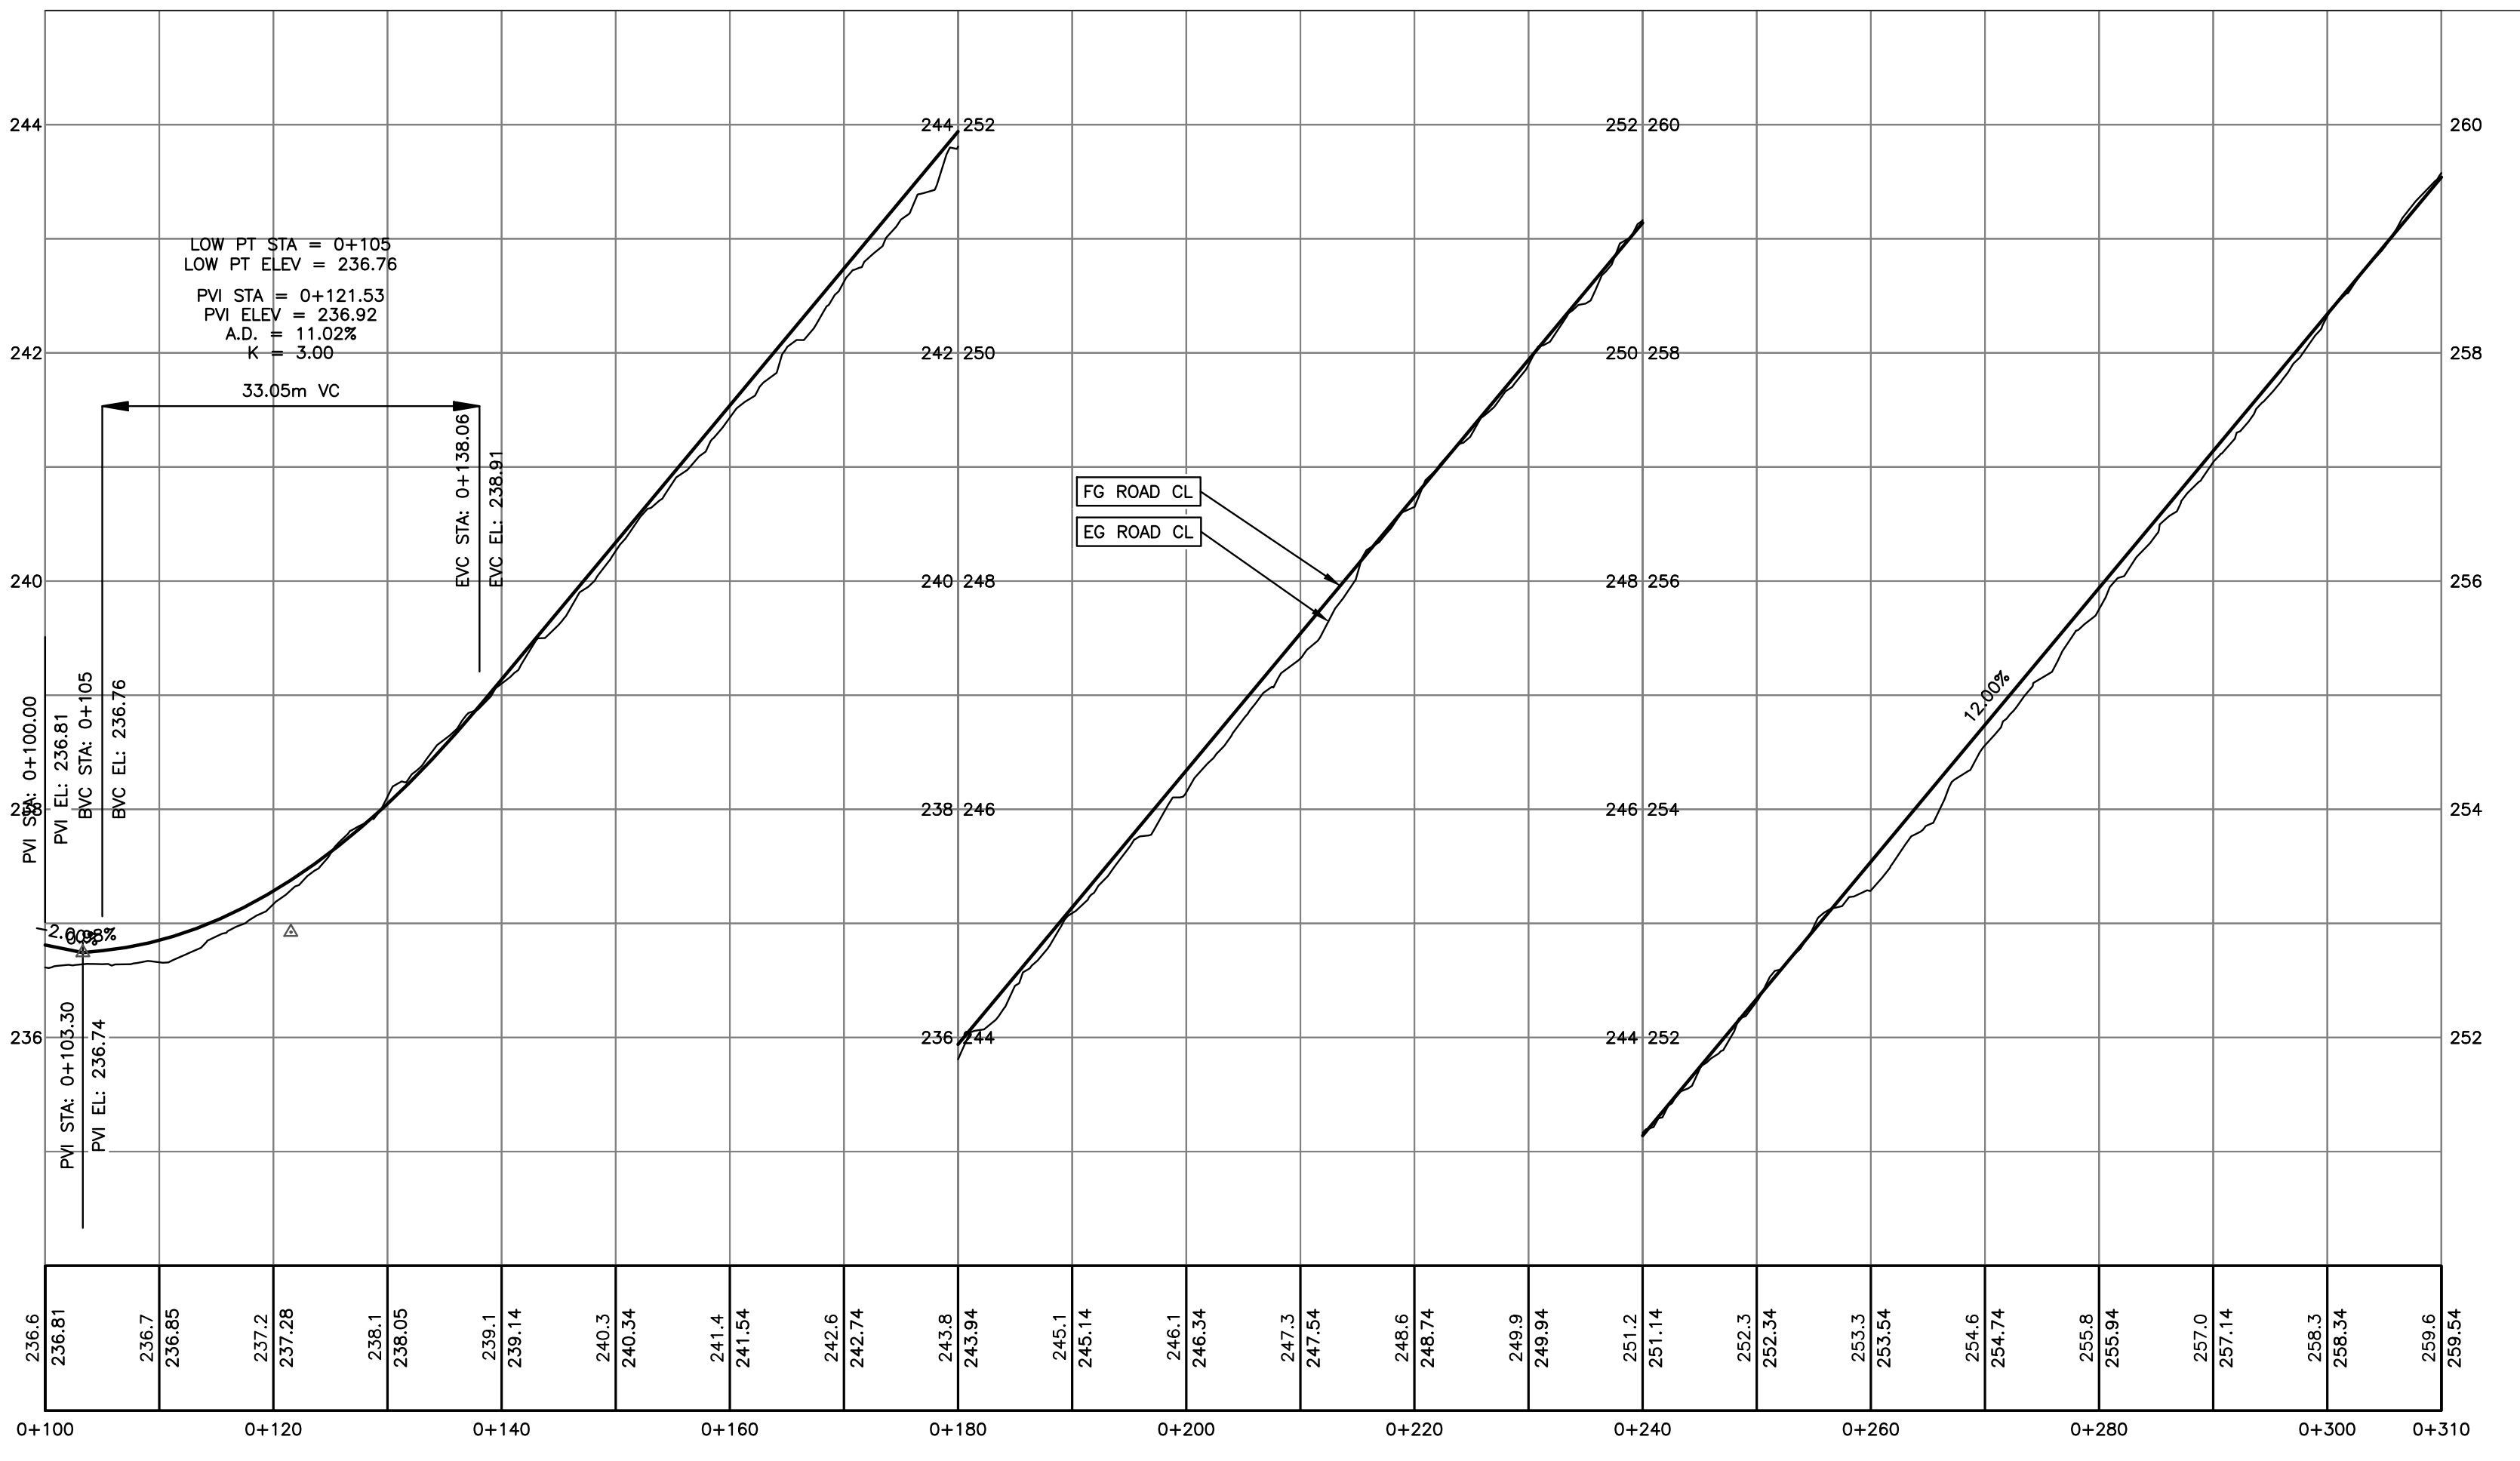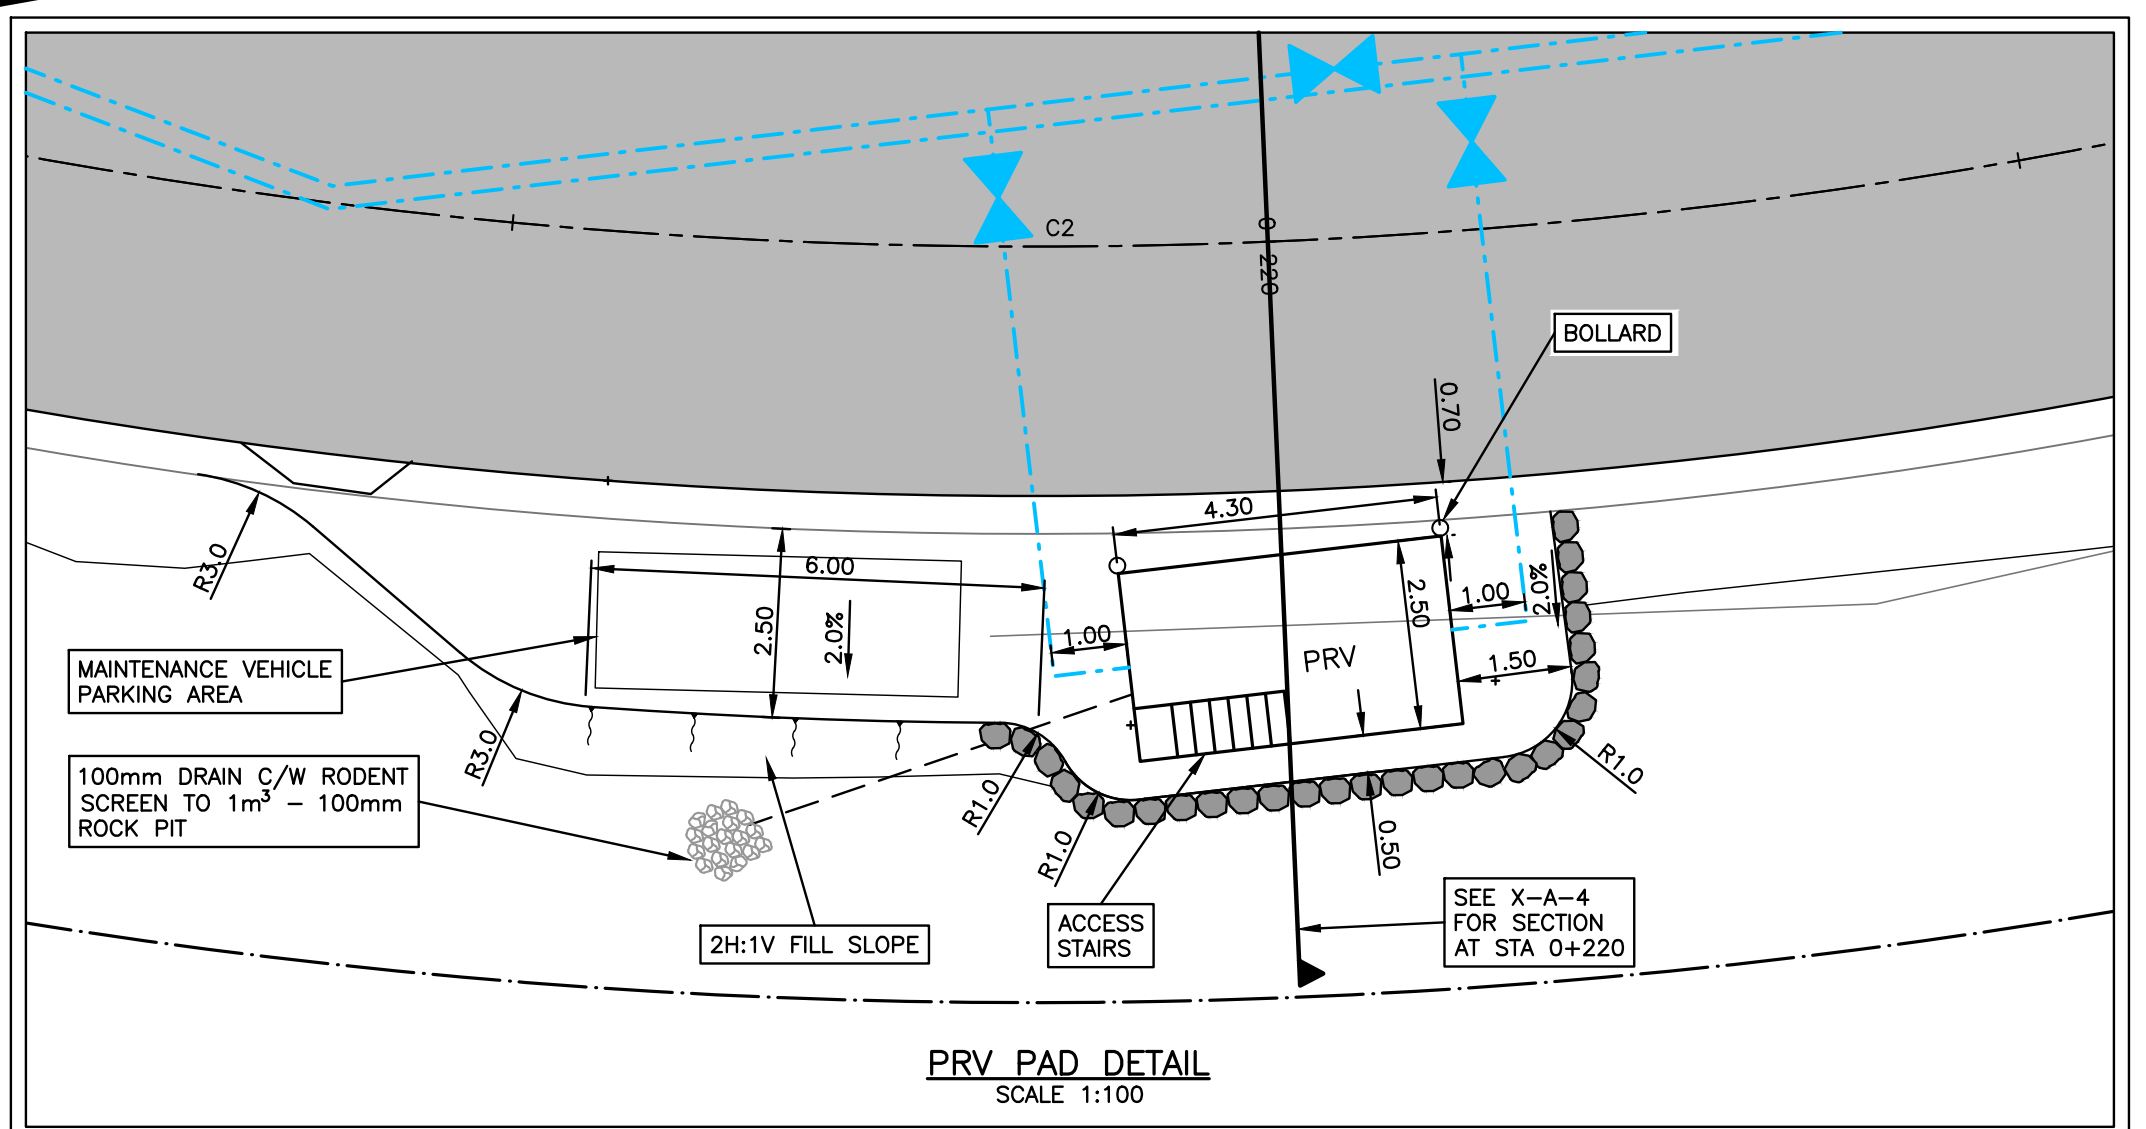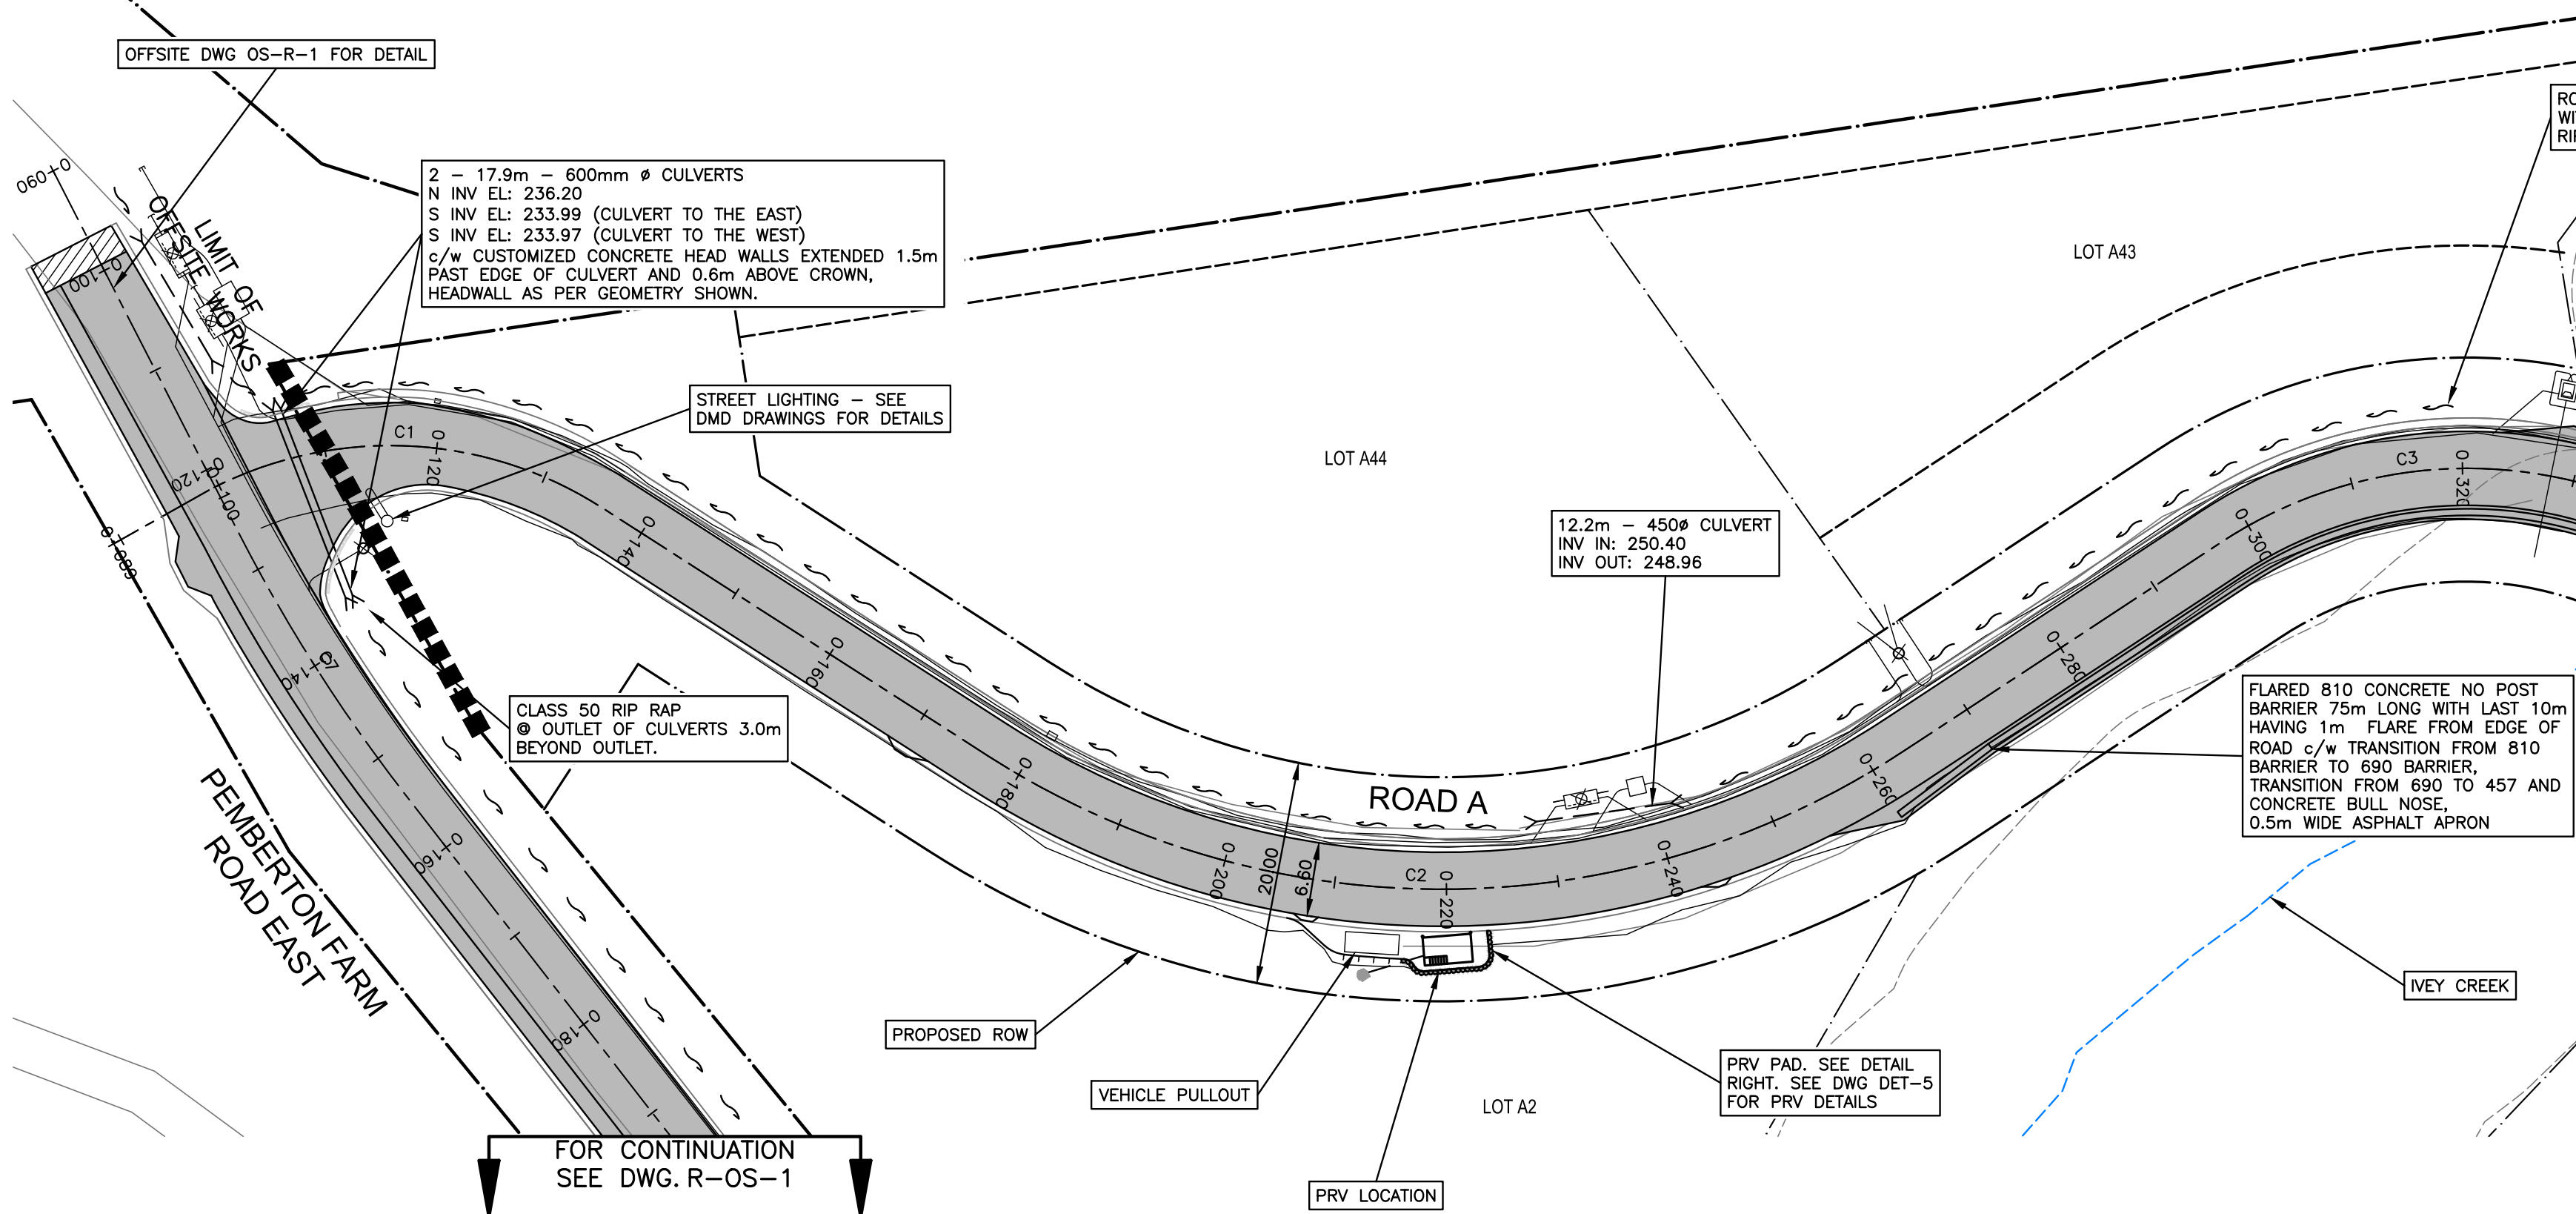

Civil Engineers & Project Managers  
 SUITE 200-901 16TH ST WEST, NORTH VANCOUVER BC, V7P1R2  
 PH: 604-987-0070 WEBSITE: www.creus.ca

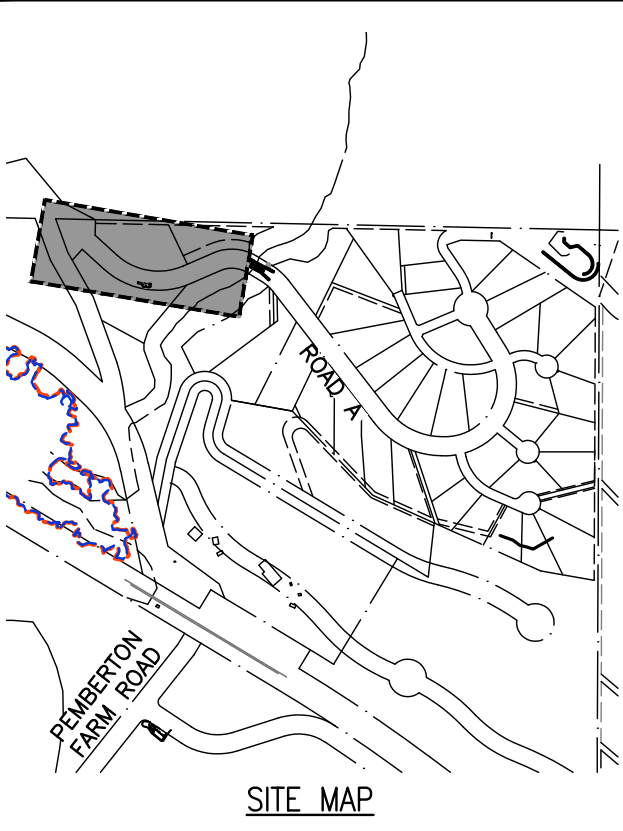

**DRAWING LEGEND**

	EXISTING	PROP.	TO BE REMOVED
LEGAL LINE	---	---	---
EASEMENT	---	---	---
WATERMAIN	---	---	---
SANITARY	---	---	---
STORM	---	---	---
HYDRO	---	---	---
TEL	---	---	---
STREETLIGHT	---	---	---
GAS	---	---	---
FIRE HYDRANT	---	---	---
GATE VALVE	---	---	---
AIR VALVE	---	---	---
REDUCER	---	---	---
INSPECTION CHAMBER	---	---	---
CATCHBASIN (STD/SI)	---	---	---
CAP	---	---	---
MANHOLE	---	---	---
POWER POLE	---	---	---
STREETLIGHT	---	---	---

approved

client  
**580049 BC LTD.**

project  
**THE RIDGE AT PEMBERTON PHASE 1 PEMBERTON, BC**

title  
**ROADWORKS ROAD A (STA 0+100-0+310)**

no.	(y/m/d)	revision	chk'd
18	18-02-06	PROJECT RECORDS OFFSITE	KBH
17	18-02-06	PROJECT RECORDS ONSITE	KBH
16	17-11-24	REVISED FOR BARRIER UPDATE	KBH
15	17-10-17	PROJECT RECORDS OFFSITE	KBH
14	17-03-07	REISSUED FOR CONSTRUCTION OFFSITE	KBH
13	17-02-27	ISSUED FOR CONSTRUCTION ONSITE	KBH
12	17-01-18	REISSUED FOR ADDENDA 1	KBH
11	16-11-09	REISSUED FOR CONSTRUCTION ONSITE	KBH

engineer of record: K.B.H. scales: hor: 1:500 vert: 1:50  
 designed by: N.G.B. file no.: **16159**  
 drawn by: R.J.L. drawing no.: **R-A-1**  
 date: 2016-05-13



AS-CONSTRUCTED INFORMATION  
 CREUS ENGINEERING LTD. CERTIFIES THAT THE WORKS & SERVICES SHOWN ON THESE DRAWINGS WERE CONSTRUCTED IN GENERAL CONFORMANCE WITH THE DRAWINGS & SPECIFICATIONS.  
 AS-CONSTRUCTED SURVEY INFORMATION SHOWN ON THESE DRAWINGS HAVE BEEN PROVIDED BY OTHERS. IT IS THE RESPONSIBILITY OF OTHERS USING THESE DRAWINGS TO CONFIRM THE LOCATION & ELEVATION OF THESE SERVICES.

SEE DRAWING KEY-1 FOR GENERAL NOTES


CURVE TABLE: OFFSITE ROAD					
CURVE #	RADIUS	LENGTH	L.P.	START POINT	END POINT
C7	150.00	28.03	517106.41, 5574680.58	517102.20, 5574693.99	517113.04, 5574668.19
C8	100.00	15.28	517141.41, 5574615.16	517137.80, 5574621.91	517143.95, 5574607.93
C9	200.00	47.53	517167.36, 5574541.40	517159.44, 5574563.93	517169.76, 5574517.65

ROADWORKS NOTES

- CONTRACTOR TO SUBMIT SIEVE TEST AND SOURCE DATA FOR AGGREGATES AND MIX DESIGN FOR ASPHALT AT BEGINNING OF CONTRACT TO ENGINEER FOR REVIEW AND APPROVAL.
- ALL LOOSE AND ORGANIC MATERIAL TO BE EXCAVATED FROM ROADWAY. ALL SUBGRADES TO BE COMPACTED TO 95% MODIFIED PROCTOR DENSITY. CONTRACTOR TO COORDINATE SUBGRADE INSPECTION BY ENGINEER PRIOR TO PLACEMENT OF GRAVEL SUBBASE. ANY WATER SOFTENED SUBGRADE SOIL SHALL BE OVEREXCAVATED AND THE GRADE RESTORED WITH GRANULAR SOILS COMPACTED TO 95% MODIFIED PROCTOR DENSITY.
- THE BASE AND SUBBASE MATERIALS SHALL BE PROPERLY PLACED AND COMPACTED TO A MINIMUM OF 95% OF MODIFIED PROCTOR DRY DENSITY (ASTM D1557).
- THE CONTRACTOR WILL GIVE THE ENGINEER 48 HOURS NOTICE PRIOR TO SUBGRADE PROOF ROLL, BASE COMPACTATION AND PAVING.
- THE CONTRACTOR MUST NOTIFY ENGINEER 48 HOURS PRIOR TO STARTING CONSTRUCTION TO ESTABLISH AN INSPECTION SCHEDULE.
- ALL CUTS IN EXISTING ASPHALT REQUIRED FOR TRENCHING SHALL BE VERTICAL & MATCHING EXISTING THICKNESS (MINIMUM 80mm ASPHALT OR DESIGN THICKNESS UNLESS OTHERWISE SPECIFIED) AFTER BACKFILL AND COMPACTION.
- ALL PAVEMENTS, BOULEVARDS, DRIVEWAYS, FENCES, ETC. ARE TO BE RESTORED TO ORIGINAL CONDITION WHEN NO IMPROVEMENT IS PROPOSED UNDER THIS CONTRACT. CONTRACTOR TO ROUGHGRADE THE BOULEVARDS AT THE SAME TIME AS ROAD GRADING.
- CHANGES IN GRADE TO BE FORMED WITH SMOOTH CURVES.
- ALL MANHOLE LIDS, VALVE COVERS, CATCHBASIN RIMS AND LIDS OF OTHER STRUCTURES TO BE SET AT FIRST LIFT ROAD ELEVATIONS AND RAISED WHEN FINAL LIFT INSTALLED.
- COVERS FOR INSPECTION CHAMBERS AND VALVE RISERS IN DRIVEWAYS SHALL BE SUITABLE FOR TRAVELED AREAS.
- PAVING CAN ONLY PROCEED IN THE PRESENCE OF THE ENGINEERS INSPECTOR.
- ENSURE ALL NEW PAVEMENT WORKS ARE KEYED INTO EXISTING ASPHALT AS PER MMCD STANDARD DRAWING G5.





**CREUS**  
 Engineering

Civil Engineers & Project Managers  
 SUITE 200-901 16TH ST WEST, NORTH VANCOUVER BC, V7P1R2  
 PH: 604-987-0070 WEBSITE: www.creus.ca

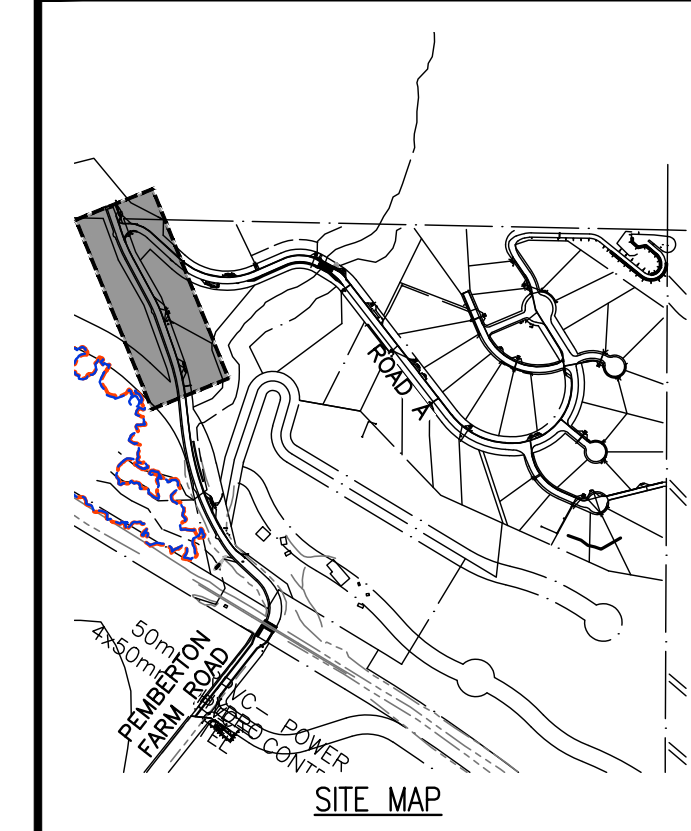

DRAWING LEGEND

	EXISTING	PROP.	TO BE REMOVED
LEGAL LINE	---	---	---
EASMENT	---	---	---
WATERMAIN	---	---	---
SANITARY	---	---	---
STORM	---	---	---
HYDRO	---	---	---
TEL	---	---	---
STREETLIGHT	---	---	---
GAS	---	---	---
	EXISTING	PROP.	TO BE REMOVED
FIRE HYDRANT	⊗	⊗	⊗
GATE VALVE	⊗	⊗	⊗
AIR VALVE	⊗	⊗	⊗
REDUCER	⊗	⊗	⊗
INSPECTION CHAMBER	⊗	⊗	⊗
CATCHBASIN (STD/SI)	⊗	⊗	⊗
CAP	⊗	⊗	⊗
MANHOLE	⊗	⊗	⊗
POWER POLE	⊗	⊗	⊗
STREETLIGHT	⊗	⊗	⊗

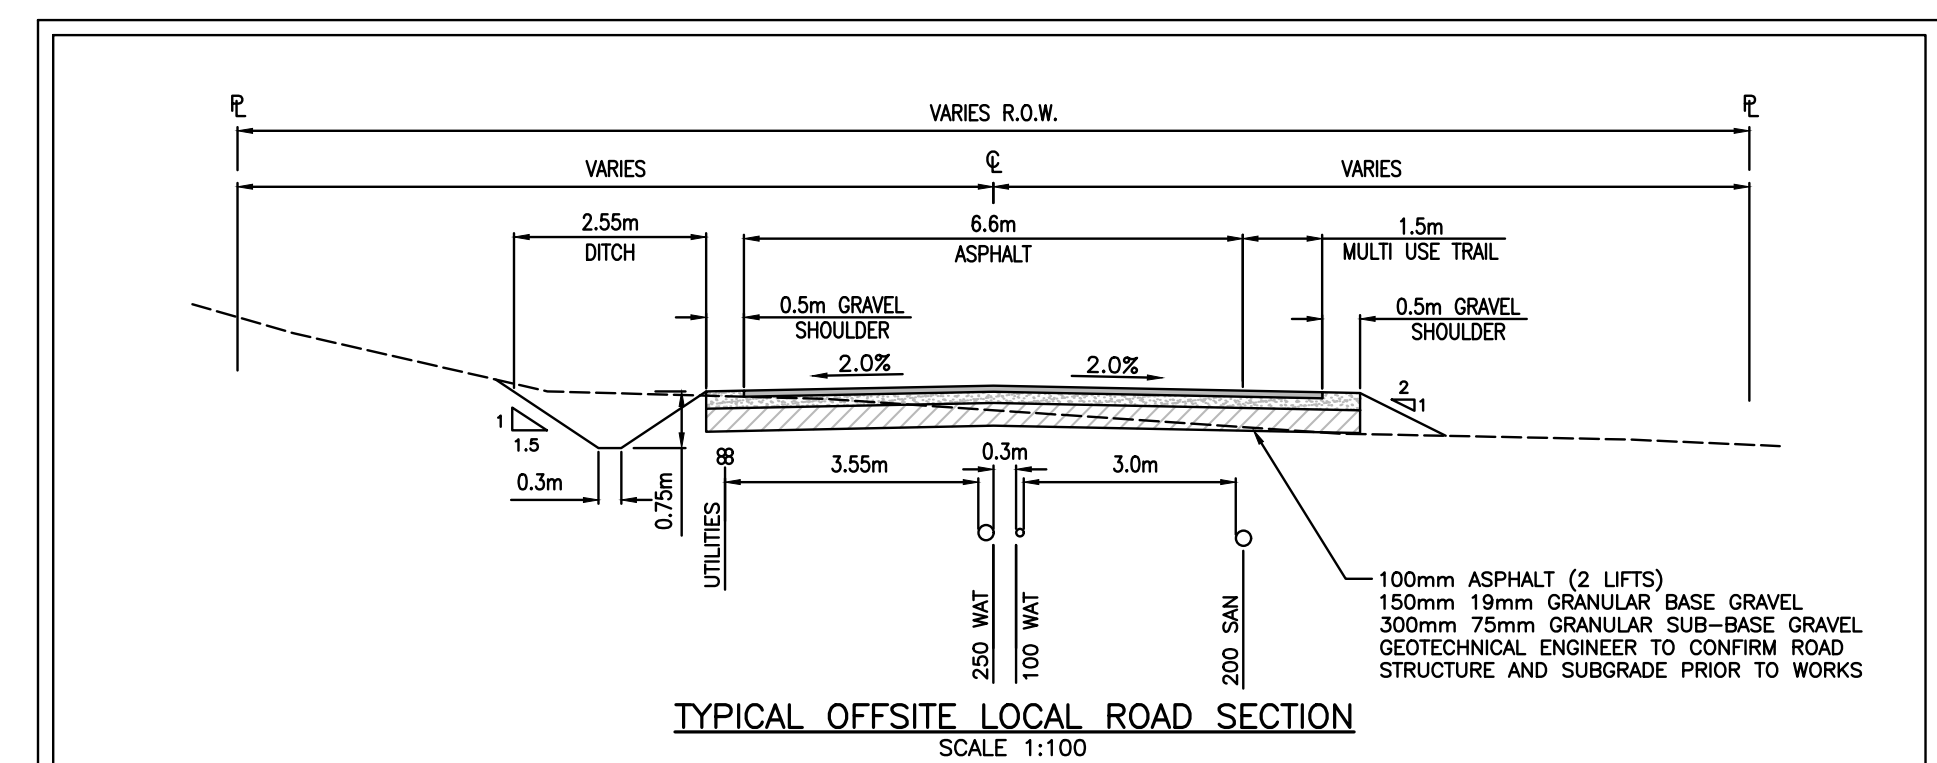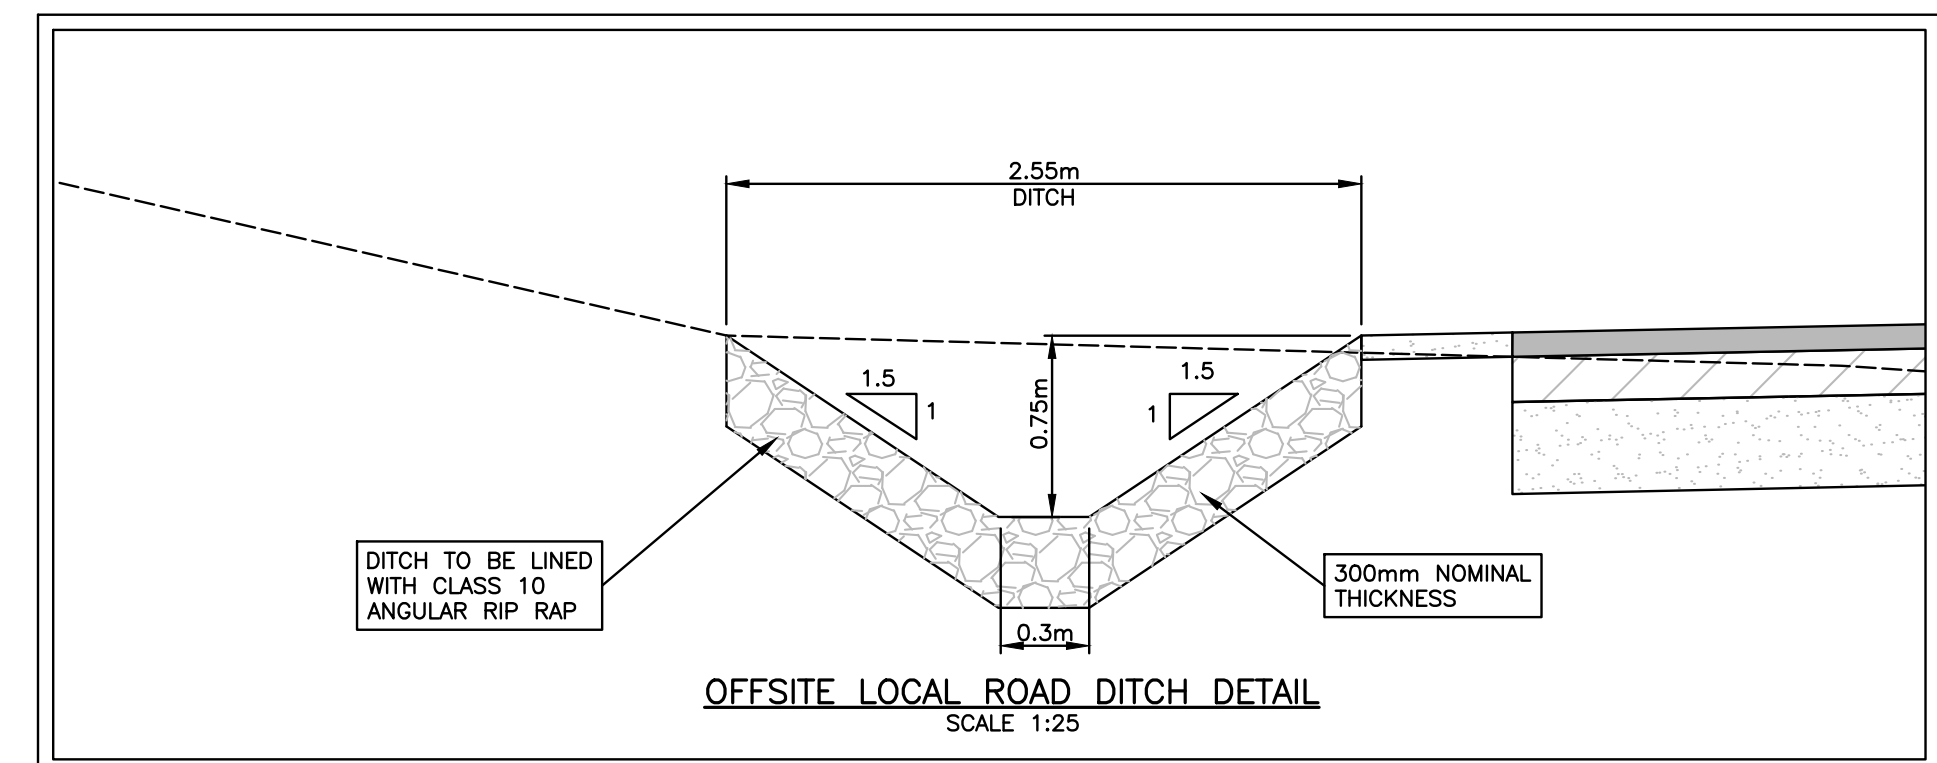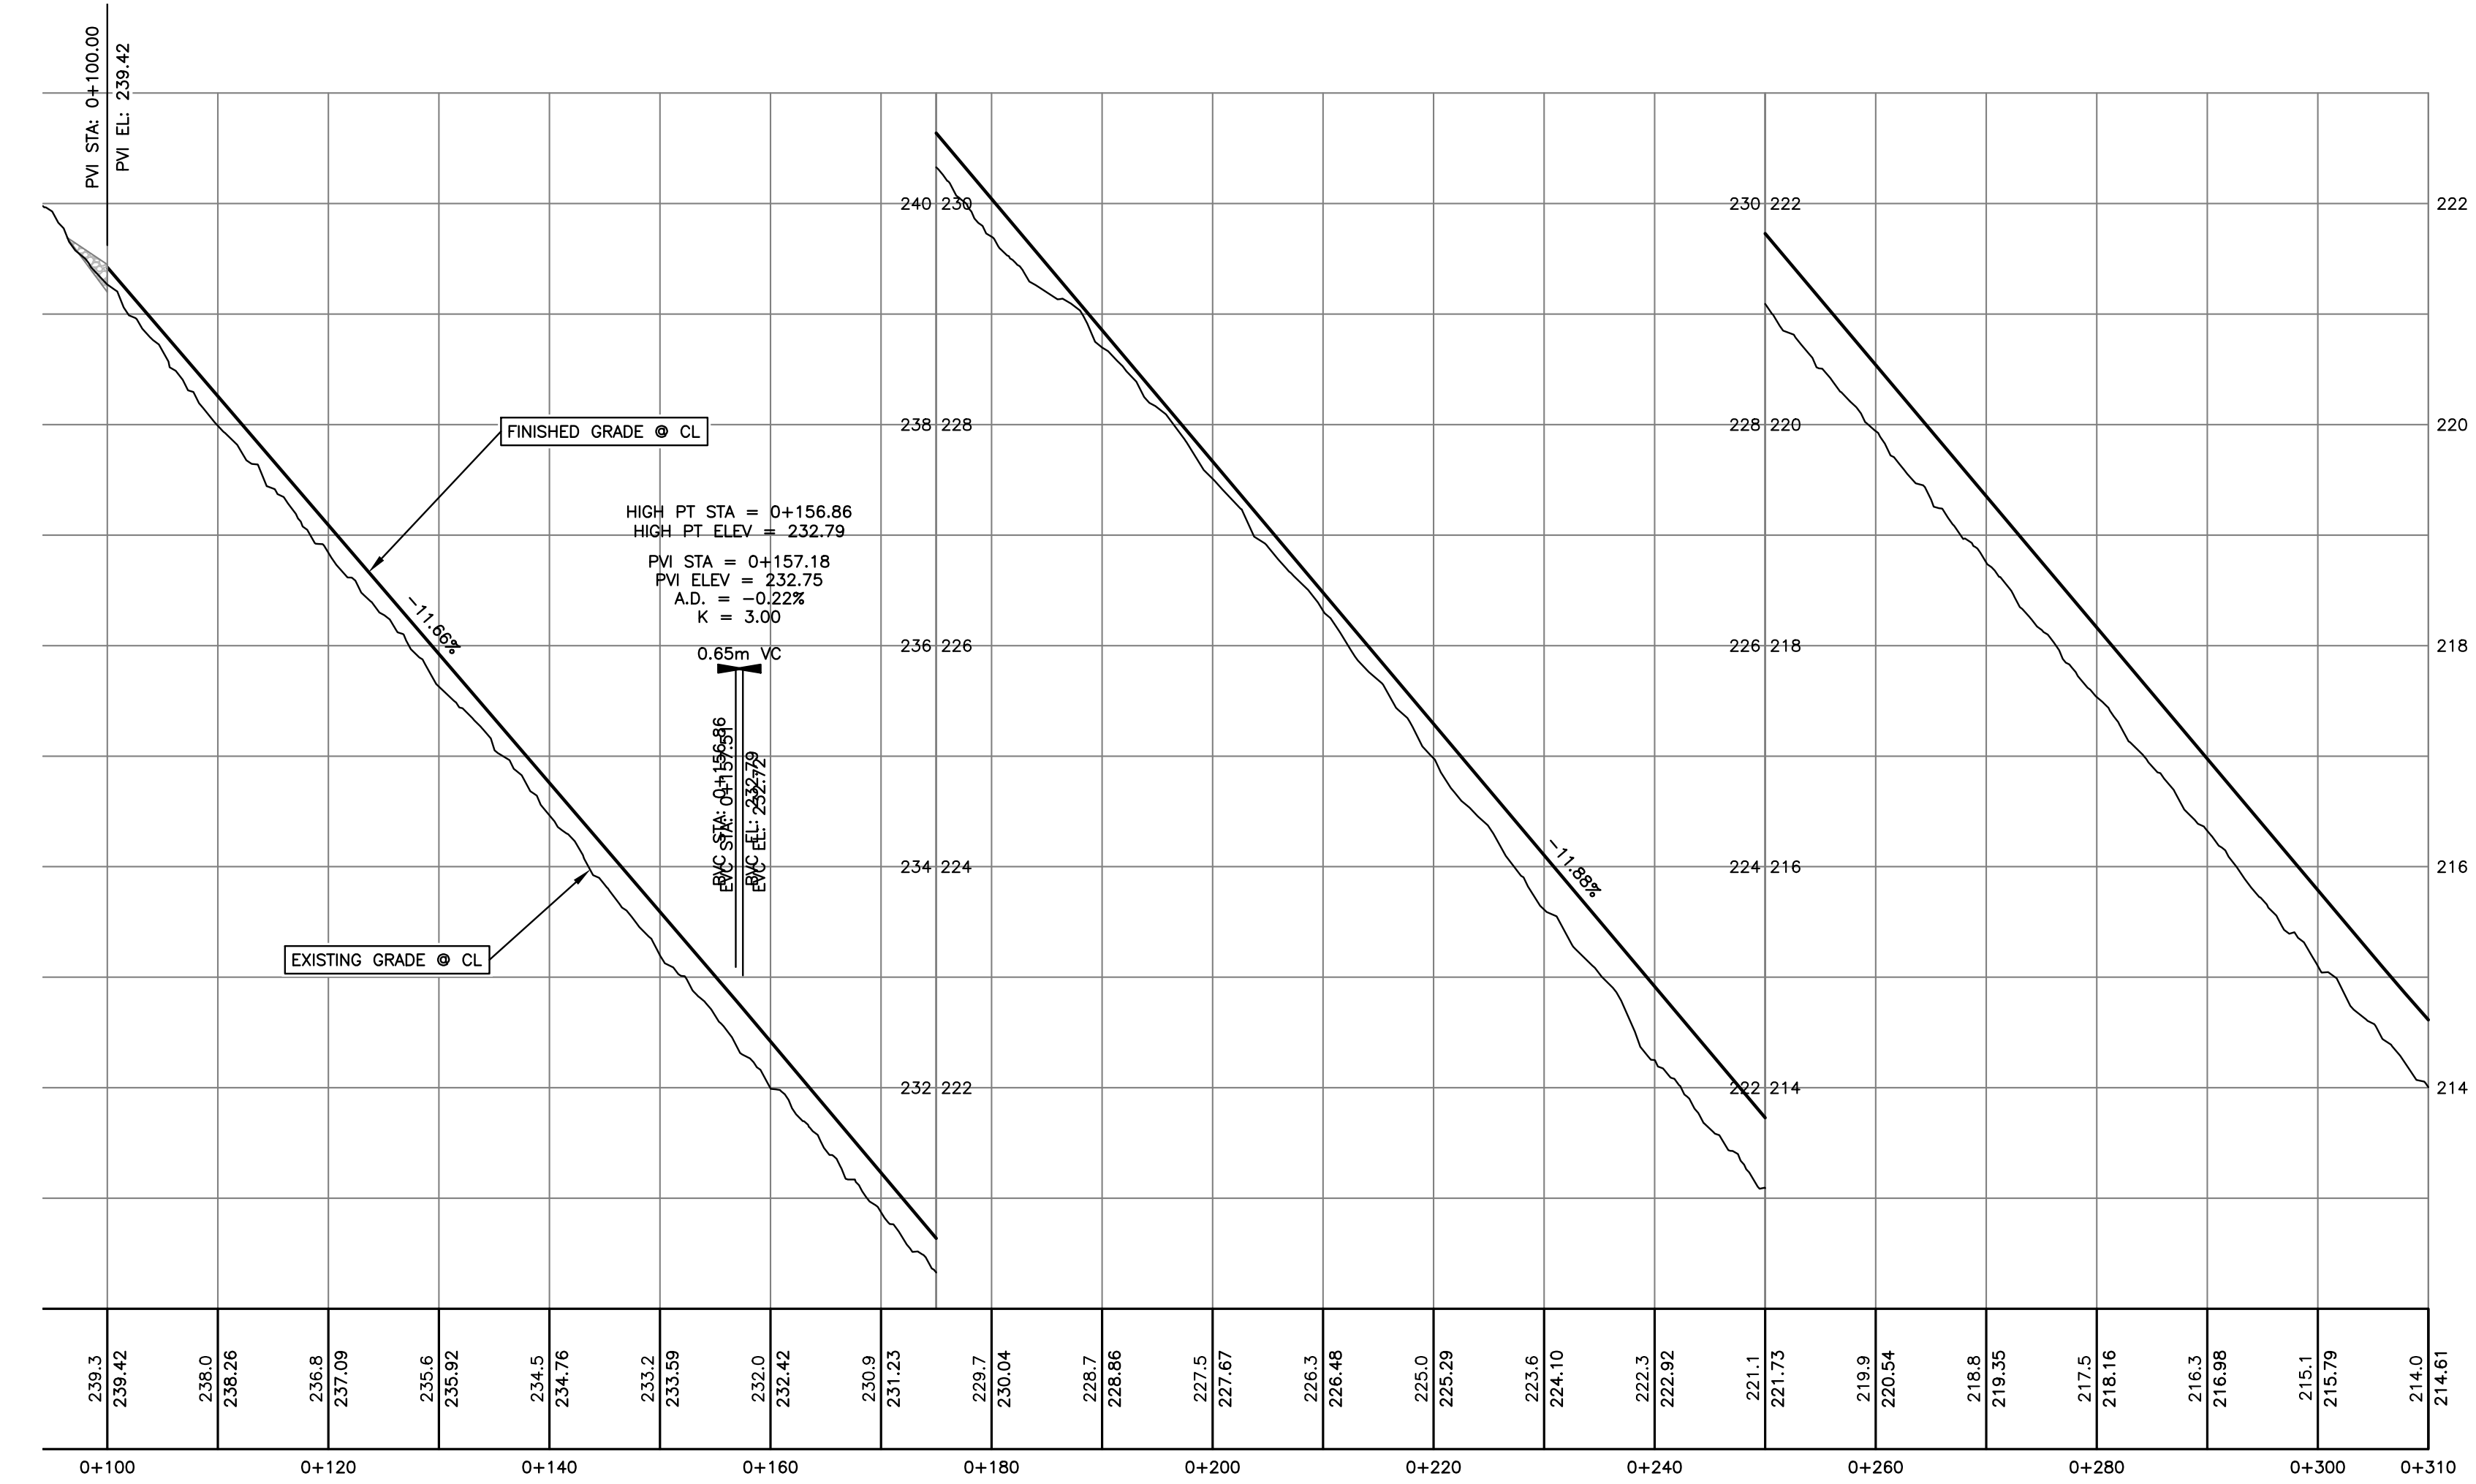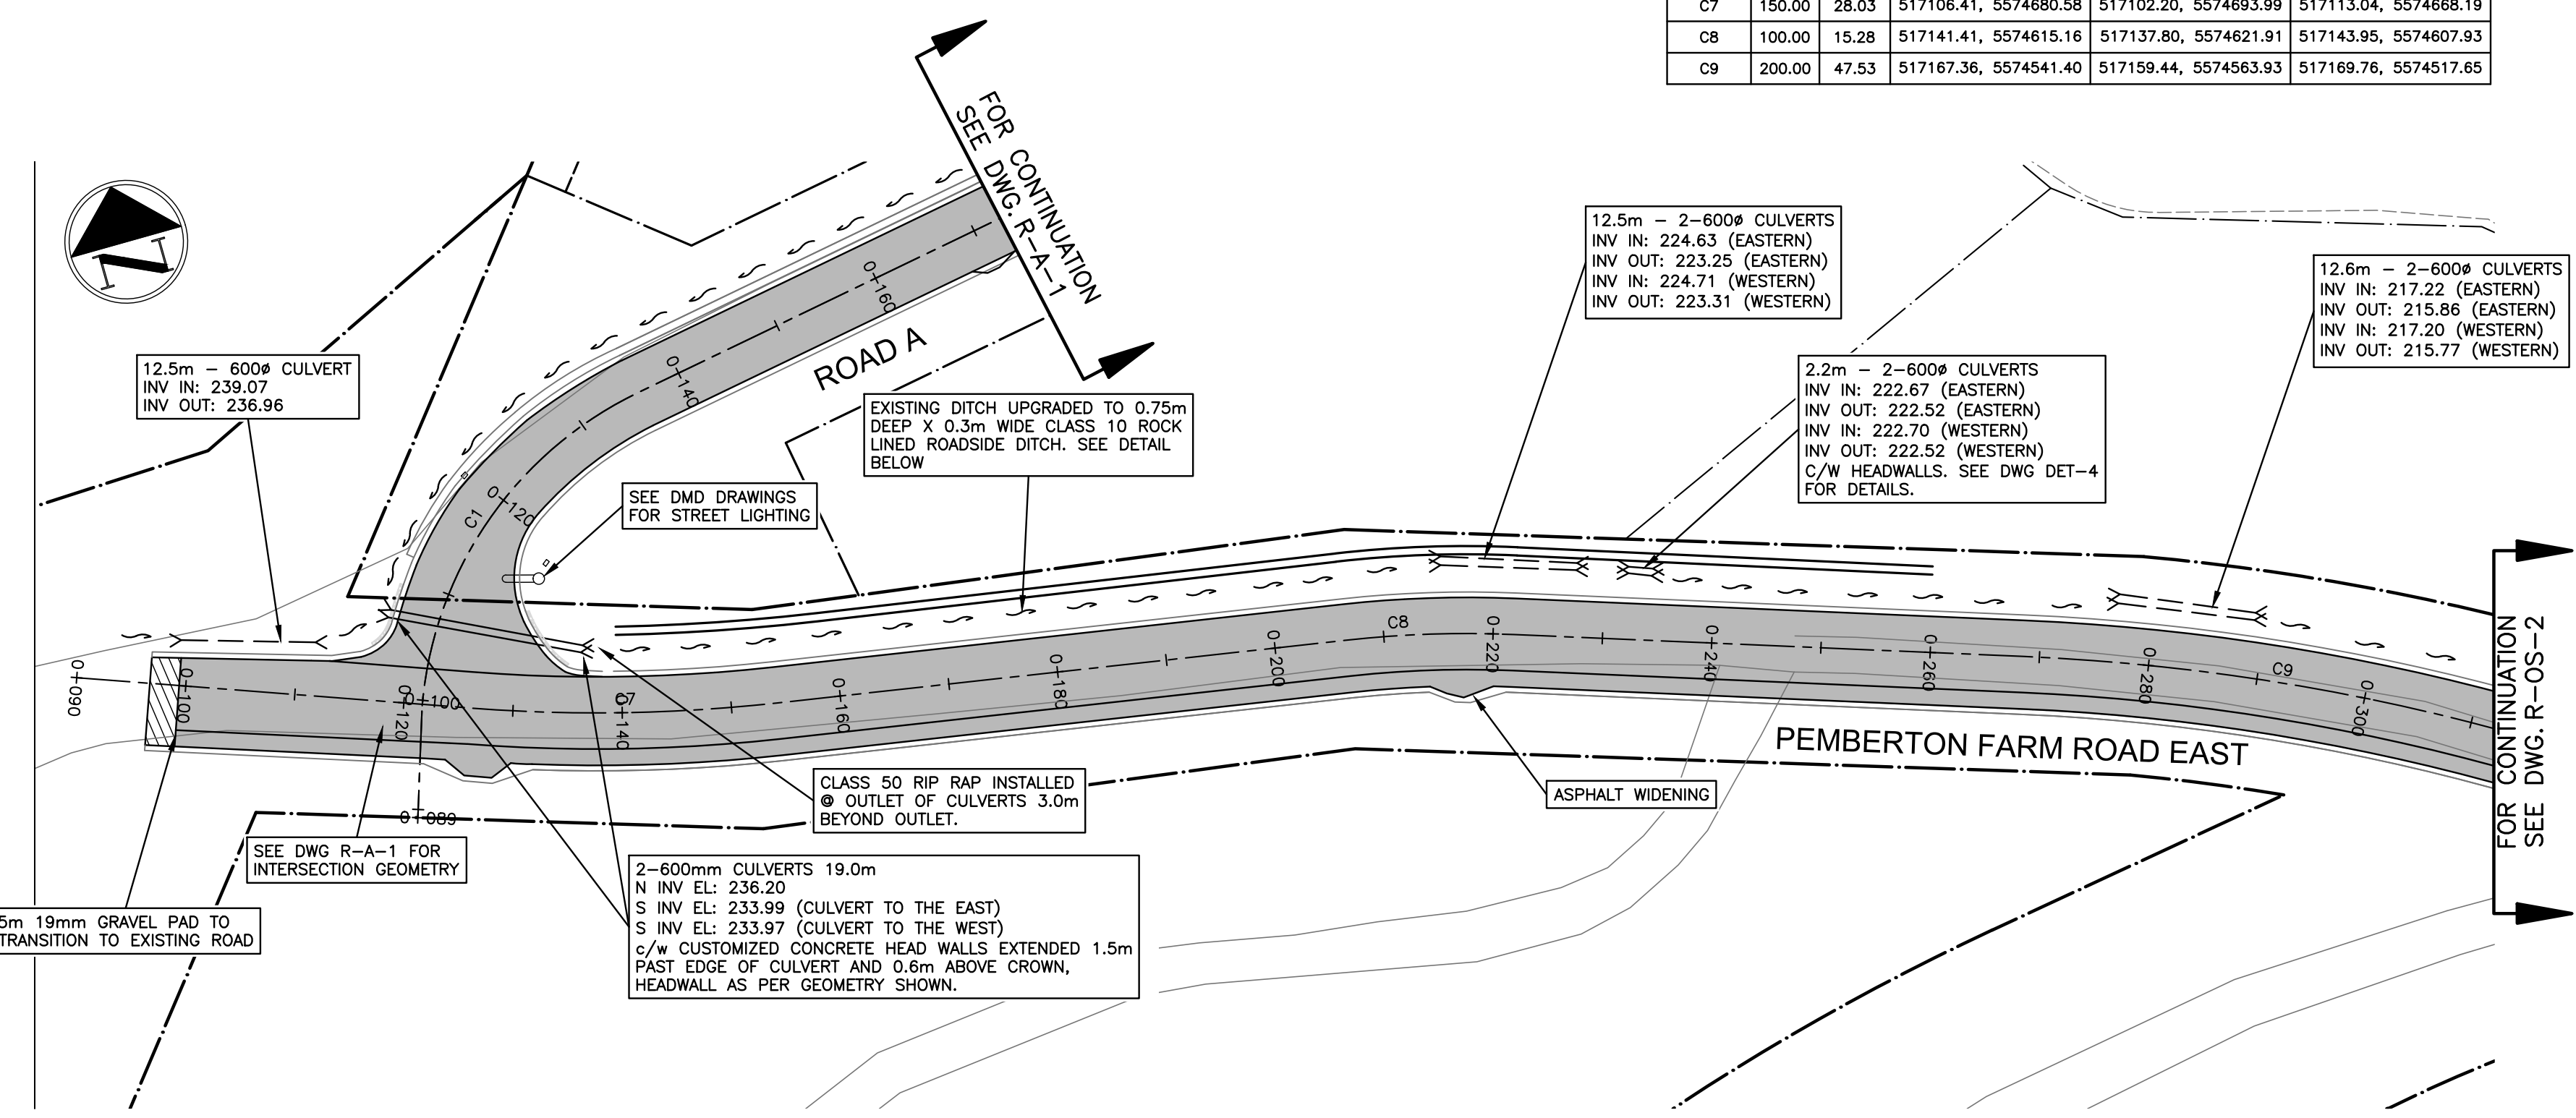

client  
 580049 BC LTD.  
 project  
 THE RIDGE AT PEMBERTON  
 PHASE 1  
 PEMBERTON, BC

ROADWORKS  
 OFFSITE ROAD (STA 0+100-0+310)

no.	(y/m/d)	revision	chk'd
15	18-02-06	PROJECT RECORDS OFFSITE	KBH
14	17-10-17	PROJECT RECORDS OFFSITE	KBH
13	17-09-28	UPDATED OFFSETS	KBH
12	17-08-15	UPDATE WITH HYDRO & TELLUS	KBH
11	17-03-07	REISSUED FOR CONSTRUCTION OFFSITE	KBH
10	16-11-09	REISSUED FOR CONSTRUCTION OFFSITE	KBH
9	16-10-26	IFC OFFSITE FINAL COMMENTS	KBH
8	16-10-13	ISSUED FOR CONSTRUCTION OFFSITE	KBH

engineer of record  
 K.B.H.  
 scales  
 hor: 1:500 vert: 1:50  
 designed by  
 N.G.B.  
 file no.  
 16159  
 drawn by  
 R.J.L.  
 drawing no.  
 R-OS-1  
 date  
 2016-05-13




AS--CONSTRUCTED INFORMATION  
 CREUS ENGINEERING LTD. CERTIFIES THAT THE WORKS & SERVICES SHOWN ON THESE DRAWINGS WERE CONSTRUCTED IN GENERAL CONFORMANCE WITH THE DRAWINGS & SPECIFICATIONS.  
 AS--CONSTRUCTED SURVEY INFORMATION SHOWN ON THESE DRAWINGS HAVE BEEN PROVIDED BY OTHERS. IT IS THE RESPONSIBILITY OF OTHERS USING THESE DRAWINGS TO CONFIRM THE LOCATION & ELEVATION OF THESE SERVICES.

CURVE TABLE: OFFSITE ROAD					
CURVE #	RADIUS	LENGTH	I.P.	START POINT	END POINT
C10	280.00	115.86	517178.33, 5574432.88	517172.42, 5574491.35	517207.25, 5574381.72
C11	90.00	27.58	517219.35, 5574360.32	517212.51, 5574372.42	517229.52, 5574350.85
C12	37.00	55.19	517280.21, 5574303.65	517255.20, 5574326.94	517258.97, 5574276.87

SEE DRAWING KEY-1 FOR GENERAL NOTES  
 SEE DRAWING R-A-1 FOR ROADWORKS NOTES



# CREUS Engineering

Civil Engineers & Project Managers  
 SUITE 200-901 16TH ST WEST, NORTH VANCOUVER BC, V7P1R2  
 PH: 604-987-0070 WEBSITE: www.creus.ca

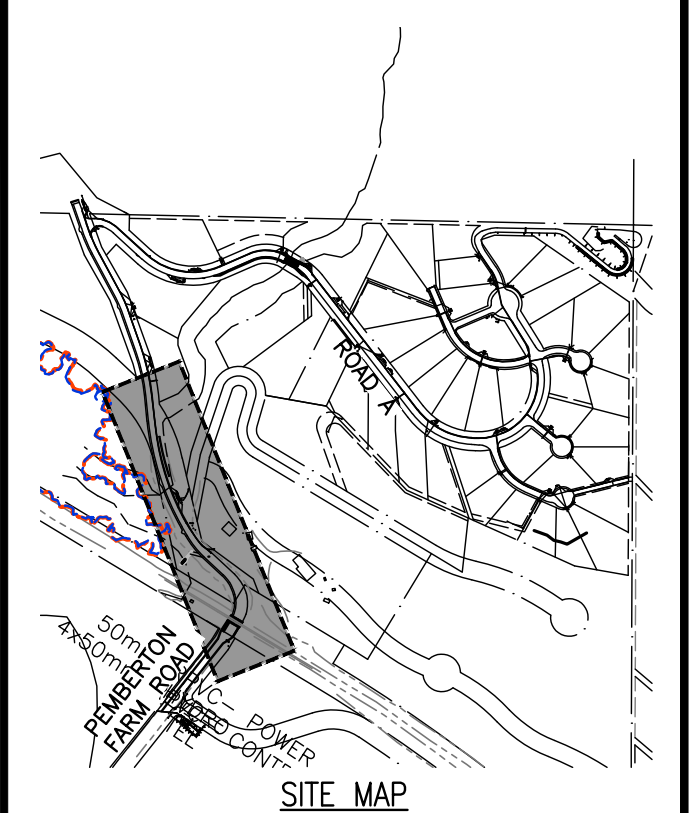

### DRAWING LEGEND

	EXISTING	PROP.	TO BE REMOVED
LEGAL LINE	---	---	---
EASEMENT	---	---	---
WATERMAIN	---	---	---
SANITARY	---	---	---
STORM	---	---	---
HYDRO	---	---	---
TEL	---	---	---
STREETLIGHT	---	---	---
GAS	---	---	---
	EXISTING	PROP.	TO BE REMOVED
FIRE HYDRANT	⊗	⊗	⊗
GATE VALVE	⊗	⊗	⊗
AIR VALVE	⊗	⊗	⊗
REDUCER	⊗	⊗	⊗
INSPECTION CHAMBER	⊗	⊗	⊗
CATCHBASIN (STD/SI)	⊗	⊗	⊗
CAP	⊗	⊗	⊗
MANHOLE	⊗	⊗	⊗
POWER POLE	⊗	⊗	⊗
STREETLIGHT	⊗	⊗	⊗

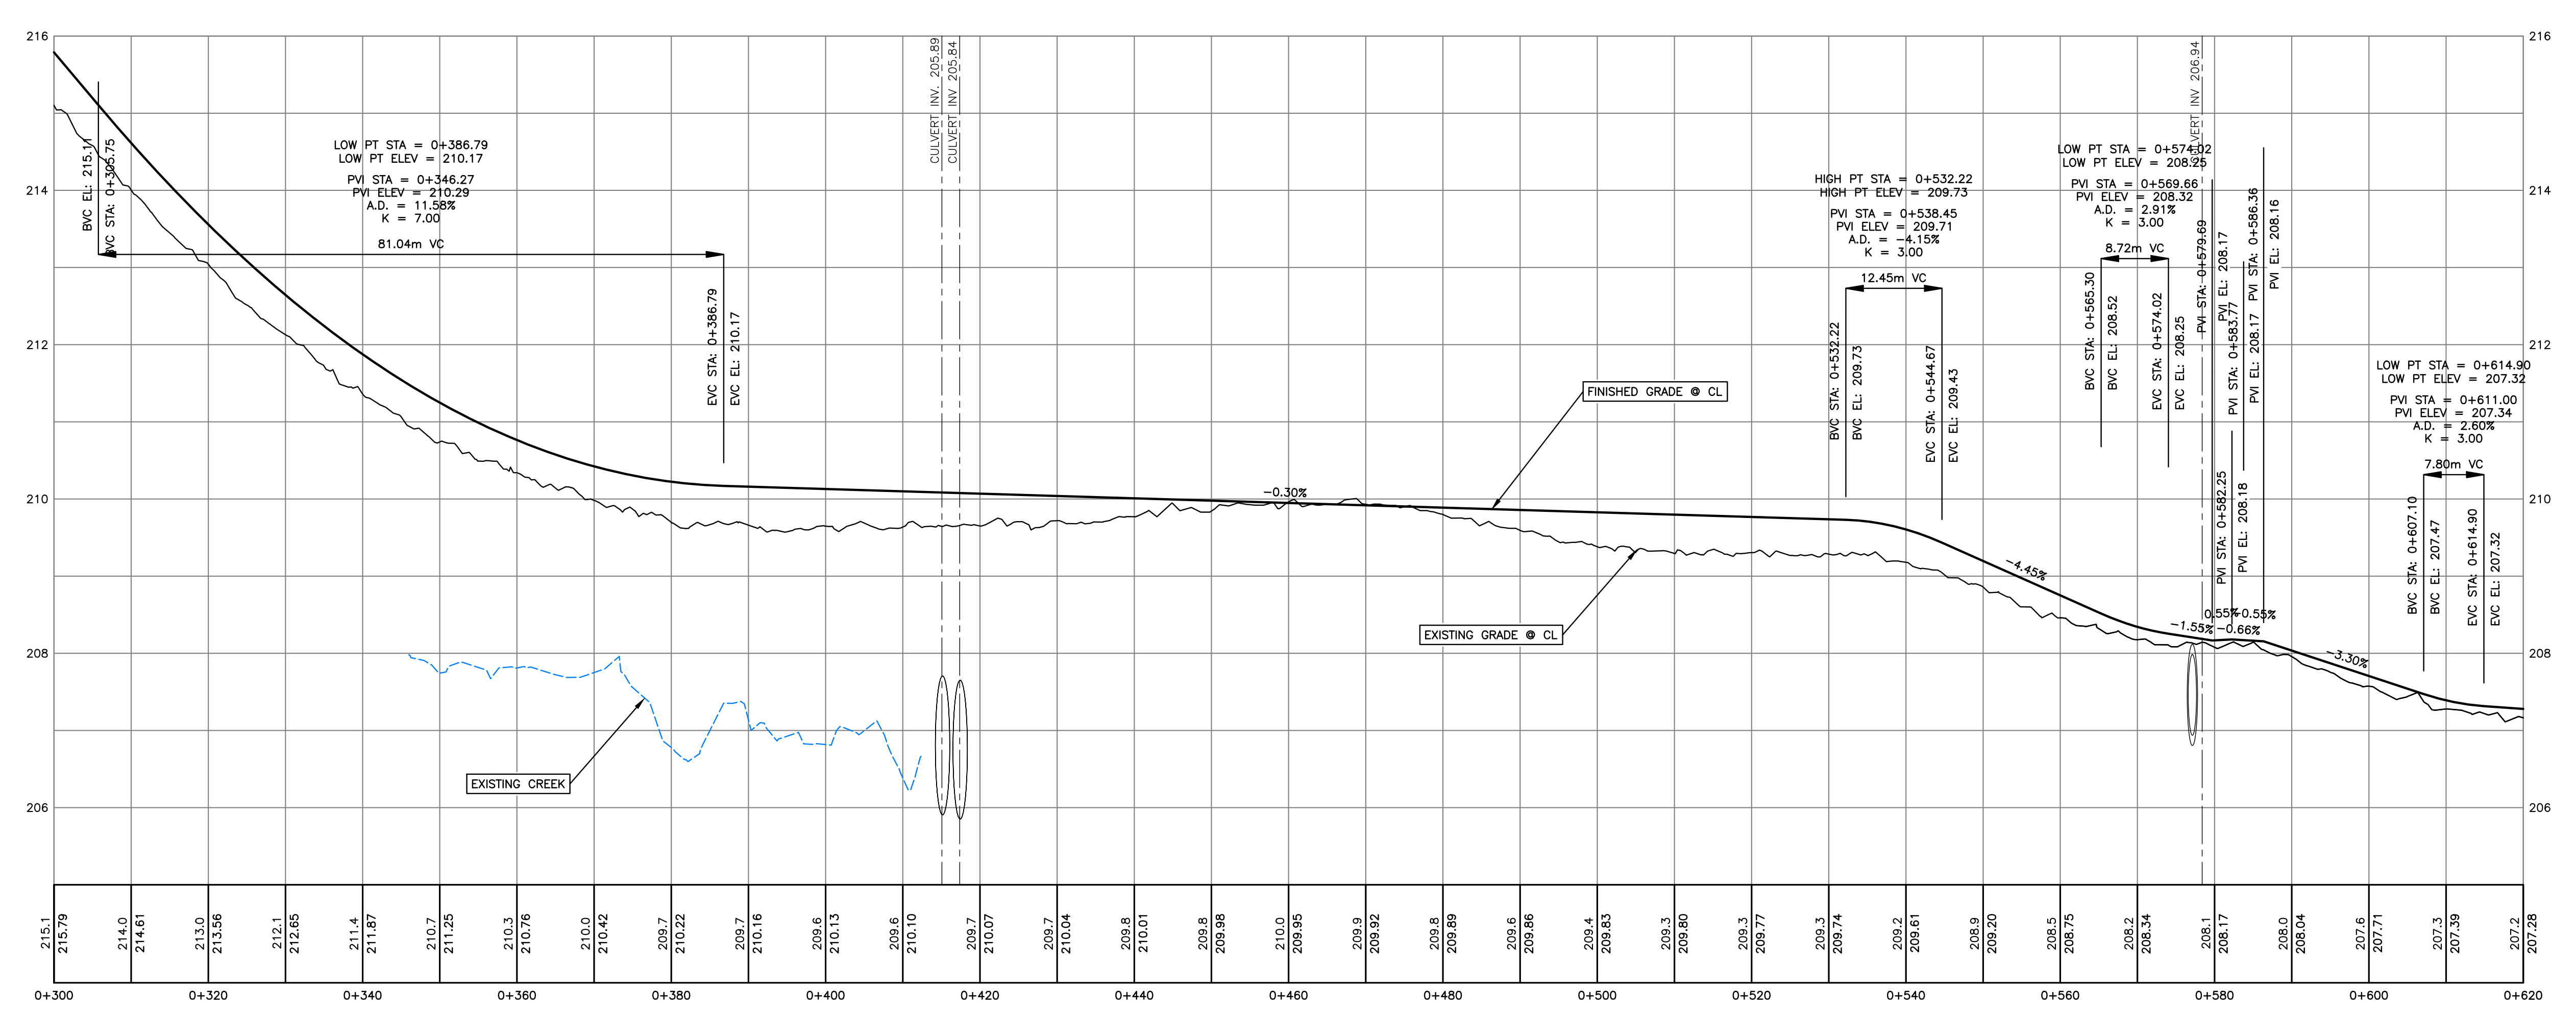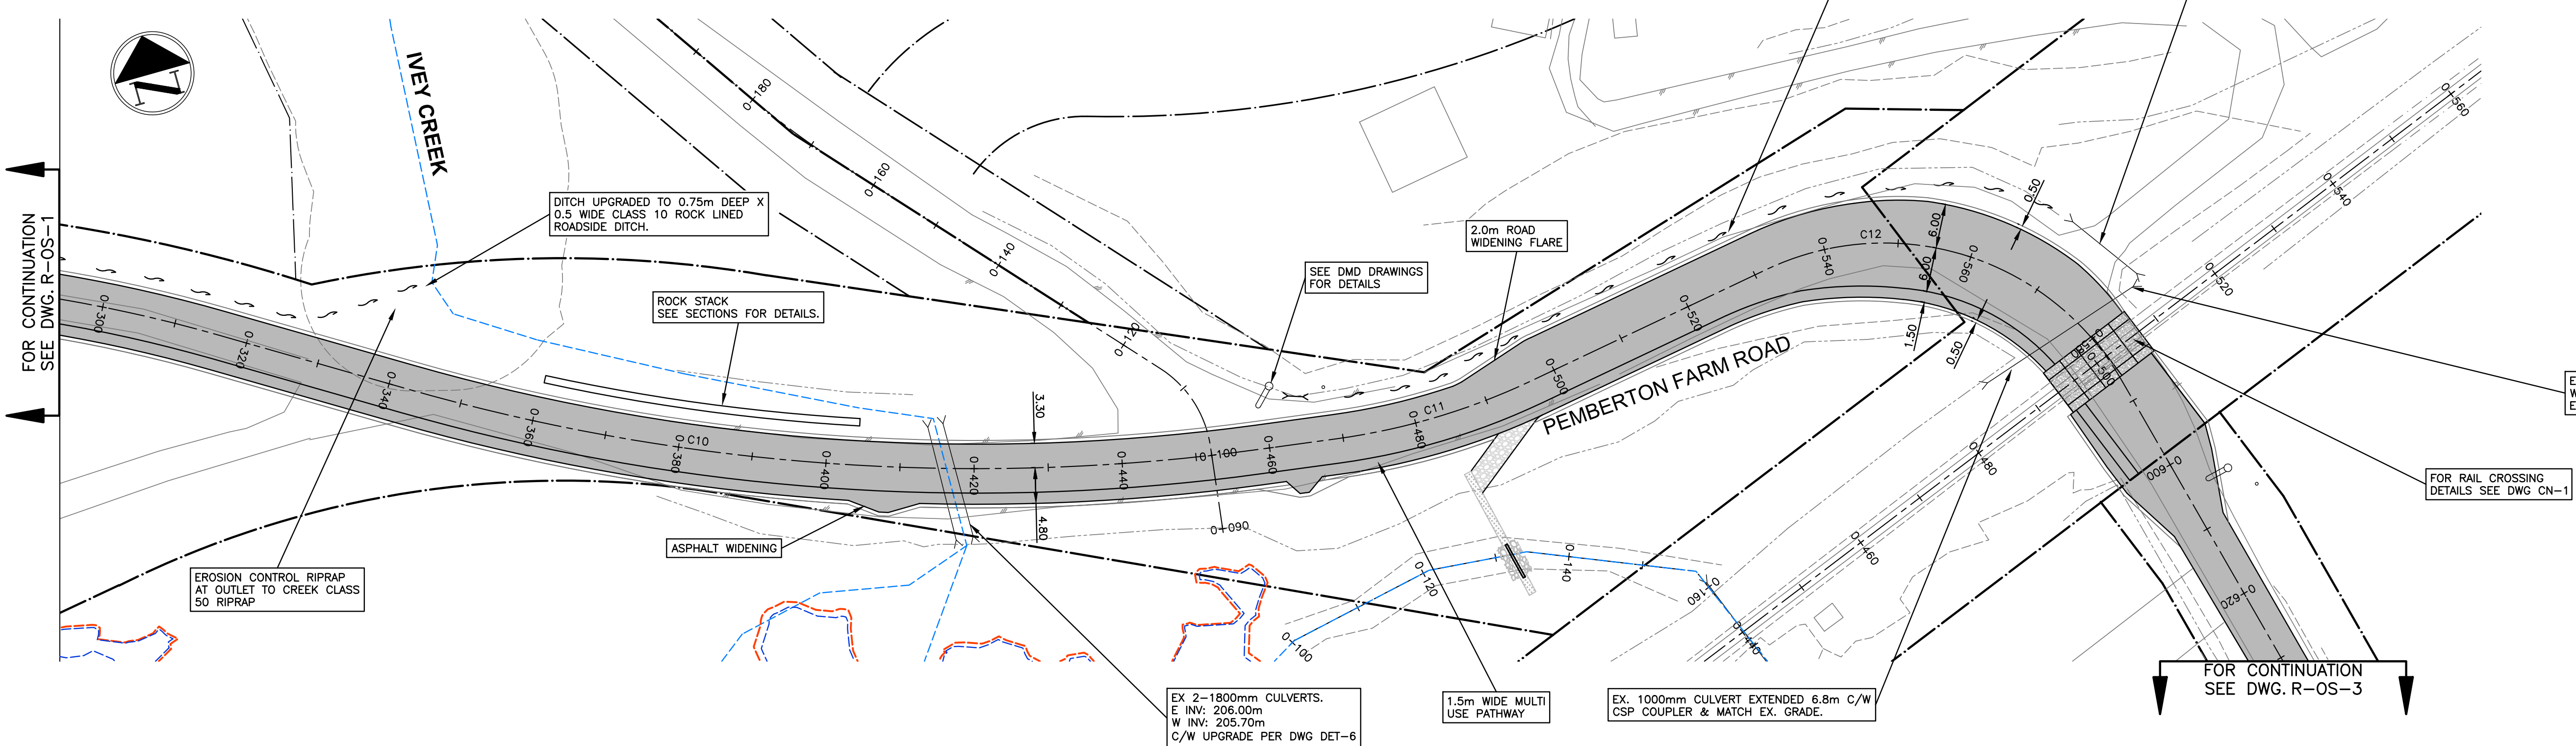

approved

client  
 580049 BC LTD.

project  
 THE RIDGE AT PEMBERTON  
 PHASE 1  
 PEMBERTON, BC

title  
 ROADWORKS  
 OFFSITE ROAD (STA 0+300-0+630)

no.	(y/m/d)	revision	chk'd
14	18-02-06	PROJECT RECORDS OFFSITE	KBH
13	17-10-17	PROJECT RECORDS OFFSITE	KBH
12	17-09-28	UPDATED OFFSETS	KBH
11	17-08-15	UPDATE WITH HYDRO & TELLUS	KBH
10	17-03-07	REISSUED FOR CONSTRUCTION OFFSITE	KBH
9	16-11-09	REISSUED FOR CONSTRUCTION OFFSITE	KBH
8	16-10-26	IFC OFFSITE FINAL COMMENTS	KBH
7	16-10-13	ISSUED FOR CONSTRUCTION OFFSITE	KBH




<small>COPYRIGHT RESERVED. THIS DRAWING AND DESIGN ARE, AND AT ALL TIMES REMAIN THE EXCLUSIVE PROPERTY OF CREUS ENGINEERING LTD. AND CANNOT BE USED, REPRODUCED OR DISTRIBUTED WITHOUT WRITTEN CONSENT.        © 2018 CREUS ENGINEERING LTD.</small>		current rev. # <b>14</b>
engineer of record K.B.H.	scales hor: 1:500 vert: 1:50	designed by N.G.B.
drawn by R.J.L.	file no. <b>16159</b>	date 2016-05-13
drawing no. <b>R-OS-2</b>		



SEE DRAWING KEY-1 FOR GENERAL NOTES  
SEE DRAWING R-A-1 FOR ROADWORKS NOTES

# CREUS Engineering

Civil Engineers & Project Managers  
SUITE 200-901 16TH ST WEST, NORTH VANCOUVER BC, V7P1R2  
PH: 604-987-0070 WEBSITE: www.creus.ca

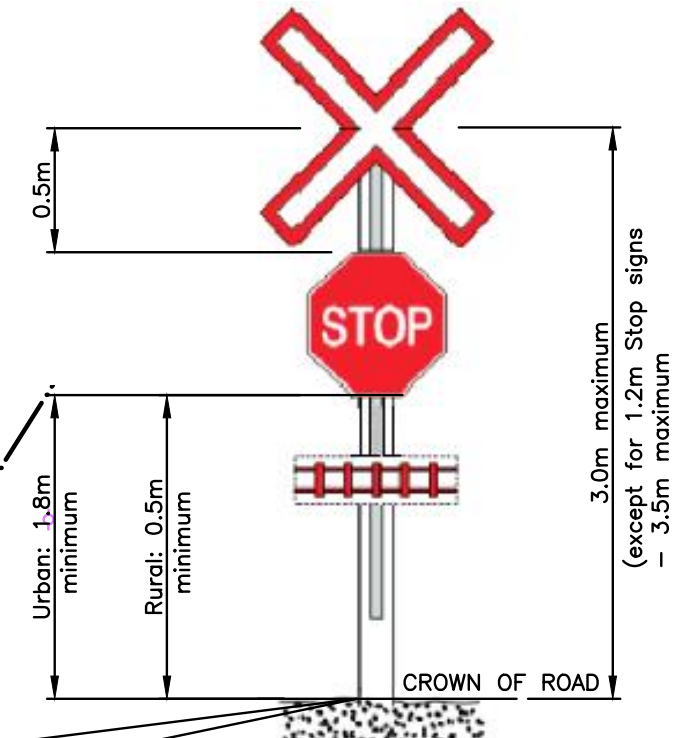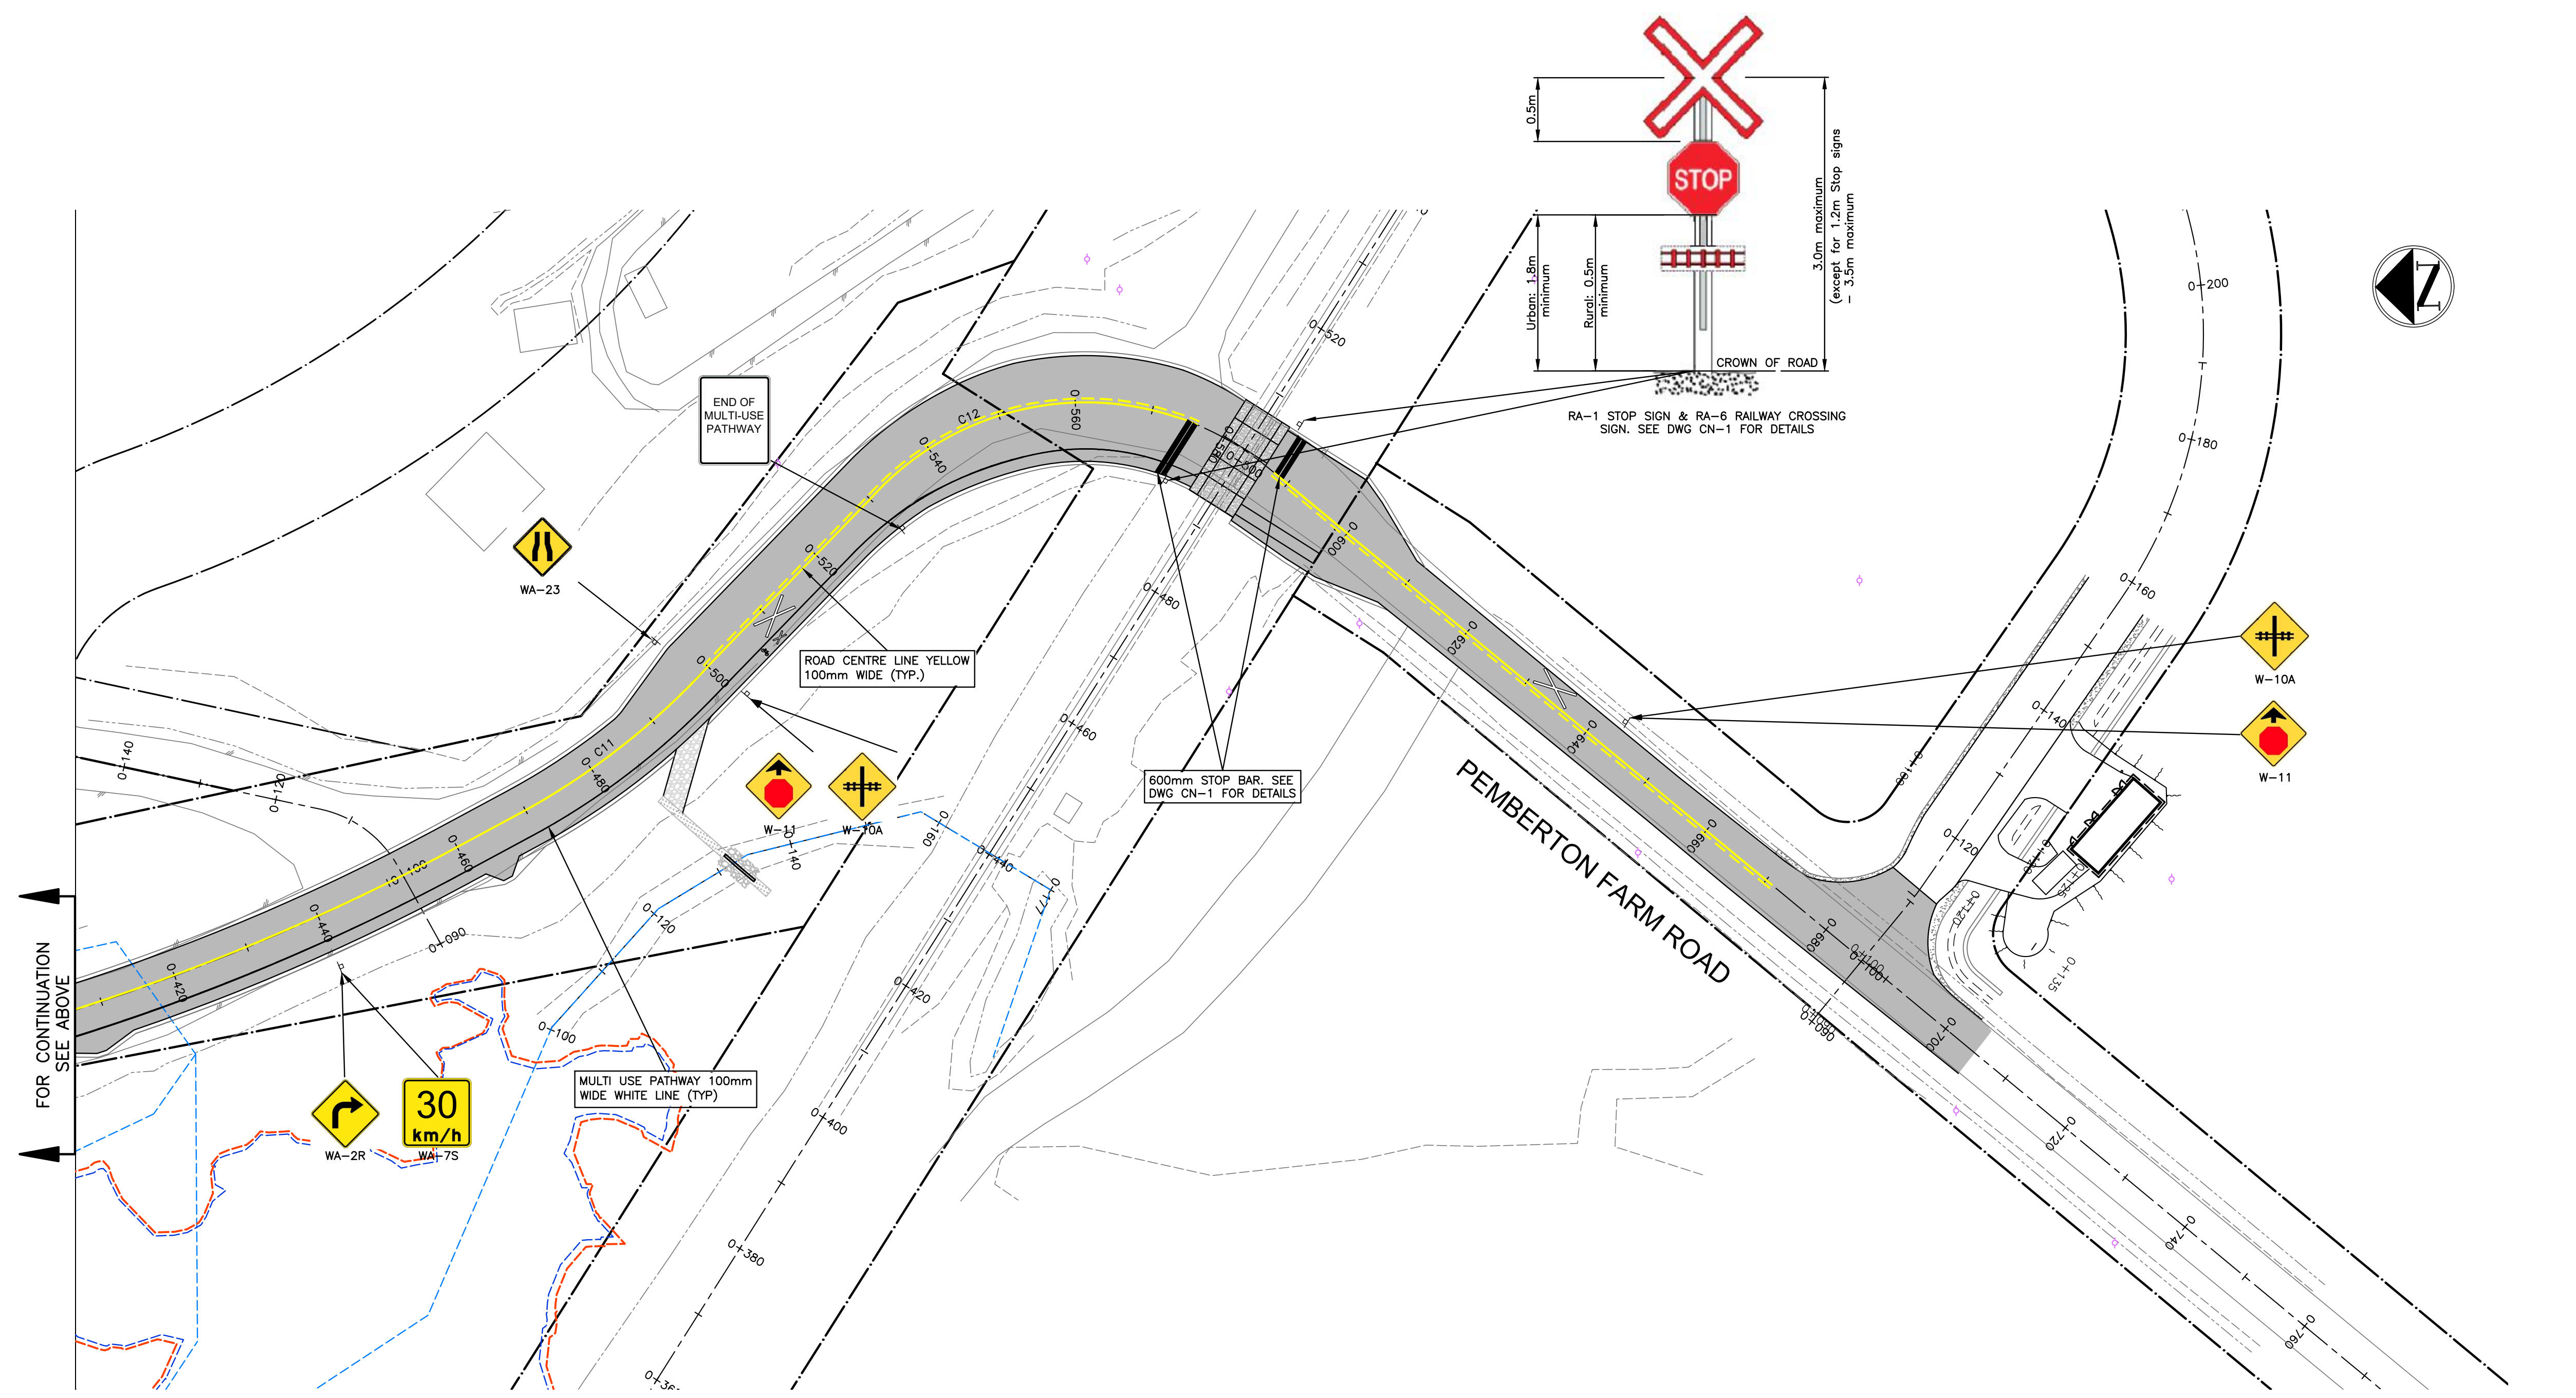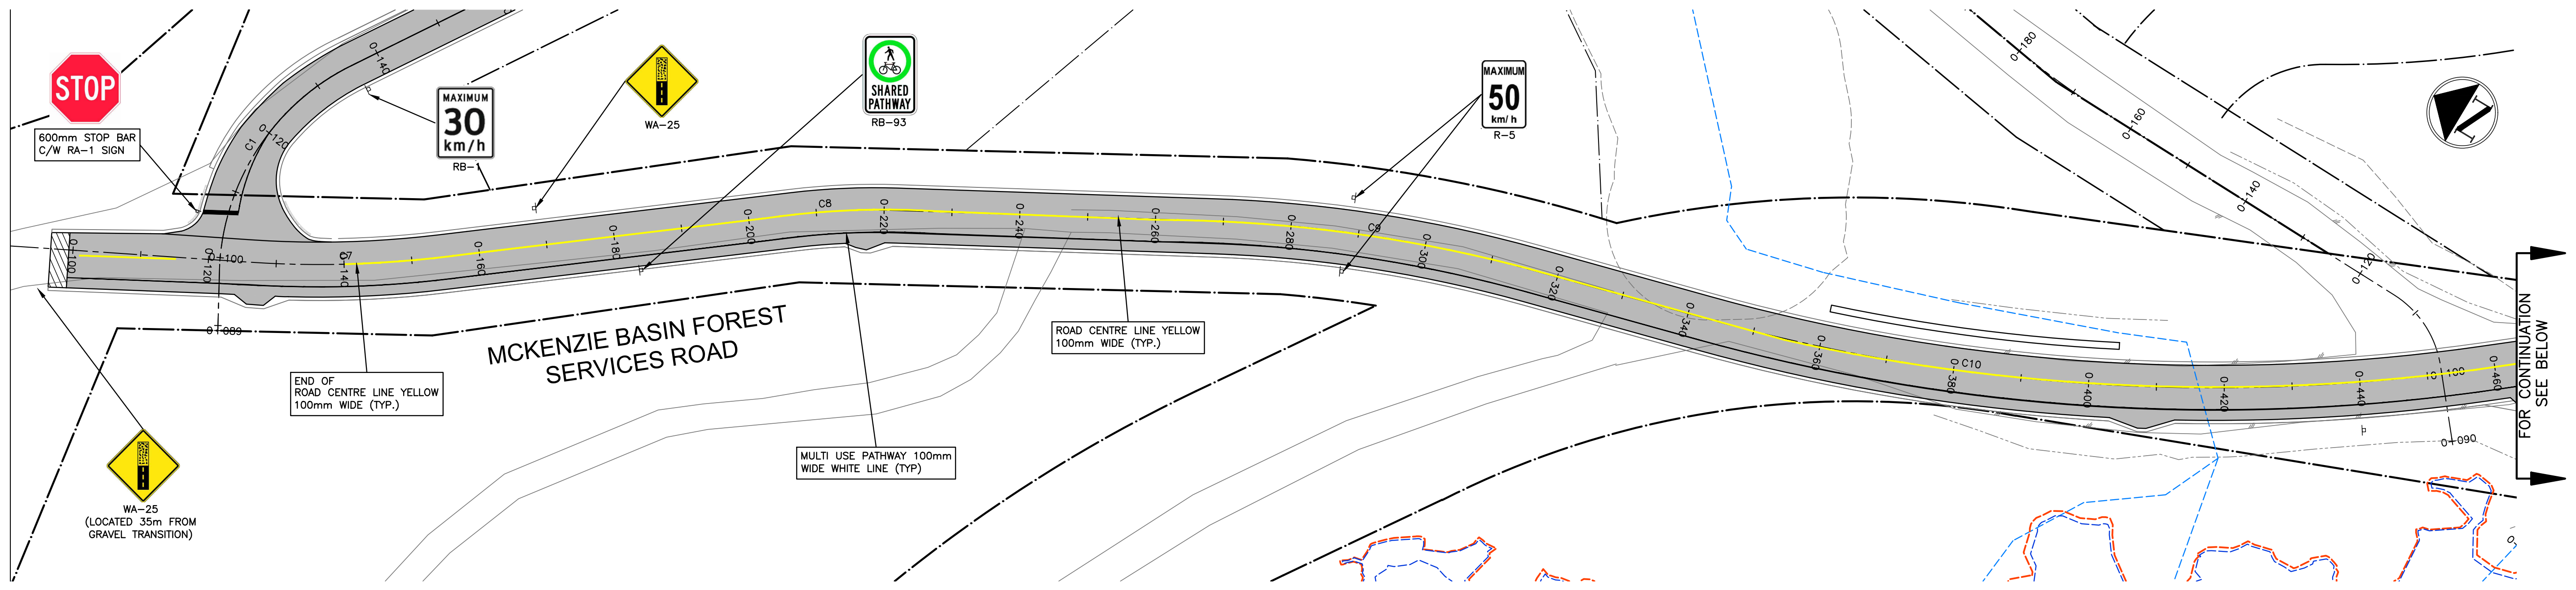

## SITE MAP

## DRAWING LEGEND

approved

client  
**580049 BC LTD.**




project  
**THE RIDGE AT PEMBERTON  
PHASE 1  
PEMBERTON, BC**

title  
**SIGNAGE & LINE PAINTING  
OFFSITE**

no.	(y/m/d)	revision	chn/d
10	18-02-06	PROJECT RECORDS OFFSITE	KBH
9	17-10-12	REVISED PER CN COMMENTS	ZM
8	17-09-27	REVISED PER CN COMMENTS	ZM
7	17-09-21	UPDATED PER CN COMMENTS	KBH
6	17-03-07	REISSUED FOR CONSTRUCTION OFFSITE	KBH
5	16-11-09	REISSUED FOR CONSTRUCTION OFFSITE	KBH
4	16-10-26	IFC OFFSITE FINAL COMMENTS	KBH
3	16-10-13	ISSUED FOR CONSTRUCTION OFFSITE	KBH

<small>COPYRIGHT RESERVED. THIS DRAWING AND DESIGN ARE, AND AT ALL TIMES REMAIN THE EXCLUSIVE PROPERTY OF CREUS ENGINEERING LTD. AND CANNOT BE USED, REPRODUCED OR DISTRIBUTED WITHOUT WRITTEN CONSENT. © 2018 CREUS ENGINEERING LTD.</small>			current rev. # <b>10</b>
engineer of record	K.B.H.	scales	hor: 1:500 vert: -
designed by	N.G.B.	file no.	<b>16159</b>
drawn by	A.A.P.	drawing no.	
date	2016-05-13		<b>LP-2</b>



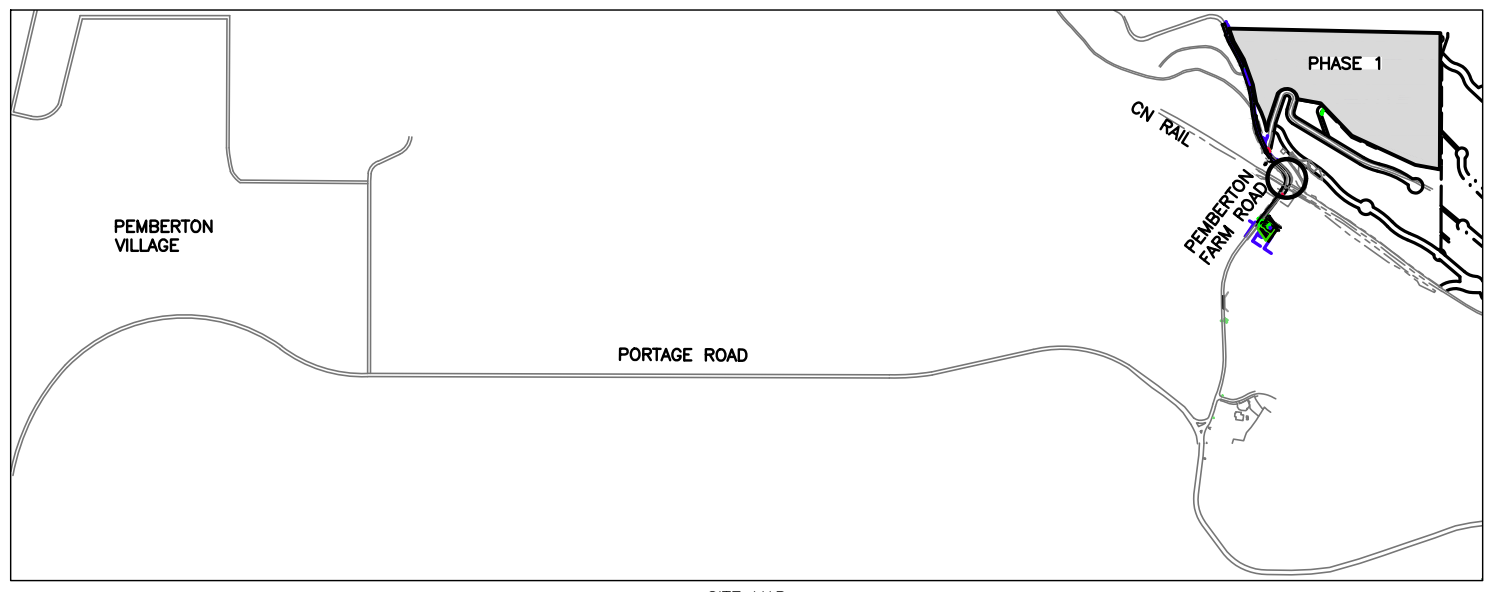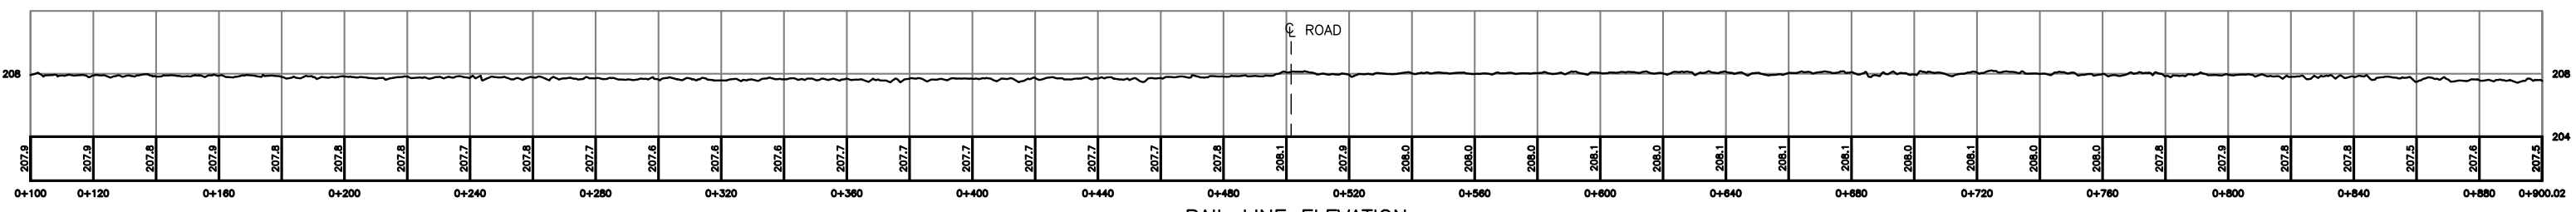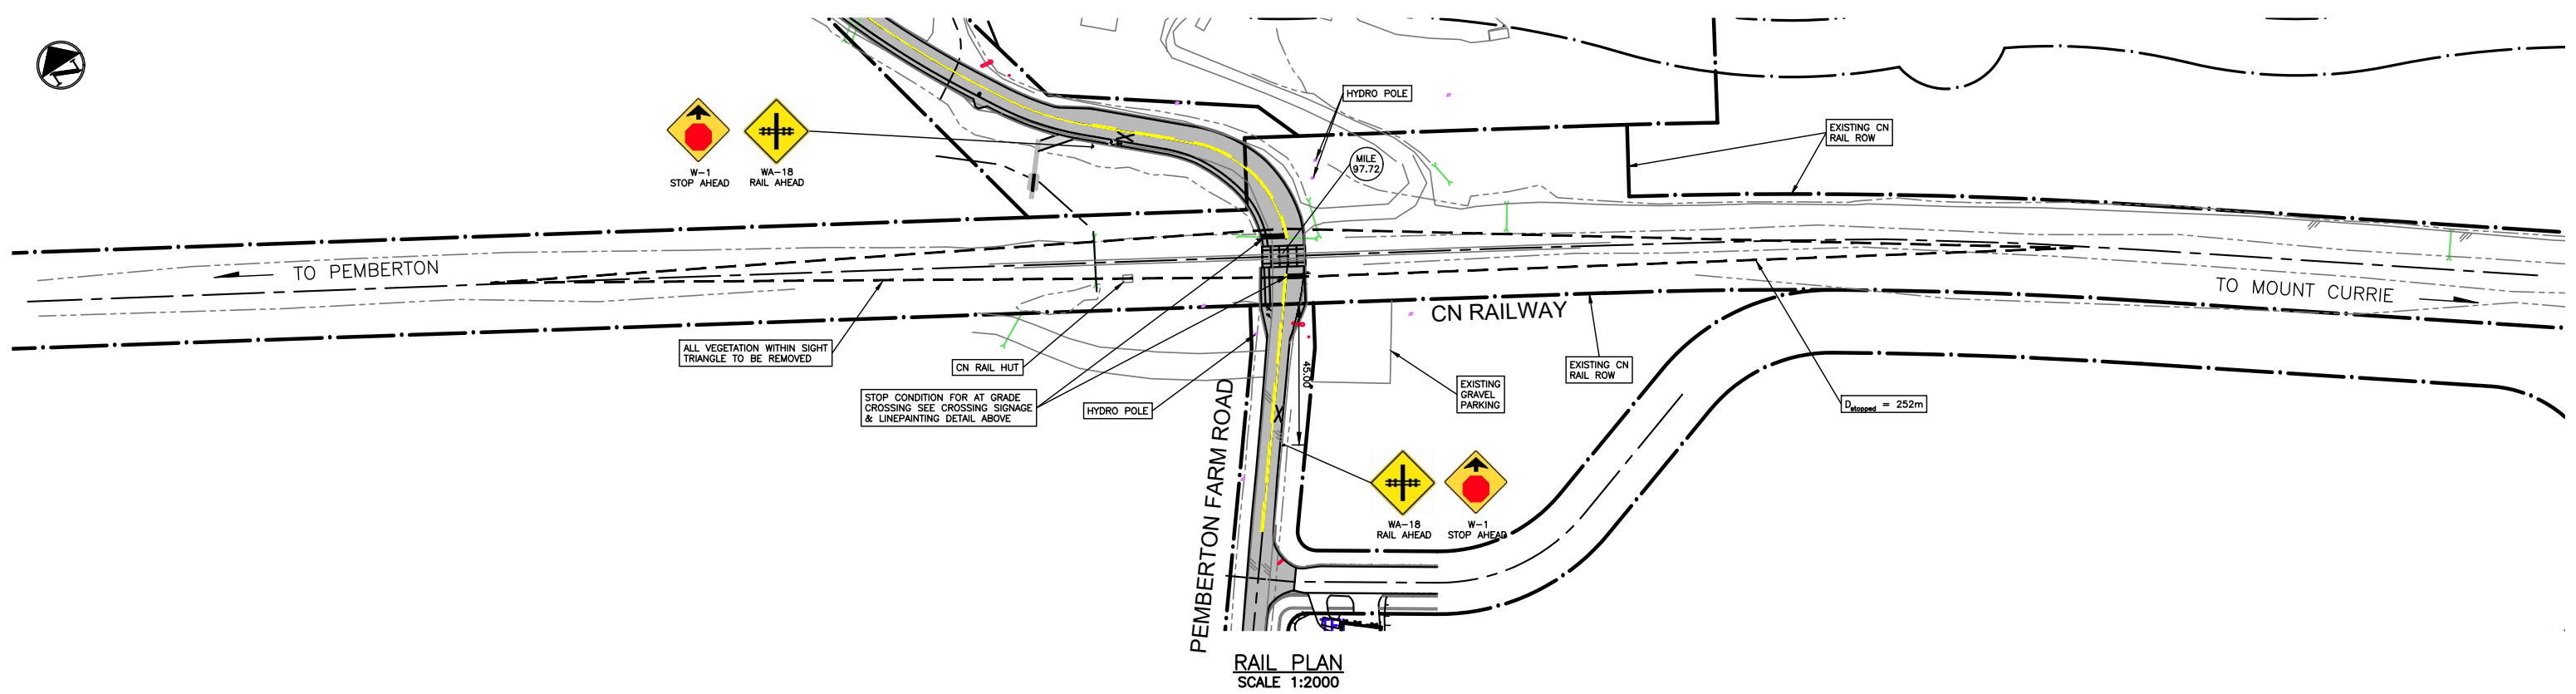

GENERAL NOTES

1. ALL DIMENSIONS ARE IN METERS UNLESS OTHERWISE NOTED.
2. ELEVATIONS ARE TO GEODETIC DATUM NAD83, AND ARE DERIVED FROM DUAL FREQUENCY GNSS OBSERVATIONS TO WHISTLER ACTIVE CONTROL POINT (GEODETIC CONTROL MONUMENT 967000) AND ARE REFERRED TO THE CENTRAL MERIDIAN OF UTM ZONE 10.
3. CONSTRUCTION AND SIGHT LINE CLEARING TO BE IN ACCORDANCE WITH TRANSPORT CANADA GRADE CROSSING STANDARDS AND GRADE CROSSING REGULATIONS.
4. ALL UNDERGROUND UTILITY LOCATIONS TO BE PROTECTED AS PER TC-E10 FOR RAILWAY LOADING AND OVERHEAD UTILITIES AS PER G.O. E-11
5. ROAD SURFACE: ASPHALT
6. CROSSING SURFACE: CONCRETE PANEL 13.72m x 6.66m
7. DESIGN VEHICLE: WB-20
8. MAXIMUM VEHICLE SPEED AND TRAFFIC COUNT: 50km/h & 200 VEHICLES PER DAY
9. MAXIMUM TRAIN SPEED AND TRAFFIC COUNT: 30mp/h & 4 TRAINS PER DAY

PROPOSED SIGHTLINES

1. DESIGN VEHICLE: WB-20
2. STOP SIGN CONTROLLED CROSSING
3. TRAIN SPEED: 30mph (49km/h)
4.  $D_{stopped} = 252m$


EXISTING SIGHT LINES (AUGUST 2016)

STATION ALONG CL OF ROAD	VEHICLES TRAVELLING FROM NORTH		VEHICLES TRAVELLING FROM SOUTH	
	EAST ALONG TRACK	WEST ALONG TRACK	EAST ALONG TRACK	WEST ALONG TRACK
5m	50m BUSH/BERM	252m	252m	75m BUSH
25m	30m BUSH/BERM	10m BUSH	130m BUSH	50m BUSH
50m	10m BUSH	0m BUSH	130m BUSH	50m BUSH
100m	0m BUSH	0m BUSH	130m BUSH	50m BUSH




SITE MAP

14	2018-02-06	PROJECT RECORDS OFFSITE	client	580049 BC LTD.	designed by	N.G.B.	title <b>ROADWORKS CN RAIL CROSSING</b> MILE 97.72 SQUAMISH SUBDIVISION, IN THE VILLAGE OF PEMBERTON	scale	hor: -	vert: -	
13	2017-10-17	PROJECT RECORDS OFFSITE	project THE RIDGE AT PEMBERTON - PHASE 1 PEMBERTON, BC	<p>www.creus.ca P: 604-987-9070 F: 604-987-9071 200 - 901 WEST 16TH ST NORTH VANCOUVER, BC V7P 1R2</p>	drawn by	A.A.P.		file no.	16159		
12	2017-10-12	REVISED PER CN COMMENTS			checked by	K.B.H.		drawing no.	rev.	CN-1-A	14
11	2017-09-27	REVISED PER CN COMMENTS			date	MAY.13.16					
no.	date	revision									




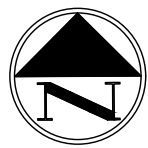

CONTRACTOR TO VERIFY & LOCATE EXISTING MAINS & SERVICE CONNECTIONS & NOTIFY THE ENGINEER OF ANY DISCREPANCIES PRIOR TO BEGINNING CONSTRUCTION

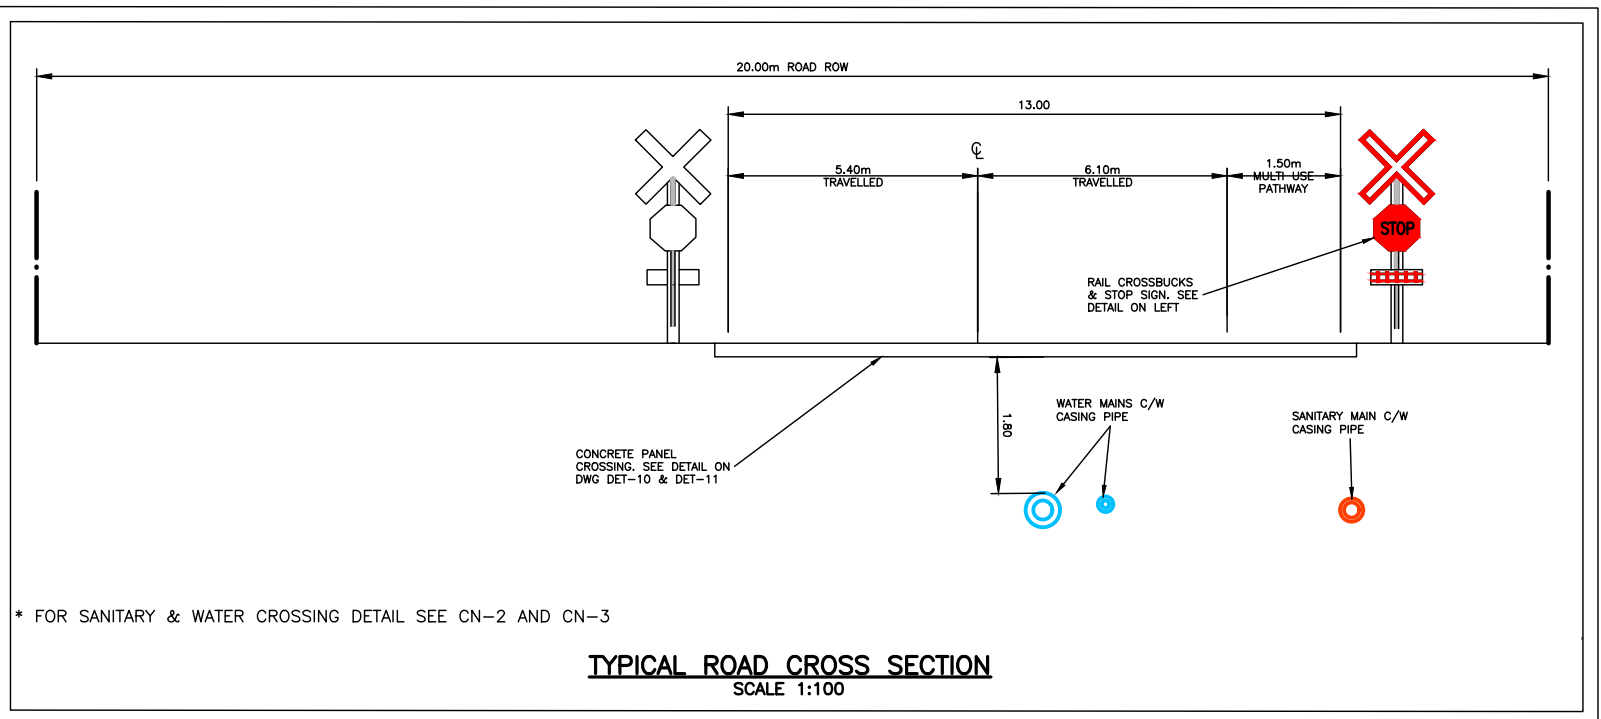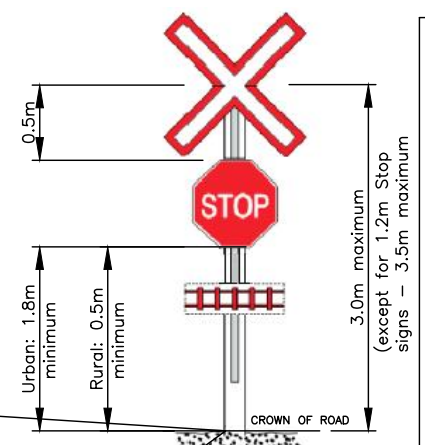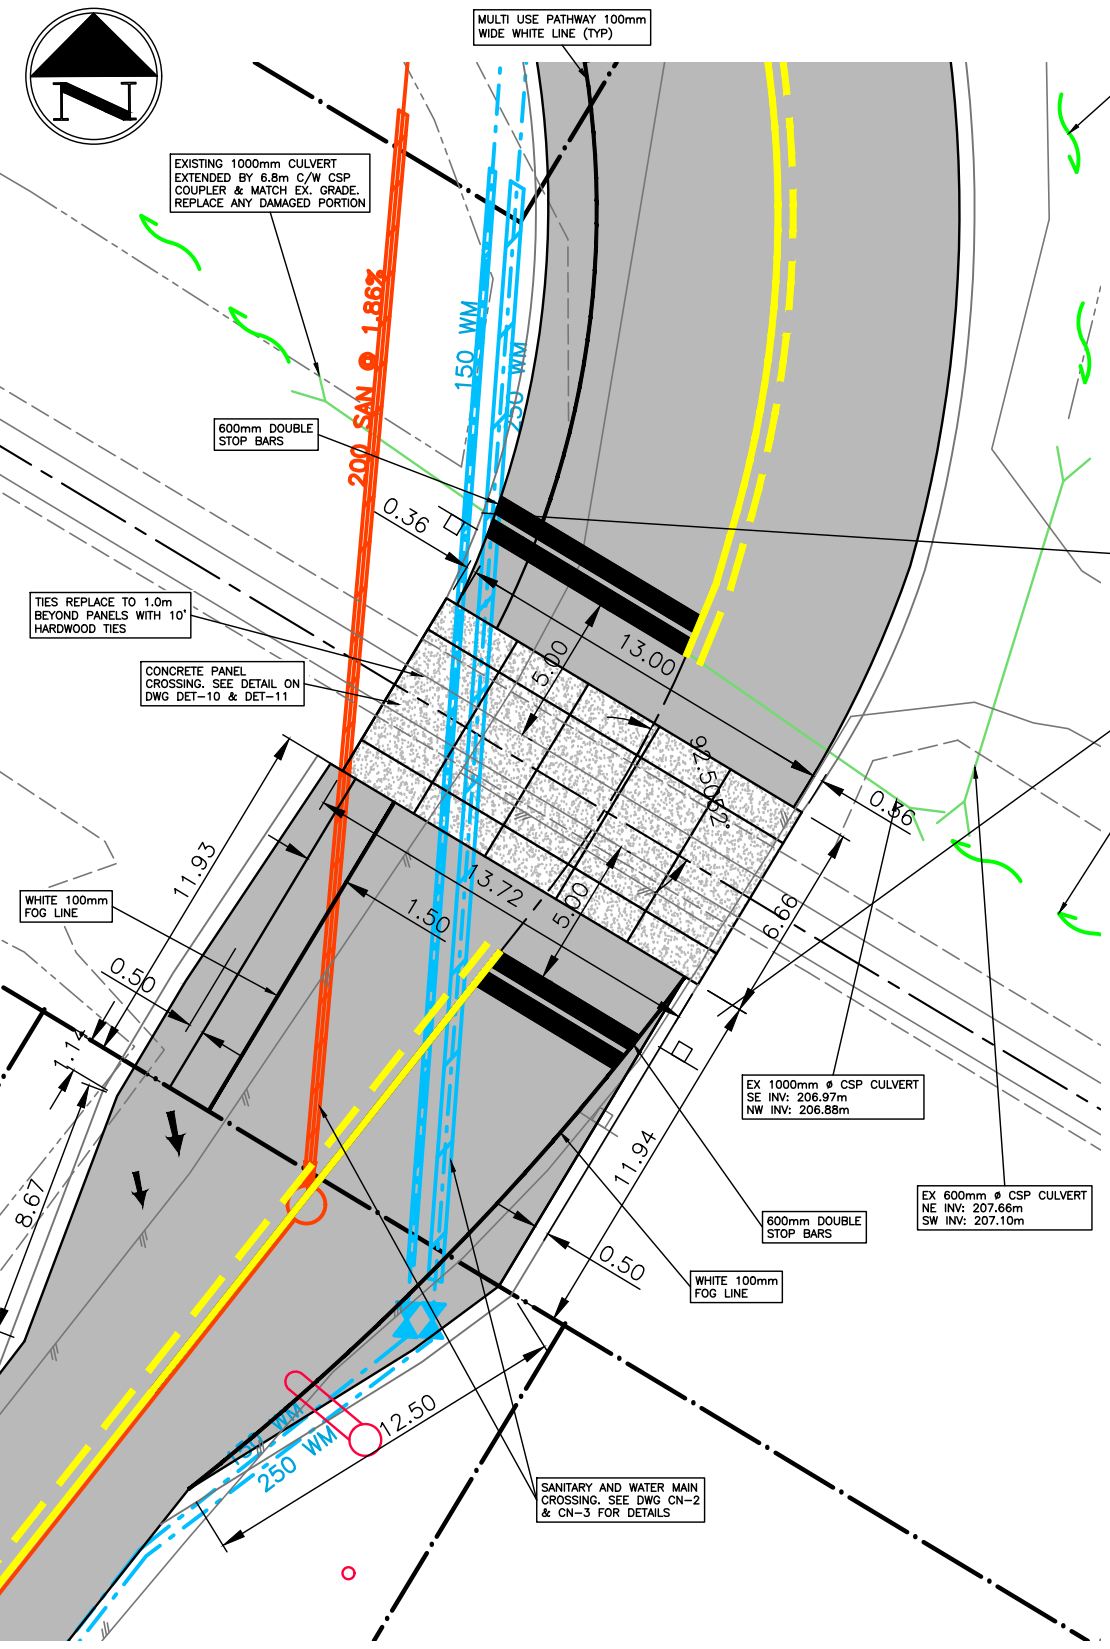

**CROSSING SIGNAGE & LINEPAINTING DETAIL**  
SCALE 1:250

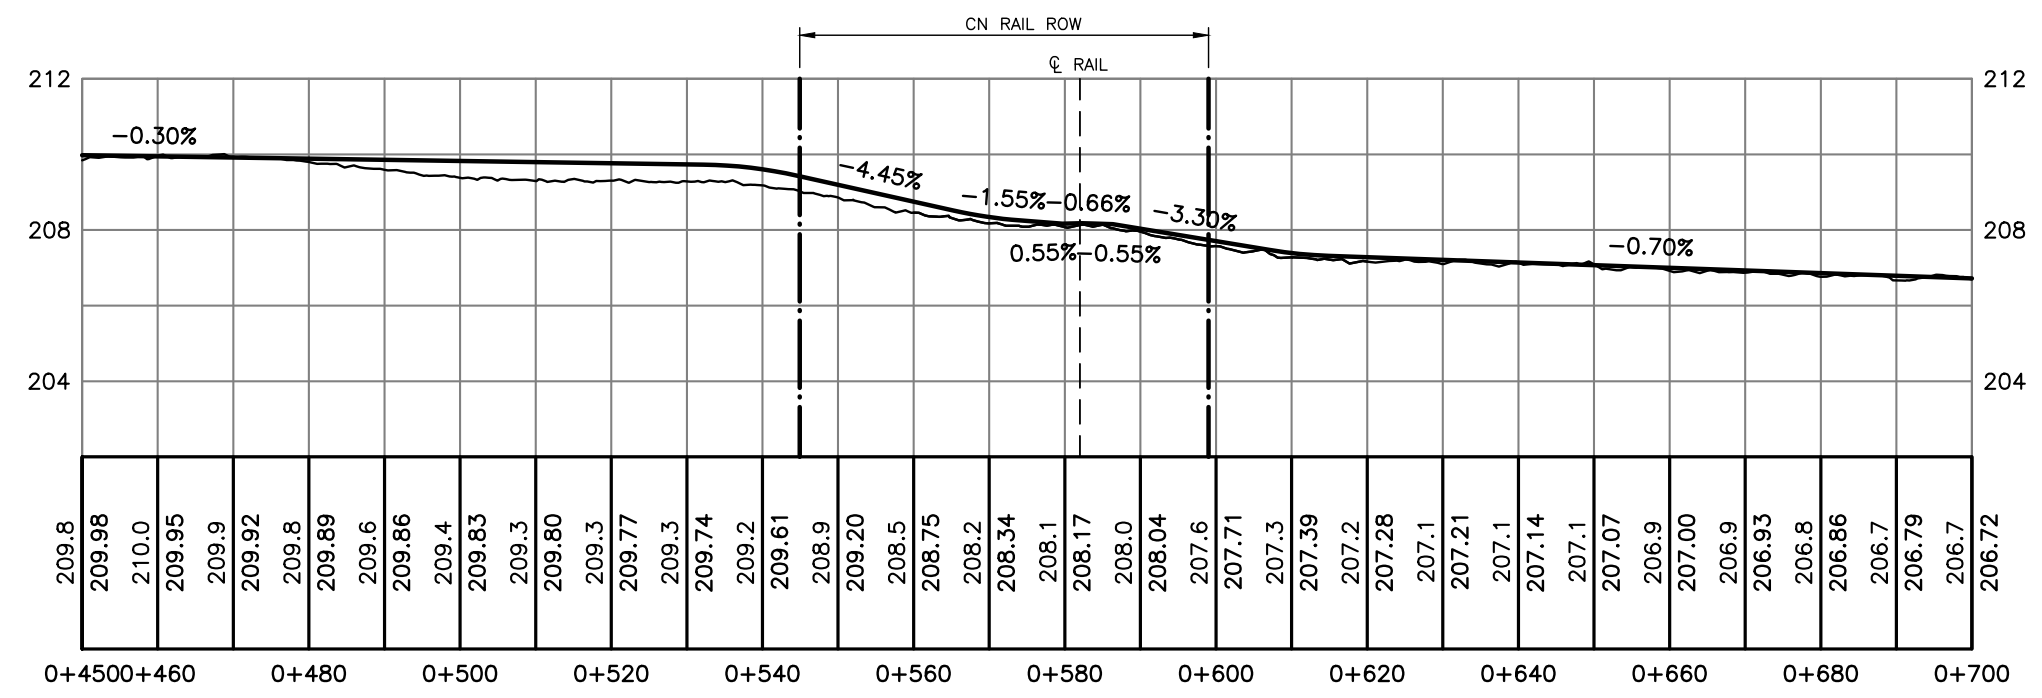

**PEMBERTON FARM ROAD PROFILE**  
SCALE hor: 1:1000 / vert: 1:200

14	2018-02-06	PROJECT RECORDS OFFSITE
13	2017-10-17	PROJECT RECORDS OFFSITE
12	2017-10-12	REVISED PER CN COMMENTS
11	2017-09-27	REVISED PER CN COMMENTS
no.	date	revision

client  
**580049 BC LTD.**

project  
**THE RIDGE AT PEMBERTON - PHASE 1  
PEMBERTON, BC**

designed by **N.G.B.**

drawn by **A.A.P.**

checked by **K.B.H.**

date **MAY.13.16**


**CREUS Engineering Ltd**  
Civil Engineers  
P: 604-987-9070 F: 604-987-9071  
200 - 901 WEST 16TH ST NORTH VANCOUVER, BC V7P 1R2

title  
**ROADWORKS  
CN RAIL CROSSING**


**MILE 97.72 SQUAMISH SUBDIVISION,  
IN THE VILLAGE OF PEMBERTON**

scales	hor: -	vert: -
file no.	<b>16159</b>	
drawing no.	<b>CN-1-B</b>	rev. <b>14</b>




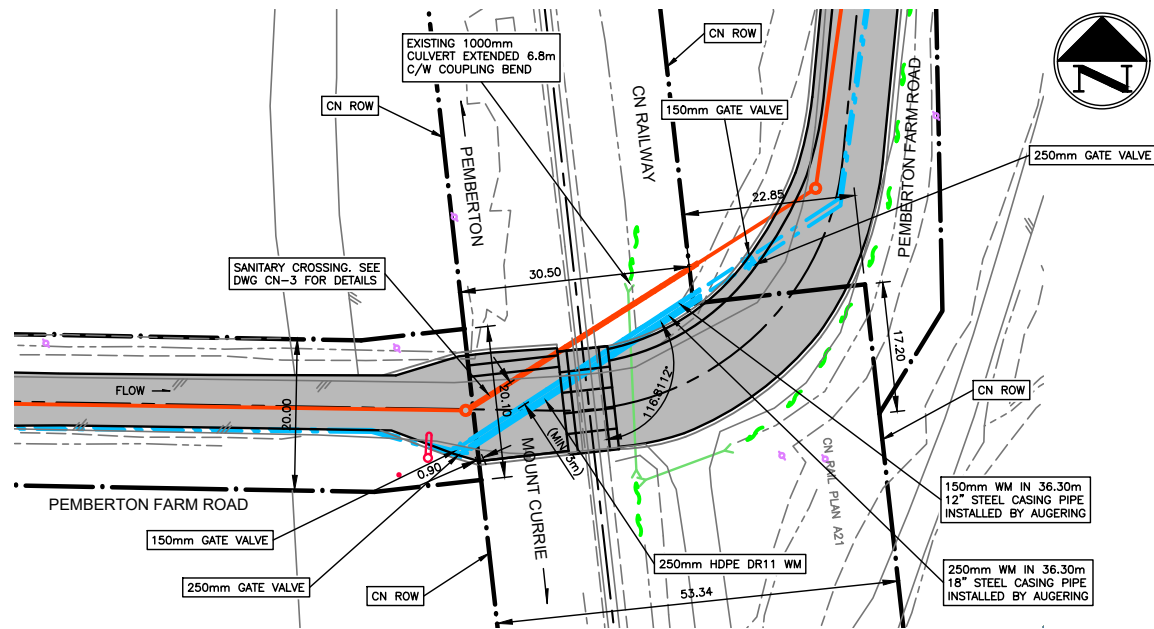


**DETAIL PLAN**  
SCALE 1:1000

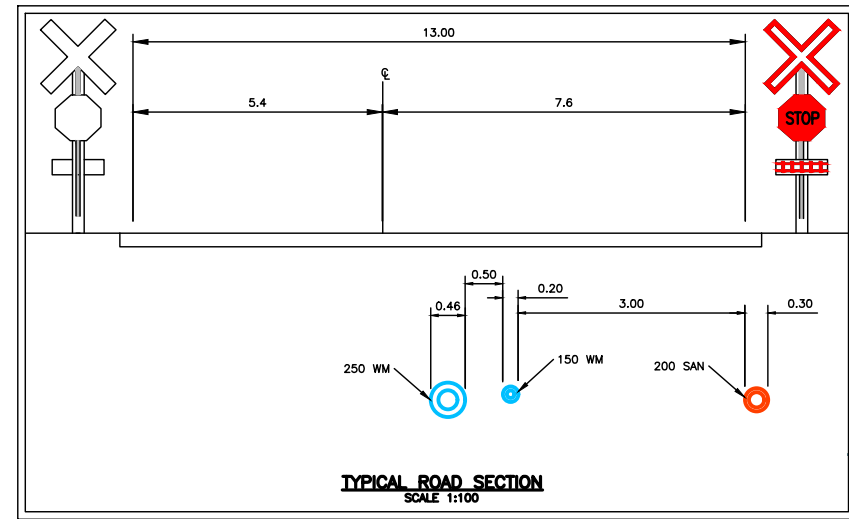



**TYPICAL ROAD SECTION**  
SCALE 1:100

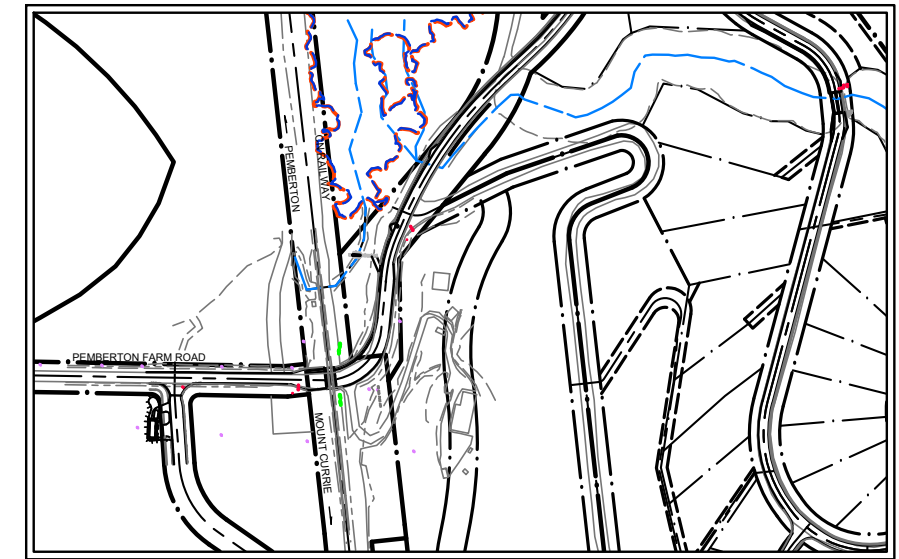

**LOCATION PLAN**  
SCALE 1:5000

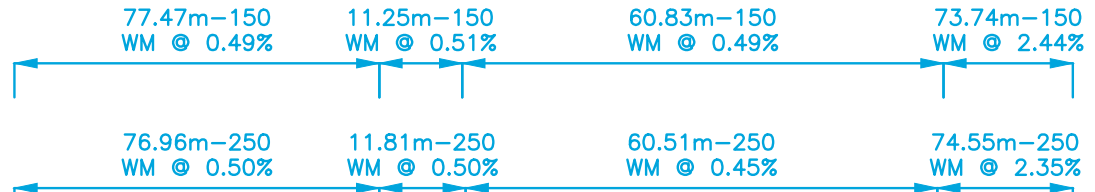

1. ALL UNDERGROUND UTILITY LOCATIONS PROTECTED AS PER TC-E10 FOR RAILWAY LOADING
2. WARNING MARKINGS AT EACH SIDE OF CN RAIL ROW
3. INSTALLATION AND MAINTENANCE IN ACCORDANCE WITH TC E-10

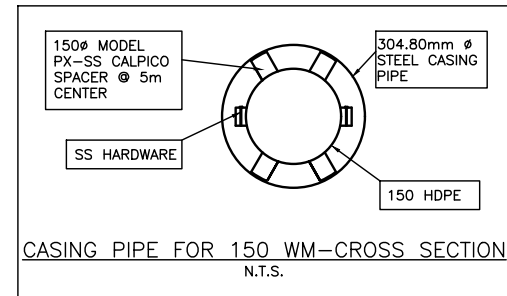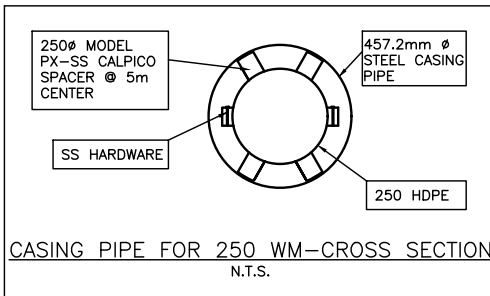


**CASING PIPE SPECIFICATION-250 WM: 18"Ø-0.312" WALL STEEL CASING**

OUTSIDE DIAMETER:	457.2mm
INSIDE DIAMETER:	441.3mm
WALL THICKNESS:	7.95mm
PIPE SPECIFICATION:	241MPa MIN. YIELD STRENGTH
LENGTH:	36.3m
MATERIAL:	STEEL
PROTECTION:	N/A
CARRIER PIPE SPECIFICATION:	HDPE
CONTENTS:	POTABLE WATER
INSIDE DIAMETER:	220mm
WALL THICKNESS:	25mm
SPEC.:	DR11
OPER./MAX. PRES.:	35psi/160psi
PROTECTION:	NIL

**CASING PIPE SPECIFICATION-150 WM: 12"Ø-0.250" WALL STEEL CASING**

OUTSIDE DIAMETER:	304.80mm
INSIDE DIAMETER:	292.00mm
WALL THICKNESS:	6.40mm
PIPE SPECIFICATION:	241MPa MIN. YIELD STRENGTH
LENGTH:	36.3m
MATERIAL:	STEEL
PROTECTION:	N/A
CARRIER PIPE SPECIFICATION:	HDPE
CONTENTS:	POTABLE WATER
INSIDE DIAMETER:	119mm
WALL THICKNESS:	23.06mm
SPEC.:	DR7.3
OPER./MAX. PRES.:	215psi/254psi
PROTECTION:	NIL

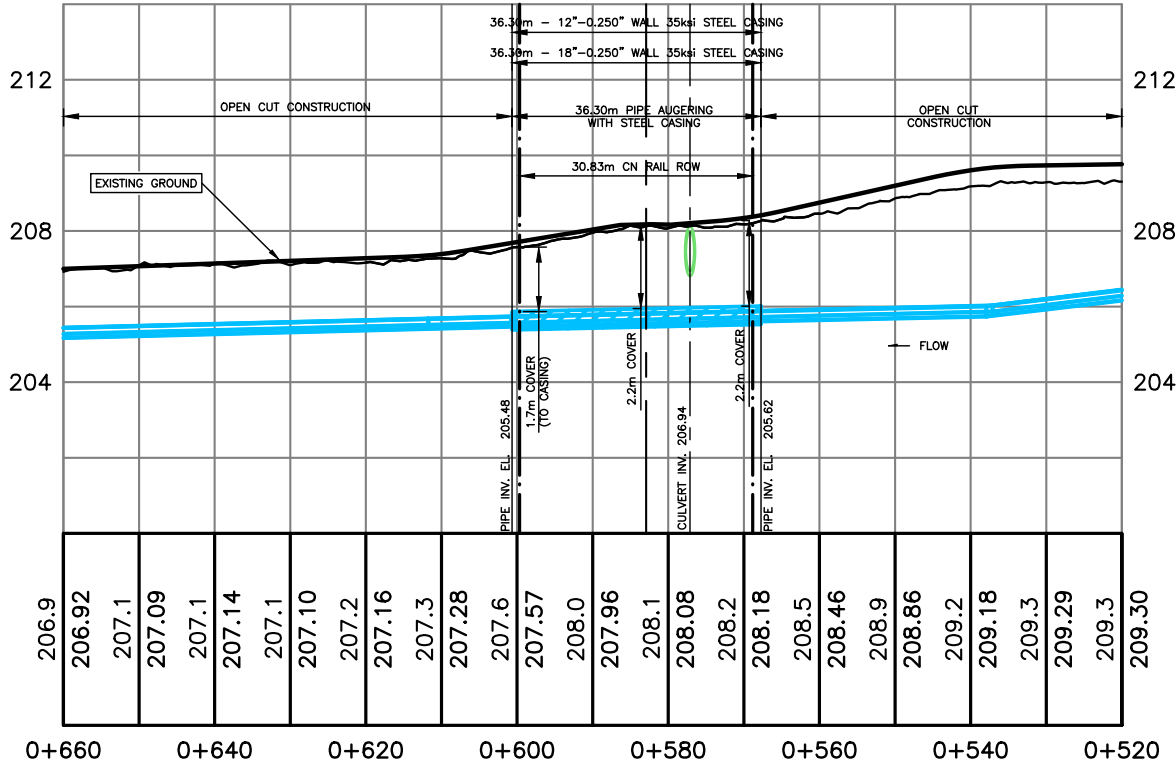

**CROSSING PROFILE**  
SCALE 1:1000

CANADIAN NATIONAL RAILWAY	
DIVISIONAL ENGINEER	
REGIONAL ENGINEER	
MANAGER	
RAILWAY CHAINAGE	
MILEAGE	
SUBDIVISION	

11	2018-02-06	PROJECT RECORDS OFFSITE	client
10	2017-10-17	PROJECT RECORDS OFFSITE	
9	2017-03-07	REISSUED FOR CONSTRUCTION OFFSITE	project
8	2016-11-09	REISSUED FOR CONSTRUCTION OFFSITE	
no.	date	revision	

client  
**580049 BC LTD.**

project  
**THE RIDGE AT PEMBERTON - PHASE 1  
PEMBERTON, BC**

**CREUS Engineering Ltd**  
Civil Engineers

P: 604-987-9070 F: 604-987-9071  
200 - 901 WEST 16TH ST NORTH VANCOUVER, BC V7P 1R2

designed by **N.G.B.**

drawn by **A.A.P.**


checked by **K.B.H.**

date **MAY.31.16**


title  
**CN RAIL CROSSING  
WATER CROSSING**

scales	hor: -	vert: -
file no.	<b>16159</b>	
drawing no.	<b>CN-2</b>	rev. <b>11</b>




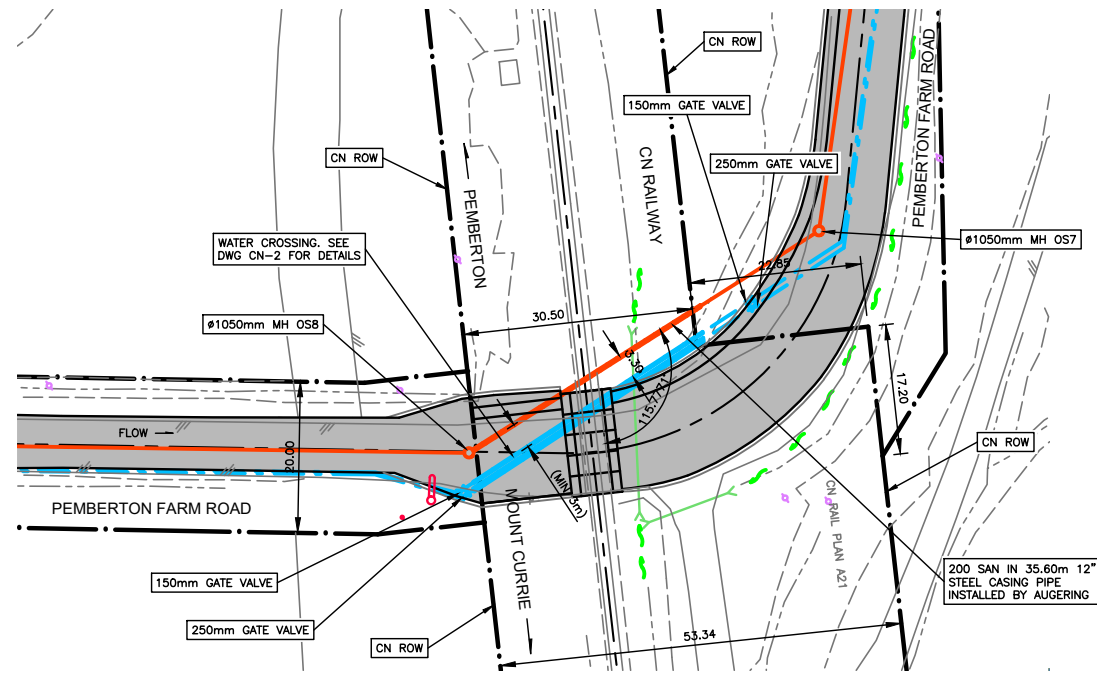


**DETAIL PLAN**  
SCALE 1:1000

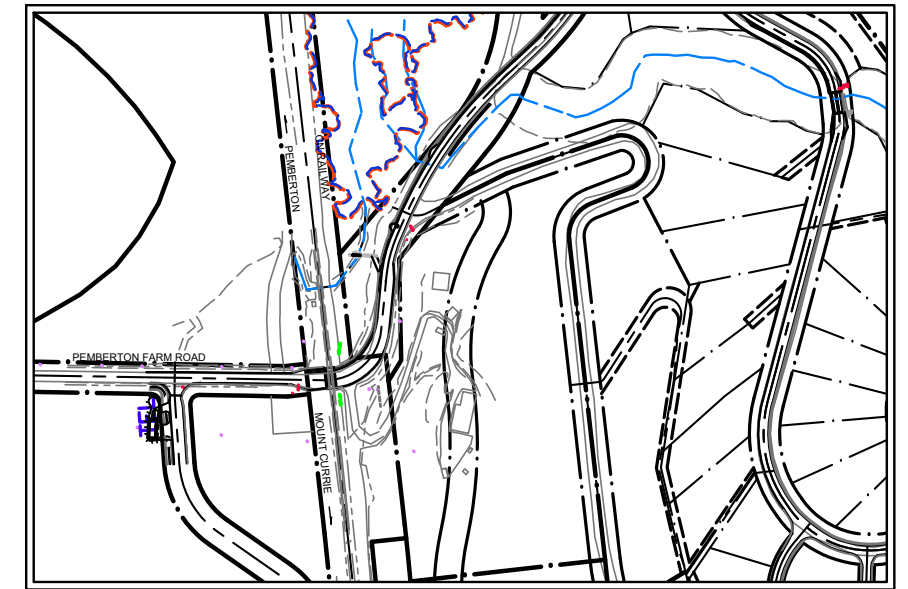

**LOCATION PLAN**  
SCALE 1:5000

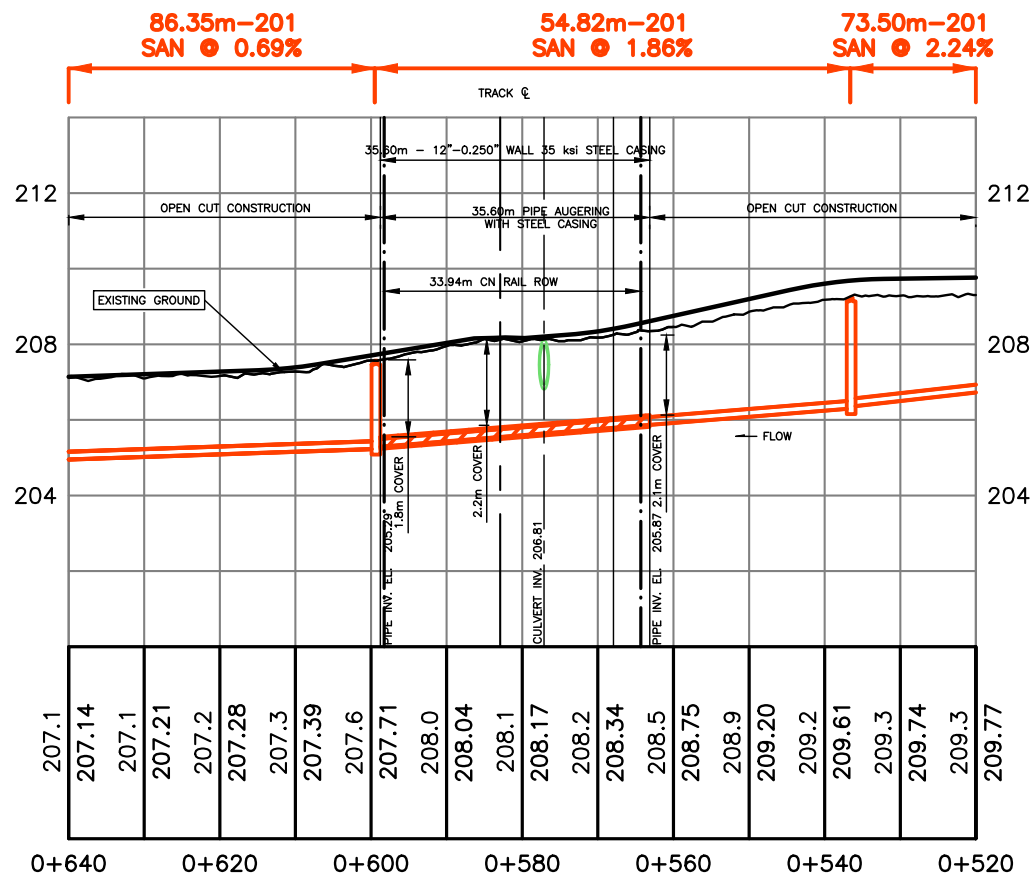


**CROSSING PROFILE**  
SCALE 1:1000

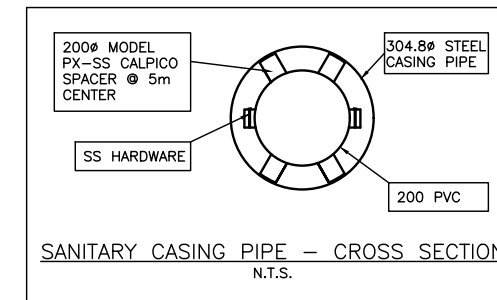

<b>CASING PIPE SPECIFICATION: 12" <math>\phi</math> - 0.250" WALL STEEL CASING</b>	
OUTSIDE DIAMETER:	304.8mm
INSIDE DIAMETER:	292.1mm
WALL THICKNESS:	6.35mm
PIPE SPECIFICATION:	241MPa MIN. YIELD STRENGTH
LENGTH:	61.77m
MATERIAL:	STEEL
PROTECTION:	N/A
<b>CARRIER PIPE SPECIFICATION: PVC SDR 35 SEWAGE</b>	
CONTENTS:	WATER
INSIDE DIAMETER:	201.16mm
WALL THICKNESS:	6.1mm
SPEC.:	DR11
OPER./MAX. PRES.:	0 psi (GRAVITY)
PROTECTION:	NIL

1. ALL UNDERGROUND UTILITY LOCATIONS PROTECTED AS PER TC-E10 FOR RAILWAY LOADING
2. WARNING MARKINGS AT EACH SIDE OF CN RAIL ROW
3. INSTALLATION AND MAINTENANCE IN ACCORDANCE WITH TC E-10

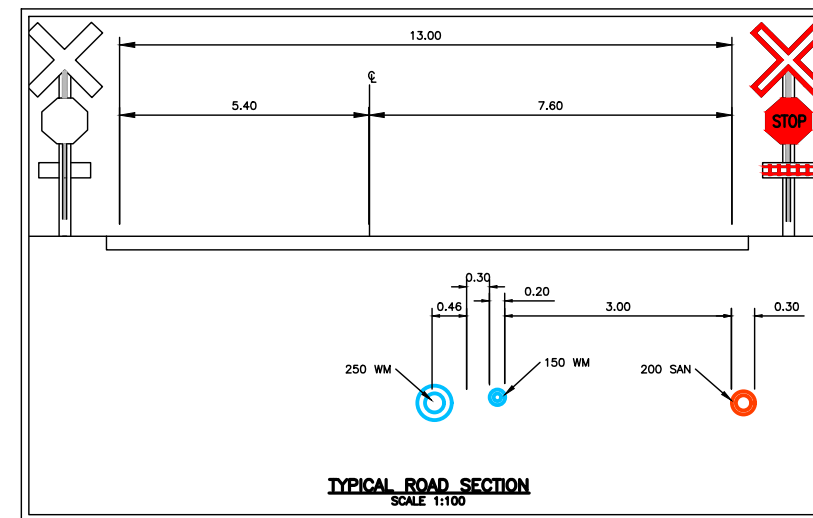

**TYPICAL ROAD SECTION**  
SCALE 1:100

<b>CANADIAN NATIONAL RAILWAY</b>	
DIVISIONAL ENGINEER	
REGIONAL ENGINEER	
MANAGER	
RAILWAY CHAINAGE	
MILEAGE	
SUBDIVISION	

10	2018-02-06	PROJECT RECORDS OFFSITE	client
9	2017-10-17	PROJECT RECORDS OFFSITE	
8	2017-03-07	REISSUED FOR CONSTRUCTION OFFSITE	project
7	2016-11-09	REISSUED FOR CONSTRUCTION OFFSITE	
no.	date	revision	

580049 BC LTD.	
THE RIDGE AT PEMBERTON - PHASE 1 PEMBERTON, BC	

www.creus.ca

# CREUS Engineering Ltd

Civil Engineers

P: 604-987-9070 F: 604-987-9071  
200 - 901 WEST 16TH ST NORTH VANCOUVER, BC V7P 1R2



designed by	N.G.B.	title
drawn by	A.A.P.	
checked by	K.B.H.	
date	MAY.31.16	

## CN RAIL CROSSING SANITARY CROSSING

scales	
hor: -	vert: -
file no.	16159
drawing no.	CN-3
rev.	10




AS--CONSTRUCTED INFORMATION  
 CREUS ENGINEERING LTD. CERTIFIES THAT THE WORKS & SERVICES SHOWN ON THESE DRAWINGS WERE CONSTRUCTED IN GENERAL CONFORMANCE WITH THE DRAWINGS & SPECIFICATIONS.  
 AS--CONSTRUCTED SURVEY INFORMATION SHOWN ON THESE DRAWINGS HAVE BEEN PROVIDED BY OTHERS. IT IS THE RESPONSIBILITY OF OTHERS USING THESE DRAWINGS TO CONFIRM THE LOCATION & ELEVATION OF THESE SERVICES.

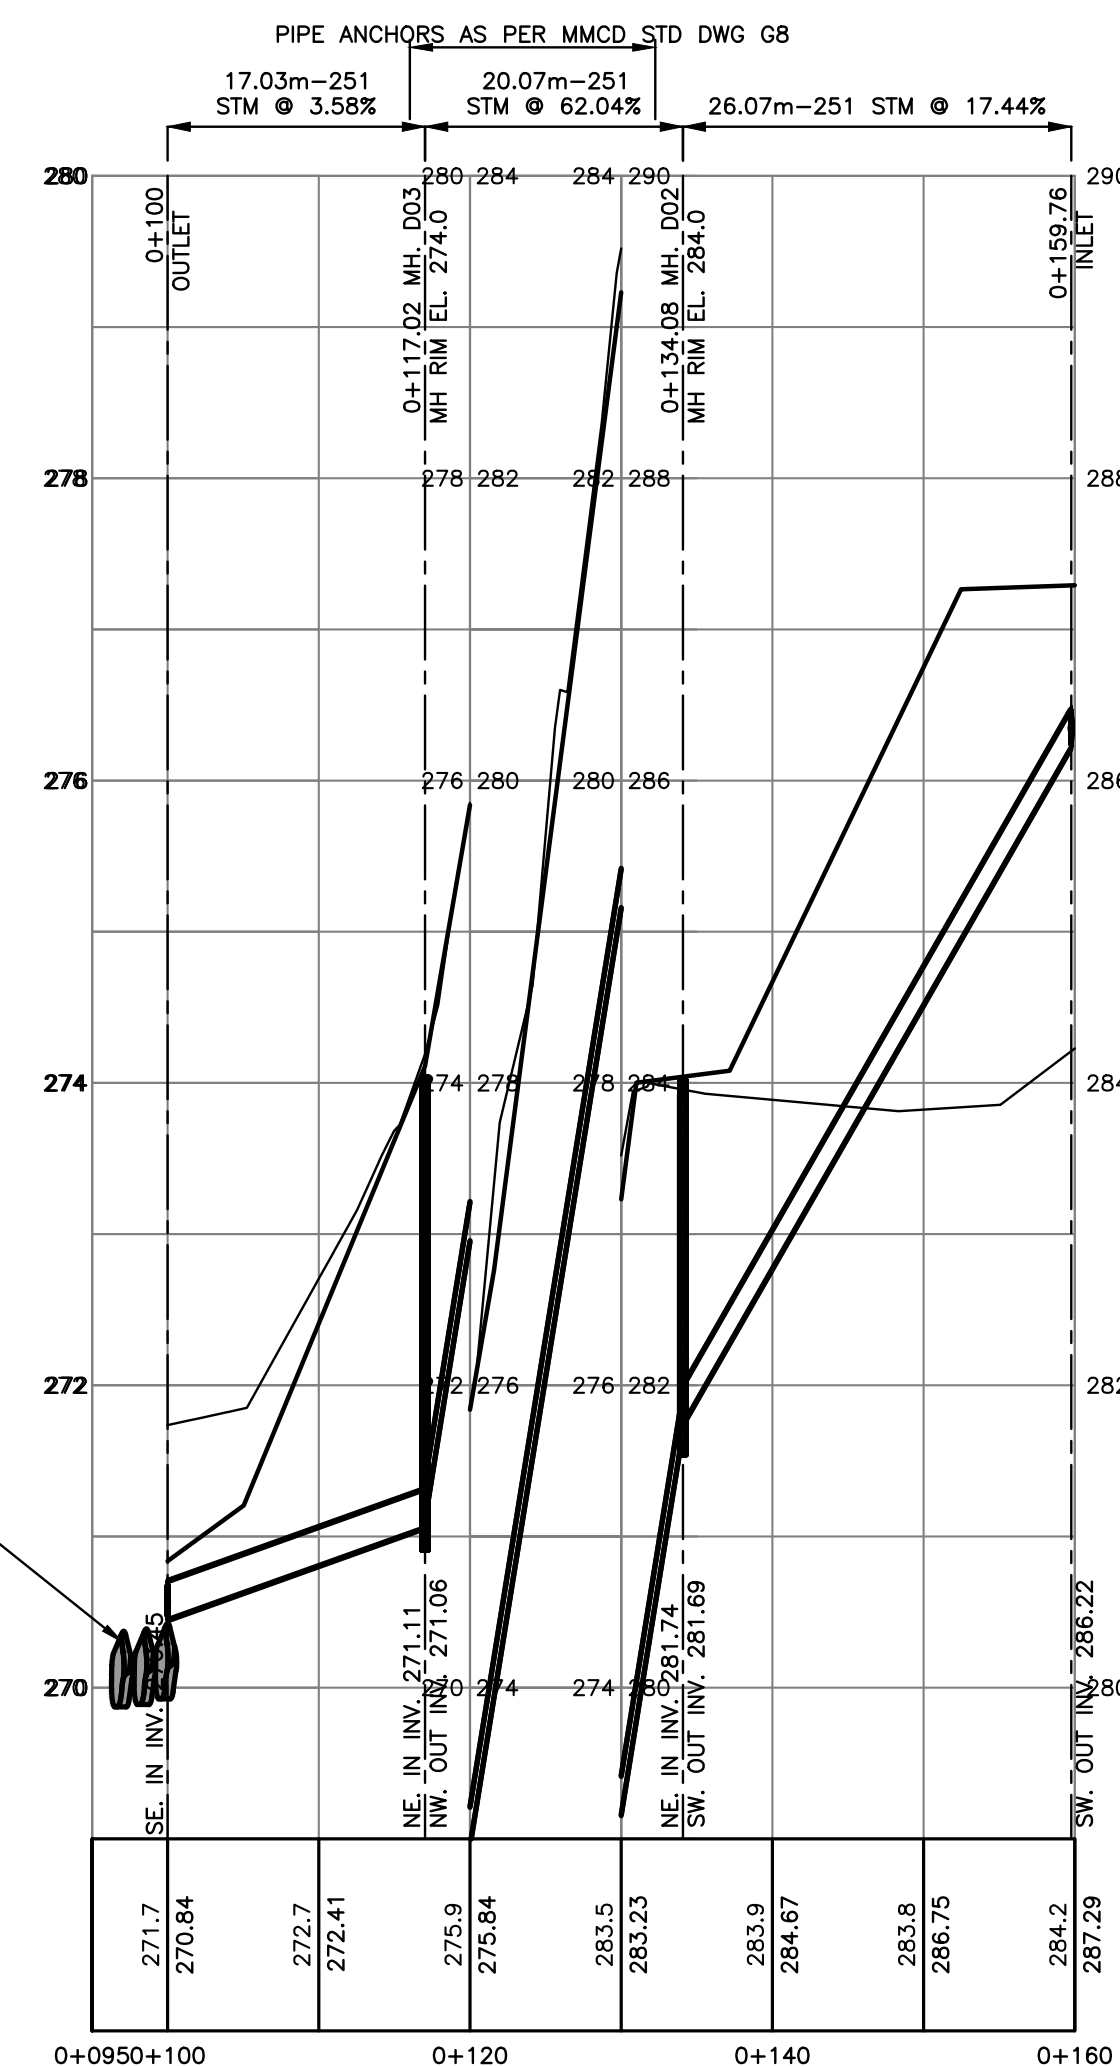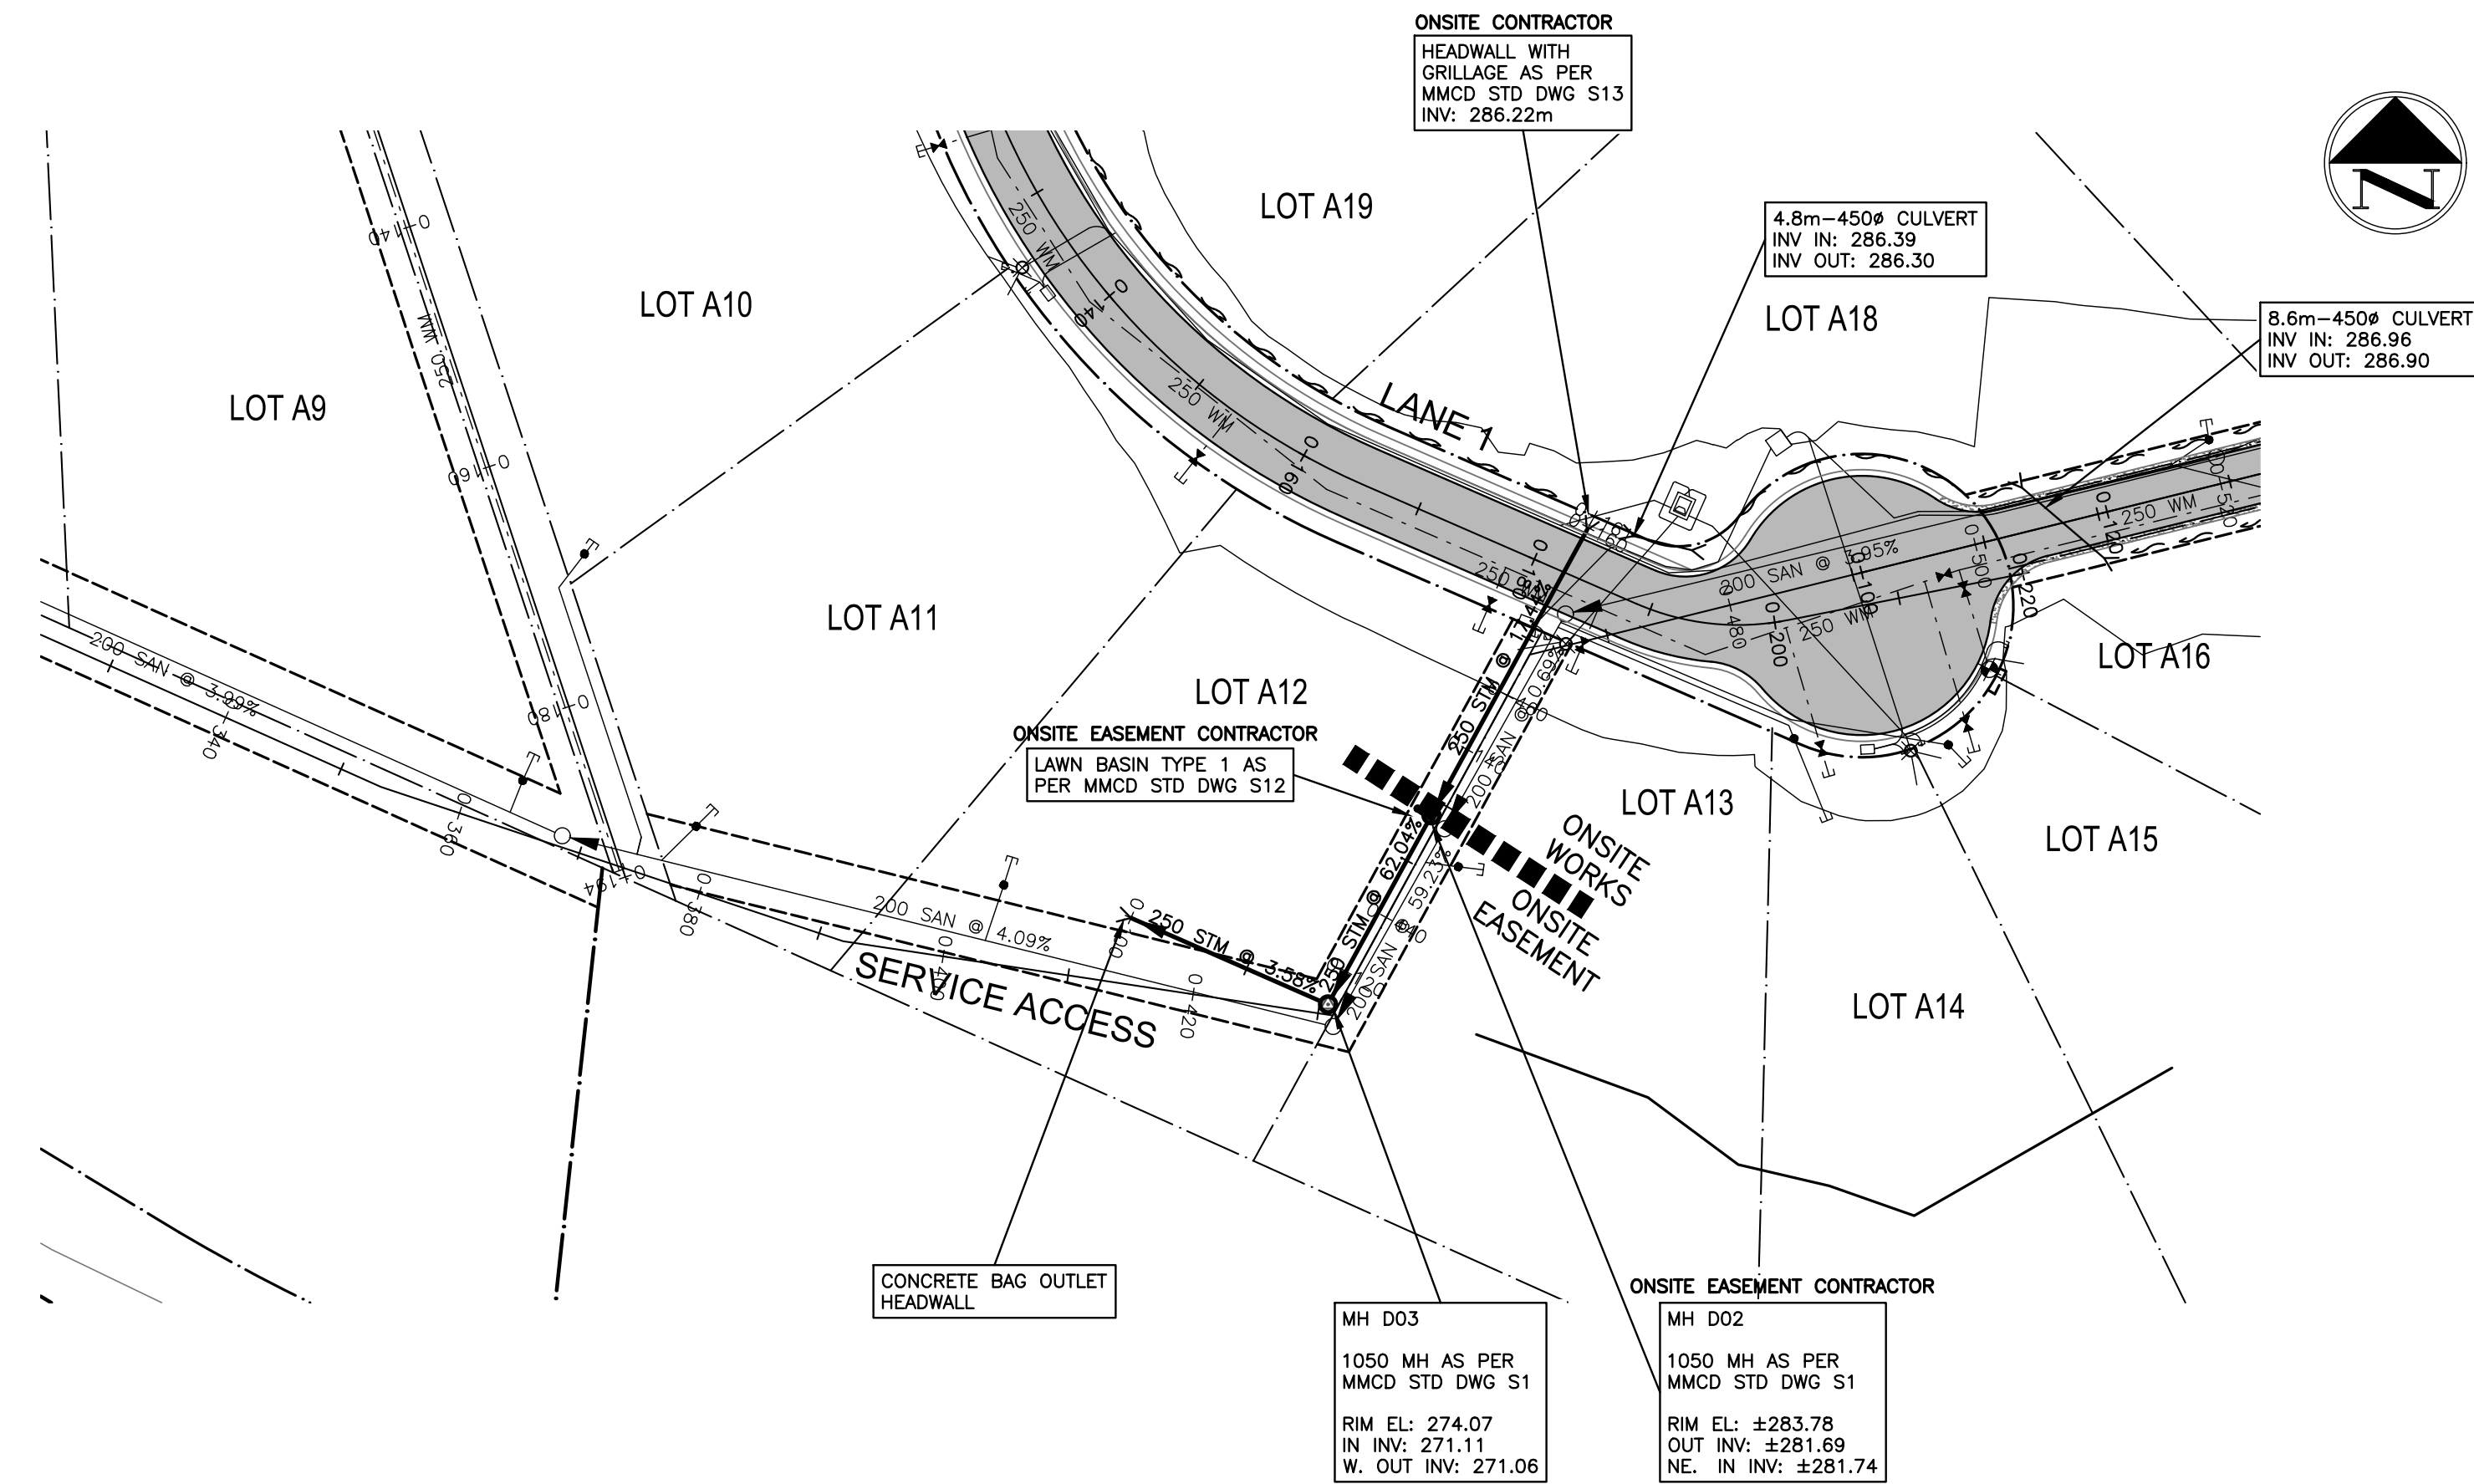

RAINFALL CAPTURE TARGET																																																							
Total Catchment Area	1536 m <sup>2</sup> (see SMP dwg)																																																						
Building Area (Impervious)	100 m <sup>2</sup> (see SMP dwg)																																																						
Hardscape Area (Impervious)	150 m <sup>2</sup> (see SMP dwg)																																																						
Permeable Pavement (Semi-PerVIOUS)	0 m <sup>2</sup> (see SMP dwg)																																																						
Landscape Area (PerVIOUS)	1286 m <sup>2</sup> (see SMP dwg)																																																						
Total Percent Impervious	16%																																																						
Total Catchment Area	1536 m <sup>2</sup>																																																						
<b>Objective: Capture The 50% MAR Storm Event</b>																																																							
MAR Rainfall Event	35 mm VOP IDF																																																						
50% of MAR Rainfall Event	17 mm																																																						
Total Impervious Area	x 250 m <sup>2</sup> (As Above)																																																						
Rainfall on Area	= 4.3 m <sup>3</sup>																																																						
Total Rainfall Volume To Be Captured	= 4.3 m <sup>3</sup>																																																						
<b>Rock Pit Capture</b>																																																							
Rock Pit Depth	0.90 m																																																						
Rock Pit Width	2.50 m																																																						
Rock Pit Length	4.50 m																																																						
Rock Pit Porosity	30%																																																						
Storage Volume	= 3.0 m <sup>3</sup> (Storage Volume)																																																						
Infiltration Rate	10 mm/hr (Typical Rate)																																																						
Potential Infiltration Provided Over 24hr	= 4.2 m <sup>3</sup> (Infiltration Volume)																																																						
Rock Pit Capture	= 7.2 m <sup>3</sup> (Storage + Infiltration)																																																						
Available Runoff for Capture	= 4.3 m <sup>3</sup> (Rainfall on Surface)																																																						
Total Rainfall Captured	= 4.3 m <sup>3</sup> (Lesser of Above)																																																						
<b>SUMMARY</b>																																																							
Total Rainfall Volume To Be Captured	= 4.3 m <sup>3</sup> (As Above)																																																						
Rock Pit Capture Volume	= 4.3 m <sup>3</sup> (As Above)																																																						
Runoff During Storm Event	= 0 m <sup>3</sup> OKAY																																																						
<b>AREAS</b>																																																							
Pre Development Catchment Area	1536 m <sup>2</sup>																																																						
Building/Roof Area (Impervious)	0 m <sup>2</sup>																																																						
Hardscape Area (Impervious)	0 m <sup>2</sup>																																																						
Landscape Area (PerVIOUS)	1536 m <sup>2</sup>																																																						
Post Development Catchment Area	1536 m <sup>2</sup>																																																						
Building/Roof Area (Impervious)	100 m <sup>2</sup>																																																						
Hardscape Area (Impervious)	150 m <sup>2</sup>																																																						
Permeable Paver Area (Semi-PerVIOUS)	0 m <sup>2</sup>																																																						
Landscape Area (PerVIOUS)	1286 m <sup>2</sup>																																																						
Post Development Percent Impervious	16%																																																						
<b>PREDEVELOPMENT</b>																																																							
Pre Development Peak Flows	Catchment Area (A) 1536 m <sup>2</sup> (As Above)																																																						
Weighted Average From Impervious And PerVIOUS Areas	Building/Roof Runoff Coefficient 0.95 for 0 m <sup>2</sup>																																																						
Hardscape Runoff Coefficient 0.80 for 0 m <sup>2</sup>	Landscape Runoff Coefficient 0.30 for 1536 m <sup>2</sup>																																																						
Pre Development Runoff Coefficient (C) = 0.30 for 1536 m <sup>2</sup>	Rainfall Intensity (I) 20 min From Pemberton IDF Curve... 10yr Rainfall Intensity 23 mm/hr																																																						
Pre Development Peak Flow (Q=CIA) = 2.9 l/s																																																							
<b>POSTDEVELOPMENT</b>																																																							
Post Development Peak Flows	Catchment Area (A) 1536 m <sup>2</sup> (As Above)																																																						
Weighted Average From Impervious And PerVIOUS Areas	Building/Roof Runoff Coefficient 0.95 for 100 m <sup>2</sup>																																																						
Hardscape Runoff Coefficient 0.80 for 150 m <sup>2</sup>	Permeable Paver Runoff Coefficient 0.50 for 0 m <sup>2</sup>																																																						
Landscape Runoff Coefficient 0.30 for 1286 m <sup>2</sup>	Post Development Runoff Coefficient (C) = 0.39 for 1536 m <sup>2</sup>																																																						
Pre Development TOC From Pemberton IDF Curve... 10yr Rainfall Intensity 15 min	26 mm/hr																																																						
Post Development Peak Flow (Q=CIA) = 4.3 l/s																																																							
<b>DETECTION REQUIREMENTS</b>																																																							
<table border="1"> <thead> <tr> <th>Duration (min)</th> <th>Intensity (mm/hr)</th> <th>Peak Flow (l/s)</th> <th>Release Rate (l/s)</th> <th>Difference (l/s)</th> <th>Volume (m<sup>3</sup>)</th> </tr> </thead> <tbody> <tr><td>5</td><td>62</td><td>10.3</td><td>2.9</td><td>7.3</td><td>1.7</td></tr> <tr><td>10</td><td>45</td><td>7.5</td><td>2.9</td><td>4.5</td><td>2.3</td></tr> <tr><td>20</td><td>33</td><td>5.4</td><td>2.9</td><td>2.5</td><td>2.8</td></tr> <tr><td>30</td><td>27</td><td>4.5</td><td>2.9</td><td>1.6</td><td>2.9</td></tr> <tr><td>60</td><td>20</td><td>3.3</td><td>2.9</td><td>0.3</td><td>1.5</td></tr> <tr><td>120</td><td>14</td><td>2.4</td><td>2.9</td><td>-0.5</td><td>-3.2</td></tr> <tr><td>180</td><td>12</td><td>2.0</td><td>2.9</td><td>-1.0</td><td>-9.3</td></tr> <tr><td>240</td><td>10</td><td>1.7</td><td>2.9</td><td>-1.2</td><td>-15.9</td></tr> </tbody> </table>		Duration (min)	Intensity (mm/hr)	Peak Flow (l/s)	Release Rate (l/s)	Difference (l/s)	Volume (m <sup>3</sup> )	5	62	10.3	2.9	7.3	1.7	10	45	7.5	2.9	4.5	2.3	20	33	5.4	2.9	2.5	2.8	30	27	4.5	2.9	1.6	2.9	60	20	3.3	2.9	0.3	1.5	120	14	2.4	2.9	-0.5	-3.2	180	12	2.0	2.9	-1.0	-9.3	240	10	1.7	2.9	-1.2	-15.9
Duration (min)	Intensity (mm/hr)	Peak Flow (l/s)	Release Rate (l/s)	Difference (l/s)	Volume (m <sup>3</sup> )																																																		
5	62	10.3	2.9	7.3	1.7																																																		
10	45	7.5	2.9	4.5	2.3																																																		
20	33	5.4	2.9	2.5	2.8																																																		
30	27	4.5	2.9	1.6	2.9																																																		
60	20	3.3	2.9	0.3	1.5																																																		
120	14	2.4	2.9	-0.5	-3.2																																																		
180	12	2.0	2.9	-1.0	-9.3																																																		
240	10	1.7	2.9	-1.2	-15.9																																																		
Peak Storage Requirement	= 2.8 m <sup>3</sup>																																																						
Storage Provided	= 3.0 OKAY > 2.8																																																						

Civil Engineers & Project Managers  
 SUITE 200-901 16TH ST WEST, NORTH VANCOUVER BC, V7P1R2  
 PH: 604-987-0070 WEBSITE: www.creus.ca

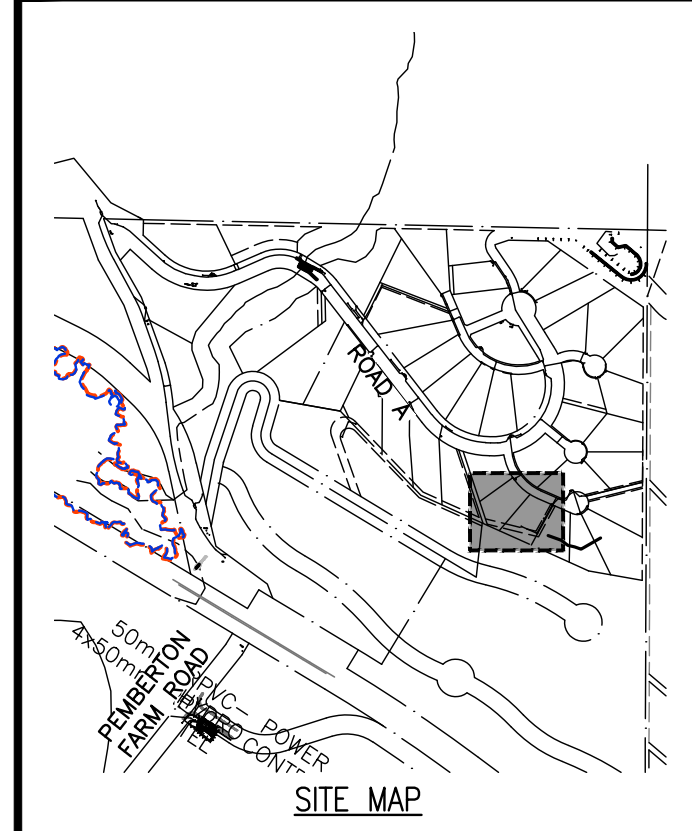

**DRAWING LEGEND**

	EXISTING	PROP.	TO BE REMOVED
LEGAL LINE	---	---	---
EASEMENT	---	---	---
WATERMAIN	---	---	---
SANITARY	---	---	---
STORM	---	---	---
HYDRO	---	---	---
TEL	---	---	---
STREETLIGHT	---	---	---
GAS	---	---	---
FIRE HYDRANT	---	---	---
GATE VALVE	---	---	---
AIR VALVE	---	---	---
REDUCER	---	---	---
INSPECTION CHAMBER	---	---	---
CATCHBASIN (STD/SI)	---	---	---
CAP	---	---	---
MANHOLE	---	---	---
POWER POLE	---	---	---
STREETLIGHT	---	---	---

approved

client

580049 BC LTD.

project

THE RIDGE AT PEMBERTON  
 PHASE 1  
 PEMBERTON, BC

title

STORMWORKS  
 LANE 1 TO ROAD B

no.	(y/m/d)	revision	chk'd
13	18-02-06	PROJECT RECORDS OFFSITE	KBH
12	18-02-06	PROJECT RECORDS ONSITE	KBH
11	17-10-17	PROJECT RECORDS OFFSITE	KBH
10	17-04-27	REVISED GRADING	DWC
9	17-04-13	ISSUED FOR OFFSITE AI #5	AGC
8	17-03-07	REISSUED FOR CONSTRUCTION OFFSITE	KBH
7	17-02-27	ISSUED FOR CONSTRUCTION ONSITE	KBH
6	16-12-19	REVISED AS PER CLIENT REQUEST AI(4)	KBH



engineer of record	scale	hor: 1:500	vert: 1:50
K.B.H.			
designed by	N.G.B.	file no.	16159
drawn by	A.A.P.	drawing no.	D-2
date	2016-05-13		



**AS--CONSTRUCTED INFORMATION**

CREUS ENGINEERING LTD. CERTIFIES THAT THE WORKS & SERVICES SHOWN ON THESE DRAWINGS WERE CONSTRUCTED IN GENERAL CONFORMANCE WITH THE DRAWINGS & SPECIFICATIONS.


AS--CONSTRUCTED SURVEY INFORMATION SHOWN ON THESE DRAWINGS HAVE BEEN PROVIDED BY OTHERS. IT IS THE RESPONSIBILITY OF OTHERS USING THESE DRAWINGS TO CONFIRM THE LOCATION & ELEVATION OF THESE SERVICES.

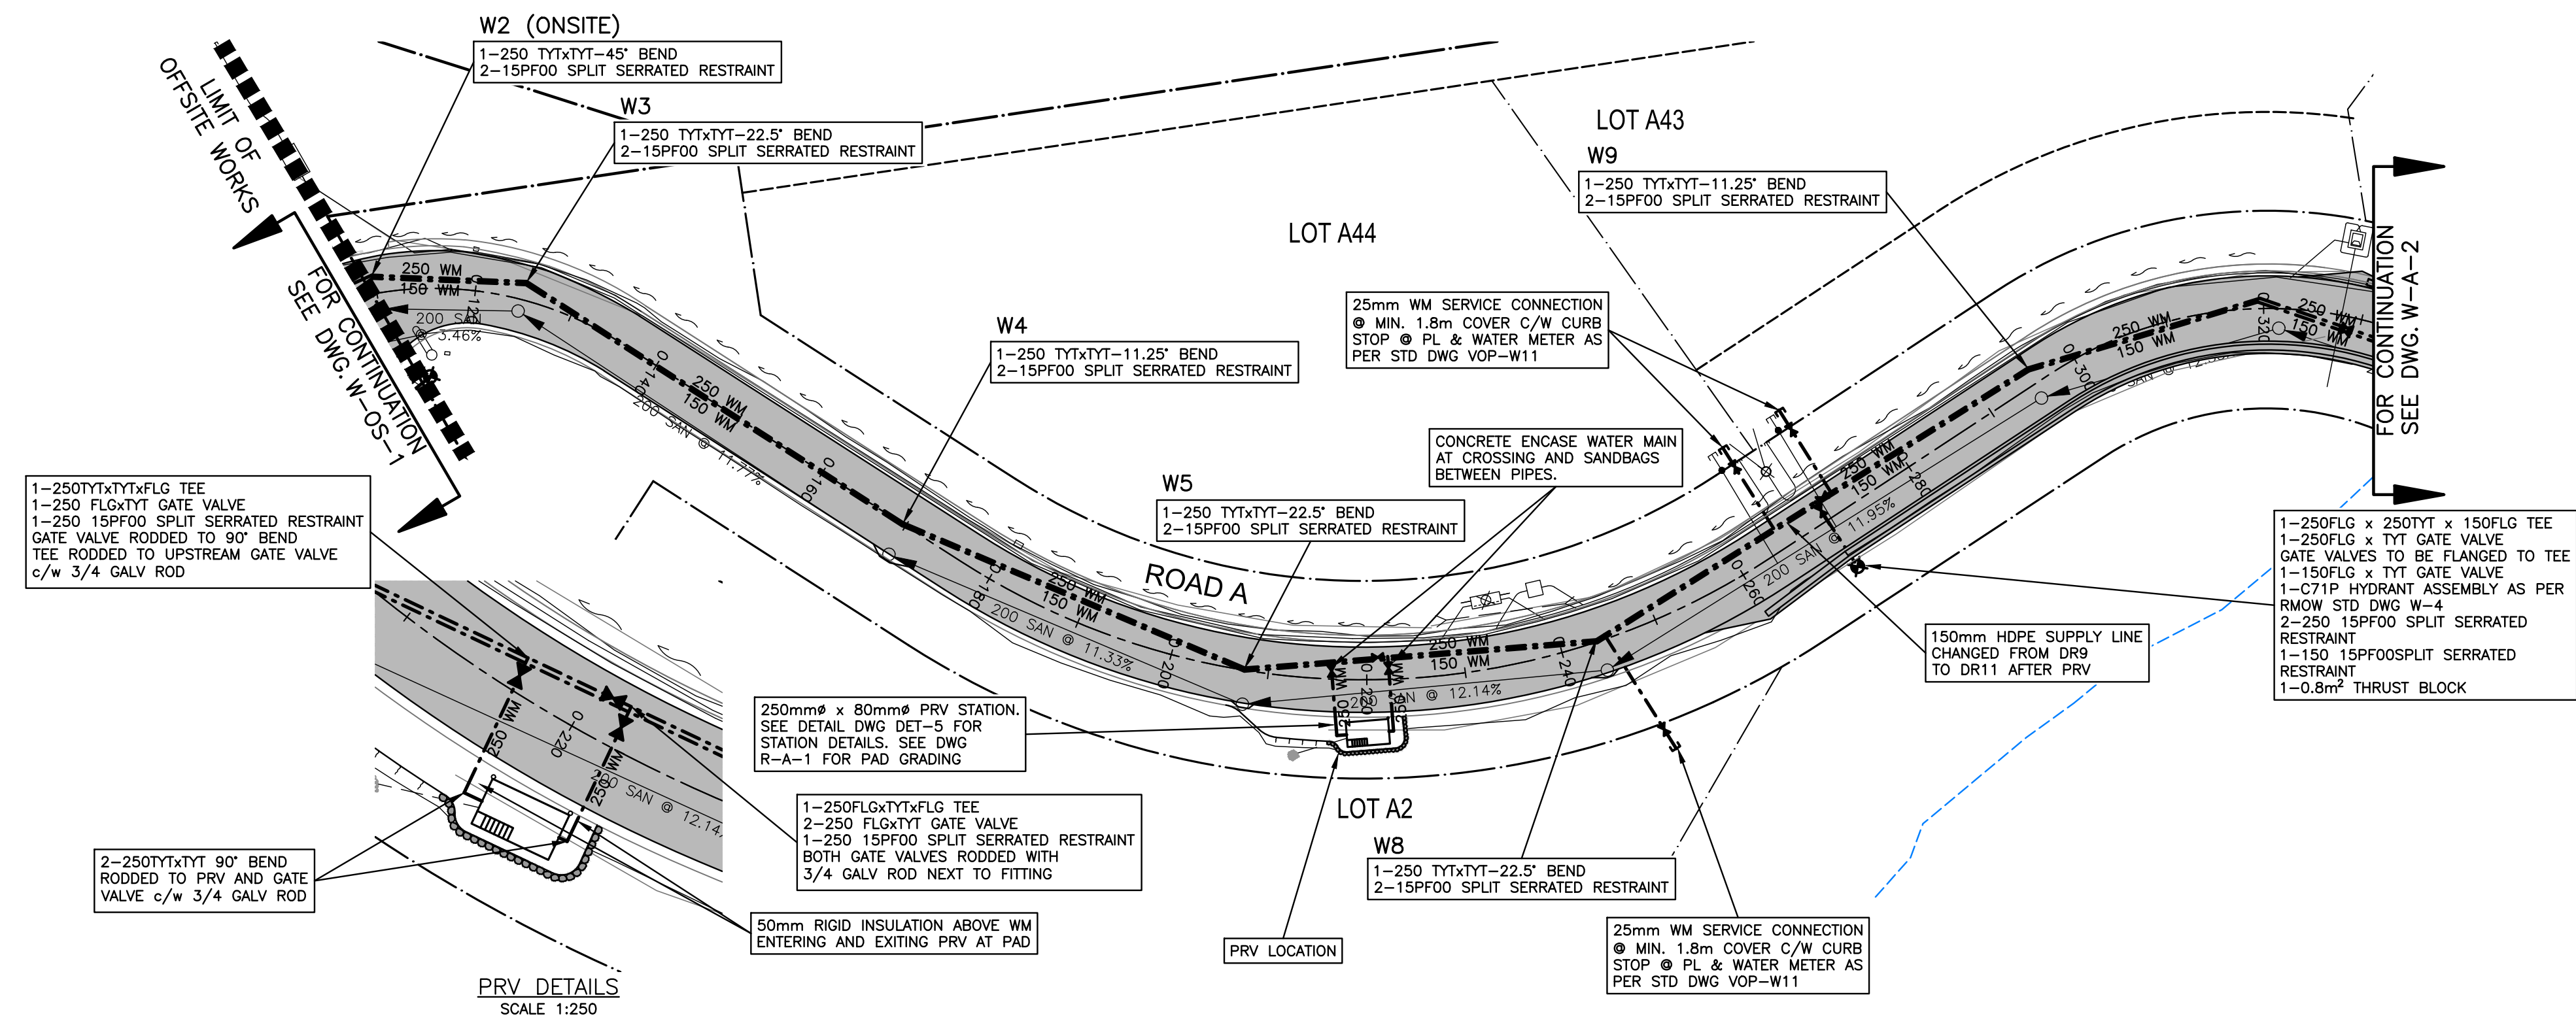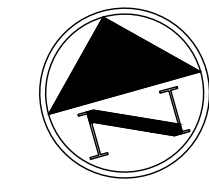

PIPE ANCHOR BLOCKS AS PER MMCD STD DWG G8

150mm HDPE DR 9 c/w FUSED JOINTS

150mm HDPE DR11 c/w FUSED JOINTS

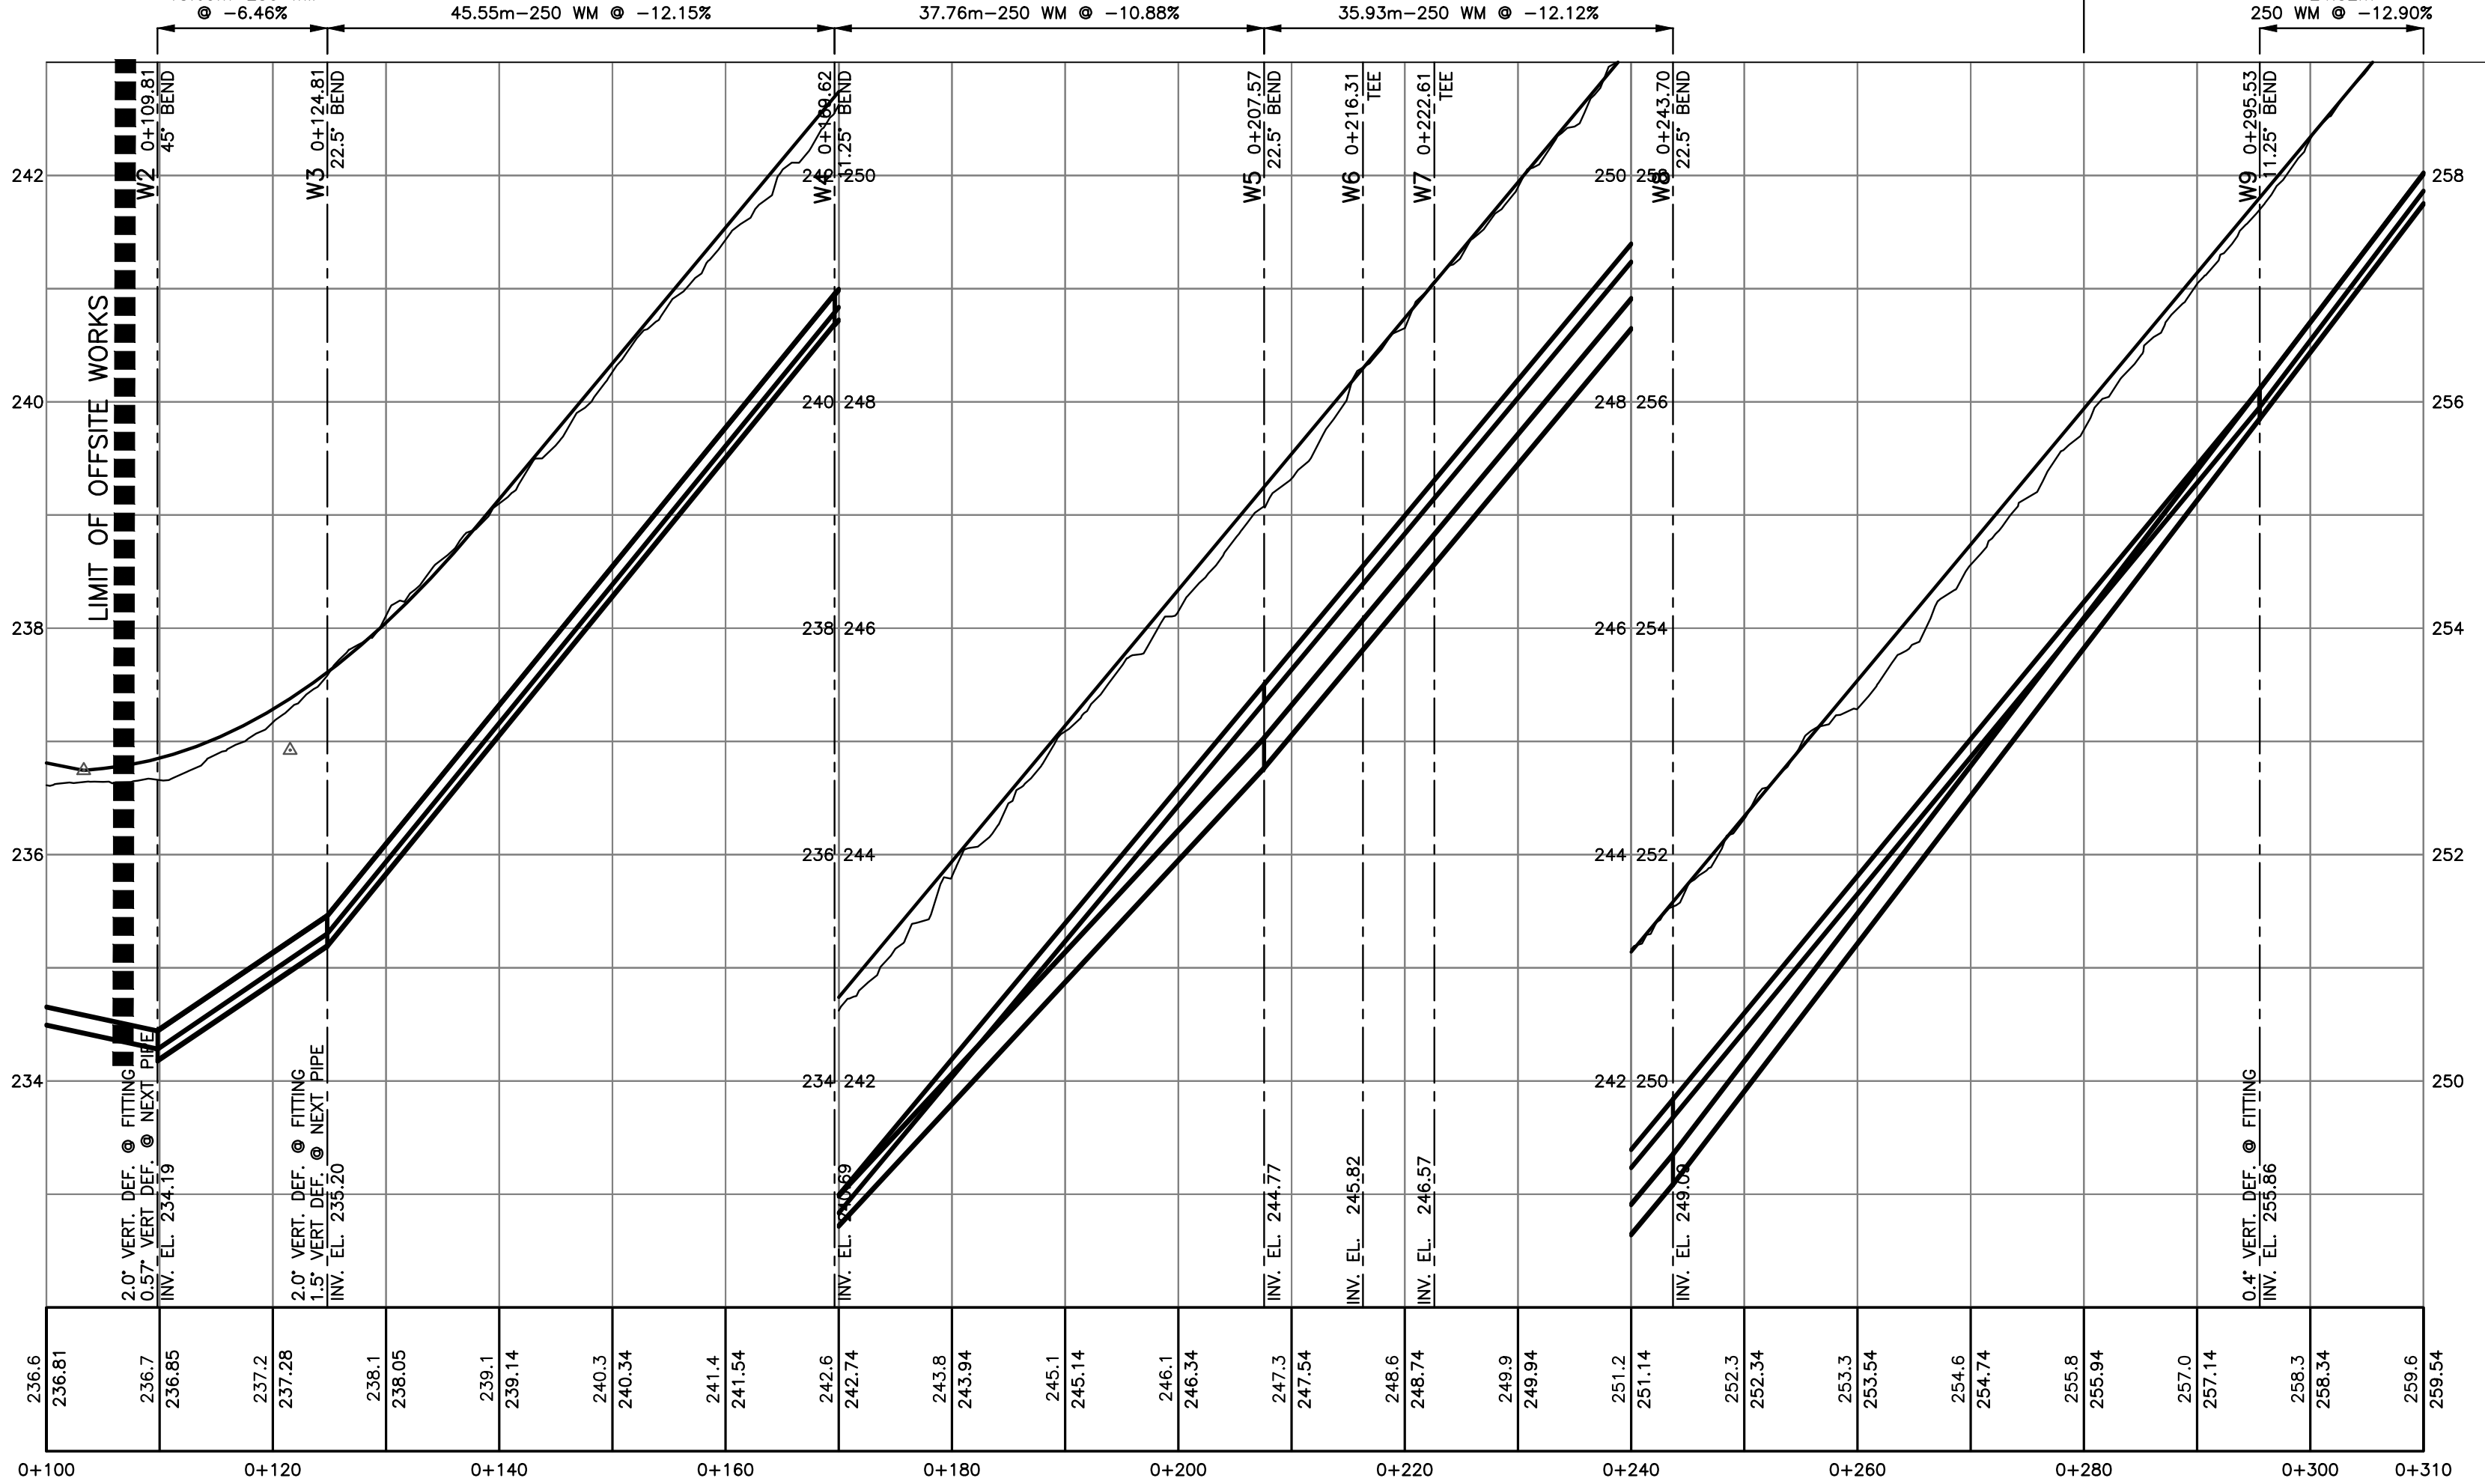


**WATERWORKS NOTES**

- VALVES AND HYDRANTS OF EXISTING SYSTEM ONLY TO BE OPERATED WITH THE PERMISSION OF THE ENGINEER AND WATER UTILITY.
- WATERMAIN TO BE PVC DR18 TO AWWA C900 FOR ALL PIPE 100mm TO 300mm IN DIAMETER. PIPE LARGER THAN 300mm TO BE AWWA C905. ALL PIPE TO BE CSA B137.3 CERTIFIED.
- ALL FITTINGS TO BE DUCTILE IRON TO AWWA C110 OR C153. CEMENT MORTAR LINED TO AWWA C104, TYTON JOINTS TO AWWA C111, & ASTM D313.9 & GASKETS TO ASTM F477 WITH CLOSED LUGS.
- HDPE JOINTS TO BE HEAT BUTT FUSION TO ASTM D2657, FITTINGS TO AWWA C906 AS PER MMCD
- ALL WORKS TO BE PER MMCD (LATEST EDITION), MUNICIPAL REQUIREMENTS, CONTRACT DOCUMENTS AND ALSO, THE BCBC (LATEST EDITION) WITHIN PROPERTY LIMITS.
- HYDRANTS TO BE TERMINAL CITY C71P TO RMOW STD. DRAWING W4. VALVE TO BE MMCD STD. & LEADS TO BE DUCTILE IRON AS PER WATERMAIN PIPING ABOVE. VILLAGE OF PEMBERTON TO PROVIDE ALL MATERIALS & FITTINGS INCLUDING VALVES FOR WORKS PROVIDED BY THEIR CREWS.
- SERVICE CONNECTIONS TO BE MARKED WITH A 40mm x 90mm POST PAINTED BLUE AT TERMINATION. SERVICES TO BE TERMINATED 1m BEYOND THE PROPERTY LINE, UNLESS OTHERWISE NOTED.
- DURING CONSTRUCTION AND AT ANY TIME PRIOR TO ACCEPTANCE AND PRESSURIZING OF MAINS, THE CONTRACTOR SHALL BAG OR PLACE A 0.3m SQUARE 20mm SHEET OF PLYWOOD OVER THE PUMPER NOZZLE OF THE HYDRANT TO INDICATE THE HYDRANT IS NOT IN USE.
- WATERMAIN TO BE CONSTRUCTED A MINIMUM OF 0.5m ABOVE STORM OR SANITARY SEWERS AND MAINTAIN 3.0m HORIZONTAL CLEARANCE. IN AREAS WHERE LESS THAN 0.5m VERTICAL OR 3.0m HORIZONTAL CLEARANCE CAN NOT BE MAINTAINED, ALL JOINTS TO BE HEAT SHRINK WRAPPED OR TAPE WRAPPED AS PER MINISTRY OF HEALTH STANDARDS; ANS/AWWA C214 (FACTORY APPLIED), ANS/AWWA C209 (FIELD APPLIED) ANS/AWWA C217-90 (RETROLATUM TAPE) ALL TO MINISTRY OF HEALTH STANDARDS. WATERMAIN CROSSINGS OF STORM OR SANITARY SEWER TO BE MADE AT MIDPOINT OF PIPE.
- WHERE SEWER MAIN CROSSES WATERMAIN AND CLEARANCE IS LESS THAN 0.5m, THE UPPER PIPE SHALL BE CONCRETE ENCASED PER MMCD STD DWG G6 AND WRAPPED AS PER NOTE ABOVE.
- WHERE WATERMAIN PIPE GRADE EXCEEDS 10% PIPE TO BE ANCHORED AS PER MMCD STD DWG G8. JOINT RESTRAINTS TO MMCD SPECIFICATION SECTION O2666 TO BE INSTALLED WHERE GRADE EXCEEDS 20%.
- PIPE BEDDING TO CONFORM WITH MMCD STANDARDS. SEE MMCD STD. DWG G4 AND BE COMPACTED TO 95% MODIFIED PROCTOR PRIOR TO BACKFILLING TRENCH.
- EXCAVATION AND PAVEMENT RESTORATION TO BE COMPLETED BY CONTRACTOR PER REGULATORY AUTHORITY REQUIREMENTS, MMCD STANDARDS AND CONTRACT DOCUMENTS. CONTRACTOR TO GIVE NOTICE PRIOR TO COMPLETING WORKS.
- WHERE IT IS SPECIFIED THAT THE CONTRACTOR IS TO MAKE TIE-IN(S) TO EXISTING WATERMAIN(S), ALL TIE-INS SHALL BE MADE UNDER THE SUPERVISION OF THE ENGINEER. CONTRACTOR TO ADVISE ENGINEER 48 HOURS PRIOR TO TIE-IN. WHERE THE TIE-IN SCOPE IS NOT SPECIFIED VOP TO MAKE TIE-IN - CONTRACTOR TO GIVE VOP & ENGINEER A MINIMUM OF 2 WEEKS NOTICE IN ADVANCE OF THE TIE-IN.
- INSTALLATION, TESTING AND CHLORINATING TO BE PERFORMED IN ACCORDANCE WITH VILLAGE OF PEMBERTON AND MMCD CONSTRUCTION SPECIFICATIONS AND AWWA C800 AND C851. ENGINEER AND VILLAGE TO BE GIVEN 48 HOURS NOTICE PRIOR TO TESTING AND CONTRACTOR TO INSURE TESTING IS COMPLETED IN THE PRESENCE OF THE ENGINEER.
- MINIMUM COVER ON WATERMAIN = 1.8m.
- THRUST BLOCKS AS PER MMCD STD DWG W1.
- BLOW OFF AND AIR VALVES AS PER MMCD STD DWGS W6 & W7.
- PIPE BEDDING TO CONFORM WITH MMCD STANDARDS. SEE MMCD STD. DWG G4 AND BE COMPACTED TO 95% MODIFIED PROCTOR PRIOR TO BACKFILLING TRENCH.
- COVERS FOR INSPECTION CHAMBERS, VALVE RISERS AND METER CHAMBERS LOCATED WITHIN DRIVEWAYS SHALL BE SUITABLE FOR H2O TRAFFIC LOADING.
- LOCATION OF SERVICE CONNECTIONS TO BE CONFIRMED BY ENGINEER ONCE ROUGH GRADING COMPLETE.
- EXCAVATION AND PAVEMENT RESTORATION FOR WATERMAIN TIE-IN FROM EX. WATERMAIN TO PROPERTY LINE TO BE COMPLETED BY CONTRACTOR. VILLAGE OF PEMBERTON UTILITIES DEPT. WILL SUPPLY WET TAP MATERIALS AND COMPLETE TIE-IN AT DEVELOPER'S COST. CONTRACTOR IS RESPONSIBLE FOR REPLACEMENT OF ANY PAVEMENT AND BOULEVARD TO THE PRE-CONSTRUCTION CONDITION OR BETTER.
- ALL ONSITE WATERMAIN PIPING TO BE PVC DR18 PIPE TO AWWA C900 FOR PIPE 100mm TO 300mm DIAMETER AND AWWA C905 FOR PIPE LARGER THAN 300mm. ALL PIPE TO BE CSA B137.3 CERTIFIED.
- ALL VALVES OUTSIDE PAVED AREAS TO INCLUDE MINIMUM 1.0m ASPHALT OR CONCRETE APRON.

RESTRAINT TABLE		
TYPE OF FITTING	LENGTH OF RESTRAINT	
DEAD END, CAPS, AND VALVES	30.0m	
TEES 250x200	2.0m ON TEE AND BRANCHES	
TEES 250x250	2.0m ON TEE AND BRANCHES	
VERTICAL OFFSET	UPPER BEND	LOWER BEND
	11.25	2.1m 1.0m
	22.5	4.0m 1.5m
	45	12.5m 3.0m
HORIZONTAL BEND	11.25	1.0m
	22.5	1.5m
	45	3.0m
	90	7.3m

Civil Engineers & Project Managers  
SUITE 200-901 16TH ST WEST, NORTH VANCOUVER BC, V7P1R2  
PH: 604-987-0070 WEBSITE: www.creus.ca

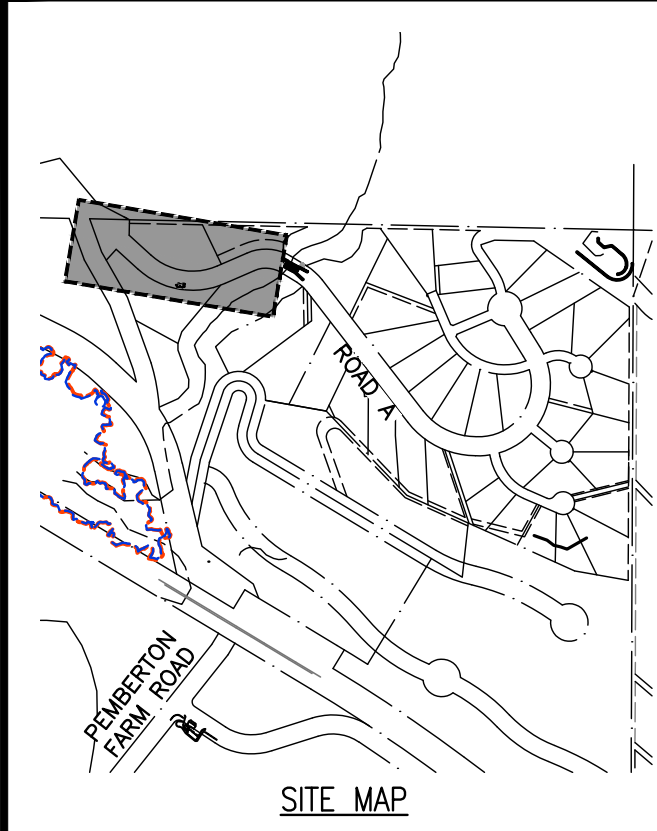

**DRAWING LEGEND**

	EXISTING	PROP.	TO BE REMOVED
LEGAL LINE	---	---	---
EASMENT	---	---	---
WATERMAIN	---	---	---
SANITARY	---	---	---
STORM	---	---	---
HYDRO	---	---	---
TEL	---	---	---
STREETLIGHT	---	---	---
GAS	---	---	---
	EXISTING	PROP.	TO BE REMOVED
FIRE HYDRANT	⊗	⊗	⊗
GATE VALVE	⊗	⊗	⊗
AIR VALVE	⊗	⊗	⊗
REDUCER	⊗	⊗	⊗
INSPECTION CHAMBER	⊗	⊗	⊗
CATCHBASIN (STD/SI)	⊗	⊗	⊗
CAP	⊗	⊗	⊗
MANHOLE	⊗	⊗	⊗
POWER POLE	⊗	⊗	⊗
STREETLIGHT	⊗	⊗	⊗

approved

client

580049 BC LTD.

project

THE RIDGE AT PEMBERTON  
PHASE 1  
PEMBERTON, BC

title

WATERWORKS  
ROAD A (STA 0+100-0+310)

no.	(y/m/d)	revision	chk'd
17	18-02-06	PROJECT RECORDS OFFSITE	KBH
16	18-02-06	PROJECT RECORDS ONSITE	KBH
15	17-04-13	ISSUED FOR OFFSITE AI #5	AGC
14	17-03-07	REISSUED FOR CONSTRUCTION OFFSITE	KBH
13	17-02-27	ISSUED FOR CONSTRUCTION ONSITE	KBH
12	16-11-09	REISSUED FOR CONSTRUCTION ONSITE	KBH
11	16-11-09	REISSUED FOR CONSTRUCTION OFFSITE	KBH
10	16-10-26	IFC OFFSITE FINAL COMMENTS	KBH

engineer of record	K.B.H.	file no.	16159
designed by	N.G.B.	drawing no.	W-A-1
drawn by	R.J.L.	date	2016-05-13
scale	hor: 1:500 vert: 1:50	current rev. #	17






**AS-CONSTRUCTED INFORMATION**

CREUS ENGINEERING LTD. CERTIFIES THAT THE WORKS & SERVICES SHOWN ON THESE DRAWINGS WERE CONSTRUCTED IN GENERAL CONFORMANCE WITH THE DRAWINGS & SPECIFICATIONS.

AS-CONSTRUCTED SURVEY INFORMATION SHOWN ON THESE DRAWINGS HAVE BEEN PROVIDED BY OTHERS. IT IS THE RESPONSIBILITY OF OTHERS USING THESE DRAWINGS TO CONFIRM THE LOCATION & ELEVATION OF THESE SERVICES.

SEE DRAWING KEY-1 FOR GENERAL NOTES  
 SEE DRAWING W-A-1 FOR WATERWORKS NOTES  
 SEE DRAWING S-A-1 FOR SANITARY NOTES

Civil Engineers & Project Managers  
 SUITE 200-901 16TH ST WEST, NORTH VANCOUVER BC, V7P1R2  
 PH: 604-987-0070 WEBSITE: www.creus.ca

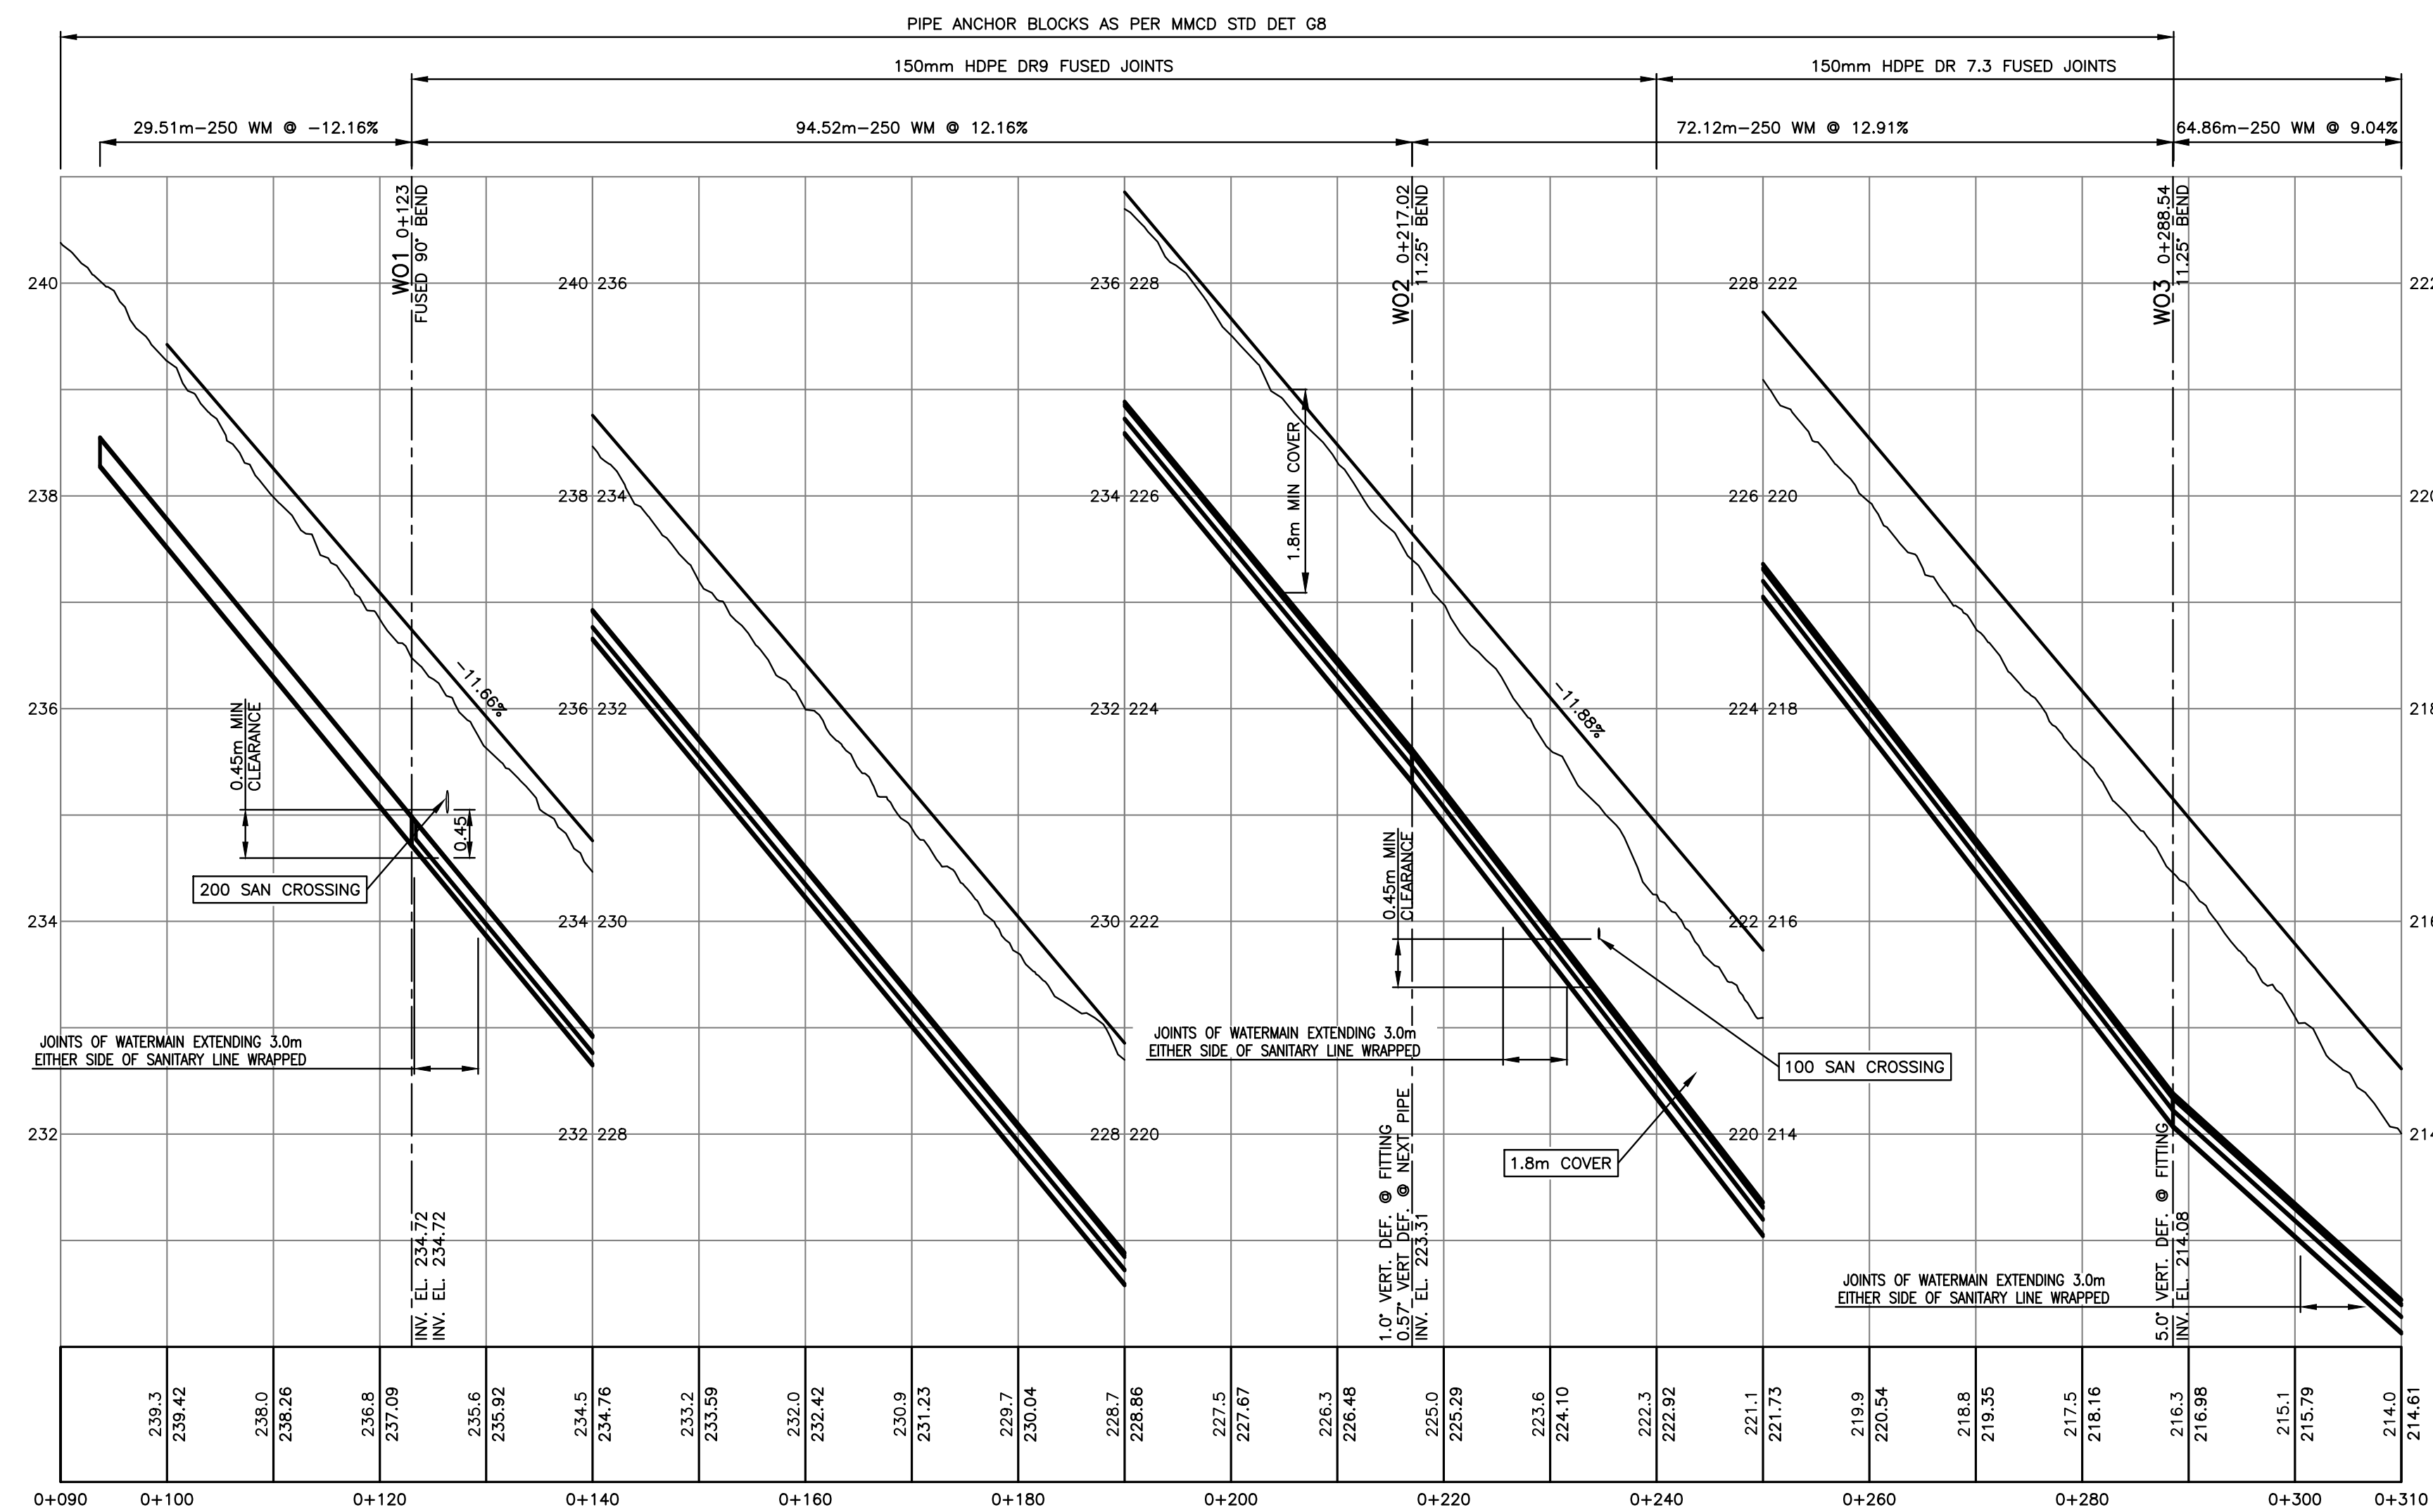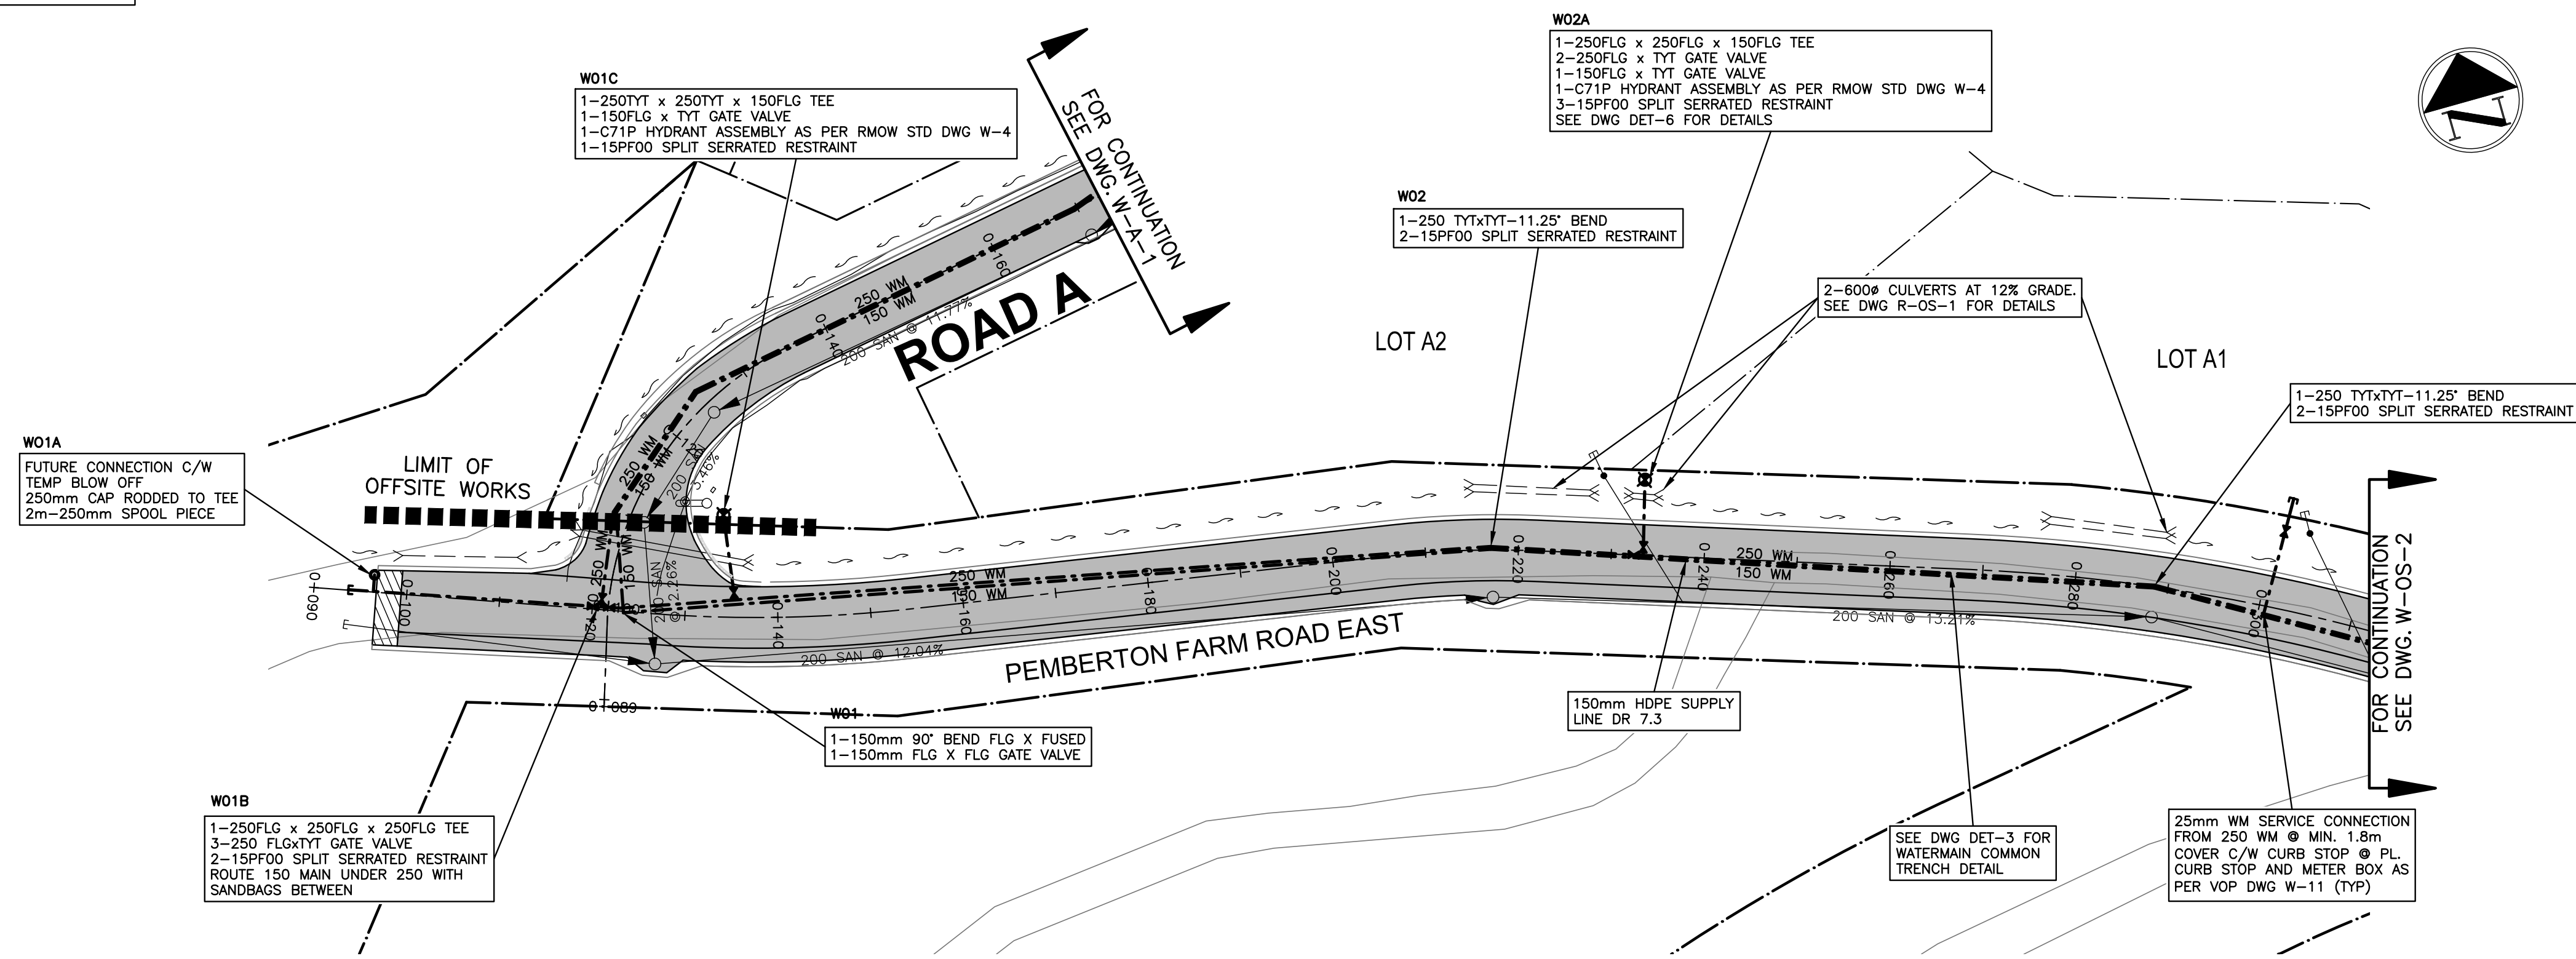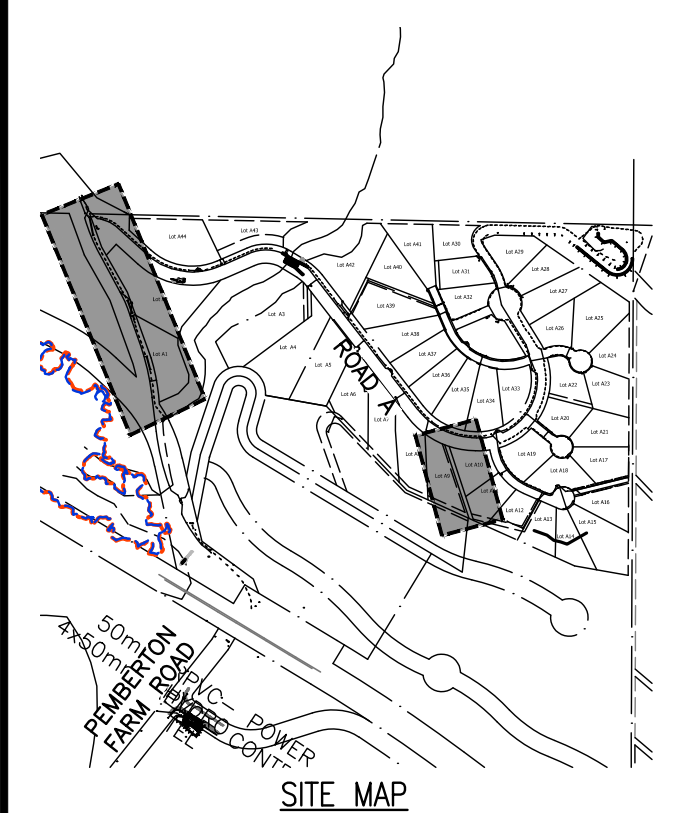

RESTRAINT TABLE		
TYPE OF FITTING	LENGTH OF RESTRAINT	
DEAD END, CAPS, AND VALVES	30.0m	
TEES 250x200	2.0m ON TEE AND BRANCHES	
TEES 250x250	2.0m ON TEE AND BRANCHES	
VERTICAL OFFSET	UPPER BEND	LOWER BEND
	11.25	2.1m
	22.5	4.0m
	45	12.5m
HORIZONTAL BEND	11.25	1.0m
	22.5	1.5m
	45	3.0m
	90	7.3m

**DRAWING LEGEND**

	EXISTING	PROP.	TO BE REMOVED
LEGAL LINE	---	---	---
EASMENT	---	---	---
WATERMAIN	---	---	---
SANITARY	---	---	---
STORM	---	---	---
HYDRO TEL	---	---	---
STREETLIGHT	---	---	---
GAS	---	---	---
	EXISTING	PROP.	TO BE REMOVED
FIRE HYDRANT	⊗	⊗	⊗
GATE VALVE	⊗	⊗	⊗
AIR VALVE	⊗	⊗	⊗
REDUCER	⊗	⊗	⊗
INSPECTION CHAMBER	⊗	⊗	⊗
CATCHBASIN (STD/SI)	⊗	⊗	⊗
CAP	⊗	⊗	⊗
MANHOLE	⊗	⊗	⊗
POWER POLE	⊗	⊗	⊗
STREETLIGHT	⊗	⊗	⊗

approved

client  
 580049 BC LTD.

project  
 THE RIDGE AT PEMBERTON  
 PHASE 1  
 PEMBERTON, BC

title  
 WATERWORKS  
 OFFSITE ROAD (STA 0+110-0+310)

no.	(y/m/d)	revision	chk'd
15	18-02-06	PROJECT RECORDS OFFSITE	KBH
14	17-10-17	PROJECT RECORDS OFFSITE	KBH
13	17-04-13	ISSUED FOR AI #5	AGC
12	17-03-07	REISSUED FOR CONSTRUCTION OFFSITE	KBH
11	16-11-09	REISSUED FOR CONSTRUCTION OFFSITE	KBH
10	16-10-26	IFC OFFSITE FINAL COMMENTS	KBH
9	16-10-21	VCH UPDATE	KBH
8	16-10-13	ISSUED FOR CONSTRUCTION OFFSITE	KBH

engineer of record	K.B.H.	scales	hor: 1:500	vert: 1:50
designed by	N.G.B.	file no.	16159	
drawn by	R.J.L.	drawing no.	W-OS-1	
date	2016-05-13			








**AS-CONSTRUCTED INFORMATION**

CREUS ENGINEERING LTD. CERTIFIES THAT THE WORKS & SERVICES SHOWN ON THESE DRAWINGS WERE CONSTRUCTED IN GENERAL CONFORMANCE WITH THE DRAWINGS & SPECIFICATIONS.

AS-CONSTRUCTED SURVEY INFORMATION SHOWN ON THESE DRAWINGS HAVE BEEN PROVIDED BY OTHERS. IT IS THE RESPONSIBILITY OF OTHERS USING THESE DRAWINGS TO CONFIRM THE LOCATION & ELEVATION OF THESE SERVICES.



SEE DRAWING KEY-1 FOR GENERAL NOTES  
 SEE DRAWING W-A-1 FOR WATERWORKS NOTES  
 SEE DRAWING S-A-1 FOR SANITARY NOTES

Civil Engineers & Project Managers  
 SUITE 200-901 16TH ST WEST, NORTH VANCOUVER BC, V7P1R2  
 PH: 604-987-0070 WEBSITE: www.creus.ca

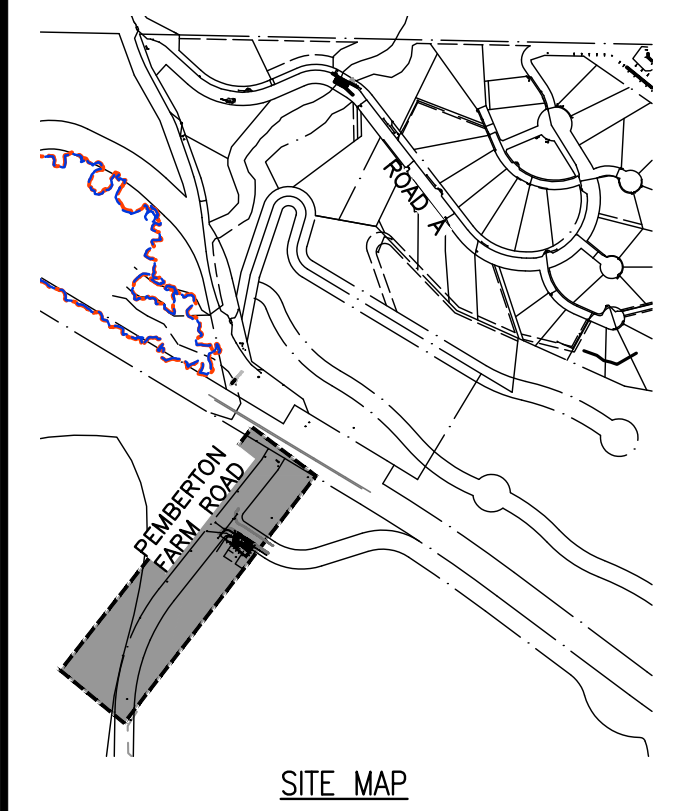

**DRAWING LEGEND**

	EXISTING	PROP.	TO BE REMOVED
LEGAL LINE	---	---	---
EASEMENT	---	---	---
WATERMAIN	---	---	---
SANITARY	---	---	---
STORM	---	---	---
HYDRO	---	---	---
TEL	---	---	---
STREETLIGHT	---	---	---
GAS	---	---	---
FIRE HYDRANT	---	---	---
GATE VALVE	---	---	---
AIR VALVE	---	---	---
REDUCER	---	---	---
INSPECTION CHAMBER	---	---	---
CATCHBASIN (STD/SI)	---	---	---
CAP	---	---	---
MANHOLE	---	---	---
POWER POLE	---	---	---
STREETLIGHT	---	---	---

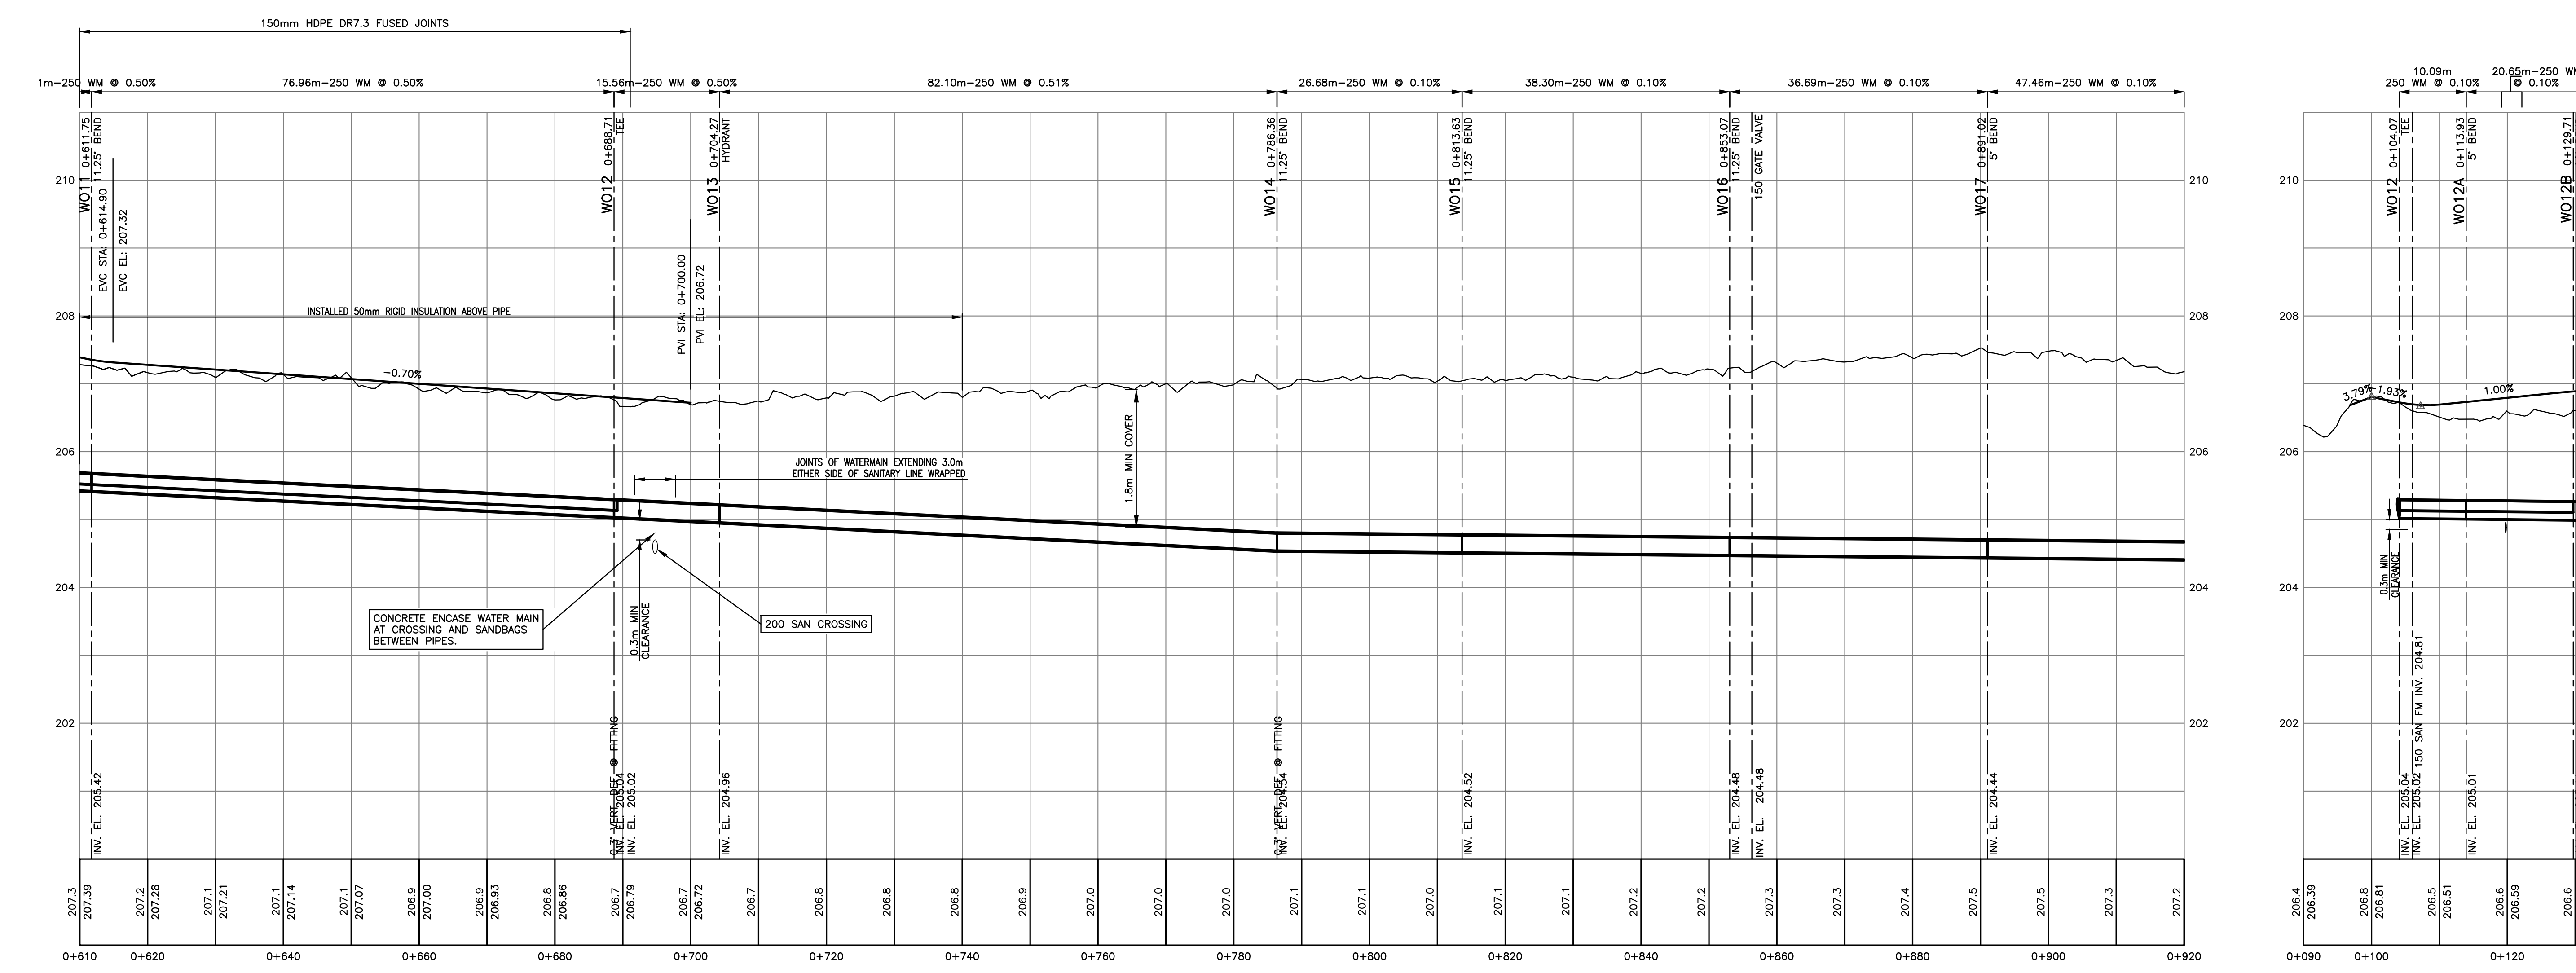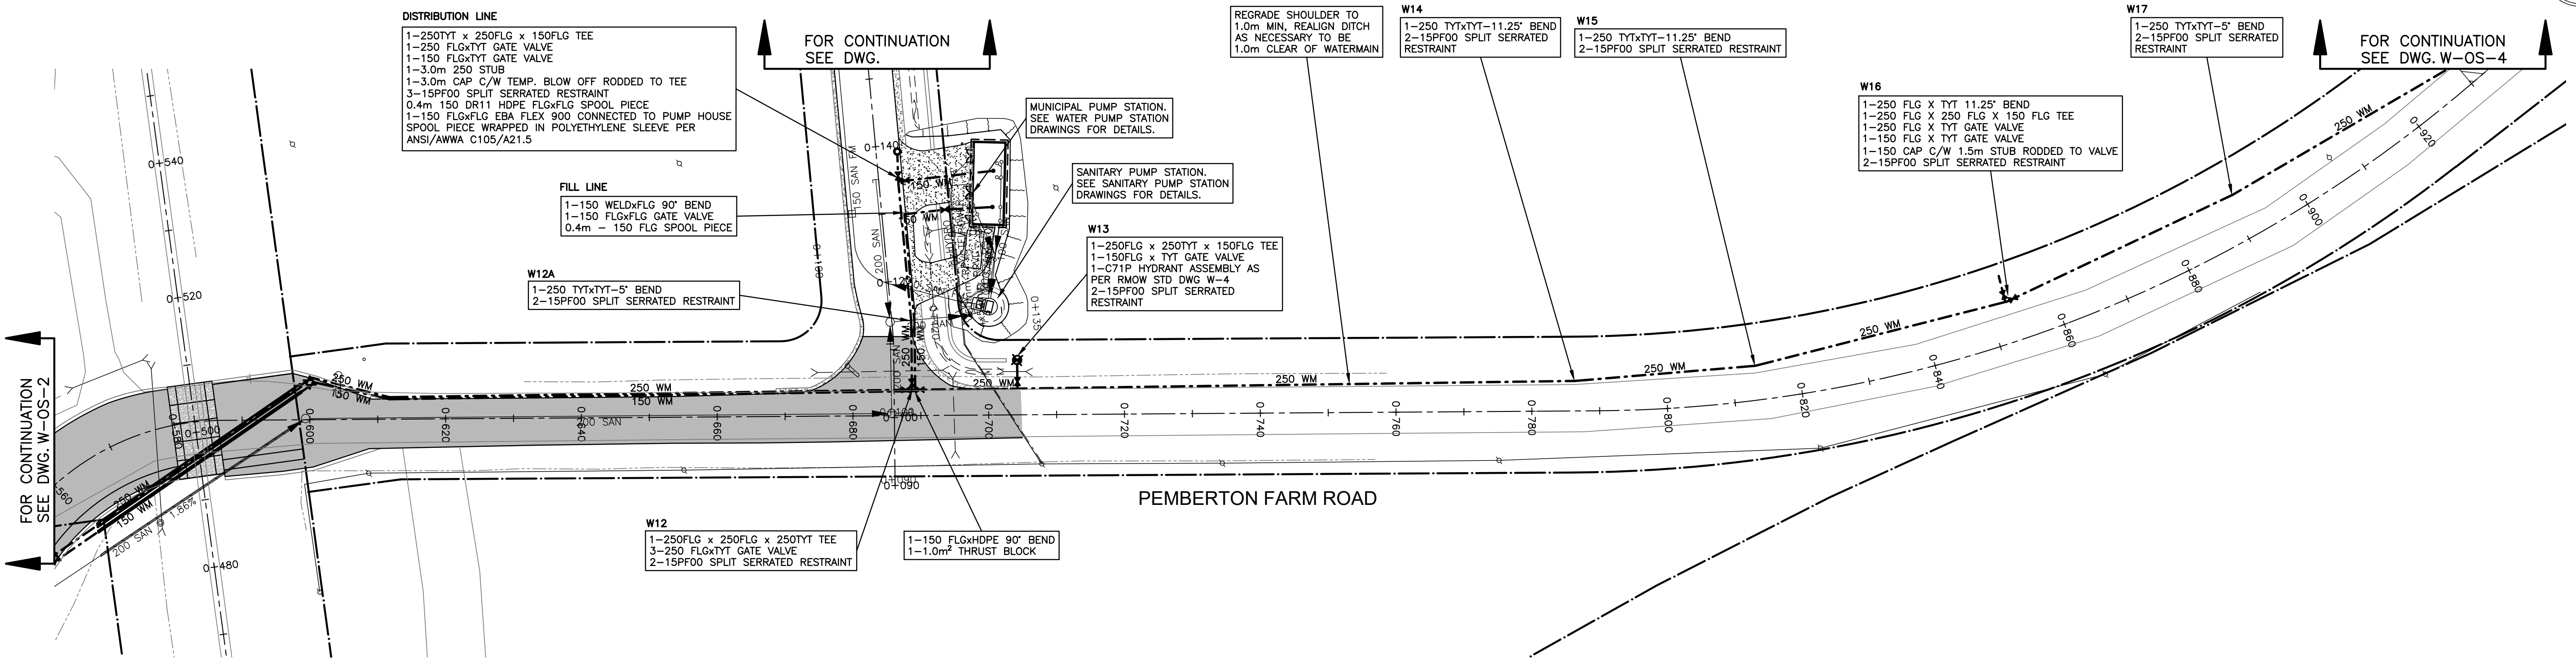

approved

client  
**580049 BC LTD.**

project  
**THE RIDGE AT PEMBERTON  
 PHASE 1  
 PEMBERTON, BC**

title  
**WATERWORKS  
 OFFSITE ROAD (STA 0+610-0+920)**

no.	(y/m/d)	revision	chk'd
15	18-02-06	PROJECT RECORDS OFFSITE	KBH
14	17-10-17	PROJECT RECORDS OFFSITE	KBH
13	17-04-13	ISSUED FOR AI #5	AGC
12	17-03-07	REISSUED FOR CONSTRUCTION OFFSITE	KBH
11	16-12-01	REVISED PER CLIENT REQUEST AI(2)	KBH
10	16-11-09	REISSUED FOR CONSTRUCTION OFFSITE	KBH
9	16-10-26	IFC OFFSITE FINAL COMMENTS	KBH
8	16-10-21	VCH UPDATE	KBH

engineer of record	K.B.H.	scales	hor: 1:500	vert: 1:50
designed by	N.G.B.	file no.	16159	
drawn by	A.A.P.	drawing no.	W-OS-3	
date	2016-05-13			








**AS-CONSTRUCTED INFORMATION**

CREUS ENGINEERING LTD. CERTIFIES THAT THE WORKS & SERVICES SHOWN ON THESE DRAWINGS WERE CONSTRUCTED IN GENERAL CONFORMANCE WITH THE DRAWINGS & SPECIFICATIONS.

AS-CONSTRUCTED SURVEY INFORMATION SHOWN ON THESE DRAWINGS HAVE BEEN PROVIDED BY OTHERS. IT IS THE RESPONSIBILITY OF OTHERS USING THESE DRAWINGS TO CONFIRM THE LOCATION & ELEVATION OF THESE SERVICES.

SEE DRAWING KEY-1 FOR GENERAL NOTES  
 SEE DRAWING W-A-1 FOR WATERWORKS NOTES  
 SEE DRAWING S-A-1 FOR SANITARY NOTES

Civil Engineers & Project Managers  
 SUITE 200-901 16TH ST WEST, NORTH VANCOUVER BC, V7P1R2  
 PH: 604-987-0070 WEBSITE: www.creus.ca

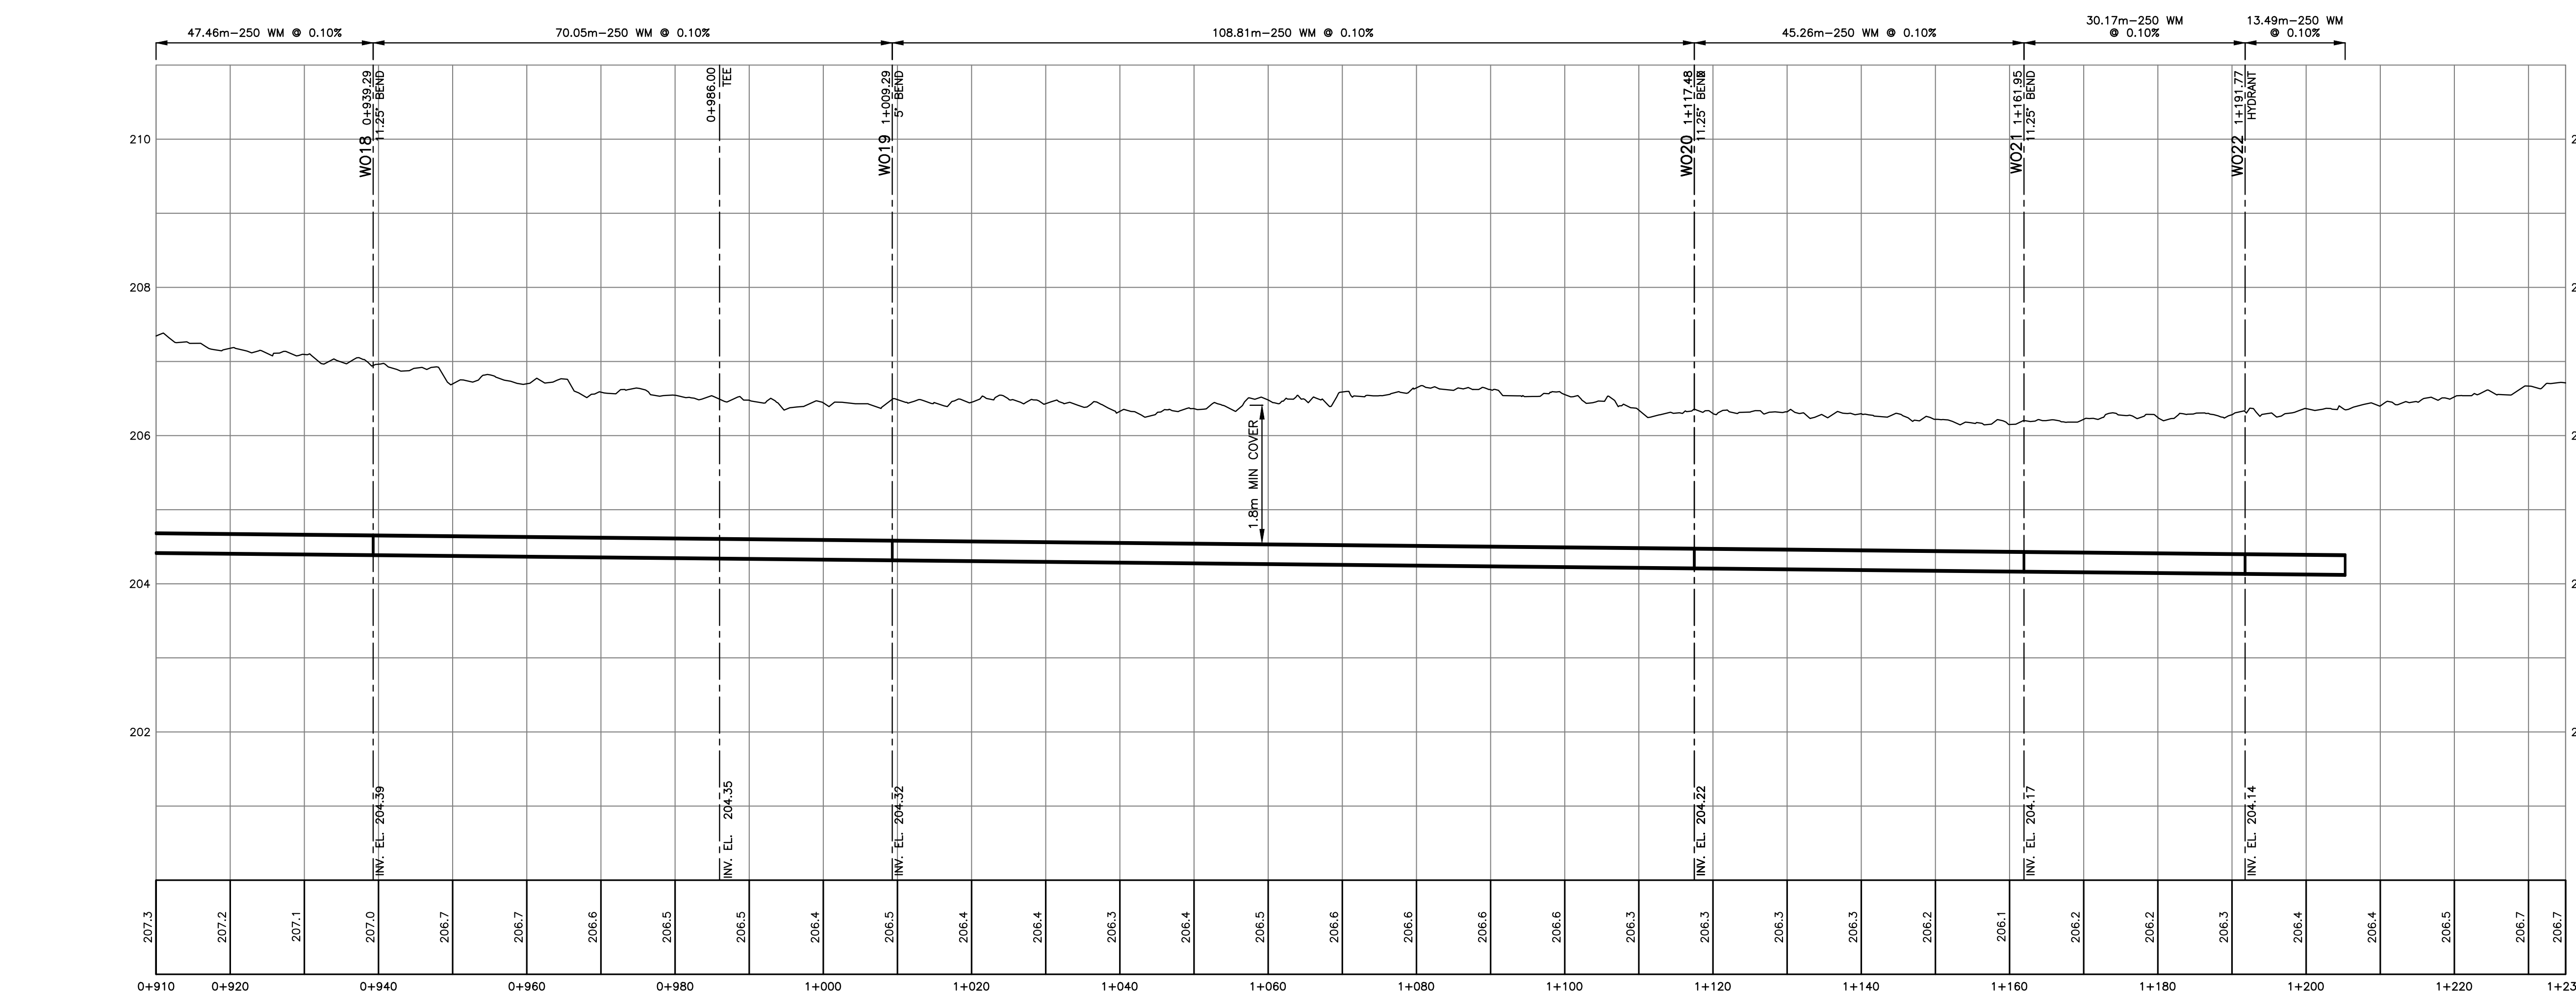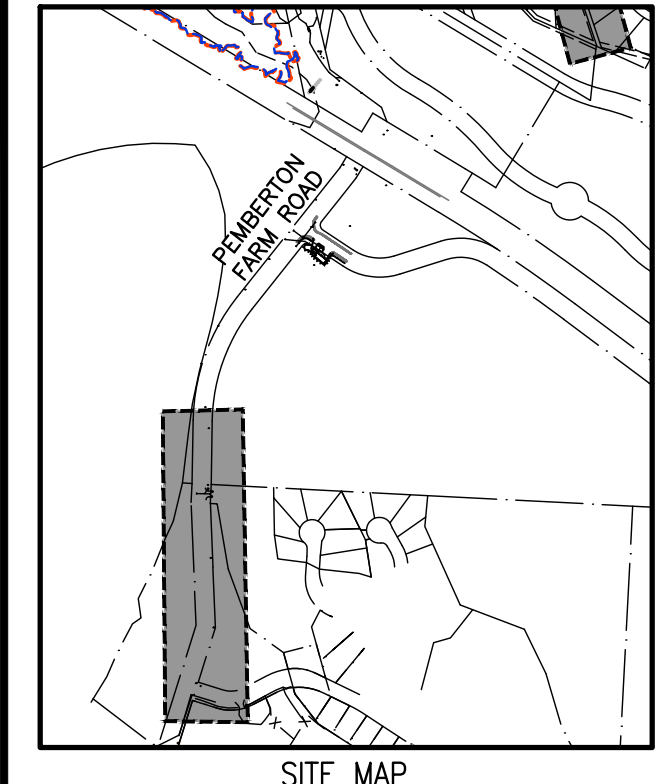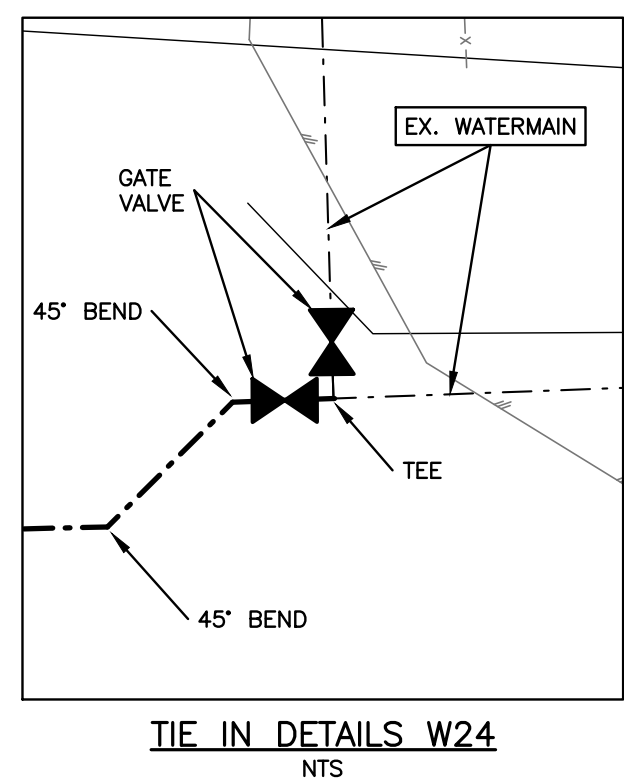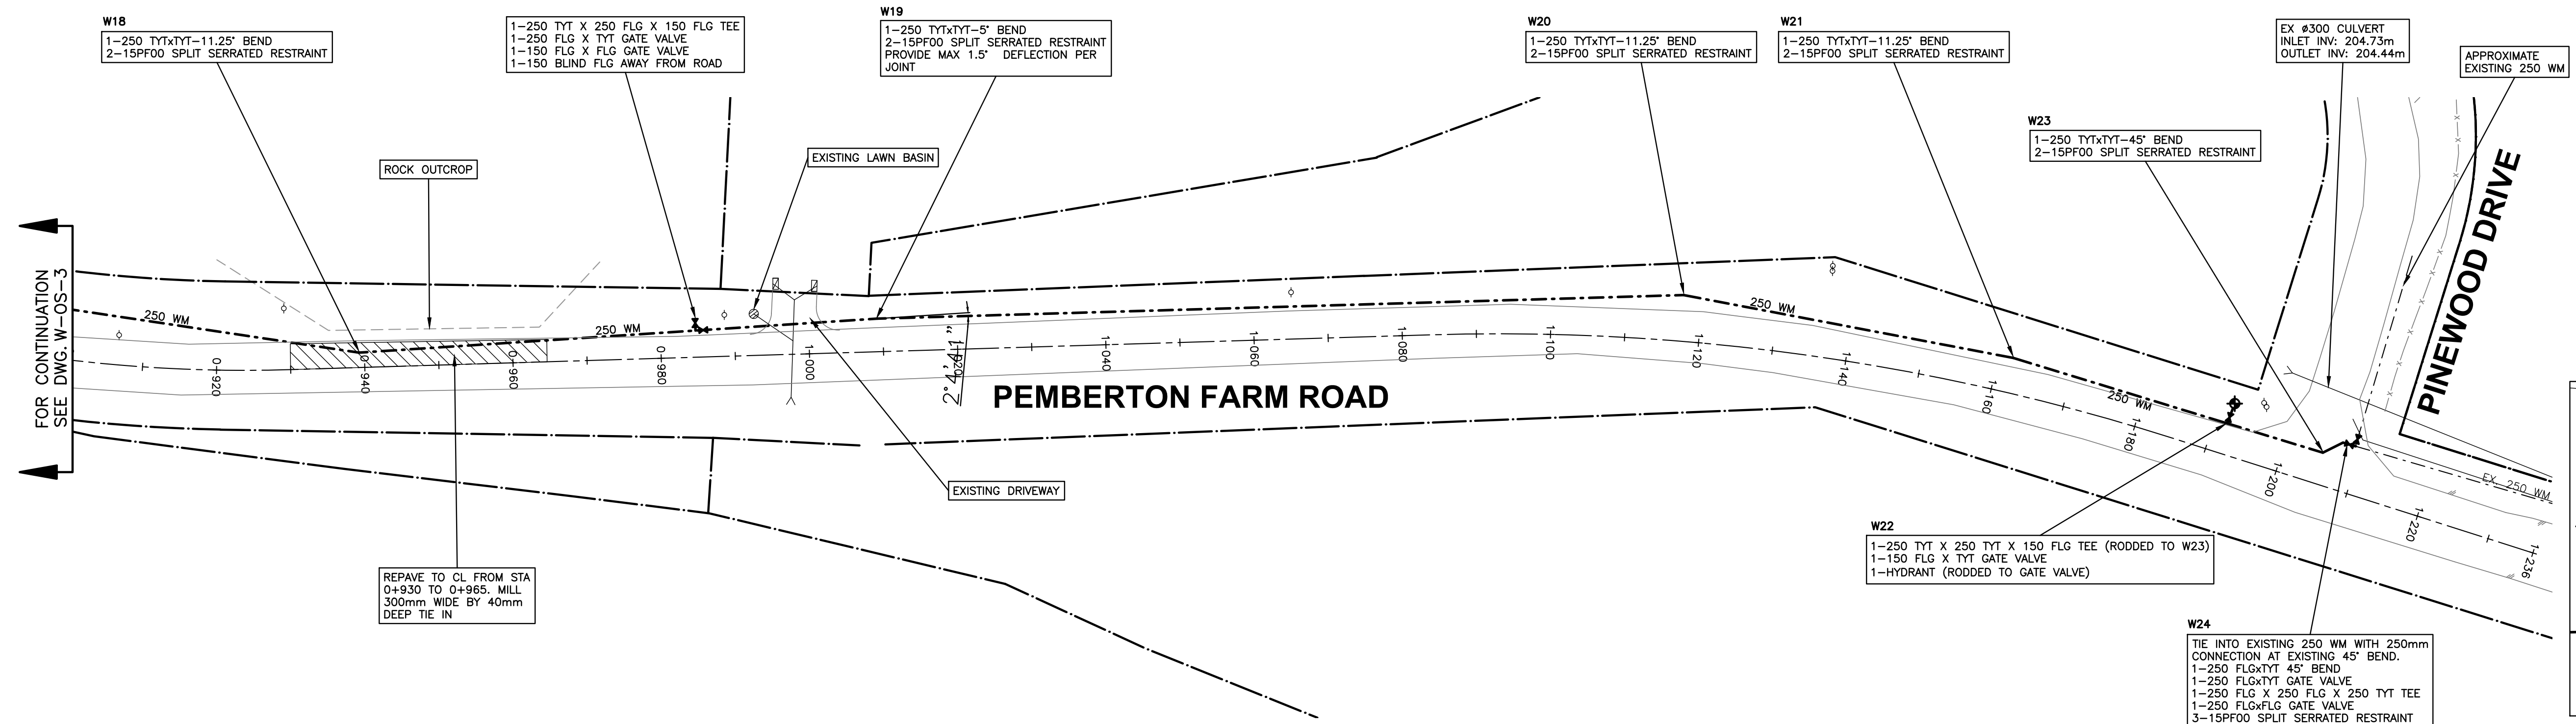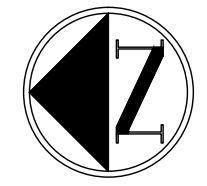

**DRAWING LEGEND**

	EXISTING	PROP.	TO BE REMOVED
LEGAL LINE EASMENT	---	---	---
WATERMAIN	---	---	---
SANITARY	---	---	---
STORM	---	---	---
HYDRO	---	---	---
TEL	---	---	---
STREETLIGHT	---	---	---
GAS	---	---	---
FIRE HYDRANT	⊗	⊗	⊗
GATE VALVE	⊗	⊗	⊗
AIR VALVE	⊗	⊗	⊗
REDUCER	⊗	⊗	⊗
INSPECTION CHAMBER	⊗	⊗	⊗
CATCHBASIN (STD/SI)	⊗	⊗	⊗
CAP	⊗	⊗	⊗
MANHOLE	⊗	⊗	⊗
POWER POLE	⊗	⊗	⊗
STREETLIGHT	⊗	⊗	⊗

approved

client

580049 BC LTD.

project

THE RIDGE AT PEMBERTON  
 PHASE 1  
 PEMBERTON, BC

title


WATERWORKS  
 OFFSITE ROAD (STA 0+910-1+220)

no.	(y/m/d)	revision	ch/d
16	18-02-06	PROJECT RECORDS OFFSITE	KBH
15	17-10-17	PROJECT RECORDS OFFSITE	KBH
14	17-04-13	ISSUED FOR AI #5	AGC
13	17-03-07	REISSUED FOR CONSTRUCTION OFFSITE	KBH
12	16-12-01	REVISED PER CLIENT REQUEST AI(2)	KBH
11	16-11-09	REISSUED FOR CONSTRUCTION OFFSITE	KBH
10	16-10-26	IFC OFFSITE FINAL COMMENTS	KBH
9	16-10-21	VCH UPDATE	KBH

engineer of record	K.B.H.	scales	hor: 1:500	vert: 1:50
designed by	N.G.B.	file no.	16159	
drawn by	A.A.P.	drawing no.	W-OS-4	
date	2016-05-13			

copyright reserved. THIS DRAWING AND DESIGN ARE, AND AT ALL TIMES REMAIN THE EXCLUSIVE PROPERTY OF CREUS ENGINEERING LTD. AND CANNOT BE USED, REPRODUCED OR DISTRIBUTED WITHOUT WRITTEN CONSENT.  
 ©2016 CREUS ENGINEERING LTD.



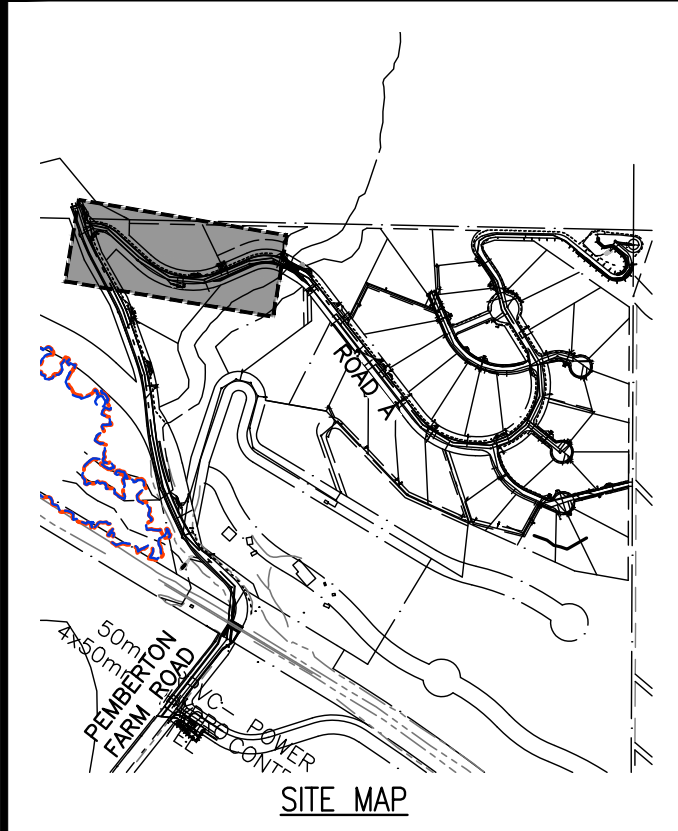



### DRAWING LEGEND

	EXISTING	PROP.	TO BE REMOVED
LEGAL LINE	---	---	---
EASMENT	---	---	---
WATERMAIN	---	---	---
SANITARY	---	---	---
STORM	---	---	---
HYDRO	---	---	---
TEL	---	---	---
STREETLIGHT	---	---	---
GAS	---	---	---
	EXISTING	PROP.	TO BE REMOVED
FIRE HYDRANT	⊗	⊗	⊗
GATE VALVE	⊗	⊗	⊗
AIR VALVE	⊗	⊗	⊗
REDUCER	⊗	⊗	⊗
INSPECTION CHAMBER	⊗	⊗	⊗
CATCHBASIN (STD/SI)	⊗	⊗	⊗
CAP	⊗	⊗	⊗
MANHOLE	⊗	⊗	⊗
POWER POLE	⊗	⊗	⊗
STREETLIGHT	⊗	⊗	⊗

### STORM AND SANITARY NOTES

- SANITARY GRAVITY SEWERS TO BE PVC SDR 28 FOR SERVICE CONNECTIONS AND SDR 35 FOR MAIN LINES WHEN TESTED IN ACCORDANCE WITH ASTM D3034 & CSA B182.1. PIPE STIFFNESS (f/y) SHALL BE 314 kPa AT 2.5% DEFLECTION WHEN TESTED IN ACCORDANCE WITH ASTM D2412 UNLESS NOTED OTHERWISE.
- STORM GRAVITY SEWERS TO BE EITHER PVC SDR 28 FOR SERVICE CONNECTIONS AND SDR 35 FOR MAIN LINES WHEN TESTED IN ACCORDANCE WITH ASTM D3034 & CSA B182.1 (PIPE STIFFNESS (f/y) SHALL BE 314 kPa AT 2.5% DEFLECTION WHEN TESTED IN ACCORDANCE WITH ASTM D2412 UNLESS NOTED OTHERWISE) OR CONCRETE AND SHALL MEET ASTM C14 CLASS 3 OR IF INDICATED ON DRAWINGS SDR 35 FOR MAIN LINES WHEN TESTED IN ACCORDANCE WITH ASTM D3034 & CSA B182.1 (PIPE STIFFNESS (f/y) SHALL BE 314 kPa AT 2.5% DEFLECTION WHEN TESTED IN ACCORDANCE WITH ASTM D2412 UNLESS NOTED OTHERWISE).
- CULVERTS TO BE CORRUGATED STEEL PIPE IN ACCORDANCE WITH CAN 3-G-401. MIN COVER 450mm.
- SANITARY FORCE MAINS ARE TO BE PVC TO AWWA C900 CLASS 150 OR HIGH DENSITY POLYETHYLENE SERIES 100 (DR17) OR BETTER, TO ASTM F714-85 & ASTM D-1248-84.
- STORM SERVICES TO BE MINIMUM SDR28 P.V.C. 150mm MIN C/W INSPECTION CHAMBER PER MMCD STD. DWG. S8 AND HAVE A MINIMUM OF 1.8m COVER.
- SANITARY SERVICES TO BE MINIMUM SDR28 P.V.C. 100mm MIN C/W INSPECTION CHAMBER PER MMCD STD. DWG S7 AND HAVE A MINIMUM OF 1.8m COVER.
- CONTRACTOR TO INSURE TESTING OF SEWER MAINS AND LATERALS TO BE PERFORMED IN THE PRESENCE OF THE ENGINEER OF RECORD AND VILLAGE OF PEMBERTON INSPECTORS. CONTRACTORS TO PROVIDE MINIMUM OF 48 HOURS NOTICE. ALL MAINS AND SERVICES ARE TO BE TESTED AS PER MMCD SPECIFICATIONS WITH THE RESULTS FORWARDED TO THE VILLAGE OF PEMBERTON.
- CONTRACTOR TO PROVIDED TEMPORARY BYPASS AND RECONNECTION OF ANY SERVICES INTERRUPTED BY CONSTRUCTION ACTIVITIES.
- ALL SEWER MAINS AND LATERALS TO BE CCTV INSPECTED. CCTV INSPECTIONS TO BE ARRANGED BY CONTRACTOR AT CONTRACTOR'S EXPENSE. CONTRACTOR TO FORWARD VIDEO FILES TO ENGINEER WITHIN TWO WEEKS OF INSPECTION.
- CROWN OF ALL SEWER SERVICE CONNECTIONS ENTERING MANHOLES TO MATCH CROWN ELEVATION OF DOWNSTREAM SEWER OUTLET EXCEPT WHERE NOTED OTHERWISE. INVERT OF SERVICE CONNECTIONS TO MAIN TO MATCH CROWN OF MAIN AS PER VOP STANDARD SERVICE CONNECTION DETAIL.
- WHERE SANITARY PIPE GRADE EXCEEDS 15%, PIPE TO BE ANCHORED AS PER MMCD STD. DWG G8.
- MINIMUM GRADE ON SERVICE CONNECTIONS TO BE 2%, UNLESS NOTED OTHERWISE.
- PIPE BEDDING TO CONFORM WITH MMCD STANDARDS AND BE COMPACTED TO 95% MODIFIED PROCTOR PRIOR TO BACKFILLING TRENCH. SEE MMCD STD. DWG G4. TEST RESULTS ARE TO BE FORWARDED TO VILLAGE OF PEMBERTON.
- TIE-INS TO EXISTING MAINS 200mm OR LARGER TO USE QWIKSEAL INSERT CONNECTIONS.
- TIE-INS TO EXISTING 150mm MAINS TO USE ROBAR 3406/3506 SEWER SADDLE OR ROMAC STYLE "CB" SEWER SADDLE.
- CUT IN WYES COMPLETE WITH FLEX SEAL ADJUSTABLE SHIELDED COUPLINGS MAY ONLY BE USED AT THE DISCRETION OF THE VILLAGE OF PEMBERTON. APPROVAL MUST BE OBTAINED PRIOR TO INSTALLATION.
- REINSTATED EXISTING OR NEW SERVICE CONNECTIONS TO HAVE MANUFACTURED WYE CONNECTION AT MAIN.
- ALL CONNECTIONS TO EXISTING PIPES OR TO PIPES OF DIFFERING MATERIAL TO USE FLEX SEAL ADJUSTABLE SHIELDED COUPLINGS.
- ALL MANHOLES TO BE TO MMCD STD DWG S1, MINIMUM 1050 UNLESS OTHERWISE NOTED.
- EXCAVATION AND PAVEMENT RESTORATION TO BE COMPLETED BY CONTRACTOR PER REGULATORY AUTHORITY REQUIREMENTS, MMCD STANDARDS AND CONTRACT DOCUMENTS. CONTRACTOR TO GIVE NOTICE PRIOR TO COMPLETING WORKS.
- NEW AND/OR REINSTATED SERVICES TO BE FREE OF BENDS UNLESS OTHERWISE APPROVED.
- SERVICE CONNECTIONS TO BE MARKED WITH A 40mm x 90mm POST PAINTED RED FOR SANITARY AND GREEN FOR STORM AT TERMINATION. SERVICES TO BE TERMINATED 1m BEYOND THE PROPERTY LINE, UNLESS OTHERWISE NOTED.
- MIN. COVER FOR SANITARY & STORM SEWERS = 1.2m UNDER TRAVELED AREAS AND 1.0m UNDER NON-TRAVELED AREAS.
- LOCATION/INVERTS OF SERVICE CONNECTIONS TO BE CONFIRMED BY ENGINEER ONCE ROUGH GRADING IS COMPLETE.
- WHEN INSTALLING PIPE DO NOT EXCEED HALF THE MANUFACTURERS PERMISSIBLE JOINT DEFLECTION. BENDING OF PVC PIPE IS NOT PERMITTED.
- TIE IN TO EXISTING SYSTEM TO BE COMPLETED BY THE VILLAGE OF PEMBERTON UNLESS OTHERWISE NOTED. WHEN IT IS NOTED THAT THE CONTRACTOR IS TO COMPLETE THE TIE-IN THE CONTRACTOR IS TO GIVE THE ENGINEER AND THE VILLAGE INSPECTOR 48 HOURS NOTICE PRIOR TO THE TIE-IN AND ONLY COMPLETE THE TIE-IN UNDER THE SUPERVISION OF THE ENGINEER.
- SITE SERVING WORKS TO COMMENCE ONLY AFTER OFFSITE SERVICE CONNECTION HAS BEEN INSTALLED & VERIFIED.
- ALL MANHOLES OUTSIDE PAVED AREAS TO INCLUDE MINIMUM 1.0m ASPHALT OR CONCRETE APRON.

**AS-CONSTRUCTED INFORMATION**  
 CREUS ENGINEERING LTD. CERTIFIES THAT THE WORKS & SERVICES SHOWN ON THESE DRAWINGS WERE CONSTRUCTED IN GENERAL CONFORMANCE WITH THE DRAWINGS & SPECIFICATIONS.  
 AS-CONSTRUCTED SURVEY INFORMATION SHOWN ON THESE DRAWINGS HAVE BEEN PROVIDED BY OTHERS. IT IS THE RESPONSIBILITY OF OTHERS USING THESE DRAWINGS TO CONFIRM THE LOCATION & ELEVATION OF THESE SERVICES.

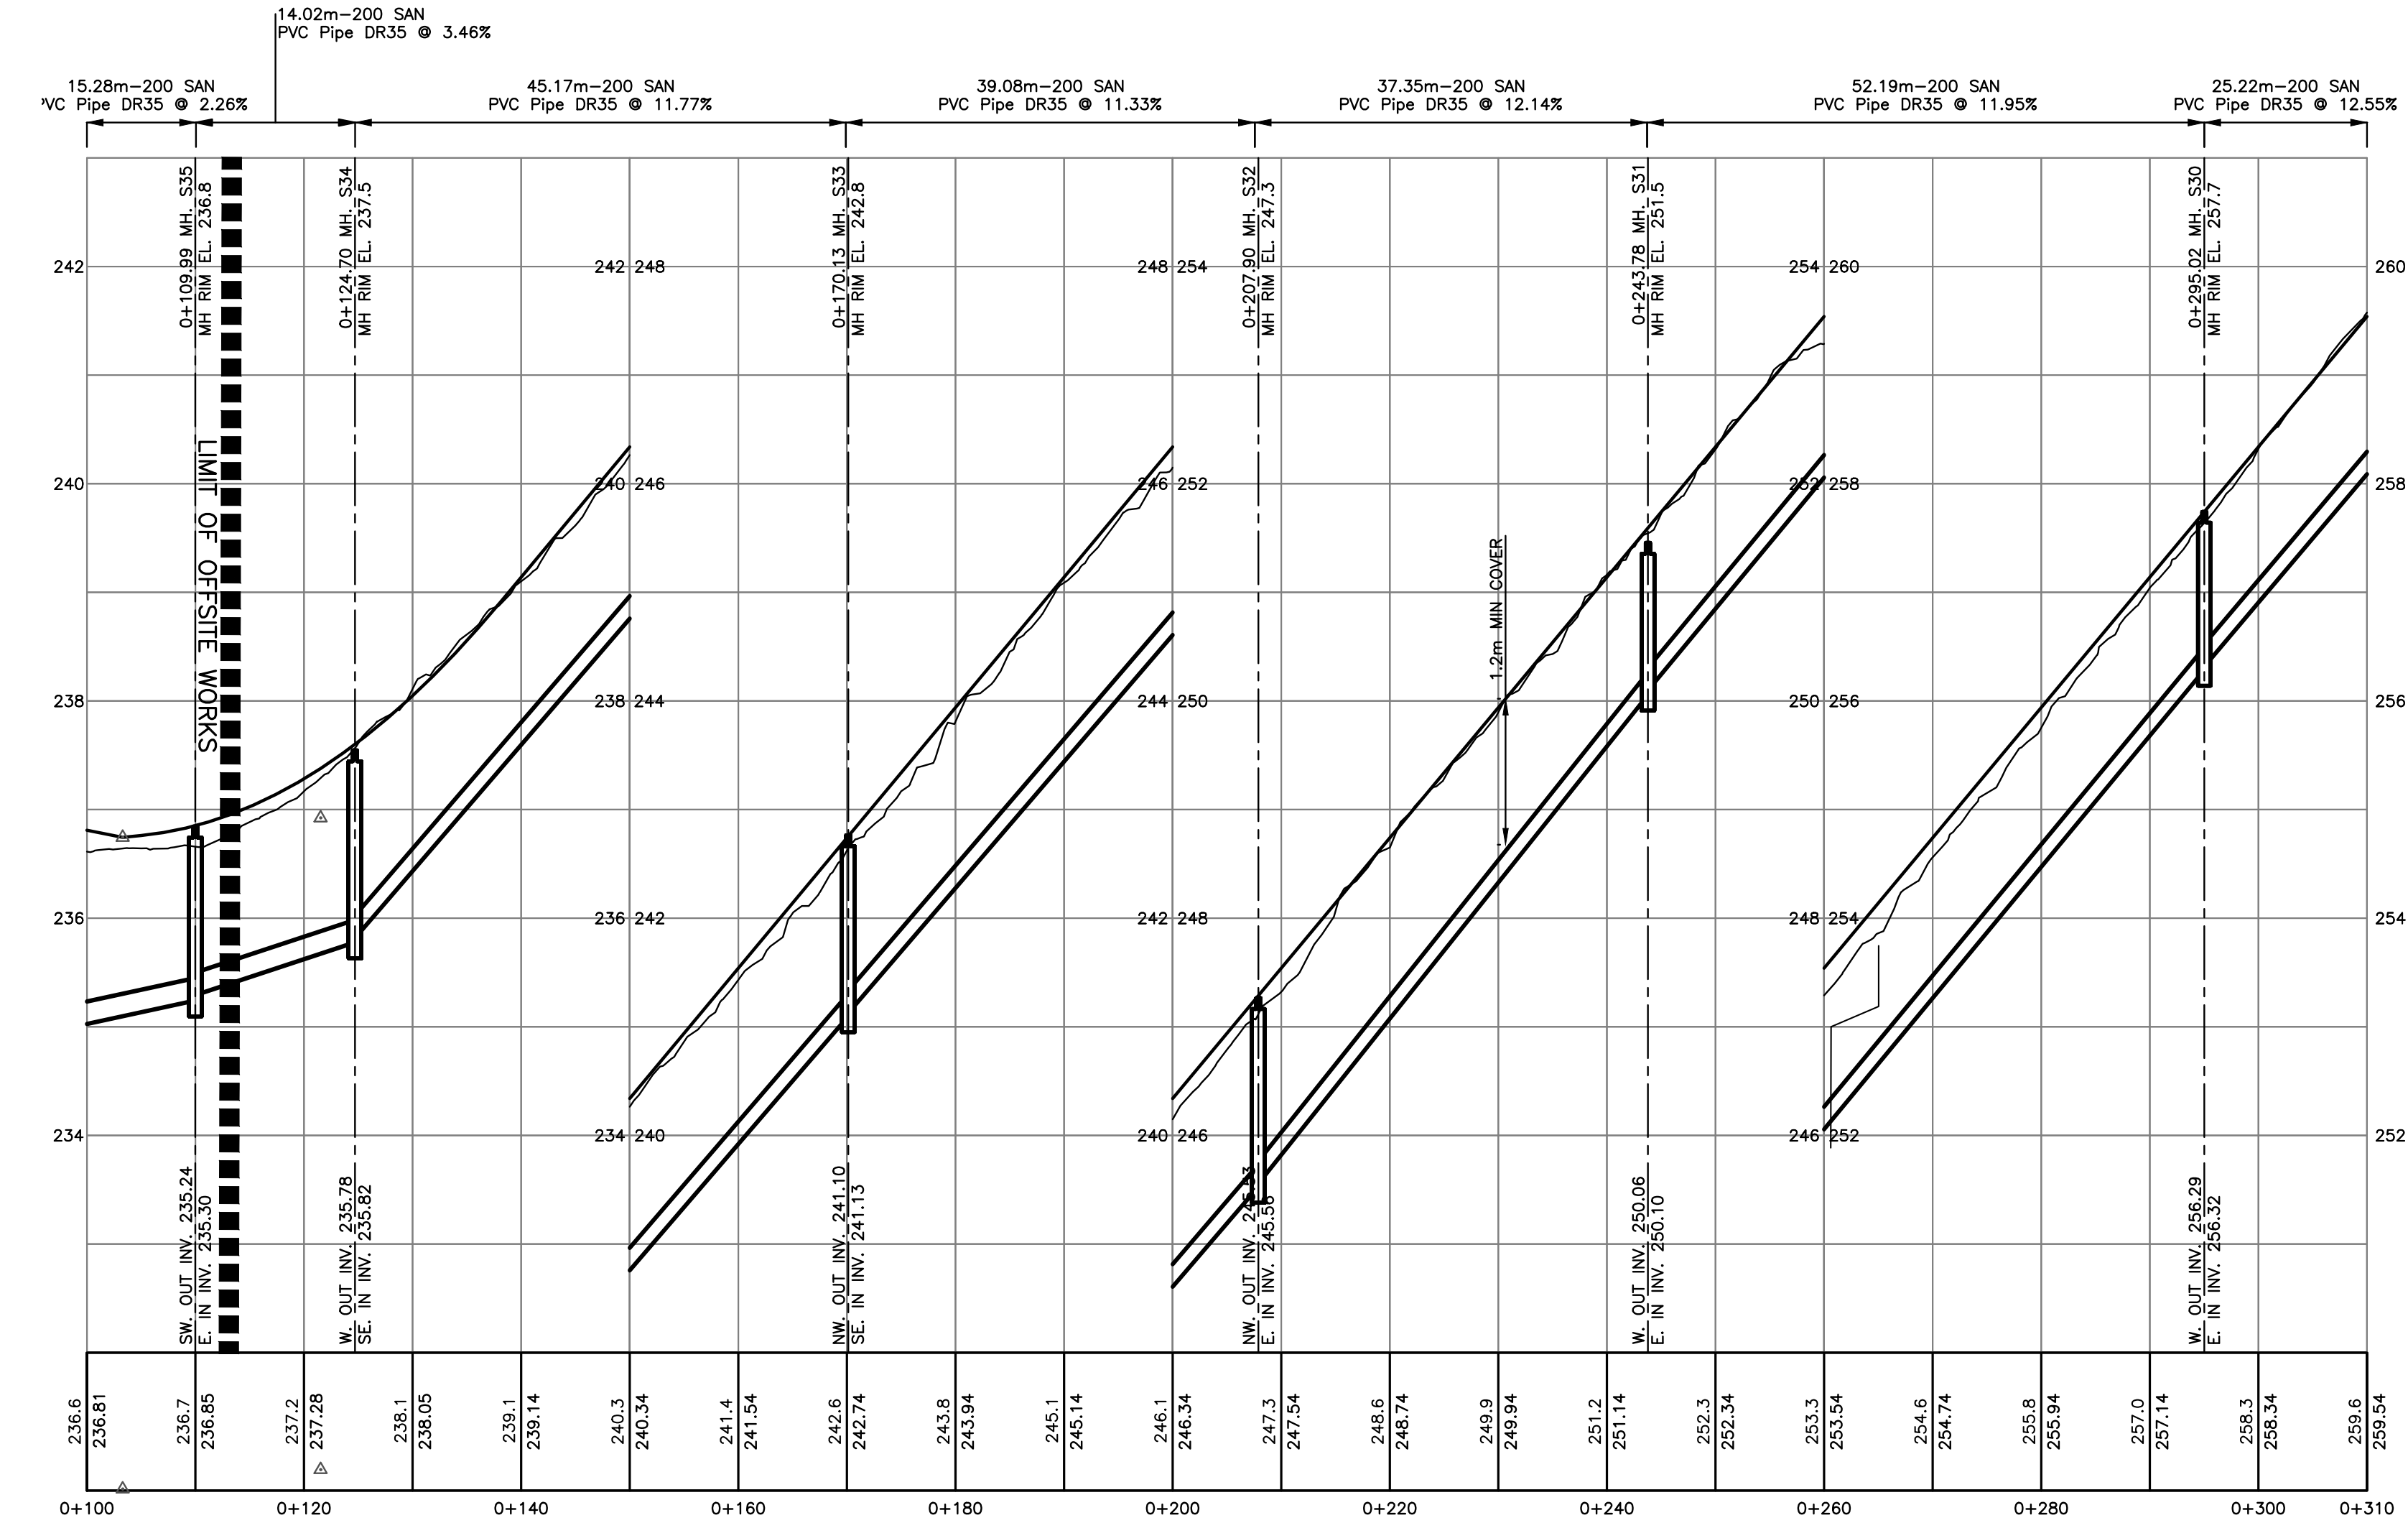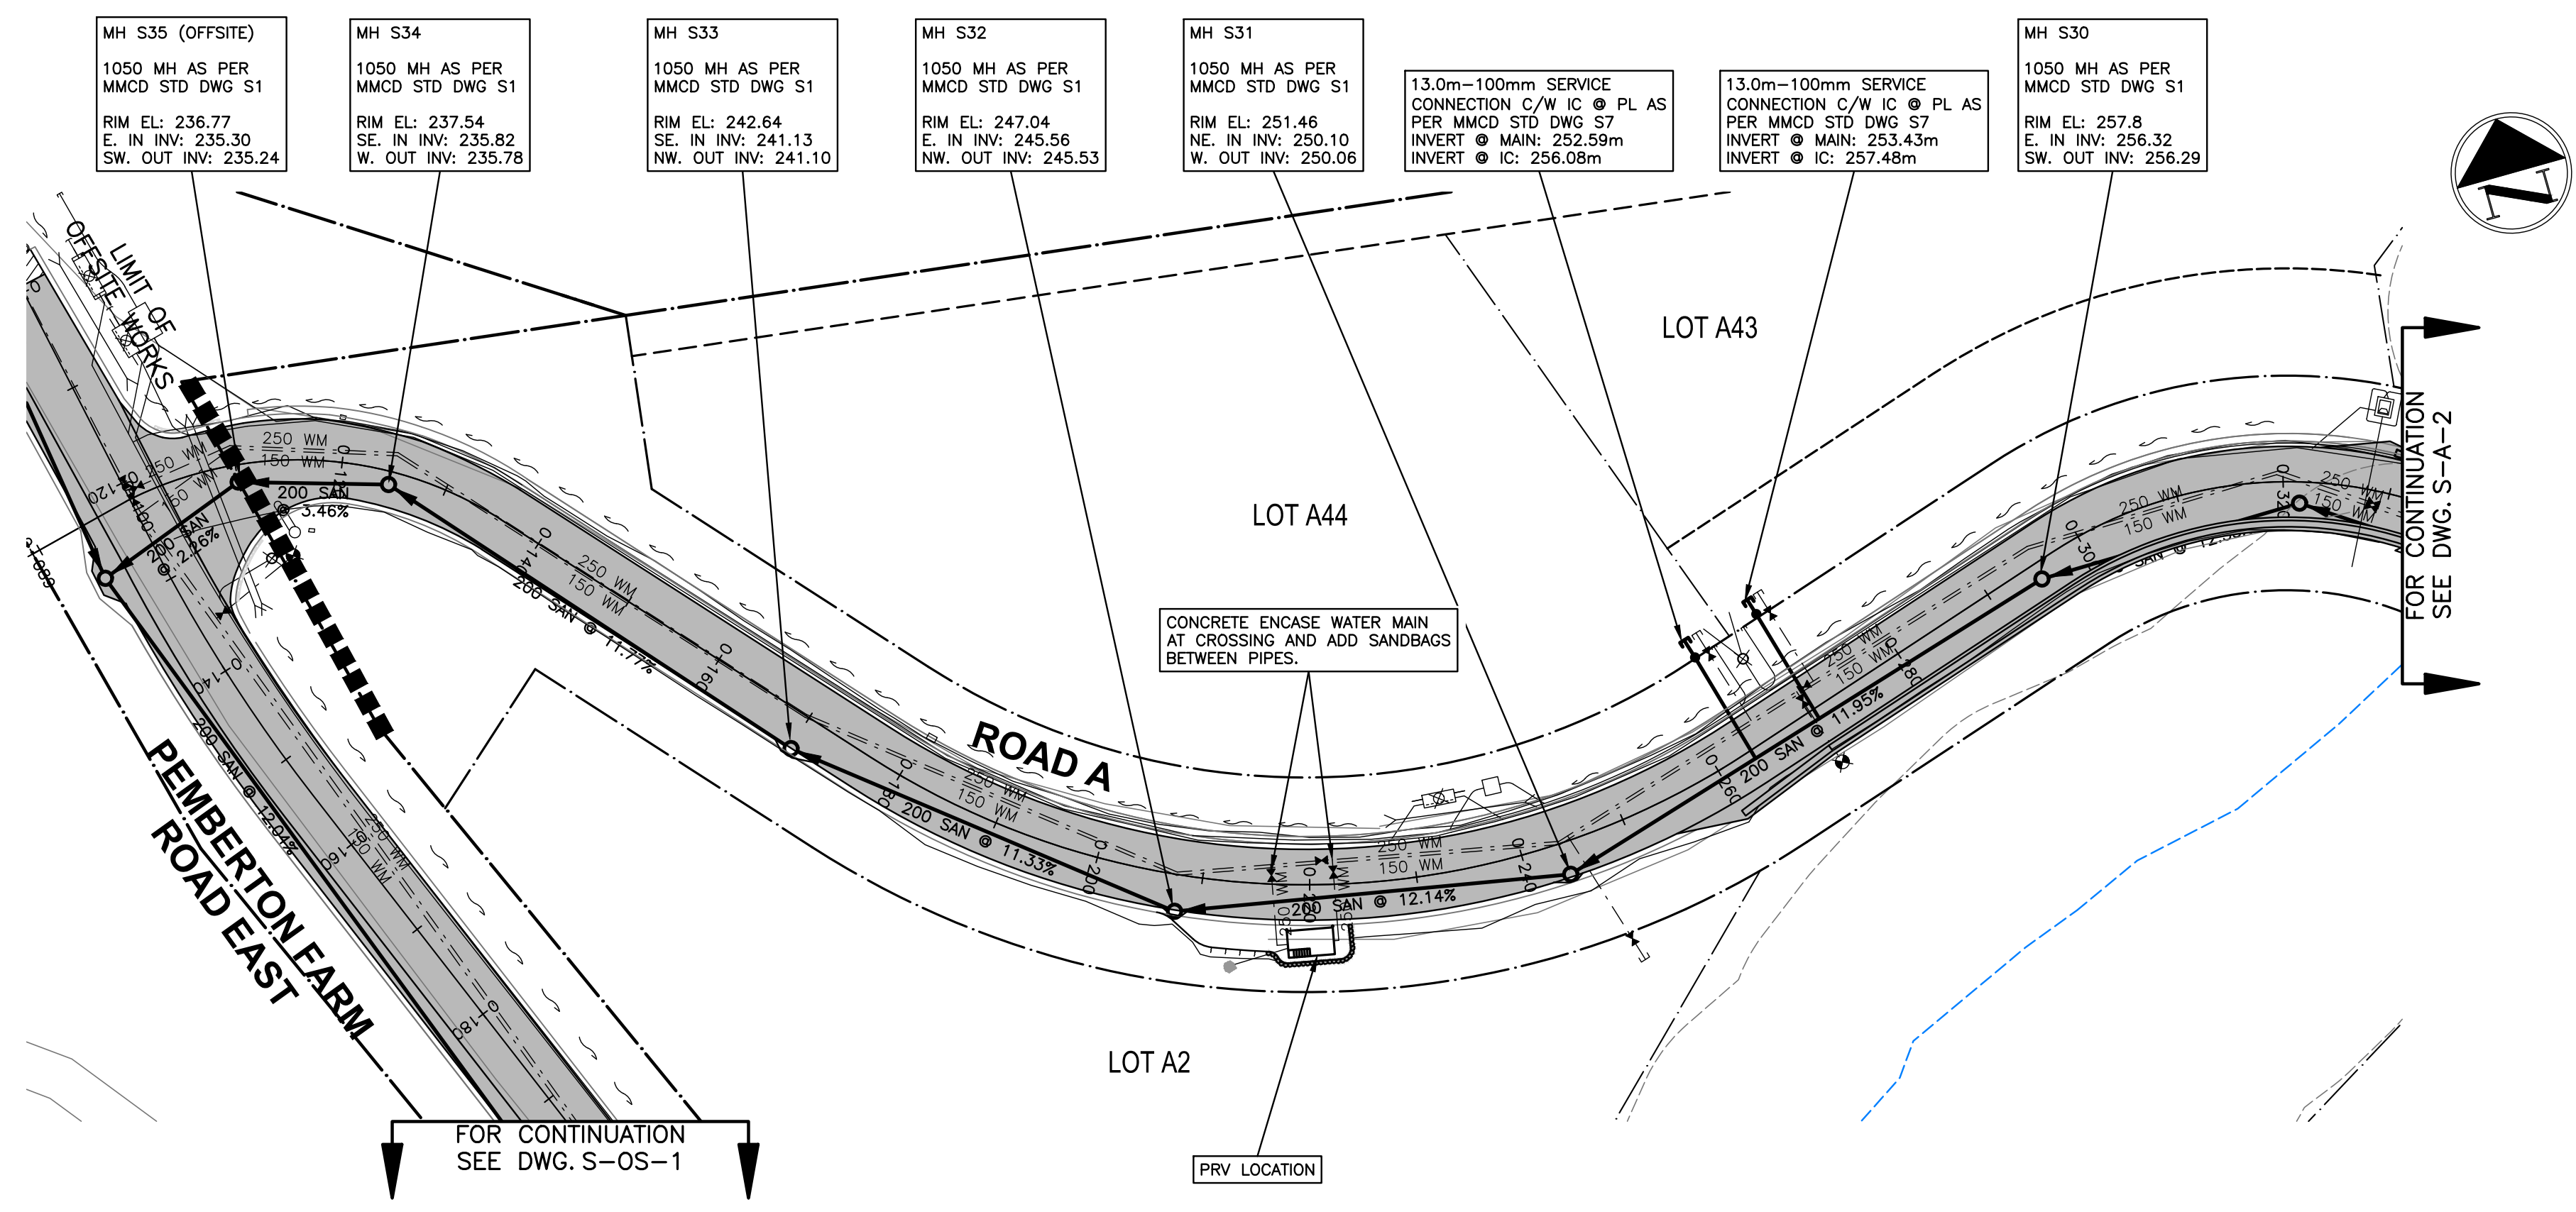


approved		
client		
580049 BC LTD.		
project		
THE RIDGE AT PEMBERTON PHASE 1 PEMBERTON, BC		
title		
SANITARY ROAD A (STA 0+100-0+310)		
no.	(y/m/d)	revision
16	18-02-06	PROJECT RECORDS OFFSITE
15	18-02-06	PROJECT RECORDS ONSITE
14	17-10-17	PROJECT RECORDS OFFSITE
13	17-05-01	ISSUED FOR AI #9
12	17-04-13	ISSUED FOR OFFSITE AI #5
11	17-03-07	REISSUED FOR CONSTRUCTION OFFSITE
10	17-02-27	ISSUED FOR CONSTRUCTION ONSITE
9	16-11-09	REISSUED FOR CONSTRUCTION ONSITE
no.	(y/m/d)	revision
current rev. #		16
engineer of record	K.B.H.	scale
designed by	N.G.B.	hor. 1:500
drawn by	R.J.L.	vert. 1:50
date	2016-05-13	file no.
		16159
		drawing no.
		S-A-1




AS-CONSTRUCTED INFORMATION  
 CREUS ENGINEERING LTD. CERTIFIES THAT THE WORKS & SERVICES SHOWN ON THESE DRAWINGS WERE CONSTRUCTED IN GENERAL CONFORMANCE WITH THE DRAWINGS & SPECIFICATIONS.  
 AS-CONSTRUCTED SURVEY INFORMATION SHOWN ON THESE DRAWINGS HAVE BEEN PROVIDED BY OTHERS. IT IS THE RESPONSIBILITY OF OTHERS USING THESE DRAWINGS TO CONFIRM THE LOCATION & ELEVATION OF THESE SERVICES.

ONSITE EASEMENT CONTRACTOR  
 MH B25  
 1050 MH AS PER MMCD STD DWG S1. OUTSIDE DROP AS PER MMCD STD DWG S3  
 RIM EL: 210.9  
 N. IN INV: 208.49  
 N. OVERFL. INV: 209.18  
 S. OUT INV: 208.44

MH B24  
 1050 MH AS PER MMCD STD DWG S1  
 RIM EL: 224.5  
 NE. IN INV: 222.82  
 S. OUT INV: 222.76

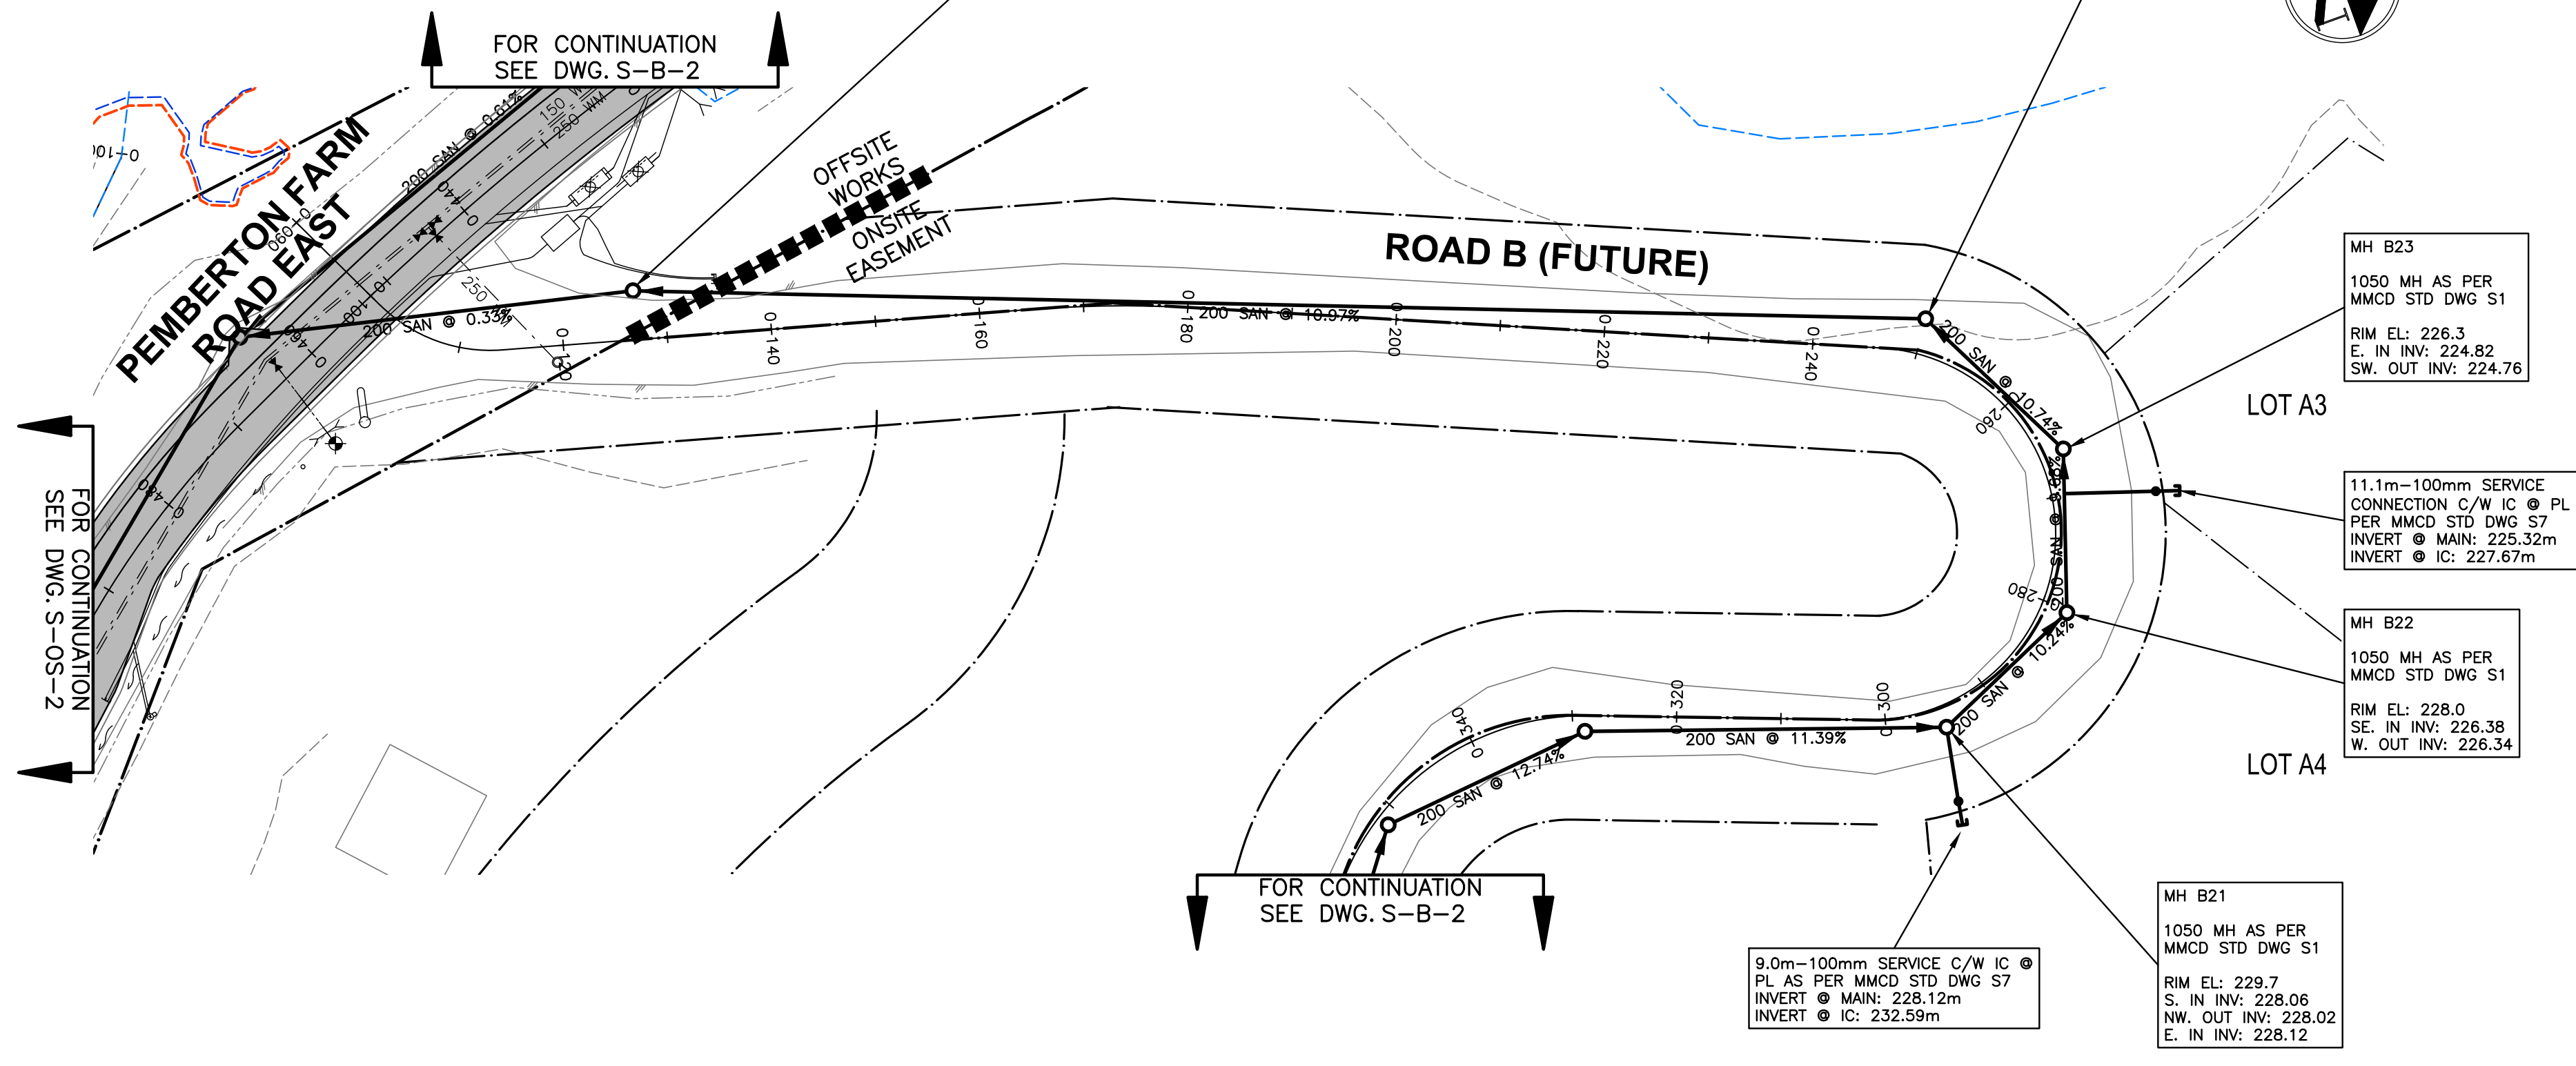

Civil Engineers & Project Managers  
 SUITE 200-901 16TH ST WEST, NORTH VANCOUVER BC, V7P1R2  
 PH: 604-987-0070 WEBSITE: www.creus.ca

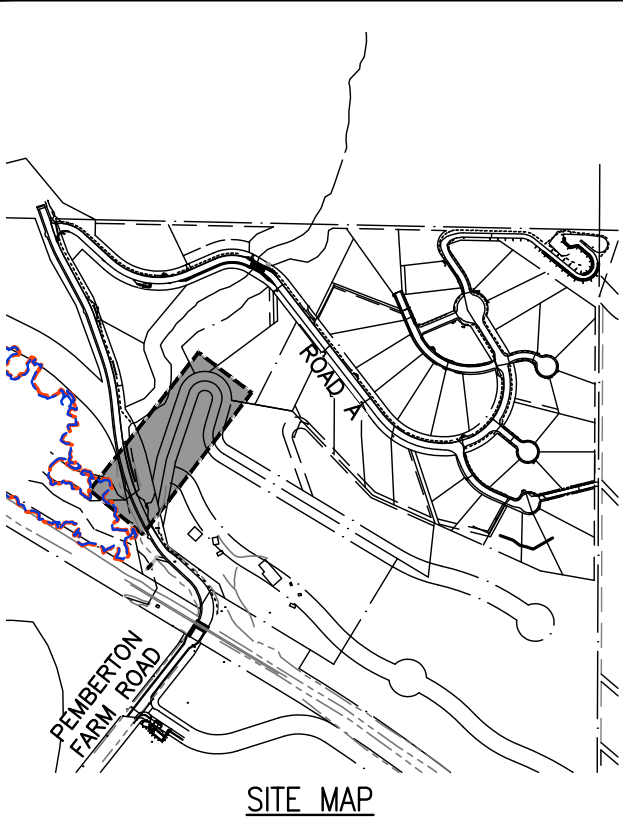

DRAWING LEGEND

	EXISTING	PROP.	TO BE REMOVED
LEGAL LINE EASEMENT	---	---	---
WATERMAIN	---	---	---
SANITARY	---	---	---
STORM	---	---	---
HYDRO	---	---	---
TEL	---	---	---
STREETLIGHT	---	---	---
GAS	---	---	---
FIRE HYDRANT	⊗	⊗	⊗
GATE VALVE	⊗	⊗	⊗
AIR VALVE	⊗	⊗	⊗
REDUCER	⊗	⊗	⊗
INSPECTION CHAMBER	⊗	⊗	⊗
CATCHBASIN (STD/SI)	⊗	⊗	⊗
CAP	⊗	⊗	⊗
MANHOLE	⊗	⊗	⊗
POWER POLE	⊗	⊗	⊗
STREETLIGHT	⊗	⊗	⊗

approved


client  
 580049 BC LTD.

project  
 THE RIDGE AT PEMBERTON  
 PHASE 1  
 PEMBERTON, BC

title  
 SANITARY  
 ROAD B (STA 0+090-0+300)

no.	(y/m/d)	revision	chk'd
18	18-02-06	PROJECT RECORDS OFFSITE	KBH
17	18-02-06	PROJECT RECORDS ONSITE	KBH
16	17-10-17	PROJECT RECORDS OFFSITE	KBH
15	17-04-13	ISSUED FOR OFFSITE AI #5	AGC
14	17-03-07	REISSUED FOR CONSTRUCTION OFFSITE	KBH
13	17-02-27	ISSUED FOR CONSTRUCTION ONSITE	KBH
12	16-11-09	REISSUED FOR CONSTRUCTION ONSITE	KBH
11	16-11-09	REISSUED FOR CONSTRUCTION OFFSITE	KBH





engineer of record	K.B.H.	scales	hor: 1:500	vert: 1:50
designed by	N.G.B.	file no.	16159	
drawn by	R.J.L.	drawing no.	S-B-1	
date	2016-05-13			

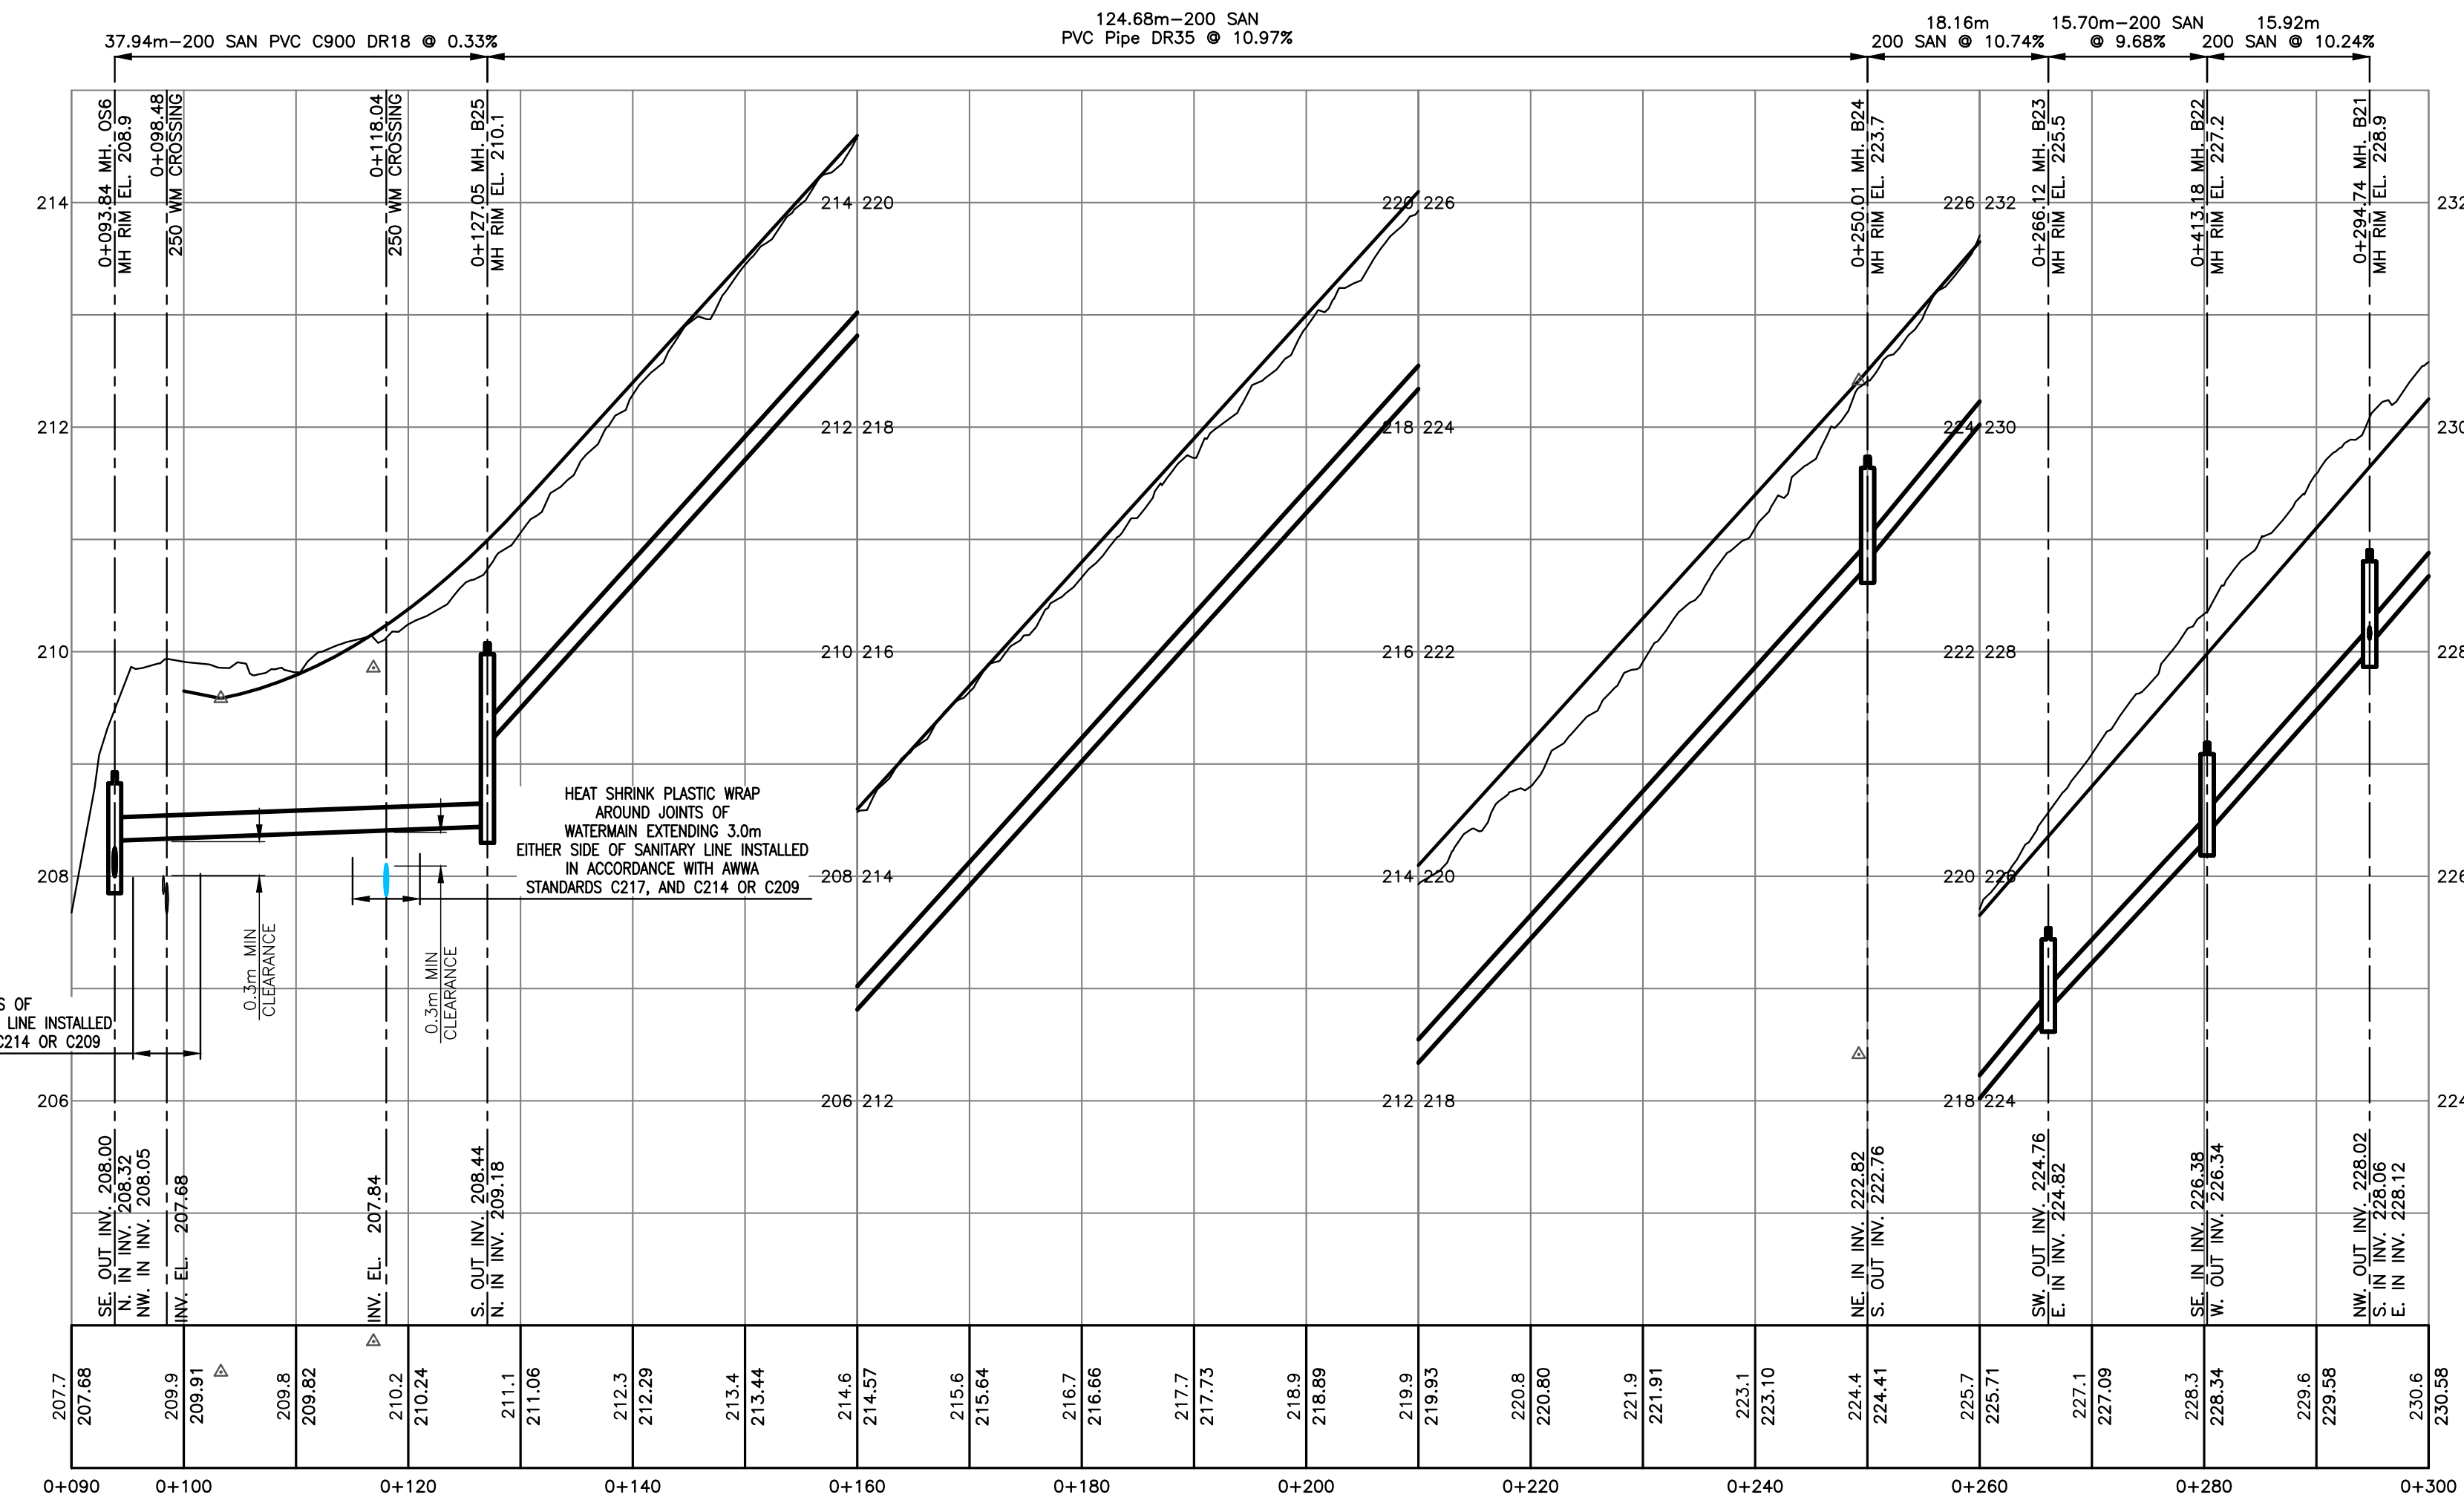


HEAT SHRINK PLASTIC WRAP AROUND JOINTS OF WATERMAIN EXTENDING 3.0m EITHER SIDE OF SANITARY LINE INSTALLED IN ACCORDANCE WITH ANWA STANDARDS C217, AND C214 OR C209



AS-CONSTRUCTED INFORMATION  
 CREUS ENGINEERING LTD. CERTIFIES THAT THE WORKS & SERVICES SHOWN ON THESE DRAWINGS WERE CONSTRUCTED IN GENERAL CONFORMANCE WITH THE DRAWINGS & SPECIFICATIONS.  
 AS-CONSTRUCTED SURVEY INFORMATION SHOWN ON THESE DRAWINGS HAVE BEEN PROVIDED BY OTHERS. IT IS THE RESPONSIBILITY OF OTHERS USING THESE DRAWINGS TO CONFIRM THE LOCATION & ELEVATION OF THESE SERVICES.

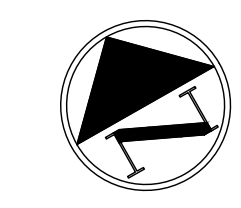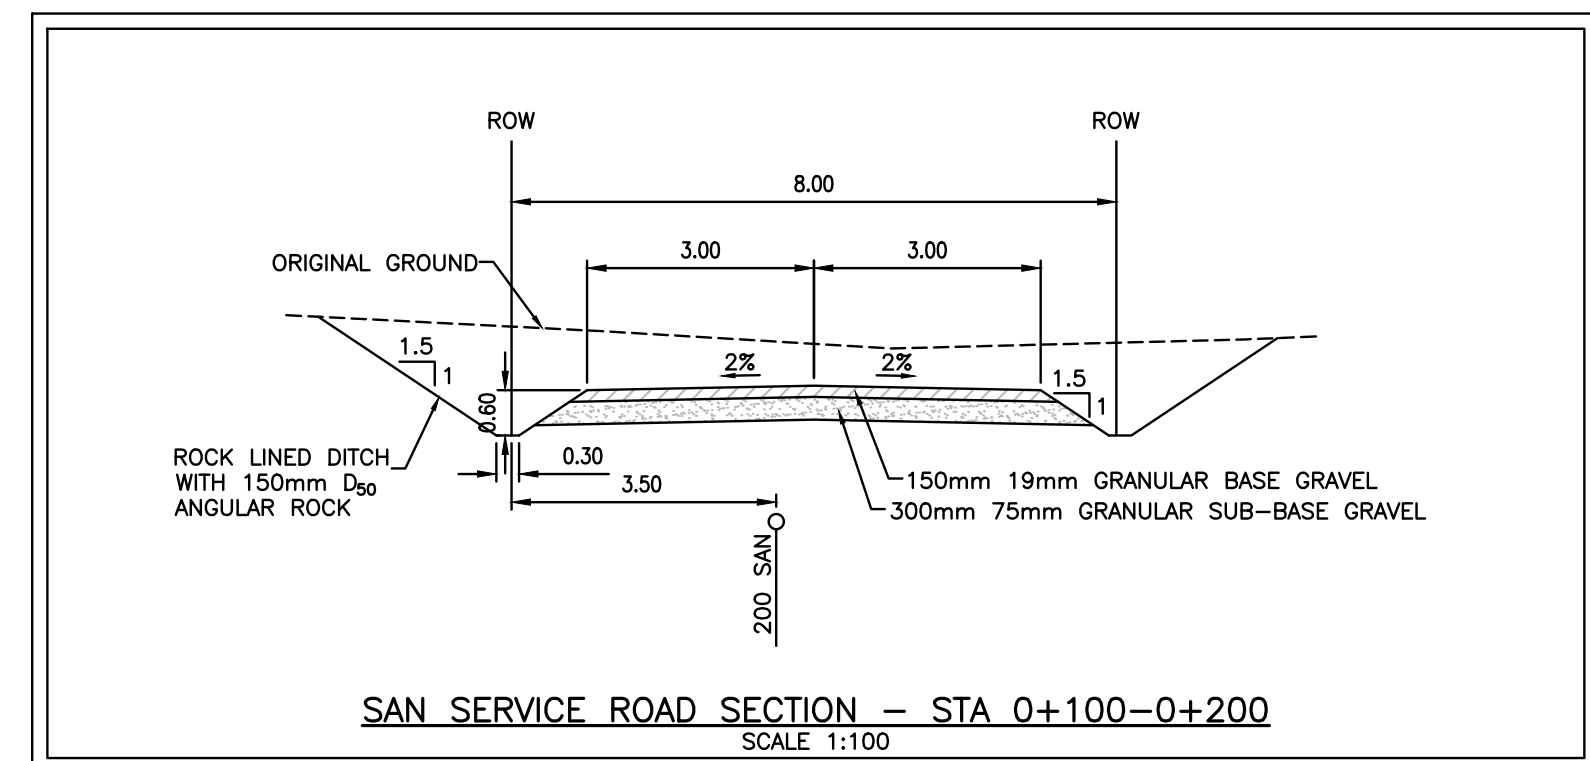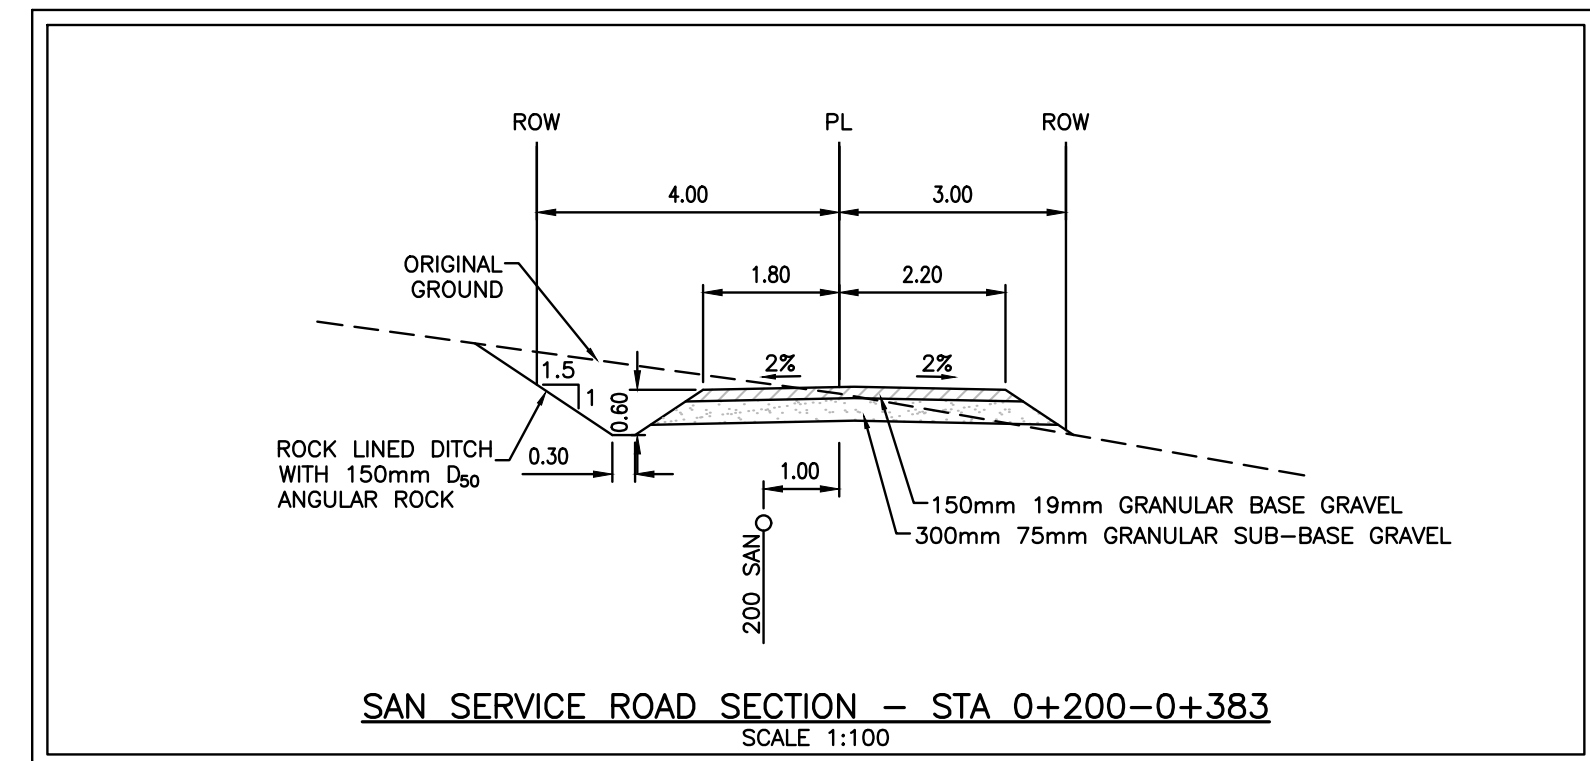
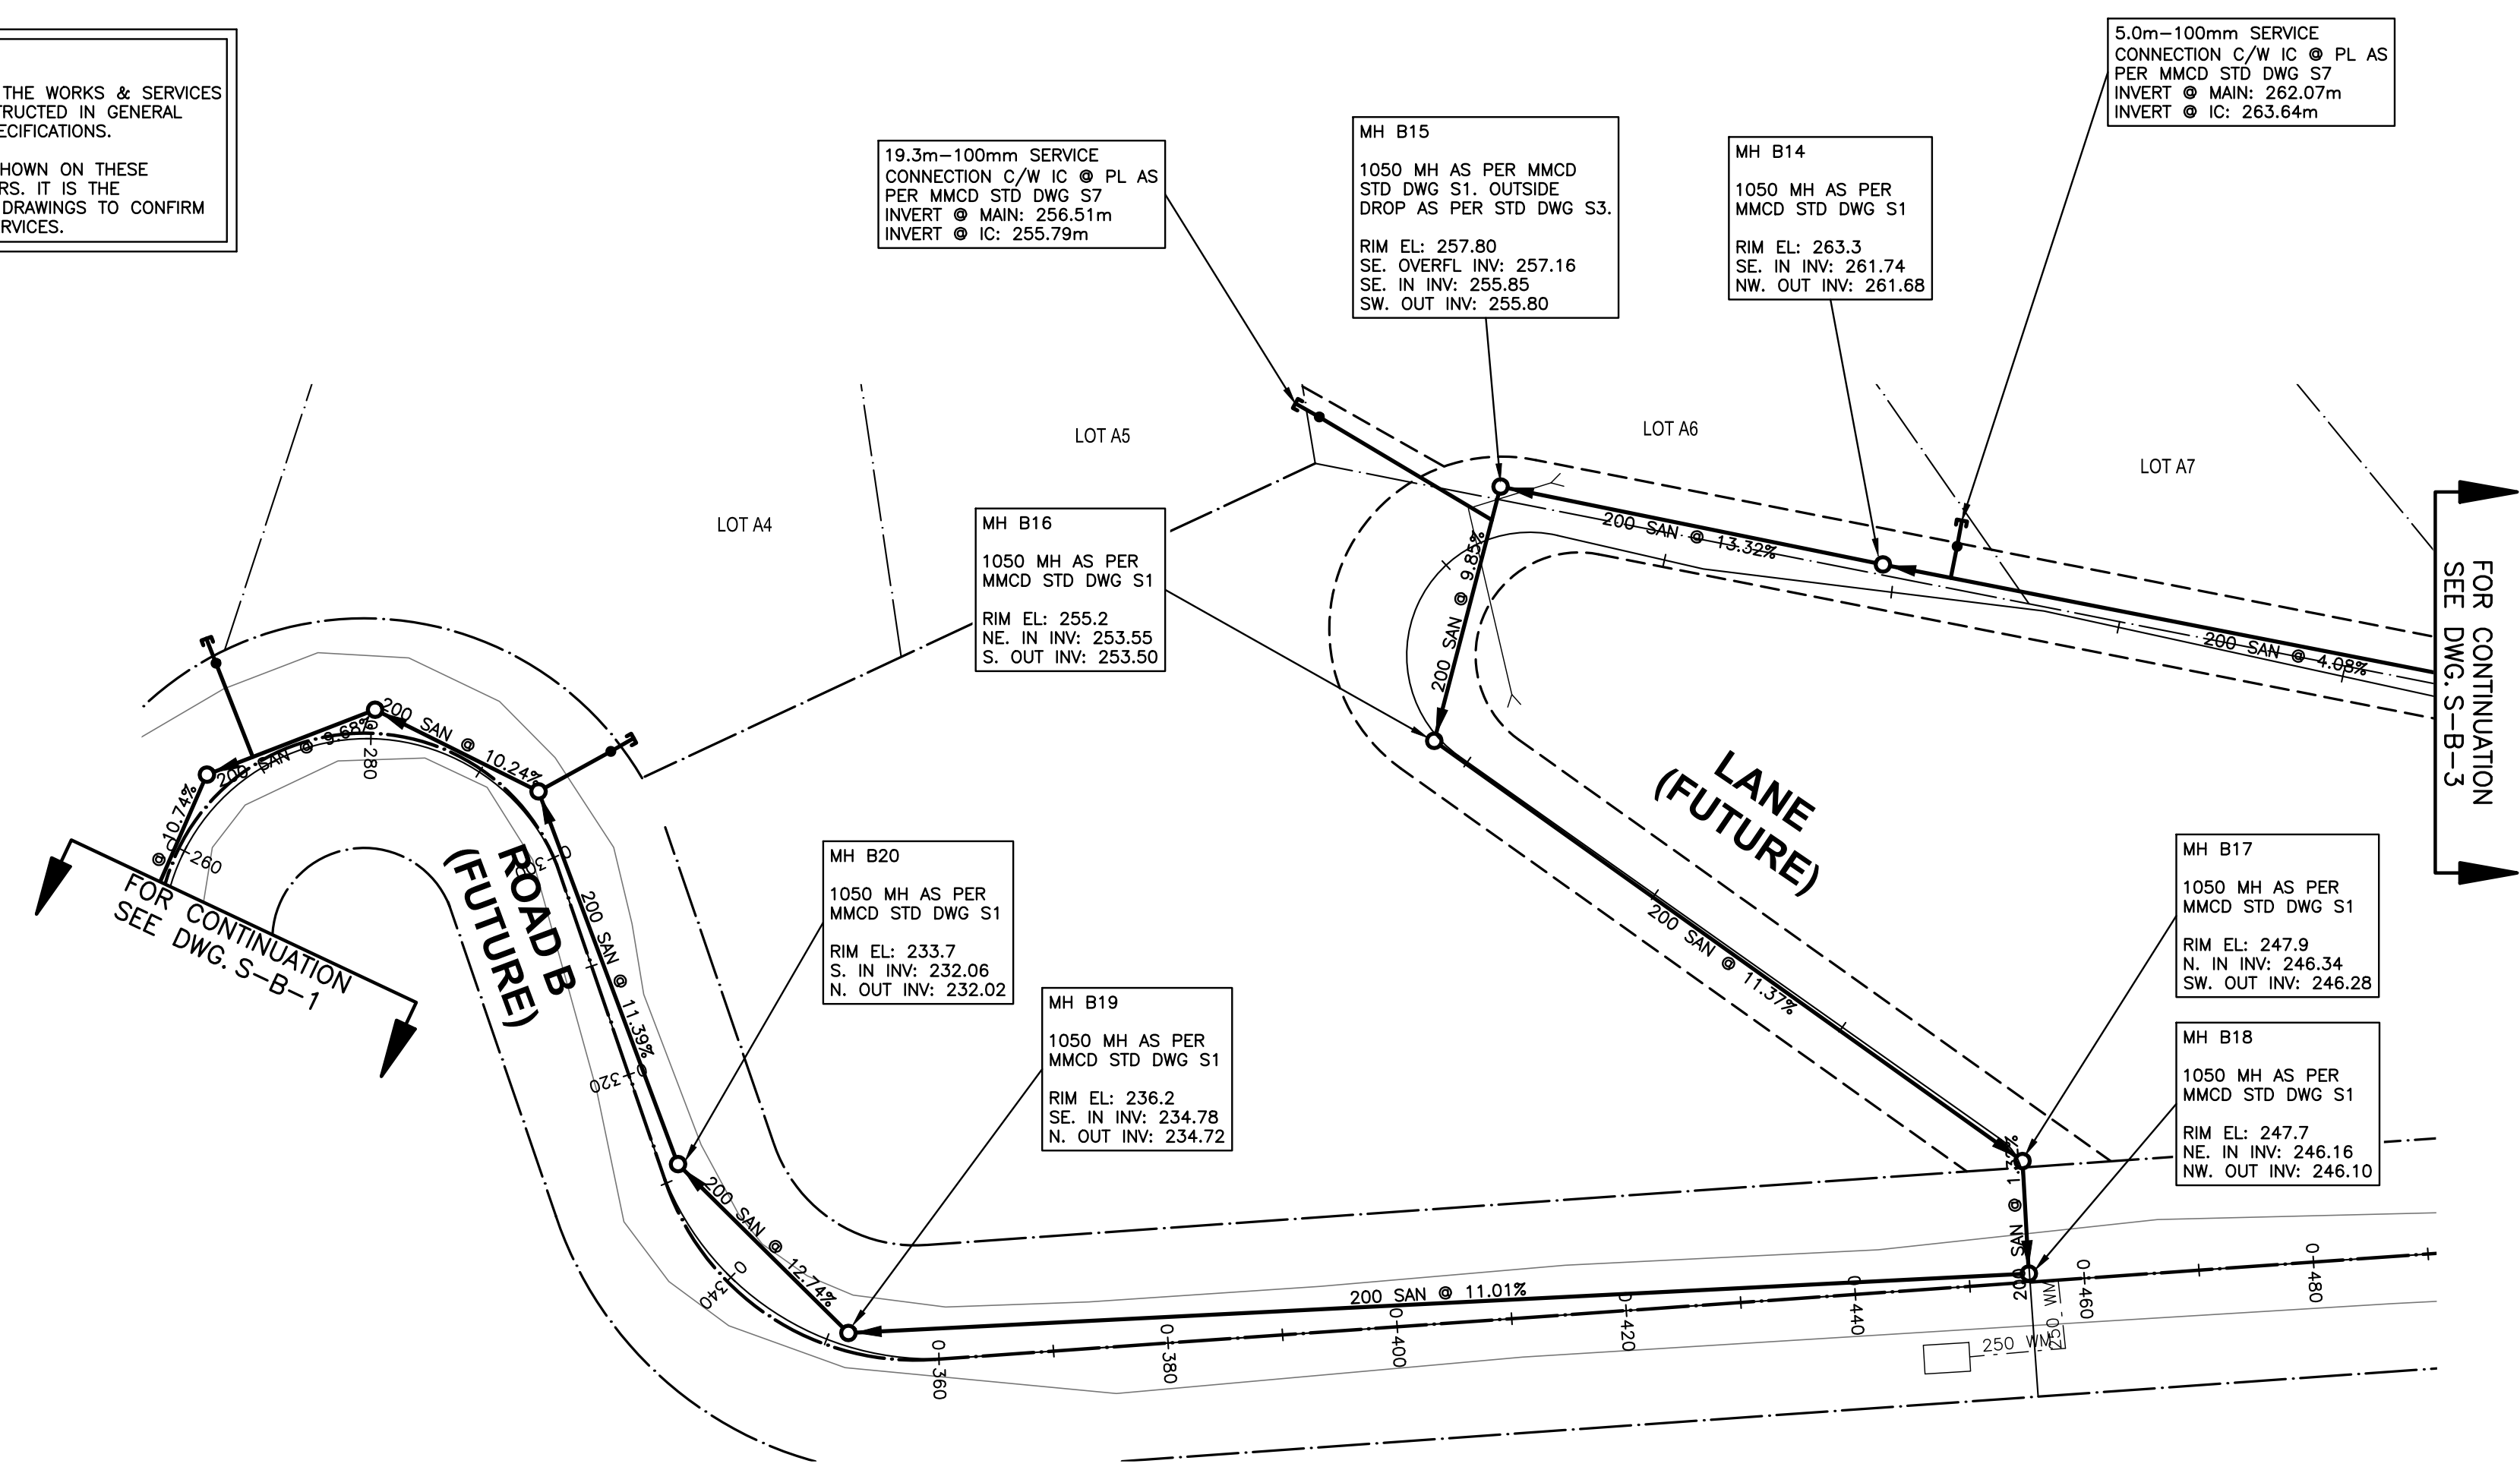


Civil Engineers & Project Managers  
 SUITE 200-901 16TH ST WEST, NORTH VANCOUVER BC, V7P1R2  
 PH: 604-987-0070 WEBSITE: www.creus.ca

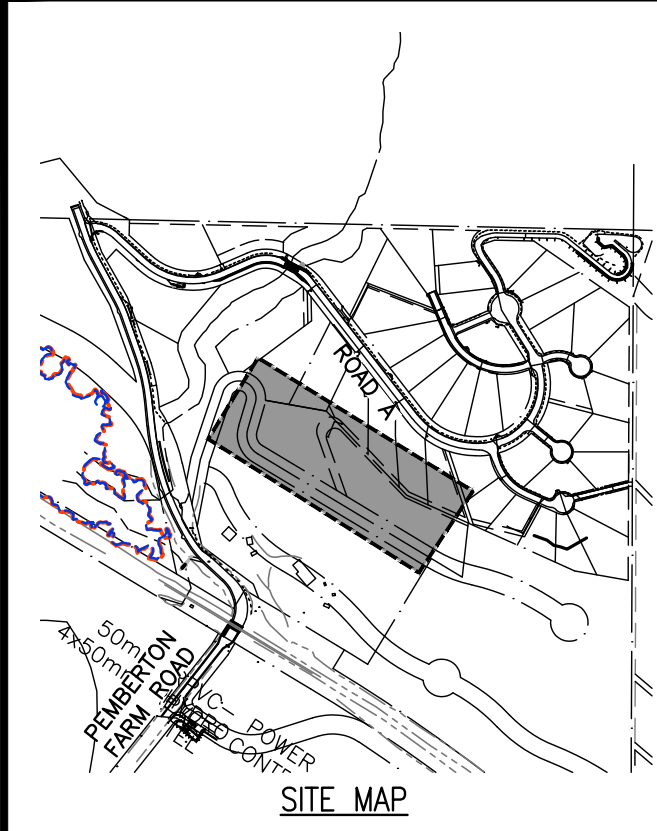

DRAWING LEGEND

	EXISTING	PROP.	TO BE REMOVED
LEGAL LINE	---	---	---
EASEMENT	---	---	---
WATERMAIN	---	---	---
SANITARY	---	---	---
STORM	---	---	---
HYDRO	---	---	---
TEL	---	---	---
STREETLIGHT	---	---	---
GAS	---	---	---
	EXISTING	PROP.	TO BE REMOVED
FIRE HYDRANT	⊗	⊗	⊗
GATE VALVE	⊗	⊗	⊗
AIR VALVE	⊗	⊗	⊗
REDUCER	⊗	⊗	⊗
INSPECTION CHAMBER	⊗	⊗	⊗
CATCHBASIN (STD/SI)	⊗	⊗	⊗
CAP	⊗	⊗	⊗
MANHOLE	⊗	⊗	⊗
POWER POLE	⊗	⊗	⊗
STREETLIGHT	⊗	⊗	⊗

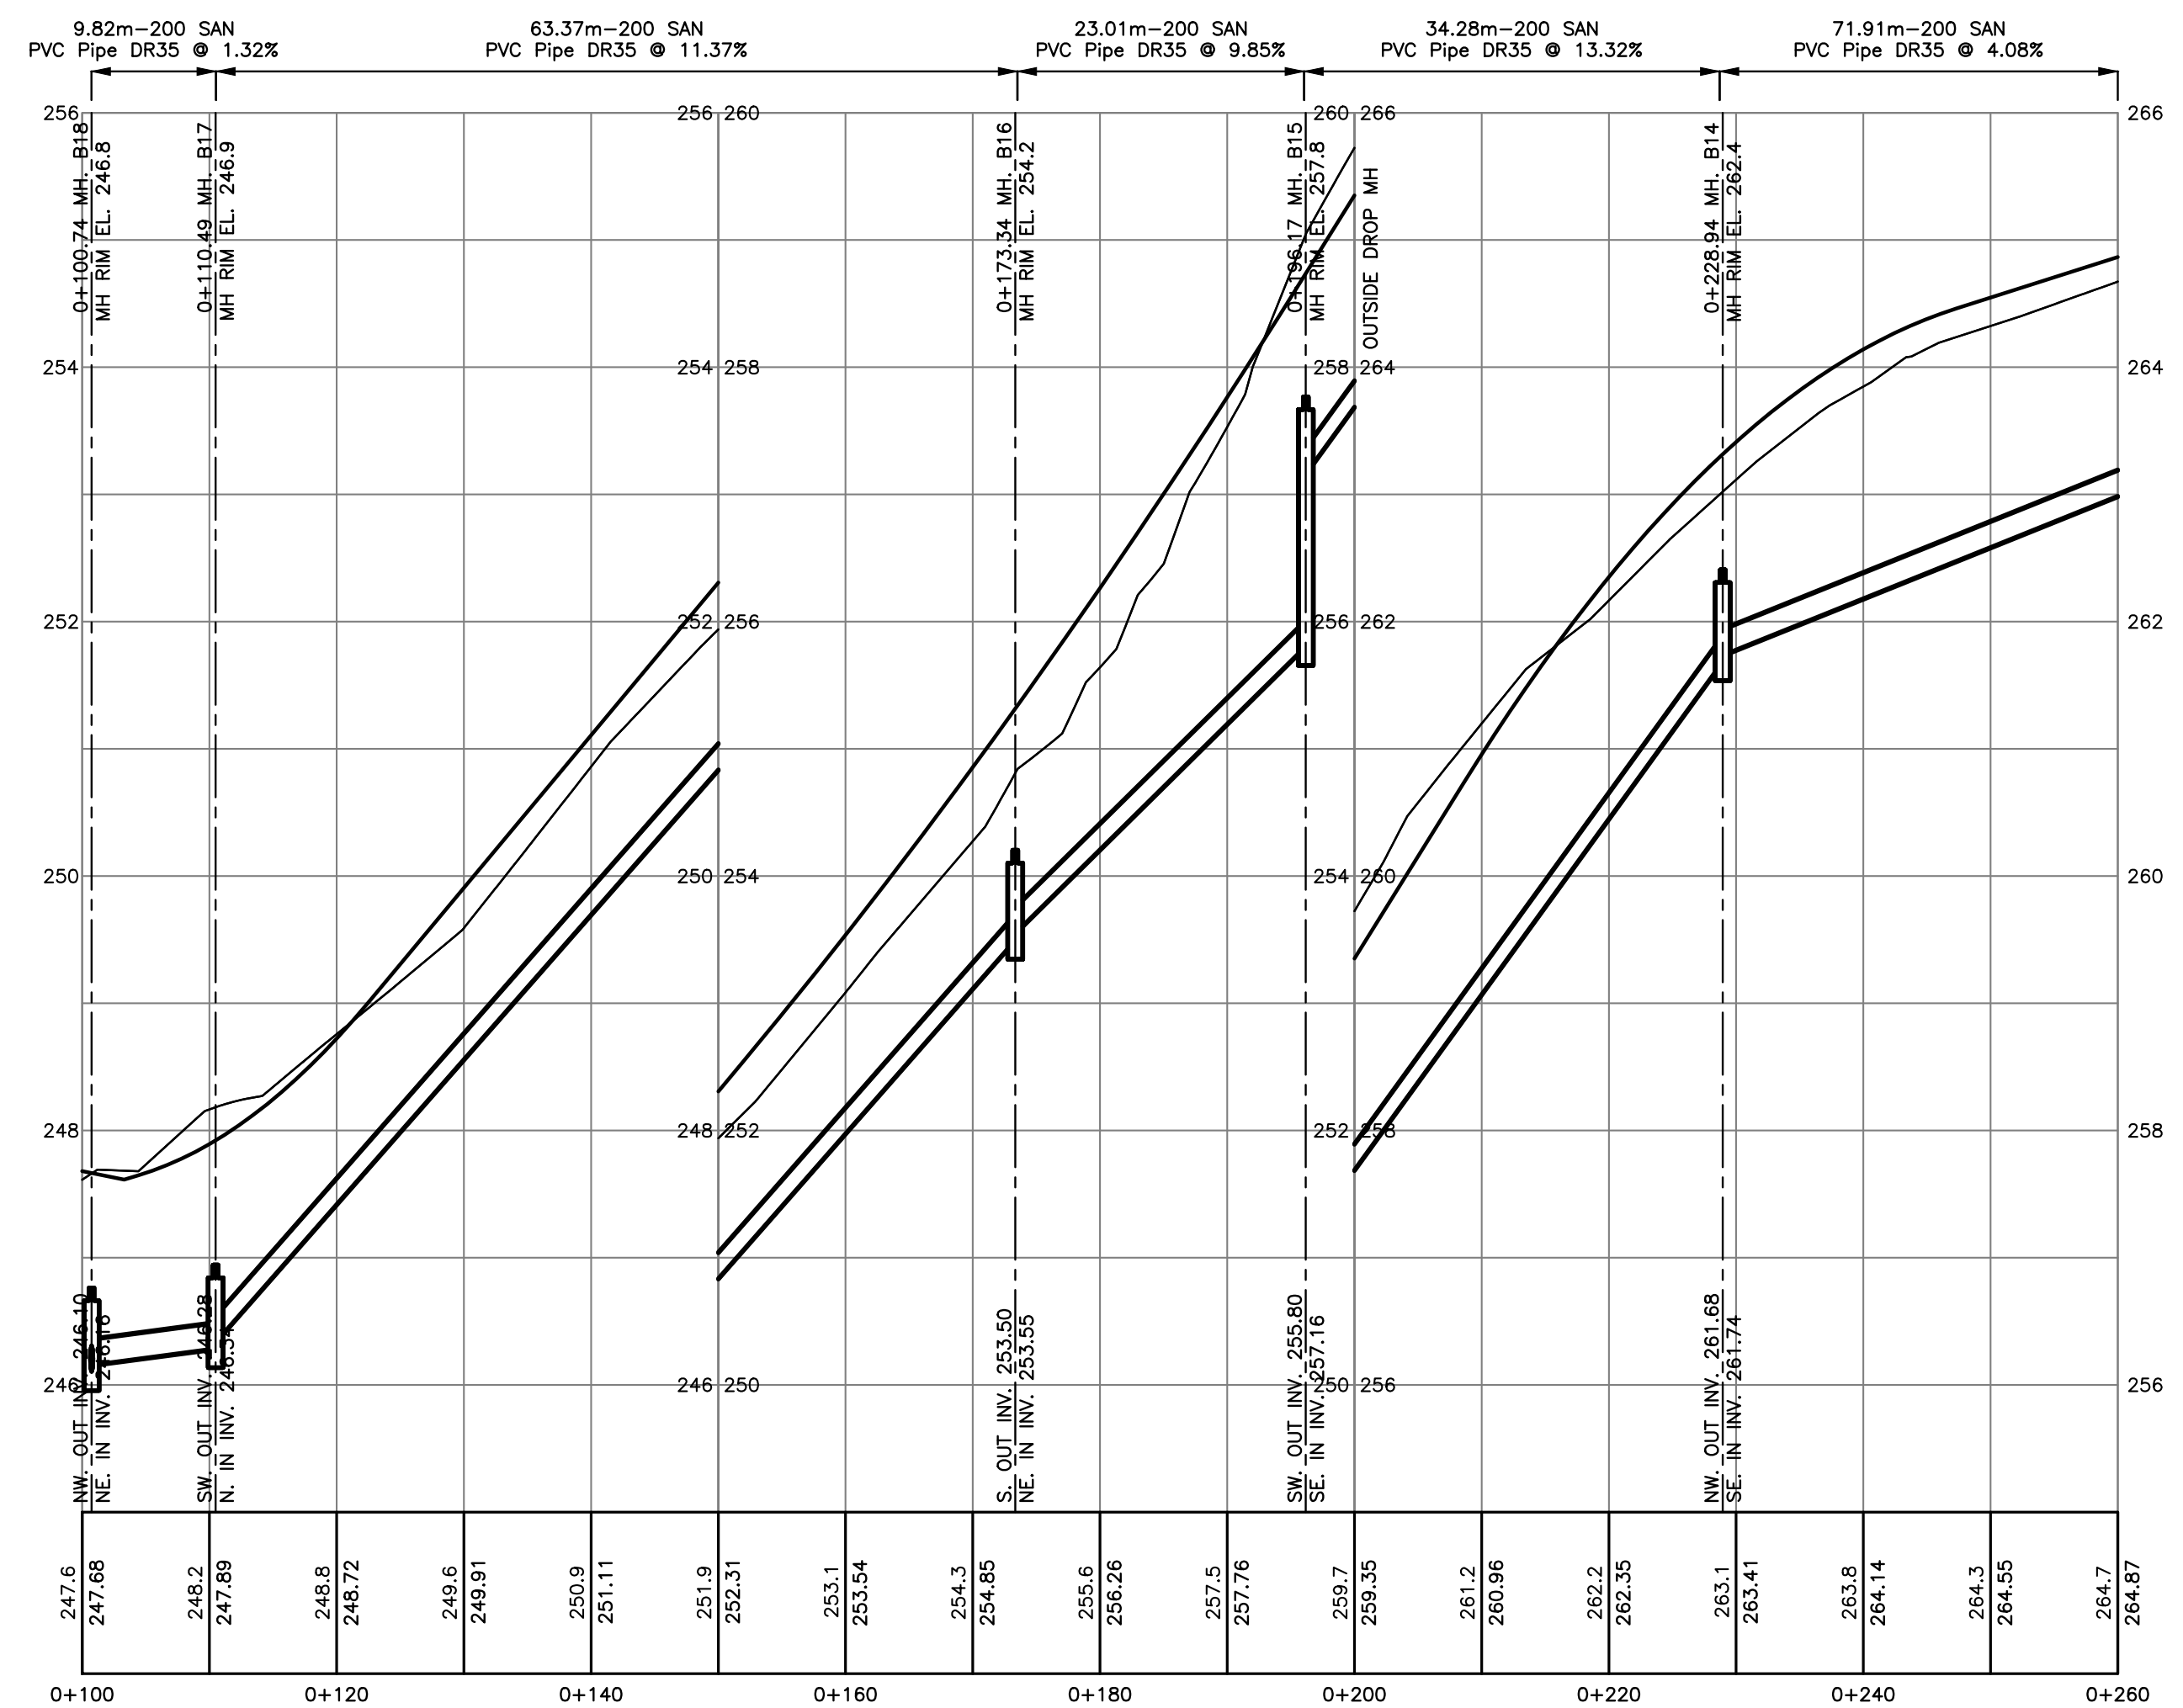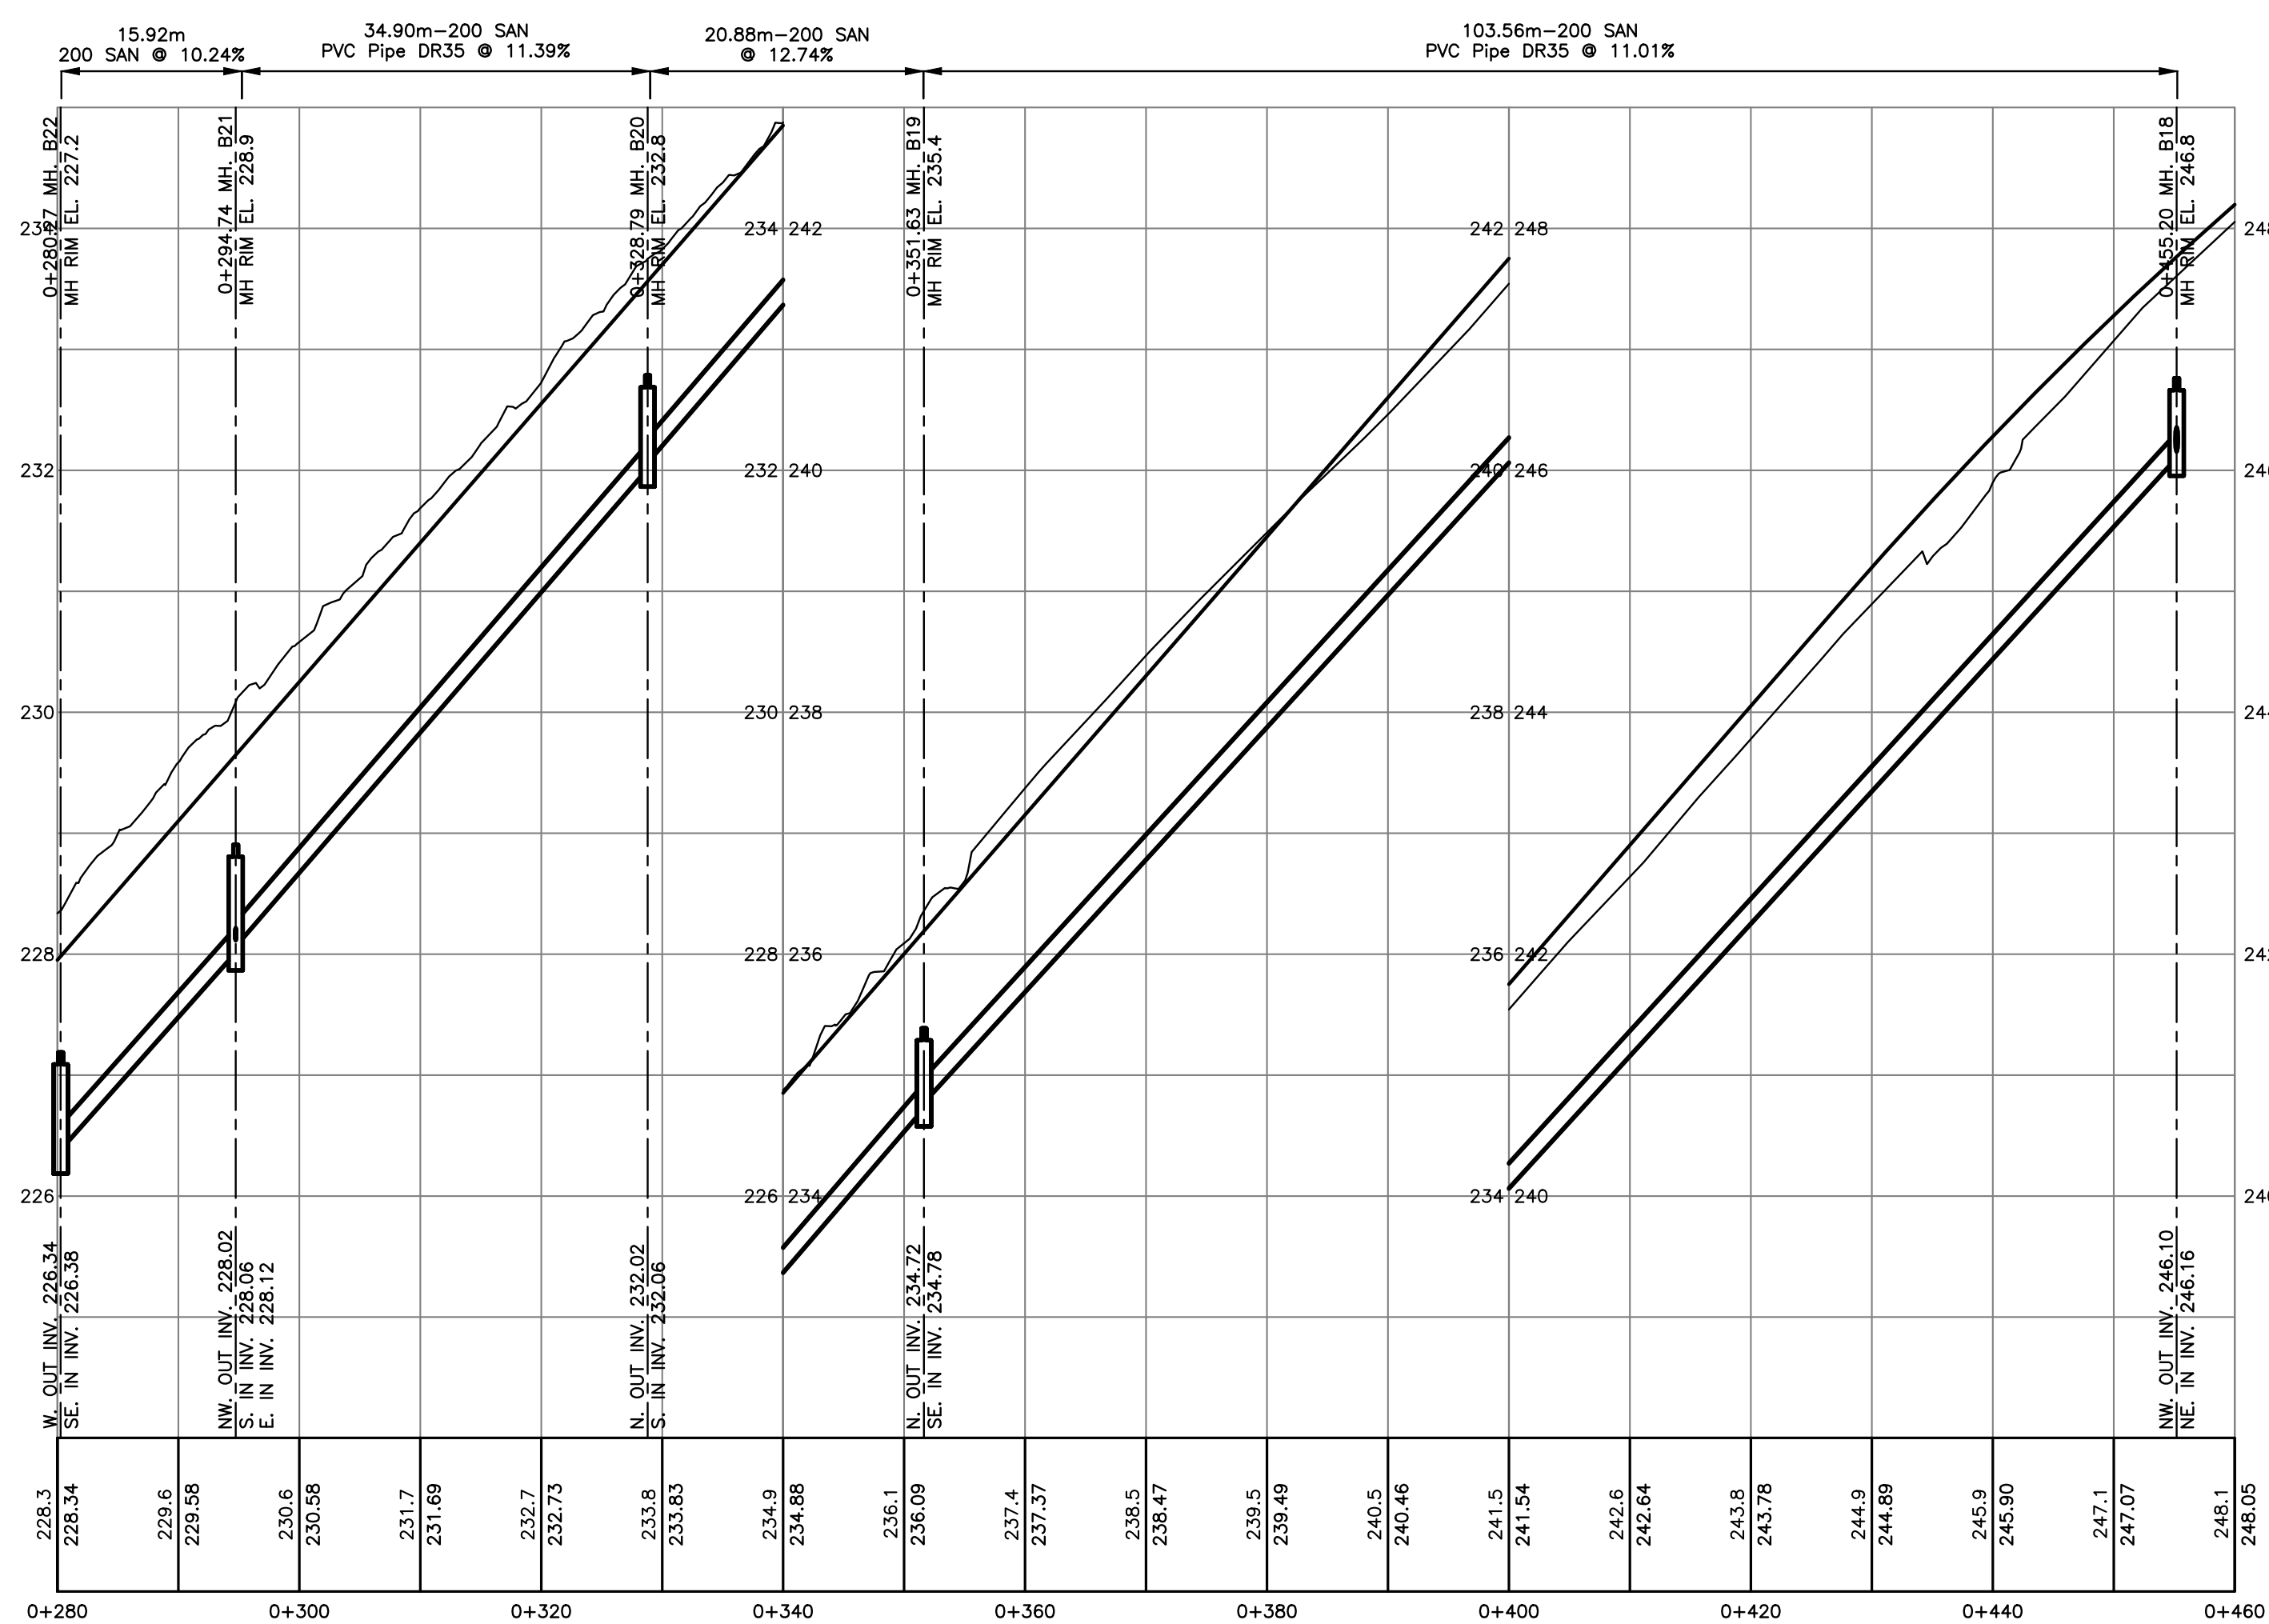

approved

client  
 580049 BC LTD.


project  
 THE RIDGE AT PEMBERTON  
 PHASE 1  
 PEMBERTON, BC

title  
 SANITARY  
 MH B13 TO MH B23

no.	(y/m/d)	revision	chk'd
12	18-02-06	PROJECT RECORDS OFFSITE	KBH
11	18-02-06	PROJECT RECORDS ONSITE	KBH
10	17-10-17	PROJECT RECORDS OFFSITE	KBH
9	17-04-13	ISSUED FOR OFFSITE AI #5	AGC
8	17-03-07	REISSUED FOR CONSTRUCTION OFFSITE	KBH
7	17-02-27	ISSUED FOR CONSTRUCTION ONSITE	KBH
6	16-12-19	REVISED PER CLIENT REQUEST AI(3)	KBH
5	16-11-09	REISSUED FOR CONSTRUCTION ONSITE	KBH

engineer of record	K.B.H.	scales	hor: 1:500 vert: 1:50
designed by	N.G.B.	file no.	16159
drawn by	R.J.L.	drawing no.	S-B-2
date	2016-05-13		







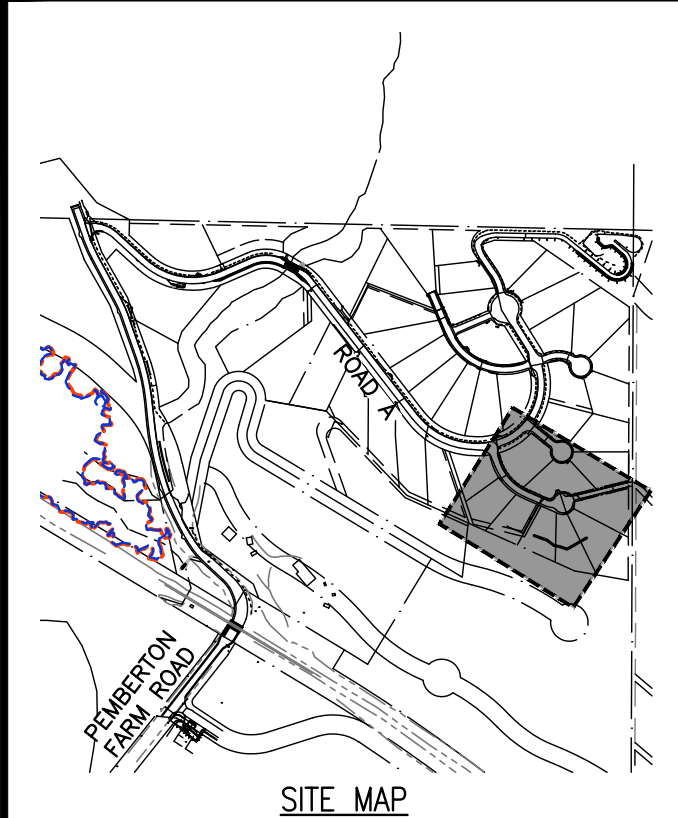

### DRAWING LEGEND

	EXISTING	PROP.	TO BE REMOVED
LEGAL LINE	---	---	---
EASEMENT	---	---	---
WATERMAIN	---	---	---
SANITARY	---	---	---
STORM	---	---	---
HYDRO	---	---	---
TEL	---	---	---
STREETLIGHT	---	---	---
GAS	---	---	---
FIRE HYDRANT	---	---	---
GATE VALVE	---	---	---
AIR VALVE	---	---	---
REDUCER	---	---	---
INSPECTION CHAMBER	---	---	---
CATCHBASIN (STD/SI)	---	---	---
CAP	---	---	---
MANHOLE	---	---	---
POWER POLE	---	---	---
STREETLIGHT	---	---	---

**AS-CONSTRUCTED INFORMATION**  
 CREUS ENGINEERING LTD. CERTIFIES THAT THE WORKS & SERVICES SHOWN ON THESE DRAWINGS WERE CONSTRUCTED IN GENERAL CONFORMANCE WITH THE DRAWINGS & SPECIFICATIONS.  
 AS-CONSTRUCTED SURVEY INFORMATION SHOWN ON THESE DRAWINGS HAVE BEEN PROVIDED BY OTHERS. IT IS THE RESPONSIBILITY OF OTHERS USING THESE DRAWINGS TO CONFIRM THE LOCATION & ELEVATION OF THESE SERVICES.

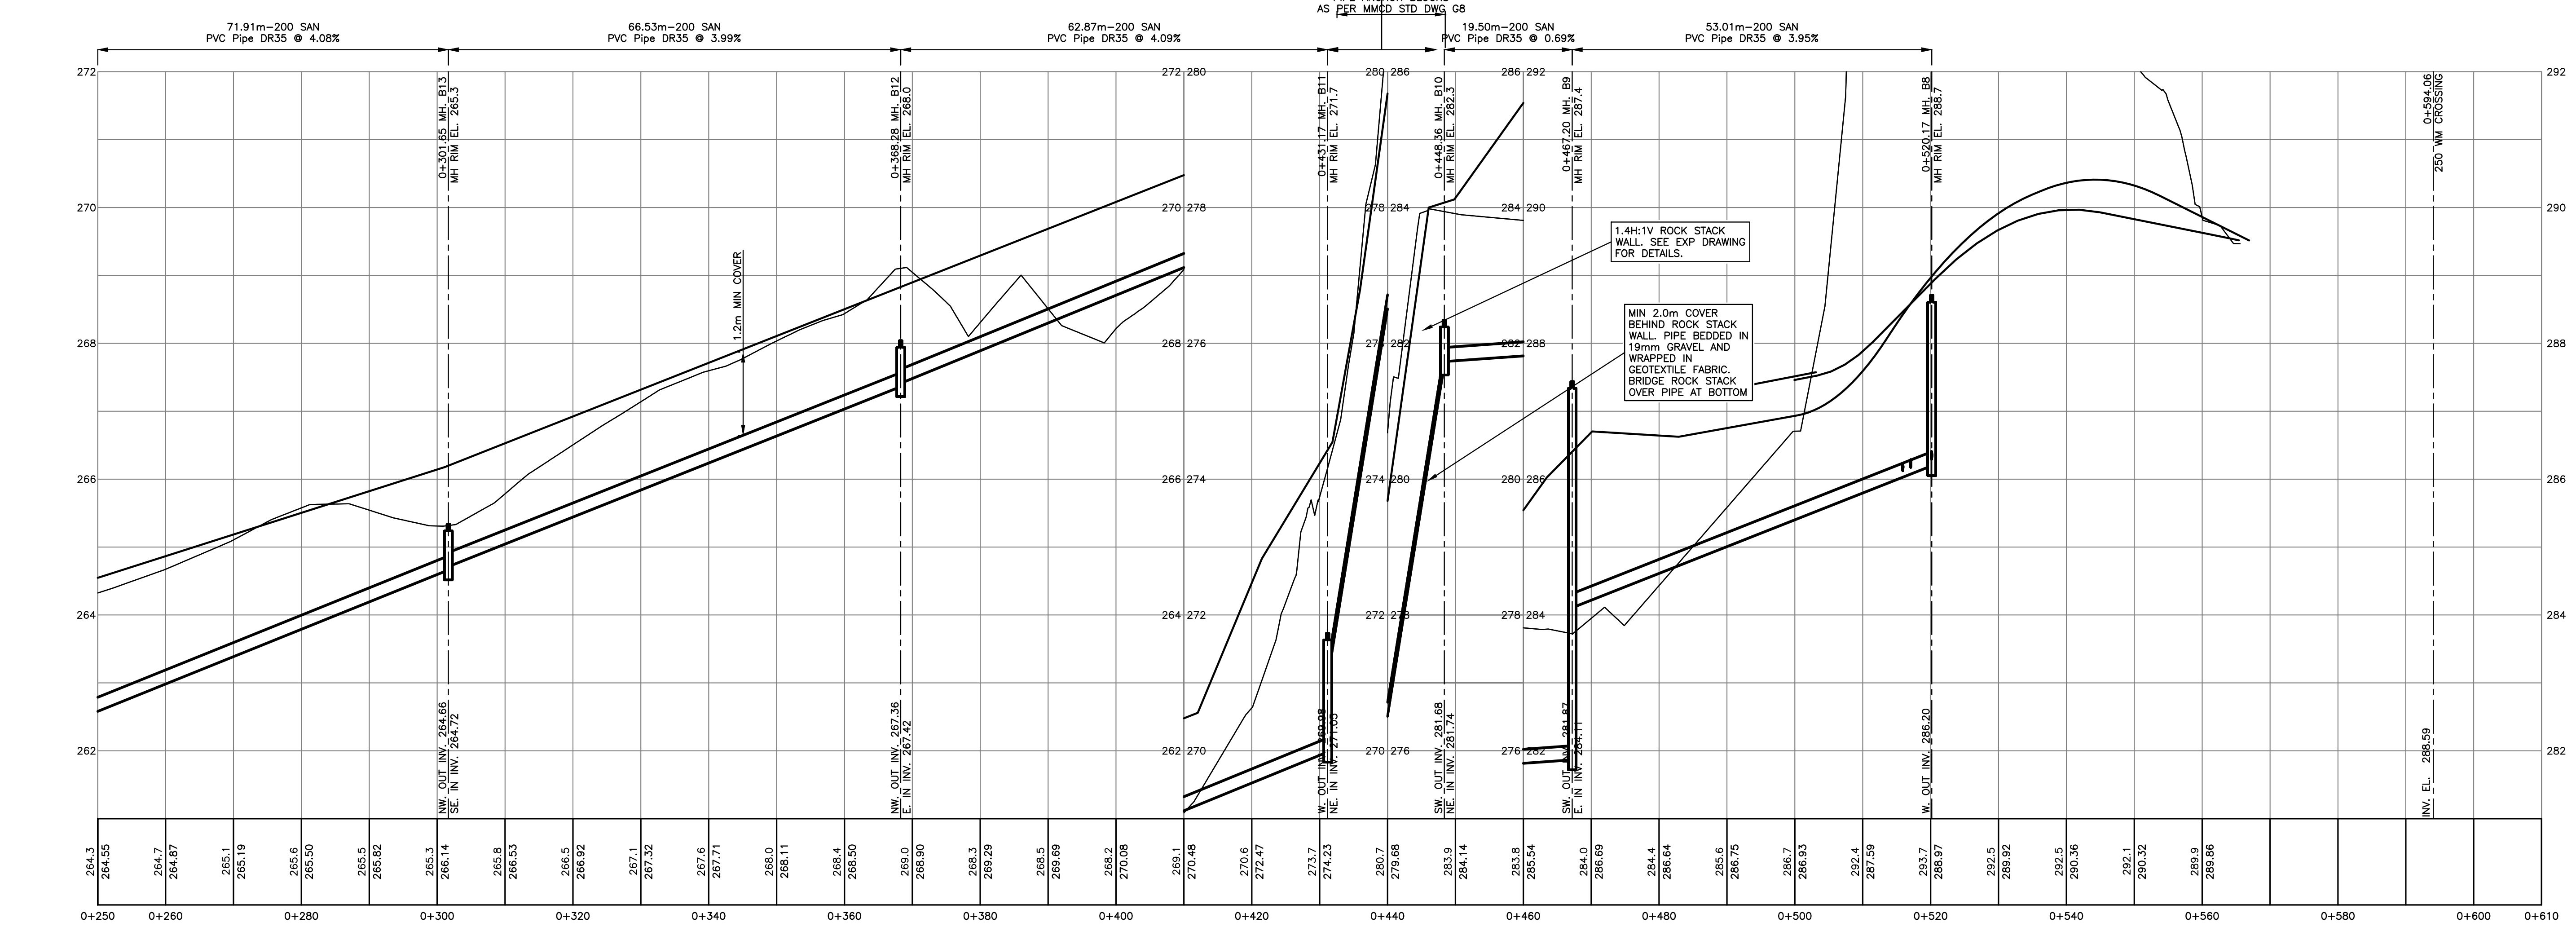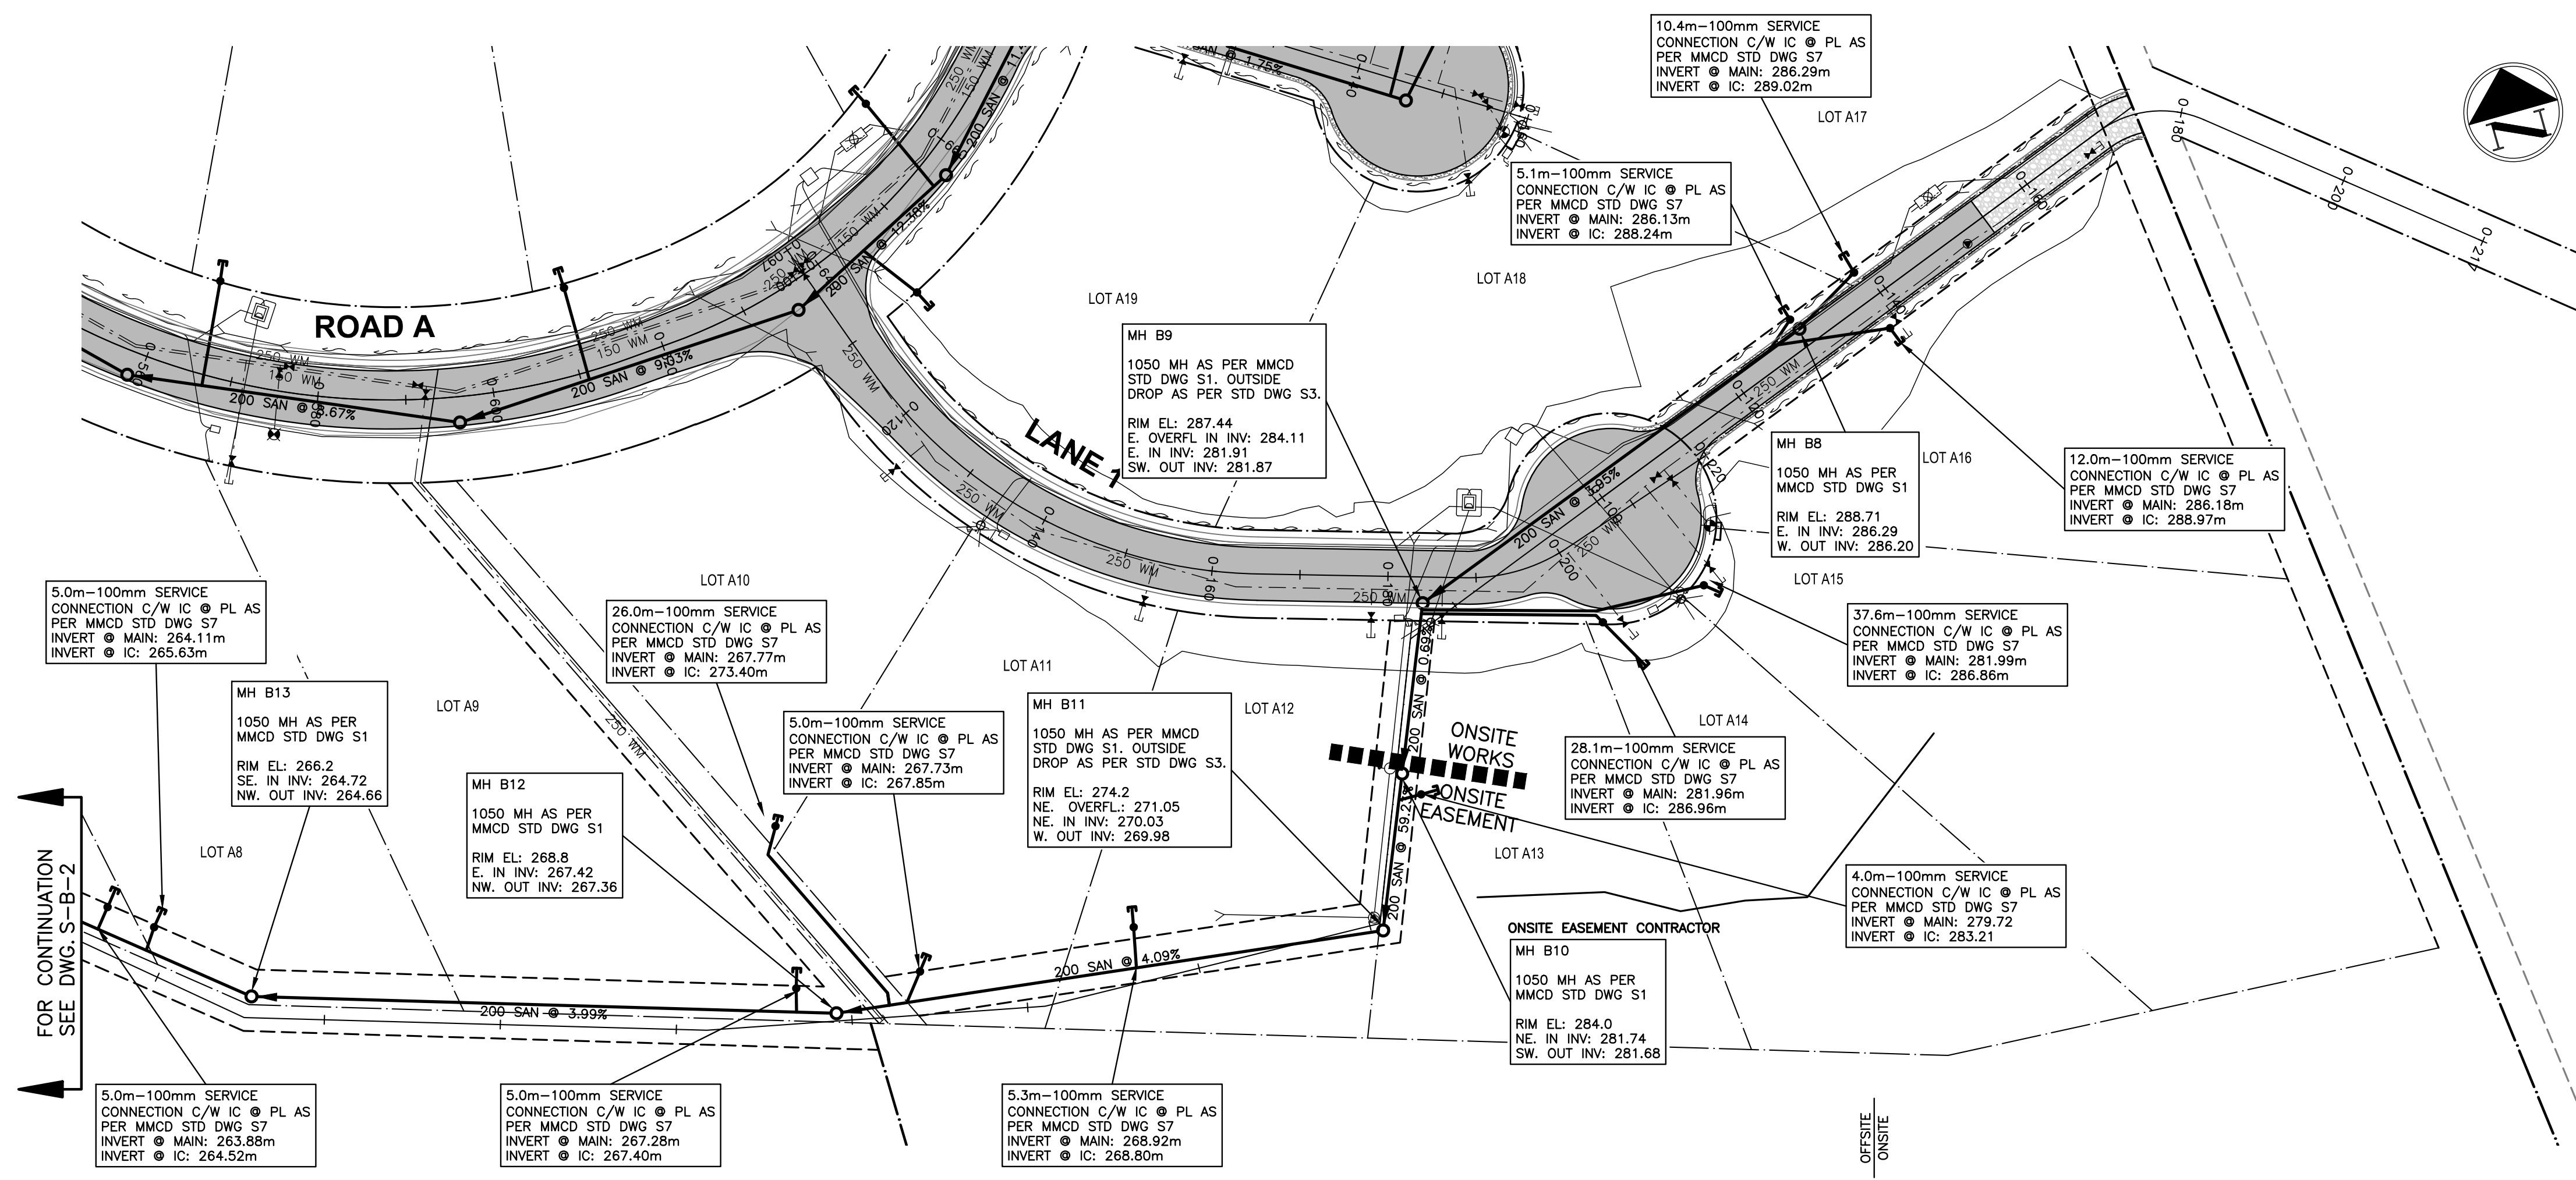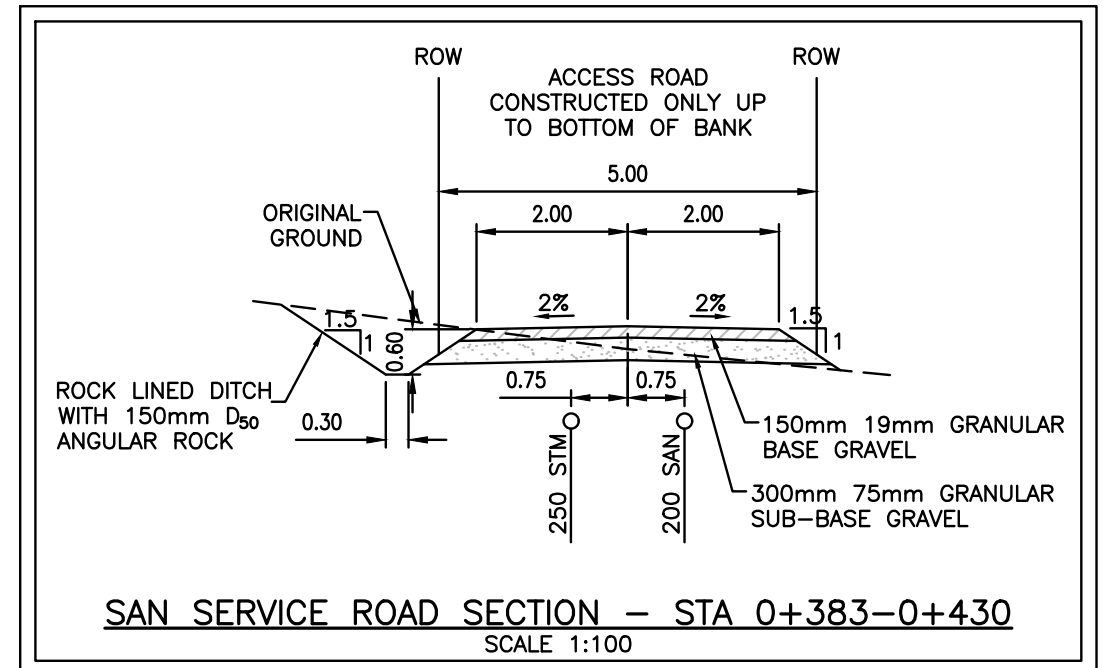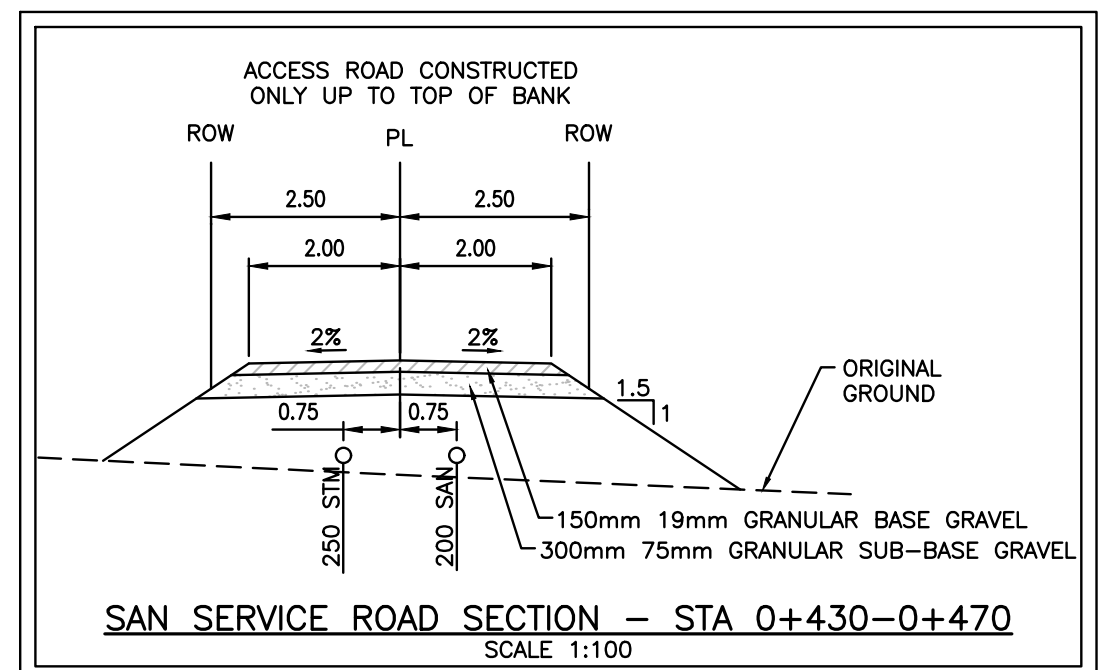

approved

client  
 580049 BC LTD.

project  
 THE RIDGE AT PEMBERTON  
 PHASE 1  
 PEMBERTON, BC

title  
 SANITARY  
 MH B1 TO MH B12

no.	(y/m/d)	revision	chk'd
15	18-02-06	PROJECT RECORDS OFFSITE	KBH
14	18-02-06	PROJECT RECORDS ONSITE	KBH
13	17-10-17	PROJECT RECORDS OFFSITE	KBH
12	17-06-09	REVISED MH B8 LOCATION	KBH
11	17-04-27	REVISED GRADING	DWC
10	17-04-13	ISSUED FOR OFFSITE AI #5	KBH
9	17-03-07	REISSUED FOR CONSTRUCTION OFFSITE	KBH
8	17-02-27	ISSUED FOR CONSTRUCTION	KBH




engineer of record	K.B.H.	scales	hor: 1:500 vert: 1:50
designed by	N.G.B.	file no.	16159
drawn by	R.J.L.	drawing no.	S-B-3
date	2016-05-13		



AS-CONSTRUCTED INFORMATION  
 CREUS ENGINEERING LTD. CERTIFIES THAT THE WORKS & SERVICES SHOWN ON THESE DRAWINGS WERE CONSTRUCTED IN GENERAL CONFORMANCE WITH THE DRAWINGS & SPECIFICATIONS.  
 AS-CONSTRUCTED SURVEY INFORMATION SHOWN ON THESE DRAWINGS HAVE BEEN PROVIDED BY OTHERS. IT IS THE RESPONSIBILITY OF OTHERS USING THESE DRAWINGS TO CONFIRM THE LOCATION & ELEVATION OF THESE SERVICES.

SEE DRAWING KEY-1 FOR GENERAL NOTES  
 SEE DRAWING W-A-1 FOR WATERWORKS NOTES  
 SEE DRAWING S-A-1 FOR SANITARY NOTES

Civil Engineers & Project Managers  
 SUITE 200-901 16TH ST WEST, NORTH VANCOUVER BC, V7P1R2  
 PH: 604-987-0070 WEBSITE: www.creus.ca

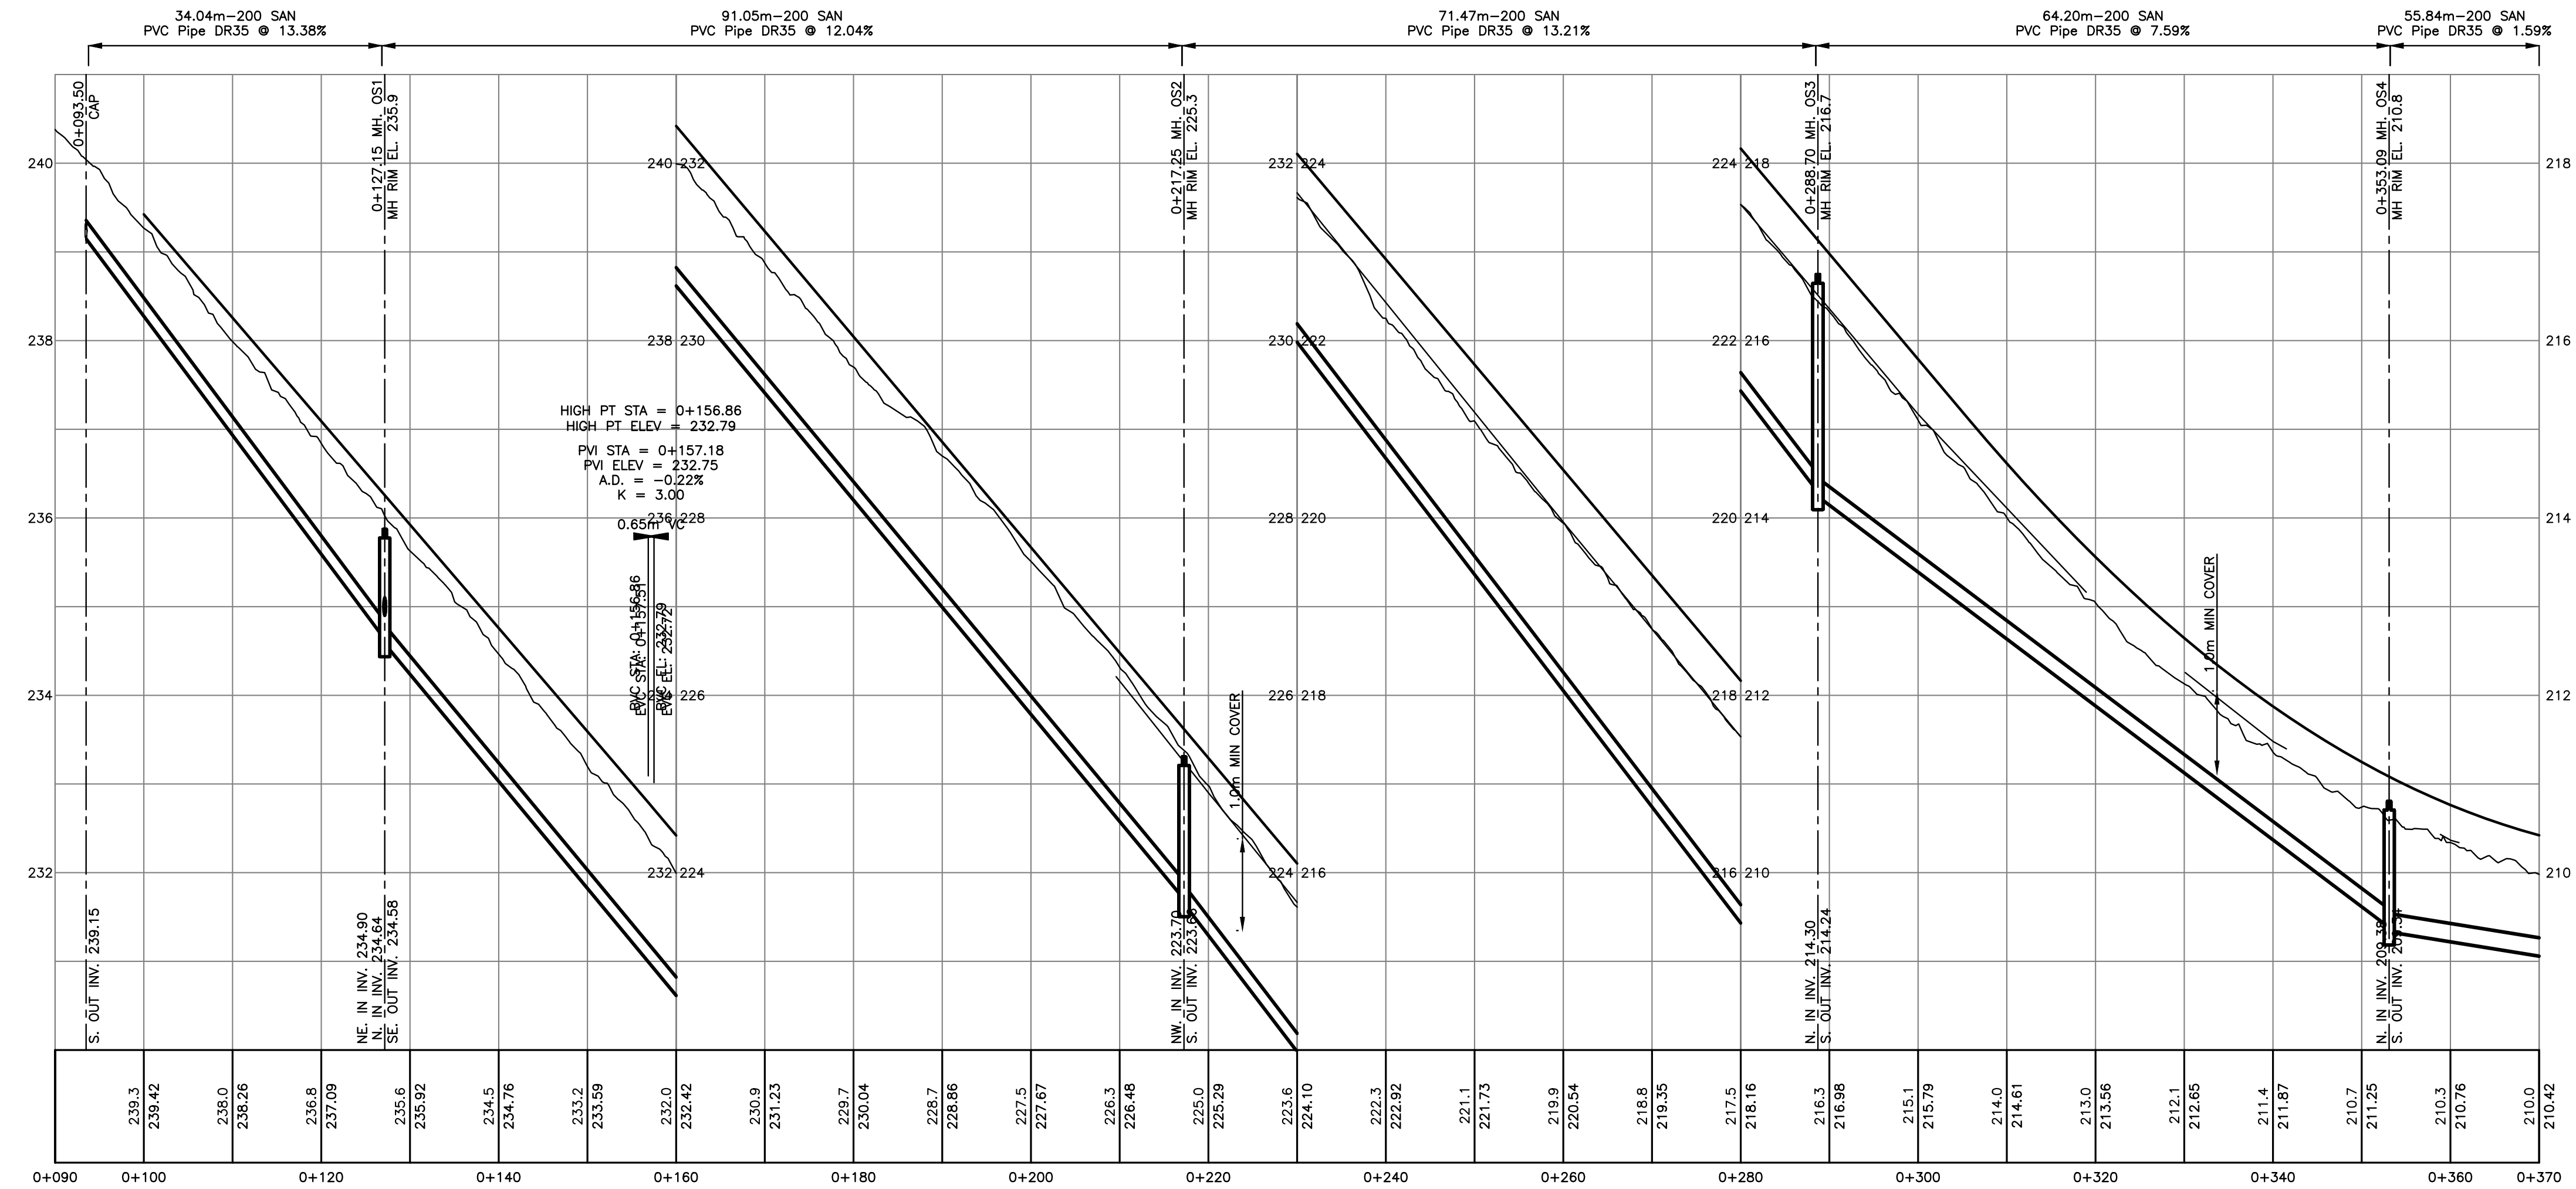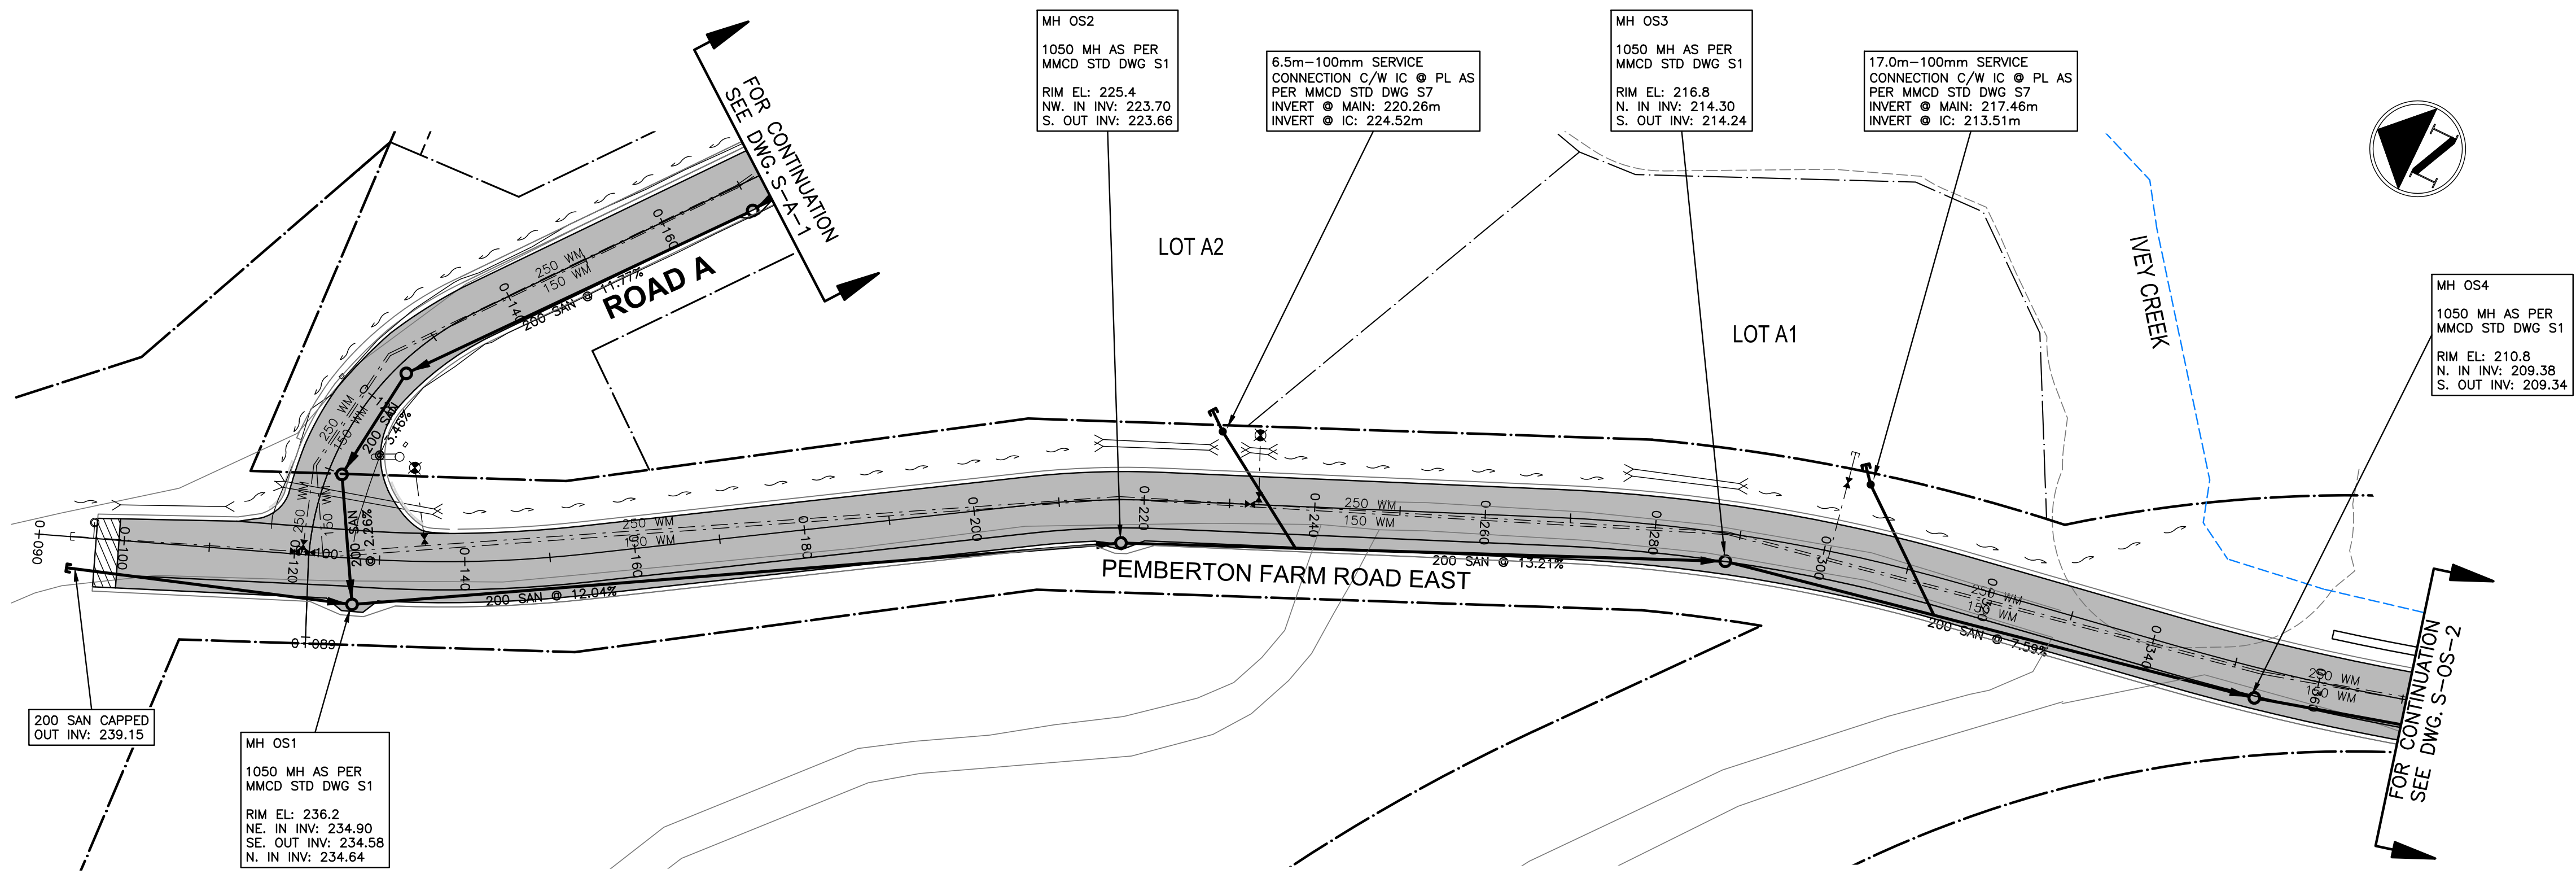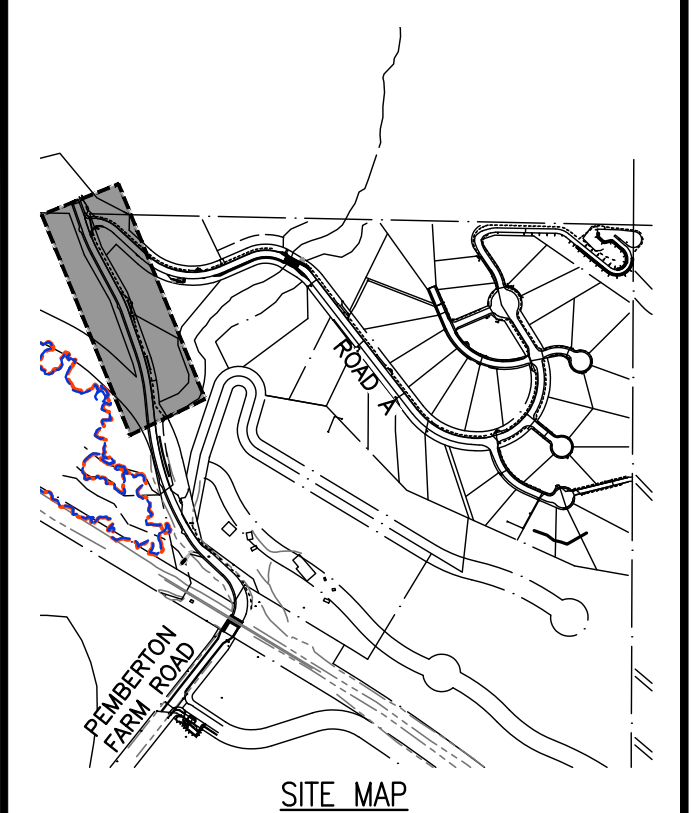

DRAWING LEGEND

	EXISTING	PROP.	TO BE REMOVED
LEGAL LINE	---	---	---
EASEMENT	---	---	---
WATERMAIN	---	---	---
SANITARY	---	---	---
STORM	---	---	---
HYDRO	---	---	---
TEL	---	---	---
STREETLIGHT	---	---	---
GAS	---	---	---
	EXISTING	PROP.	TO BE REMOVED
FIRE HYDRANT	⊗	⊗	⊗
GATE VALVE	⊗	⊗	⊗
AIR VALVE	⊗	⊗	⊗
REDUCER	⊗	⊗	⊗
INSPECTION CHAMBER	⊗	⊗	⊗
CATCHBASIN (STD/SI)	⊗	⊗	⊗
CAP	⊗	⊗	⊗
MANHOLE	⊗	⊗	⊗
POWER POLE	⊗	⊗	⊗
STREETLIGHT	⊗	⊗	⊗

approved

client  
 580049 BC LTD.

project  
 THE RIDGE AT PEMBERTON  
 PHASE 1  
 PEMBERTON, BC

title  
 SANITARY  
 OFFSITE ROAD (STA 0+120-0+370)

no.	(y/m/d)	revision	chk'd
13	18-02-06	PROJECT RECORDS OFFSITE	KBH
12	17-10-17	PROJECT RECORDS OFFSITE	KBH
11	17-04-13	ISSUED FOR AI #5	AGC
10	17-03-07	REISSUED FOR CONSTRUCTION OFFSITE	KBH
9	16-11-09	REISSUED FOR CONSTRUCTION OFFSITE	KBH
8	16-10-26	IFC OFFSITE FINAL COMMENTS	KBH
7	16-10-13	ISSUED FOR CONSTRUCTION OFFSITE	KBH
6	16-09-19	ISSUED FOR VOP FINAL COMMENTS	KBH


engineer of record: K.B.H. scales: hor: 1:500 vert: 1:50  
 designed by: N.G.B. file no.: 16159  
 drawn by: R.J.L. drawing no.: S-OS-1  
 date: 2016-05-13



AS--CONSTRUCTED INFORMATION  
 CREUS ENGINEERING LTD. CERTIFIES THAT THE WORKS & SERVICES SHOWN ON THESE DRAWINGS WERE CONSTRUCTED IN GENERAL CONFORMANCE WITH THE DRAWINGS & SPECIFICATIONS.  
 AS--CONSTRUCTED SURVEY INFORMATION SHOWN ON THESE DRAWINGS HAVE BEEN PROVIDED BY OTHERS. IT IS THE RESPONSIBILITY OF OTHERS USING THESE DRAWINGS TO CONFIRM THE LOCATION & ELEVATION OF THESE SERVICES.



SEE DRAWING KEY-1 FOR GENERAL NOTES  
 SEE DRAWING W-A-1 FOR WATERWORKS NOTES  
 SEE DRAWING S-A-1 FOR SANITARY NOTES

Civil Engineers & Project Managers  
 SUITE 200-901 16TH ST WEST, NORTH VANCOUVER BC, V7P1R2  
 PH: 604-987-0070 WEBSITE: www.creus.ca

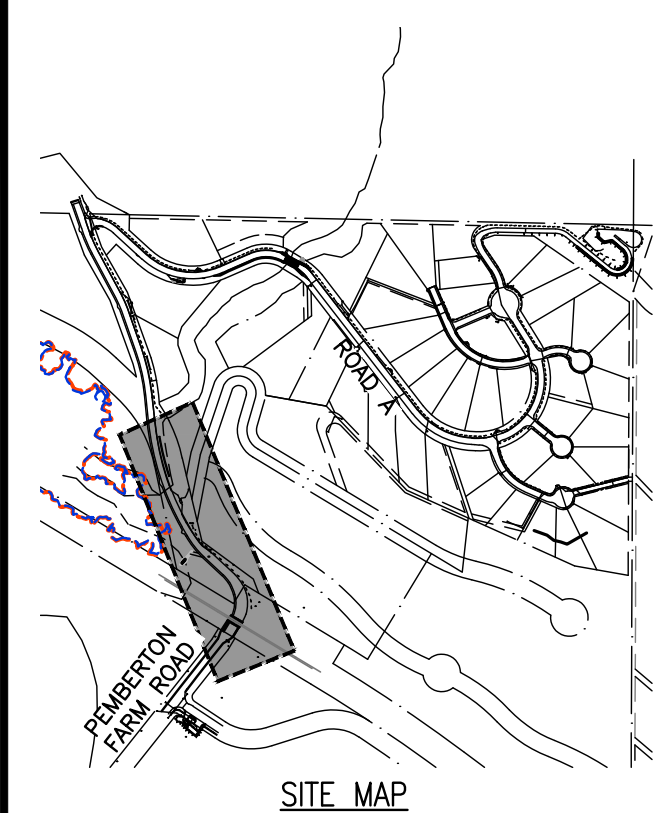

### DRAWING LEGEND

	EXISTING	PROP.	TO BE REMOVED
LEGAL LINE	---	---	---
EASEMENT	---	---	---
WATERMAIN	---	---	---
SANITARY	---	---	---
STORM	---	---	---
HYDRO	---	---	---
TEL	---	---	---
STREETLIGHT	---	---	---
GAS	---	---	---
	EXISTING	PROP.	TO BE REMOVED
FIRE HYDRANT	⊗	⊗	⊗
GATE VALVE	⊗	⊗	⊗
AIR VALVE	⊗	⊗	⊗
REDUCER	⊗	⊗	⊗
INSPECTION CHAMBER	⊗	⊗	⊗
CATCHBASIN (STD/SI)	⊗	⊗	⊗
CAP	⊗	⊗	⊗
MANHOLE	⊗	⊗	⊗
POWER POLE	⊗	⊗	⊗
STREETLIGHT	⊗	⊗	⊗

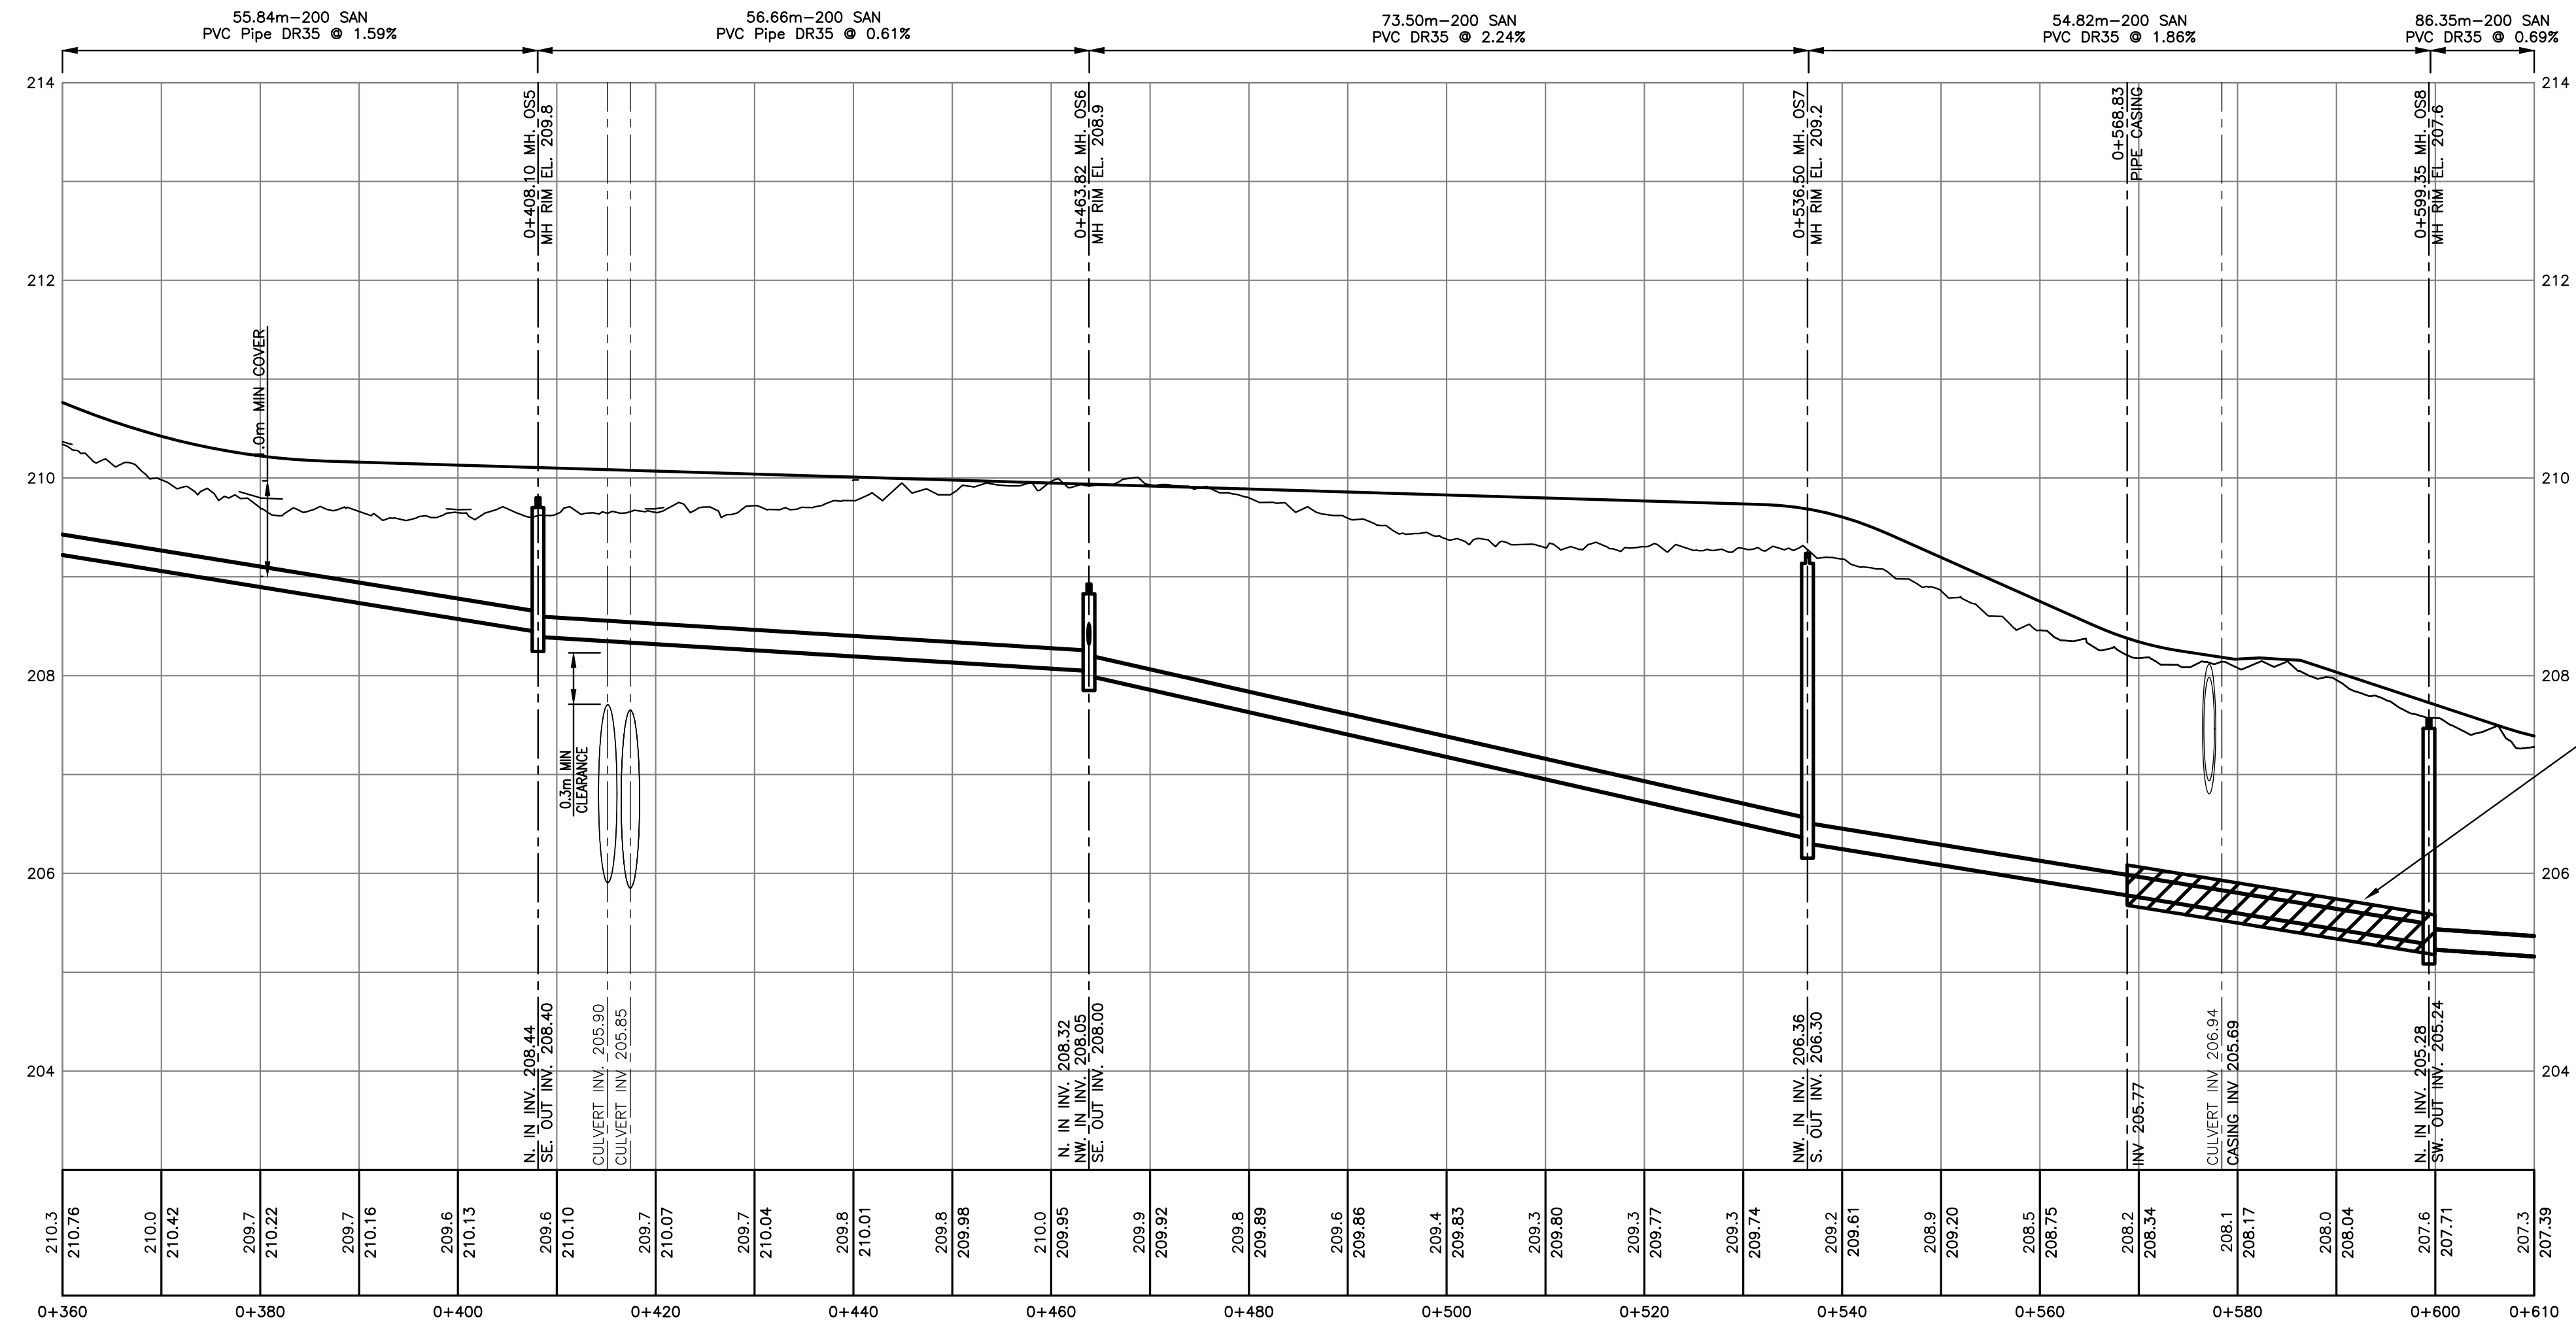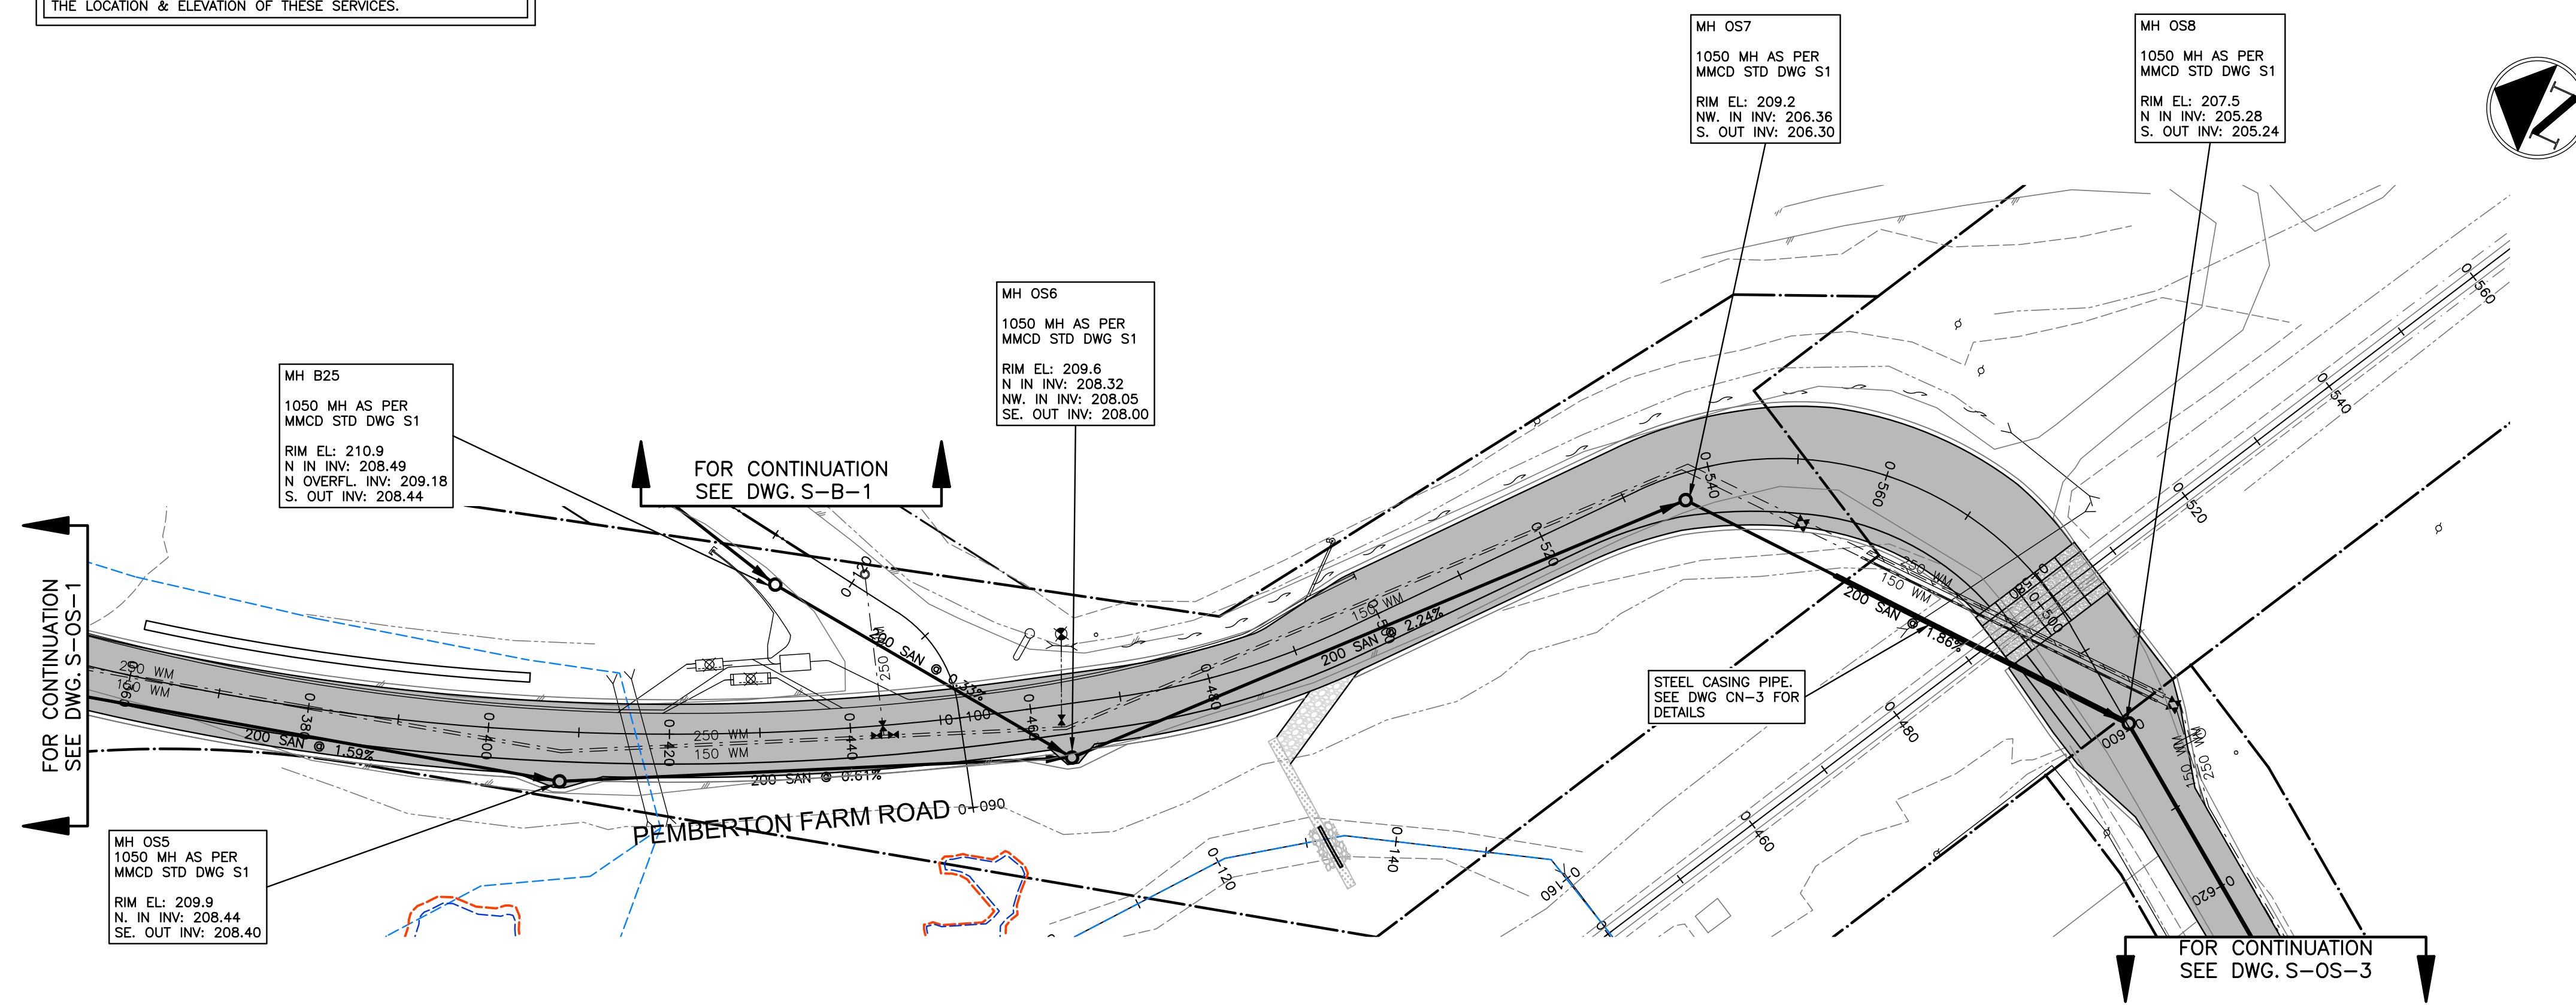

approved

client  
 580049 BC LTD.

project  
 THE RIDGE AT PEMBERTON  
 PHASE 1  
 PEMBERTON, BC

title  
 SANITARY  
 OFFSITE ROAD (STA 0+360-0+610)

no.	(y/m/d)	revision	chk'd
13	18-02-06	PROJECT RECORDS OFFSITE	KBH
12	17-10-17	PROJECT RECORDS OFFSITE	KBH
11	17-04-13	ISSUED FOR AI #5	AGC
10	17-03-07	REISSUED FOR CONSTRUCTION OFFSITE	KBH
9	16-11-09	REISSUED FOR CONSTRUCTION OFFSITE	KBH
8	16-10-26	IFC OFFSITE FINAL COMMENTS	KBH
7	16-10-13	ISSUED FOR CONSTRUCTION OFFSITE	KBH
6	16-09-19	ISSUED FOR VOP FINAL COMMENTS	KBH

copyright reserved. THIS DRAWING AND DESIGN ARE, AND AT ALL TIMES REMAIN THE EXCLUSIVE PROPERTY OF CREUS ENGINEERING LTD. AND CANNOT BE USED, REPRODUCED OR DISTRIBUTED WITHOUT WRITTEN CONSENT.  
 © 2018 CREUS ENGINEERING LTD.

engineer of record	K.B.H.	scales	hor: 1:500	vert: 1:50
designed by	N.G.B.	file no.	16159	
drawn by	R.J.L.	drawing no.	S-OS-2	
date	2016-05-13			







AS-CONSTRUCTED INFORMATION

CREUS ENGINEERING LTD. CERTIFIES THAT THE WORKS & SERVICES SHOWN ON THESE DRAWINGS WERE CONSTRUCTED IN GENERAL CONFORMANCE WITH THE DRAWINGS & SPECIFICATIONS.

AS-CONSTRUCTED SURVEY INFORMATION SHOWN ON THESE DRAWINGS HAVE BEEN PROVIDED BY OTHERS. IT IS THE RESPONSIBILITY OF OTHERS USING THESE DRAWINGS TO CONFIRM THE LOCATION & ELEVATION OF THESE SERVICES.

SEE DRAWING KEY-1 FOR GENERAL NOTES  
 SEE DRAWING W-A-1 FOR WATERWORKS NOTES  
 SEE DRAWING S-A-1 FOR SANITARY NOTES

Civil Engineers & Project Managers  
 SUITE 200-901 16TH ST WEST, NORTH VANCOUVER BC, V7P1R2  
 PH: 604-987-0070 WEBSITE: www.creus.ca

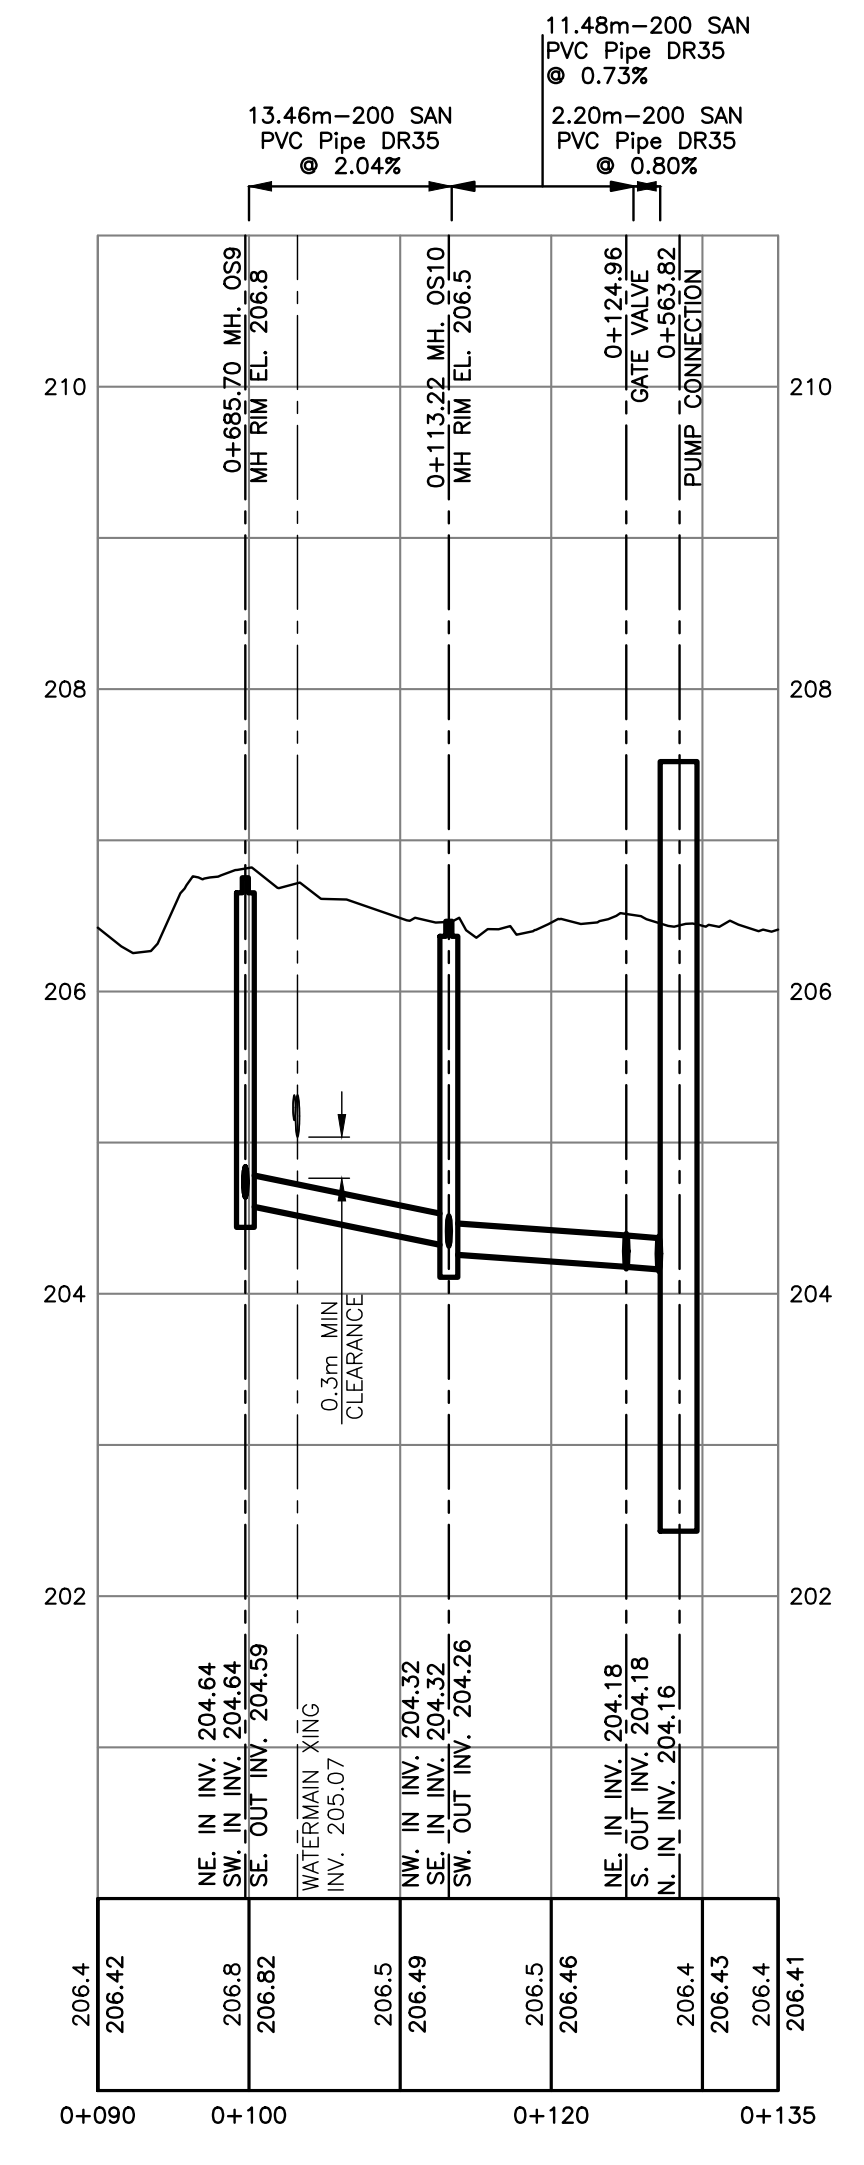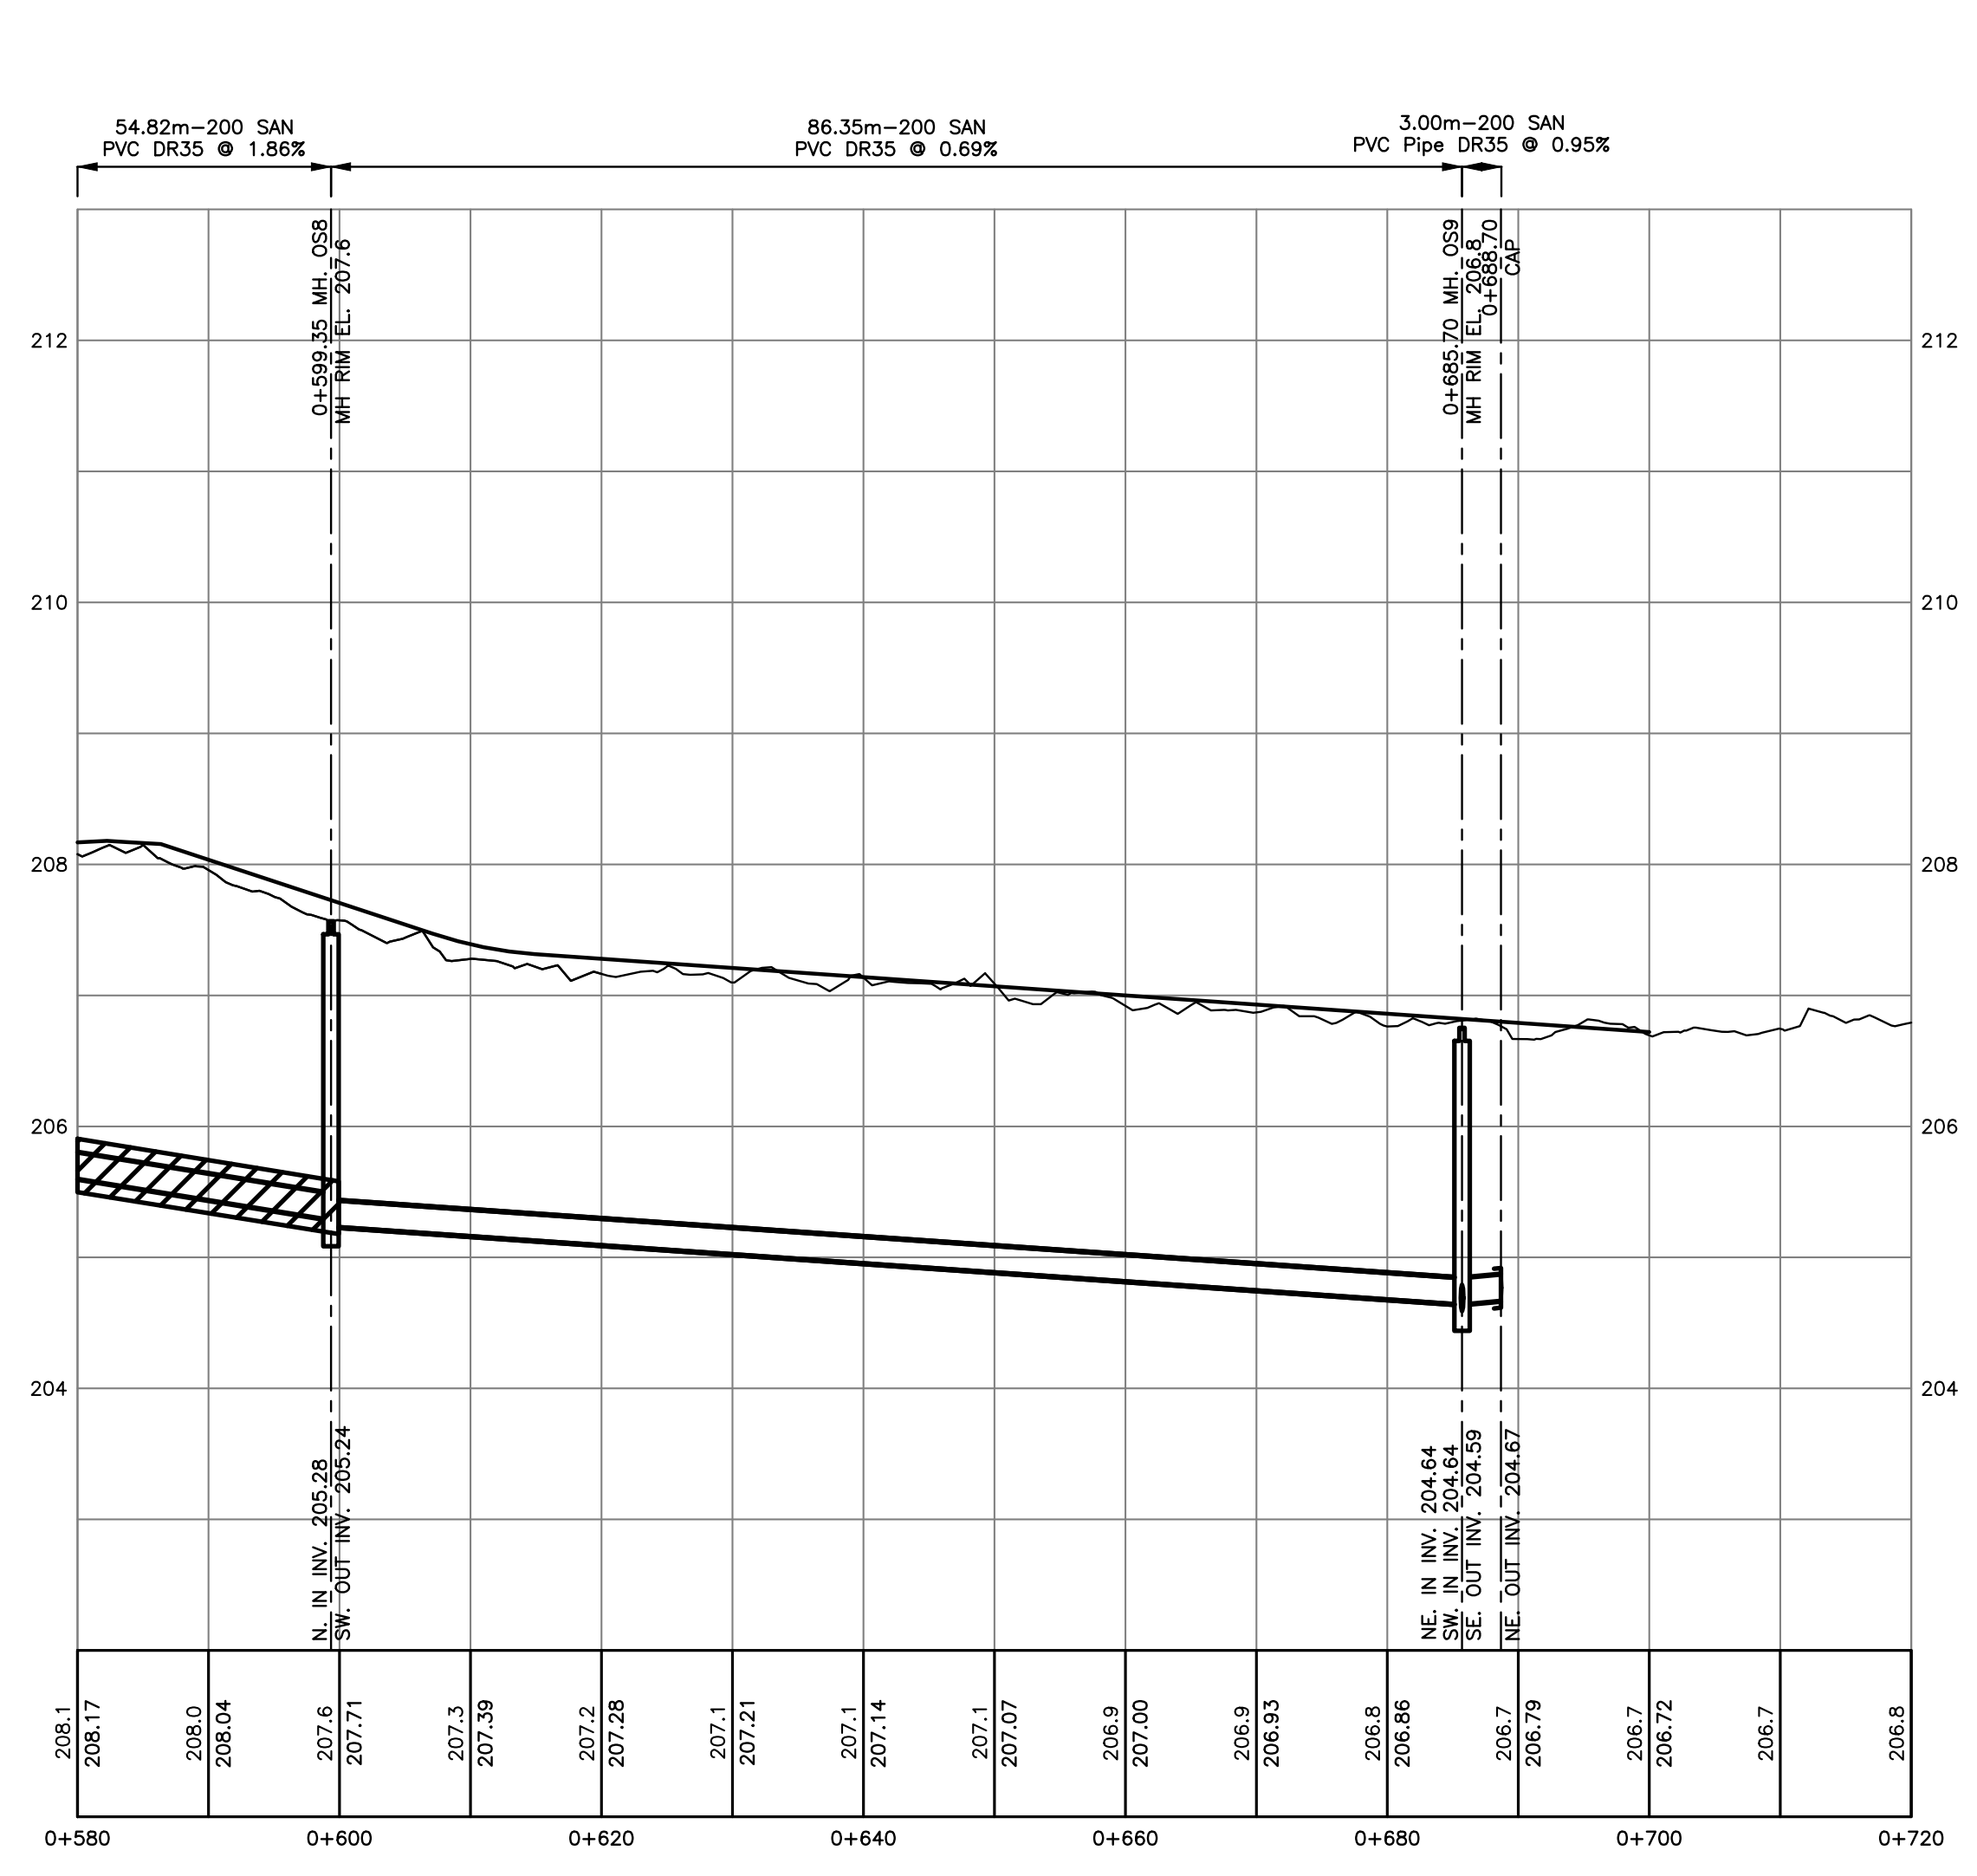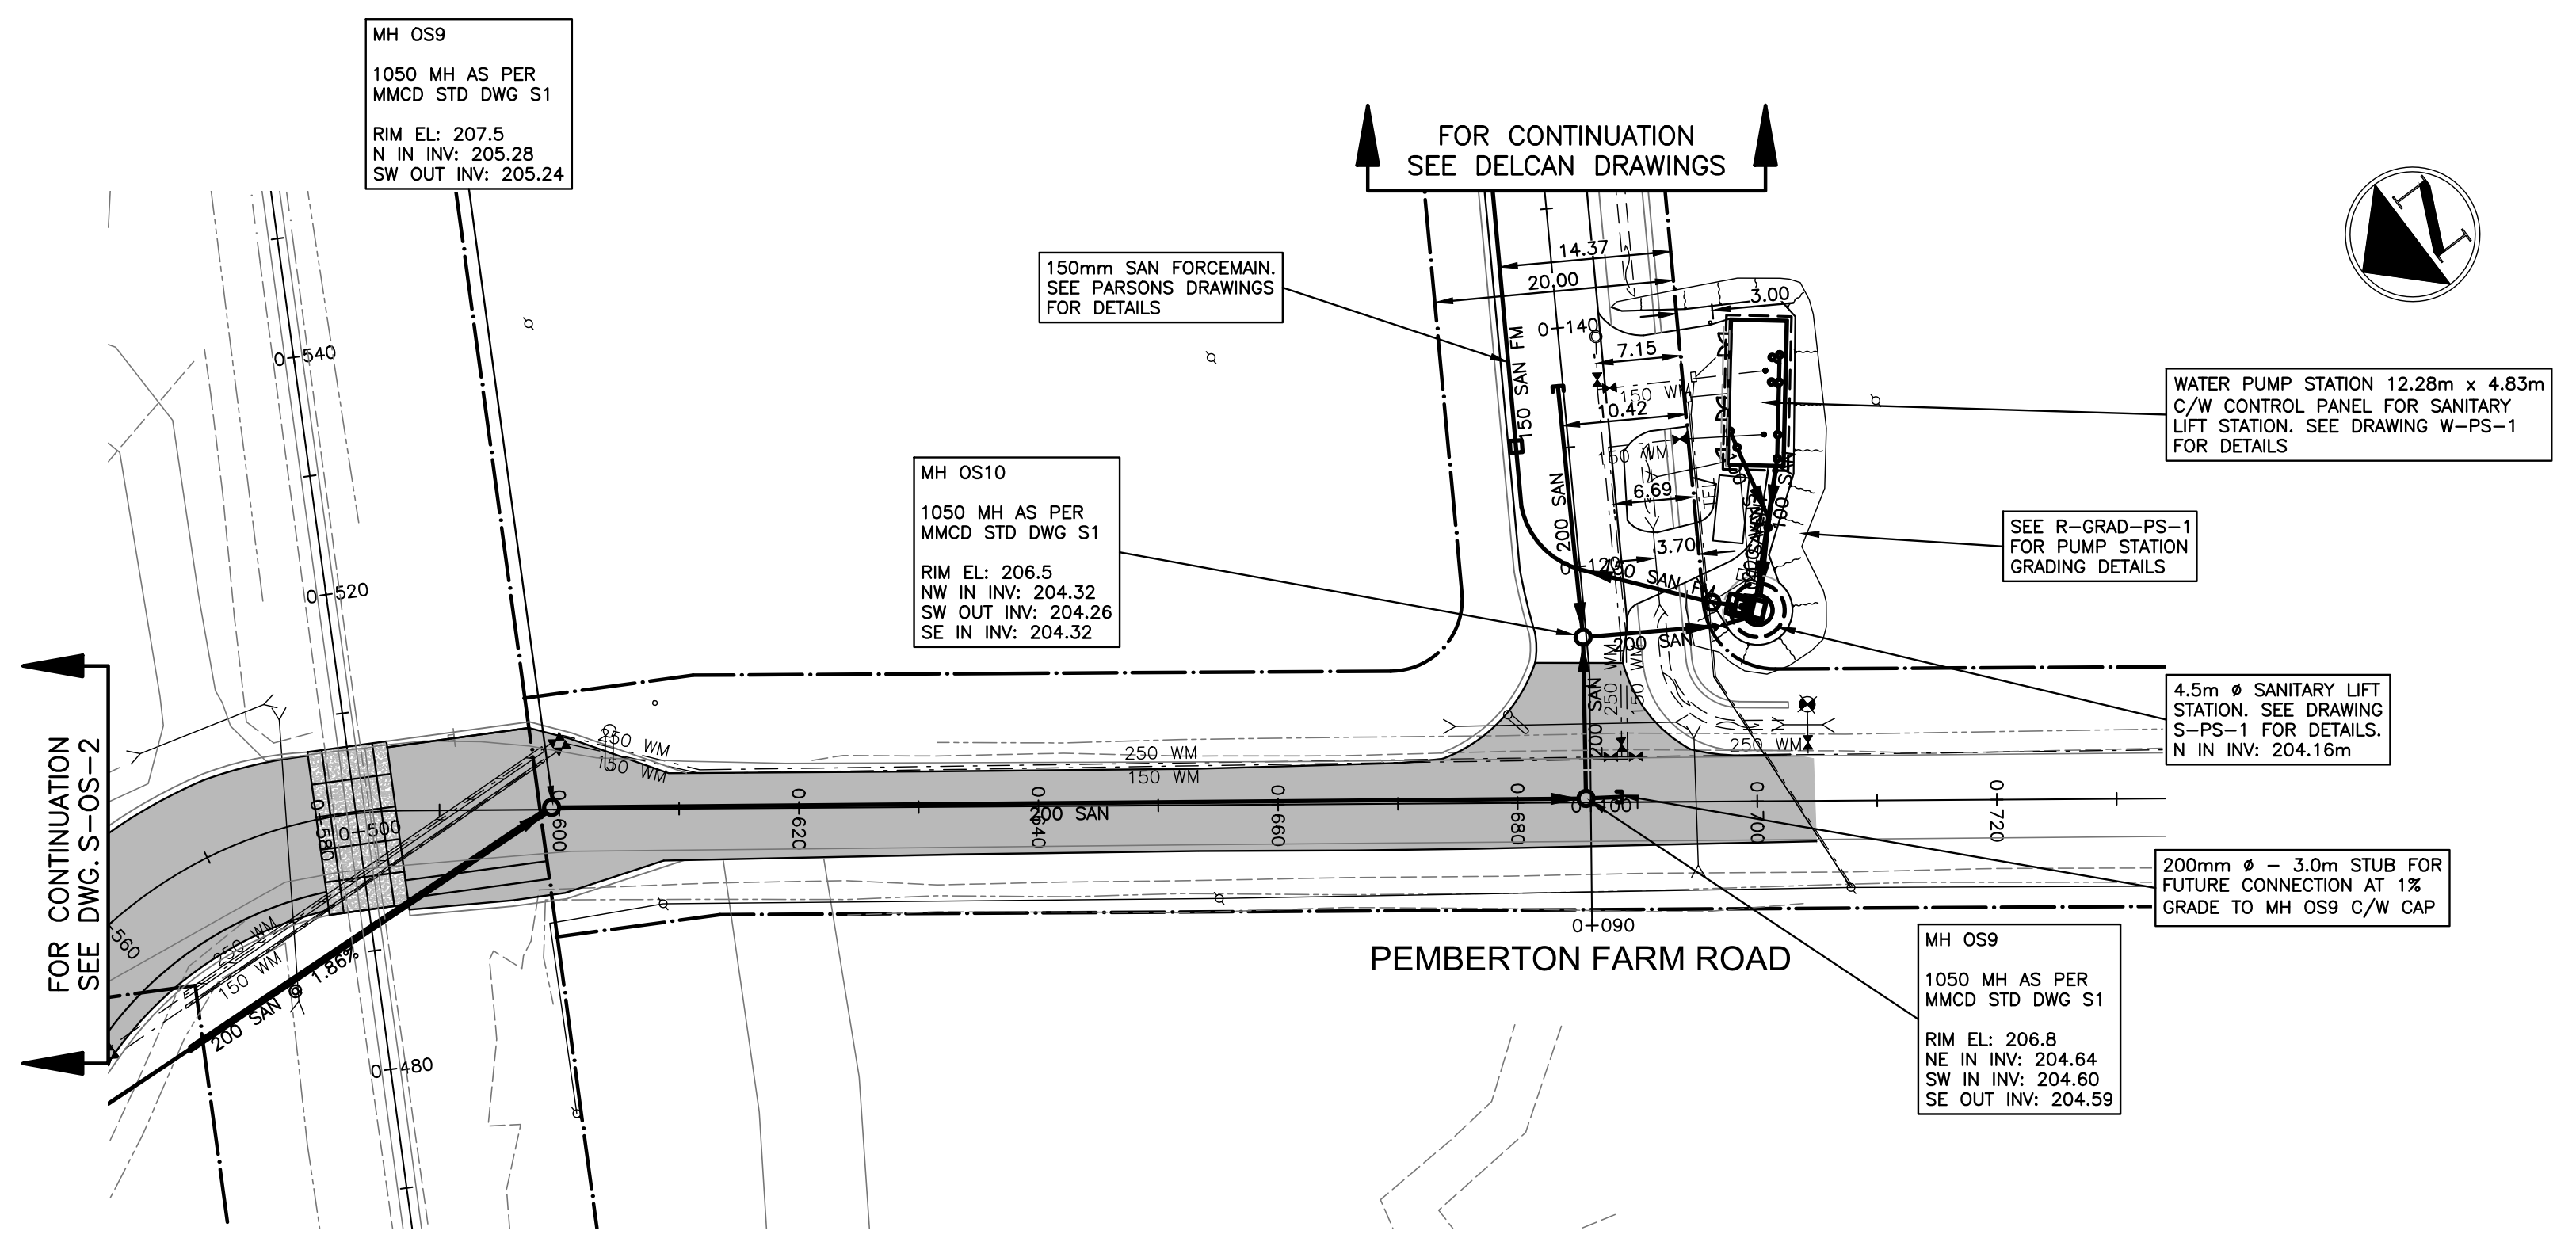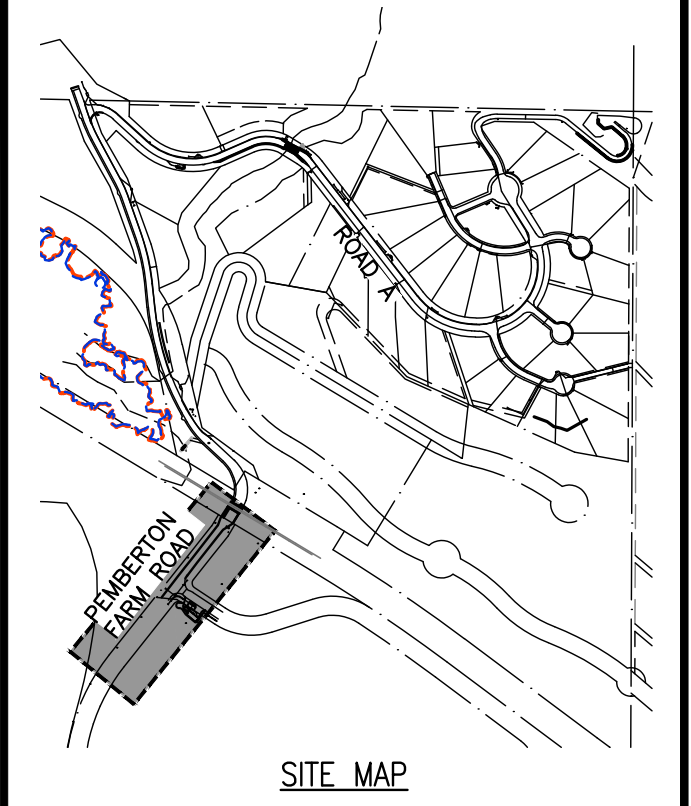

OS9 TO LIFT STATION

DRAWING LEGEND

	EXISTING	PROP.	TO BE REMOVED
LEGAL LINE	---	---	---
EASEMENT	---	---	---
WATERMAIN	---	---	---
SANITARY	---	---	---
STORM	---	---	---
HYDRO	---	---	---
TEL	---	---	---
STREETLIGHT	---	---	---
GAS	---	---	---
FIRE HYDRANT	⊗	⊗	⊗
GATE VALVE	⊗	⊗	⊗
AIR VALVE	⊗	⊗	⊗
REDUCER	⊗	⊗	⊗
INSPECTION CHAMBER	⊗	⊗	⊗
CATCHBASIN (STD/SI)	⊗	⊗	⊗
CAP	⊗	⊗	⊗
MANHOLE	⊗	⊗	⊗
POWER POLE	⊗	⊗	⊗
STREETLIGHT	⊗	⊗	⊗

approved

client

580049 BC LTD.

project

THE RIDGE AT PEMBERTON  
 PHASE 1  
 PEMBERTON, BC

title




SANITARY  
 OFFSITE ROAD (STA 0+600-0+800)

no.	(y/m/d)	revision	chk'd
18	18-02-06	PROJECT RECORDS - OFFSITE	KBH
17	18-02-06	PROJECT RECORDS - PUMP STATION	KBH
16	17-10-17	PROJECT RECORDS OFFSITE	KBH
15	17-05-02	REISSUED FOR CONSTRUCTION PUMP STATION	ZM
14	17-04-13	ISSUED FOR AI #5	AGC
13	17-03-16	PROFILE CLARIFICATION	AGC
12	17-03-07	REISSUED FOR CONSTRUCTION OFFSITE	AGC
11	17-02-27	REISSUED FOR VOP APPROVAL	AGC

engineer of record	scale	hor: 1:500	vert: 1:50
K.B.H.			
designed by	N.G.B.	file no.	16159
drawn by	A.A.P.	drawing no.	S-OS-3
date	2016-05-13		

COPYRIGHT RESERVED. THIS DRAWING AND DESIGN ARE, AND AT ALL TIMES REMAIN THE EXCLUSIVE PROPERTY OF CREUS ENGINEERING LTD. AND CANNOT BE USED, REPRODUCED OR DISTRIBUTED WITHOUT WRITTEN CONSENT.  
 © 2016 CREUS ENGINEERING LTD.



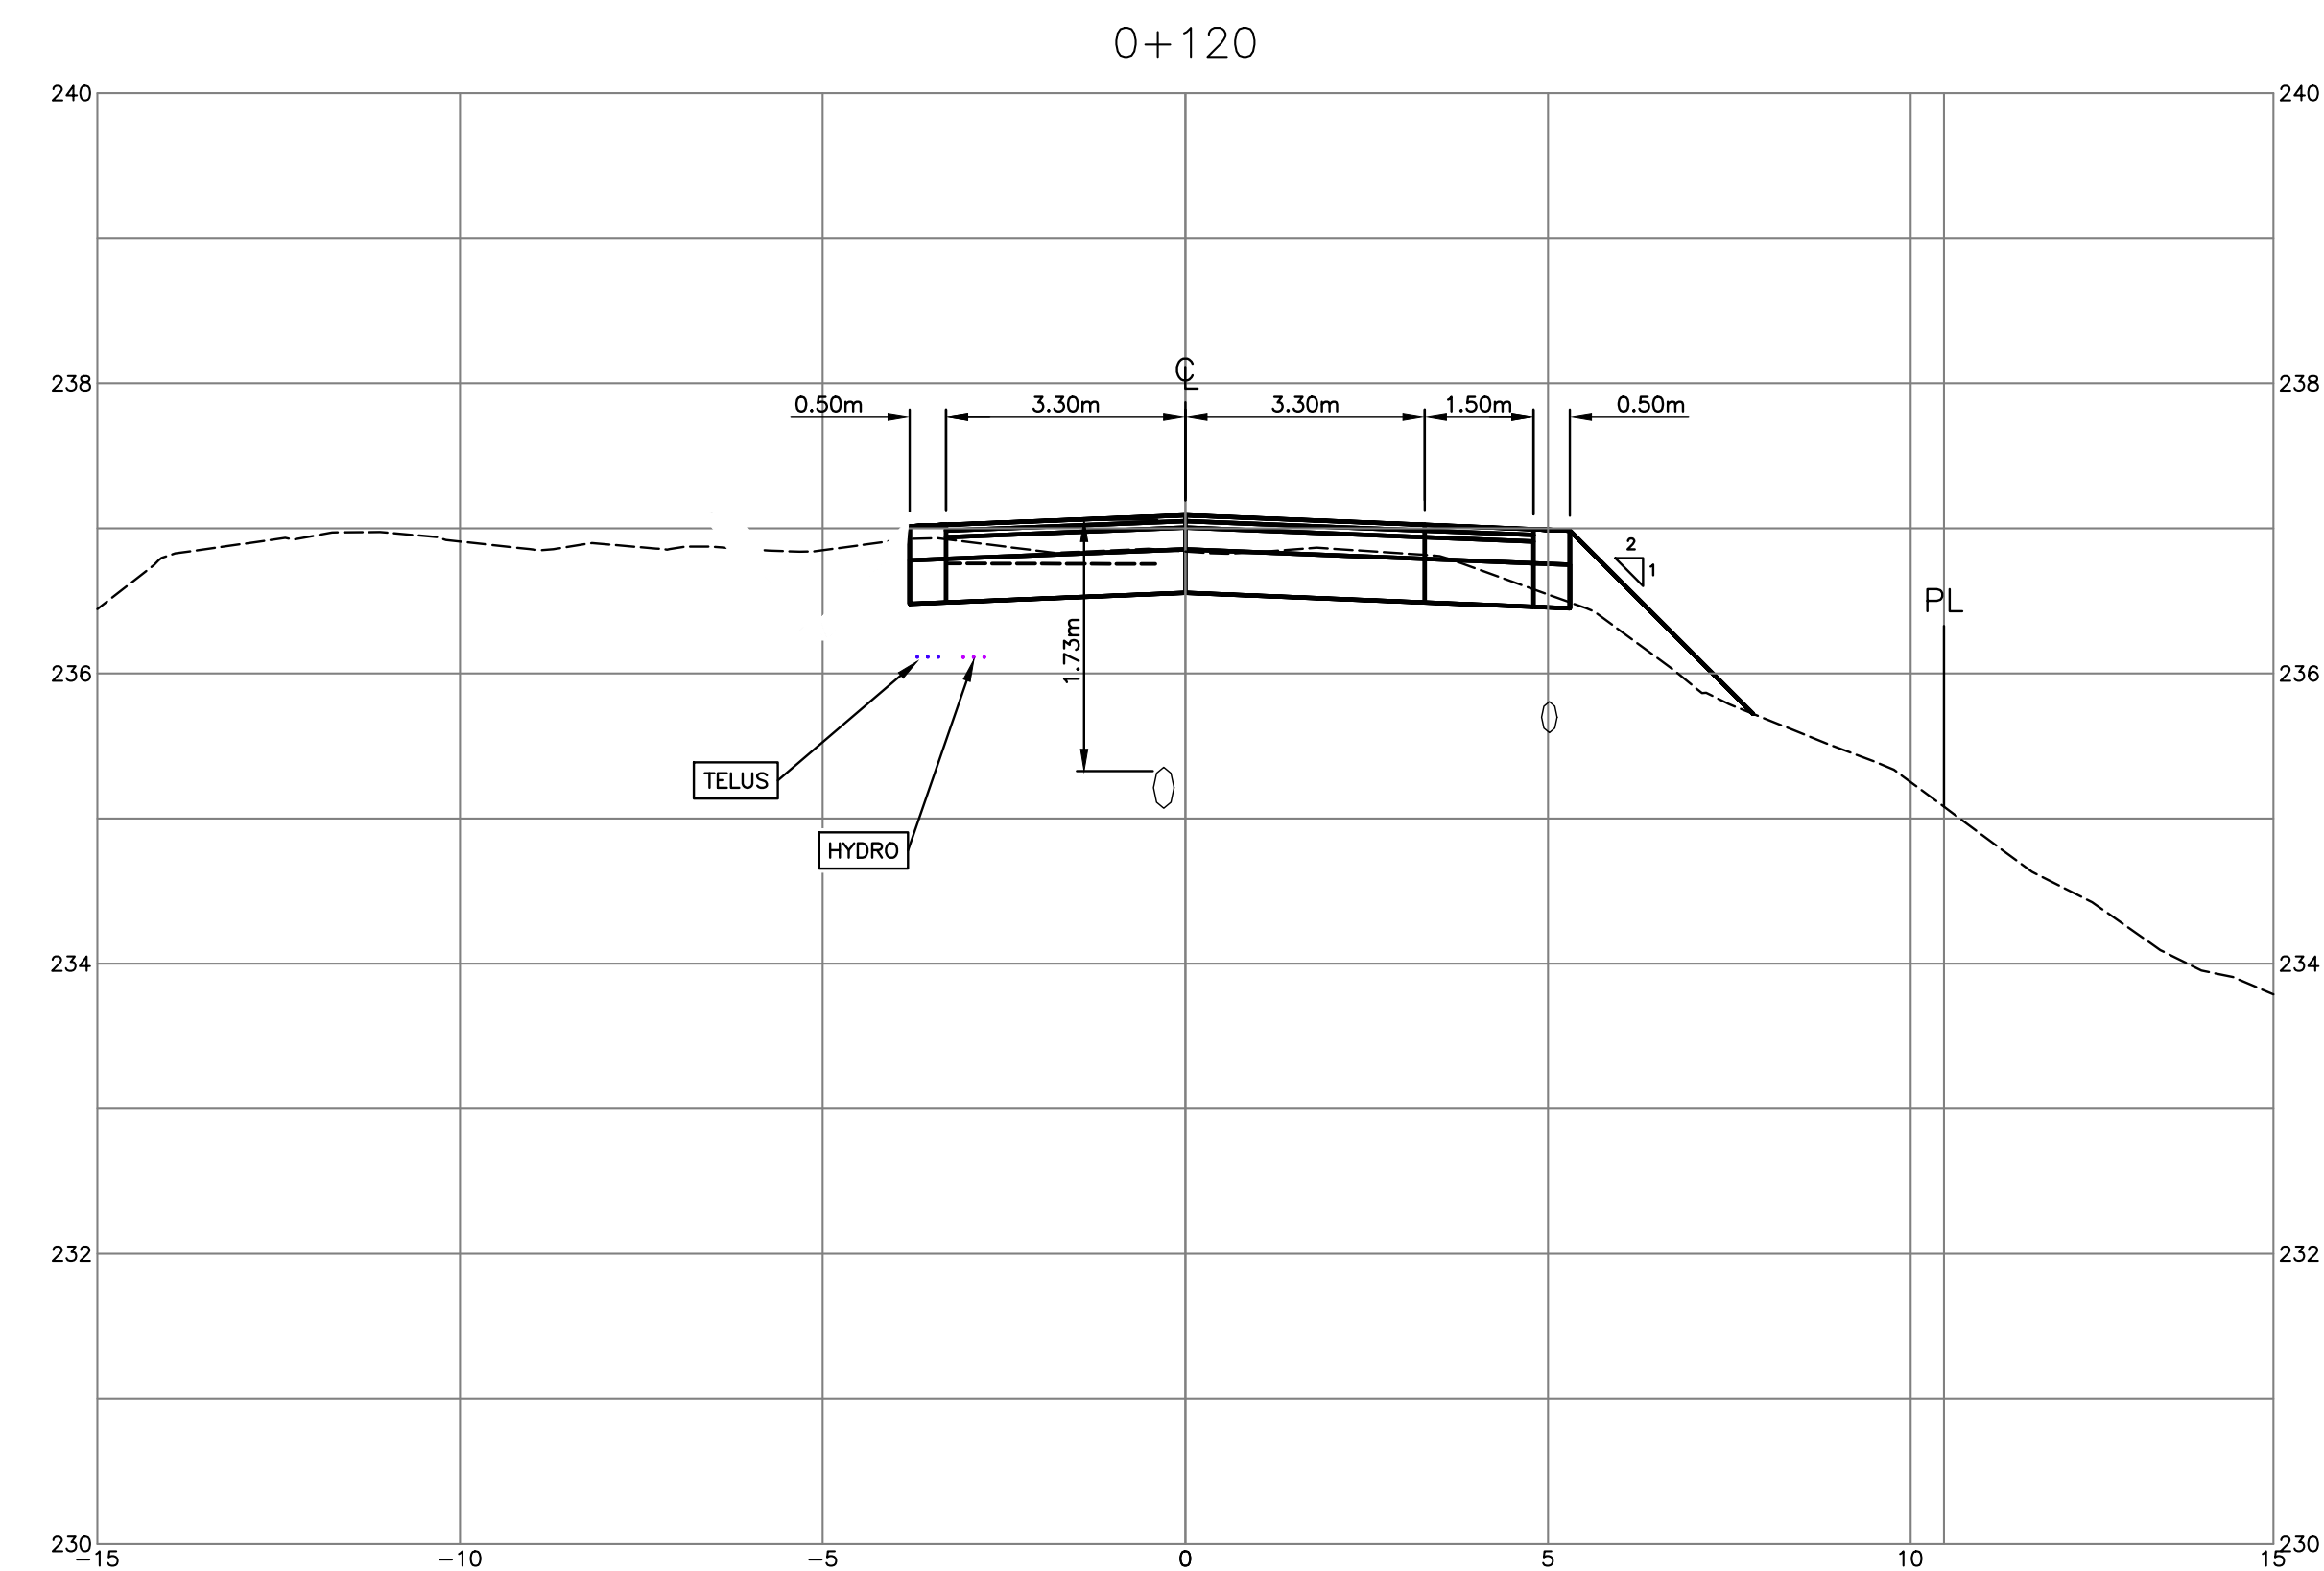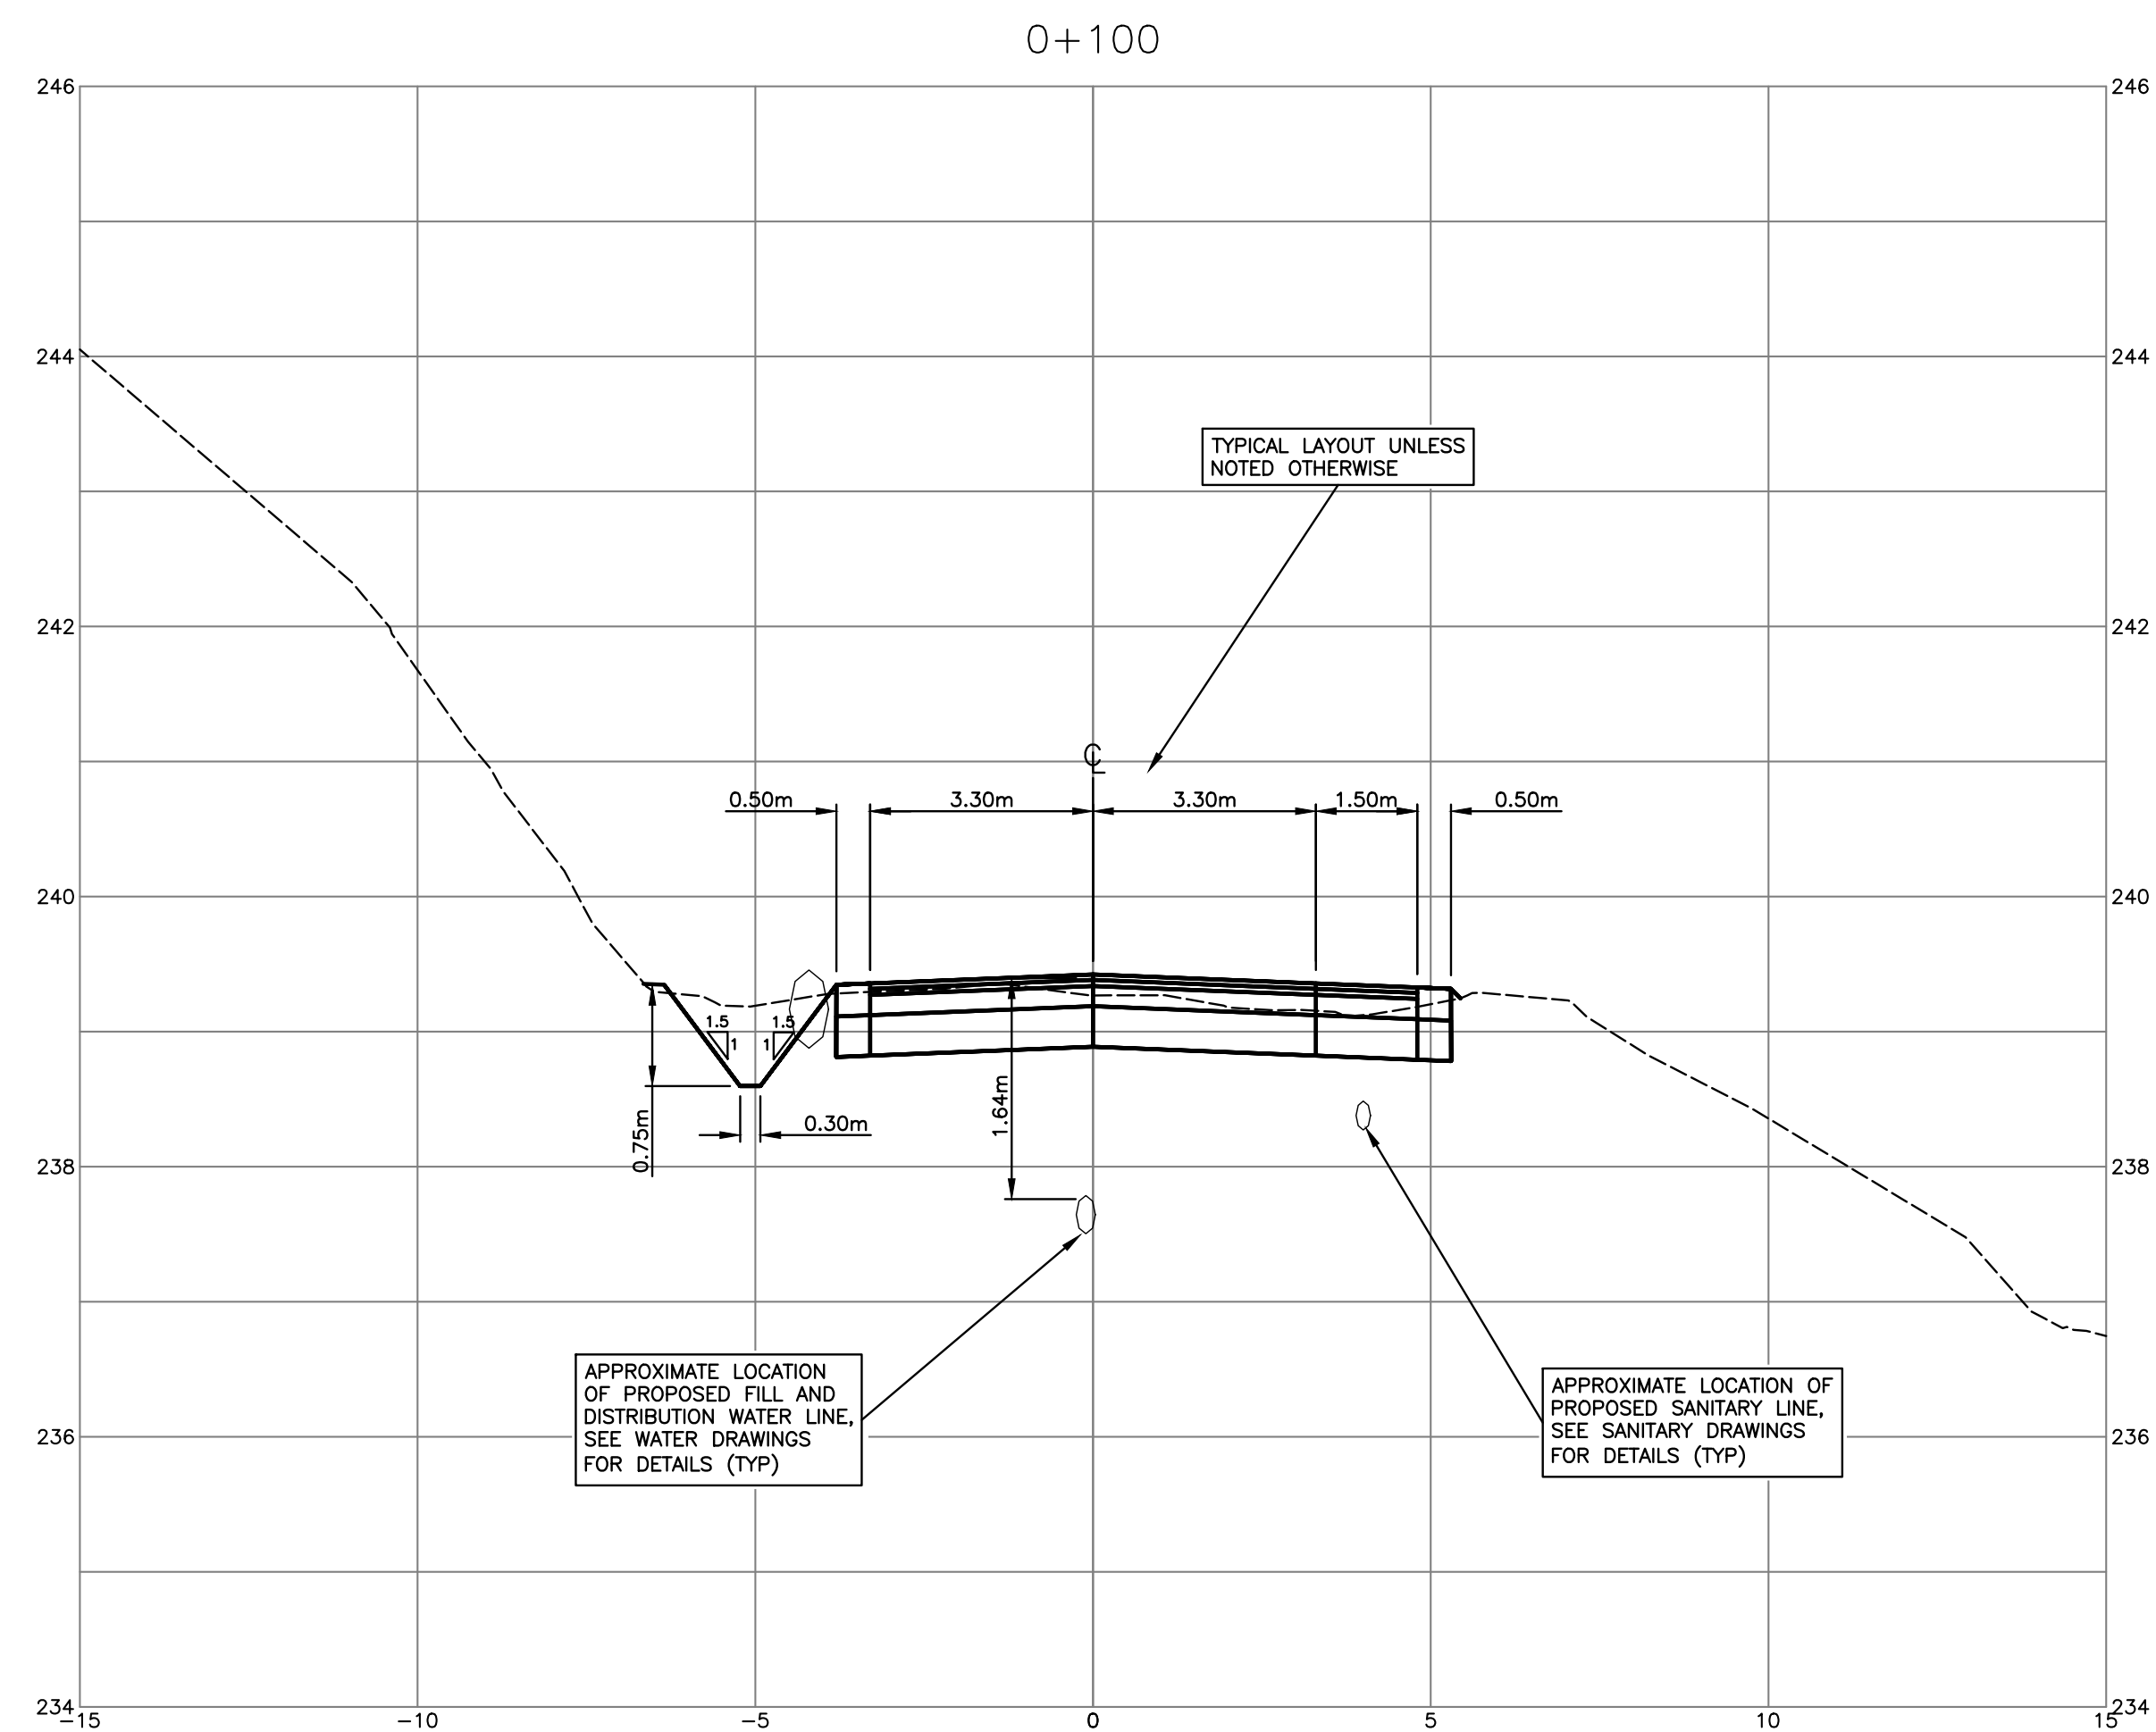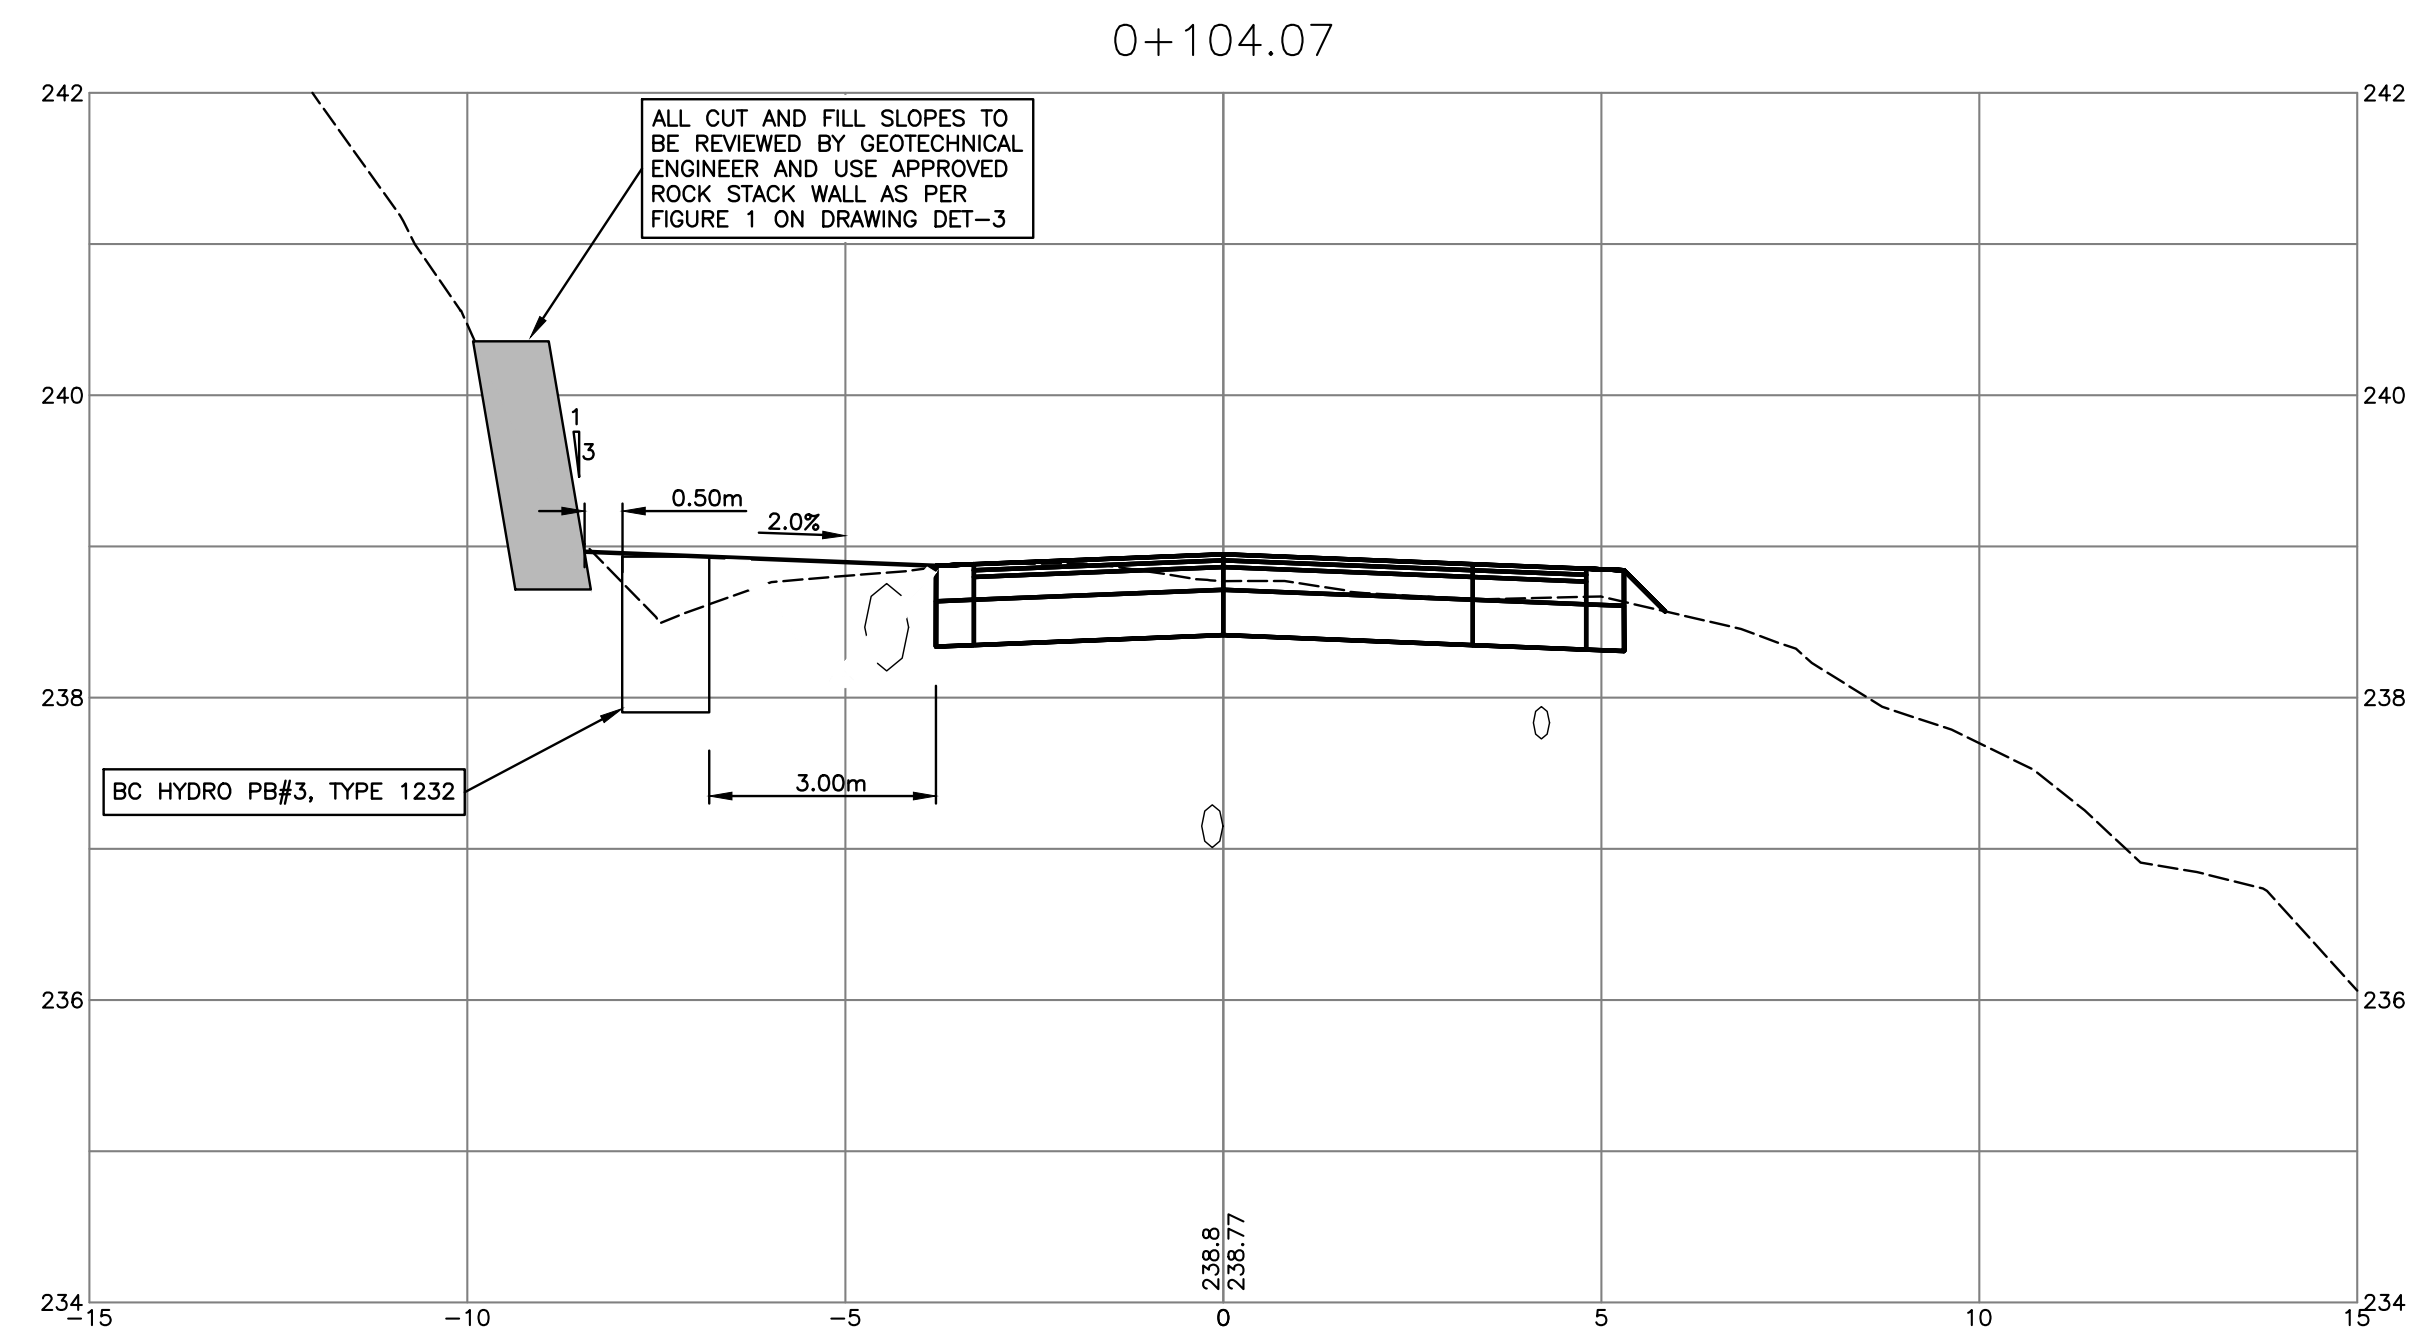

### DRAWING LEGEND

	EXISTING	PROP.	TO BE REMOVED
LEGAL LINE	---	---	---
EASMENT	---	---	---
WATERMAIN	---	---	---
SANITARY	---	---	---
STORM	---	---	---
HYDRO	---	---	---
TEL	---	---	---
STREETLIGHT	---	---	---
GAS	---	---	---
	EXISTING	PROP.	TO BE REMOVED
FIRE HYDRANT	⊗	⊗	⊗
GATE VALVE	⊗	⊗	⊗
AIR VALVE	⊗	⊗	⊗
REDUCER	⊗	⊗	⊗
INSPECTION CHAMBER	⊗	⊗	⊗
CATCHBASIN (STD/SI)	⊗	⊗	⊗
CAP	⊗	⊗	⊗
MANHOLE	⊗	⊗	⊗
POWER POLE	⊗	⊗	⊗
STREETLIGHT	⊗	⊗	⊗

approved

client

580049 BC LTD.

project  
 THE RIDGE AT PEMBERTON  
 PHASE 1  
 PEMBERTON, BC

### CROSS SECTIONS OFFSITE ROAD (STA 0+100-0+120)

no.	(y/m/d)	revision	chk'd
12	18-02-06	PROJECT RECORDS OFFSITE	KBH
11	17-10-17	PROJECT RECORDS OFFSITE	KBH
10	17-09-19	UPDATED OFFSETS	KBH
9	17-08-15	UPDATE WITH HYDRO & TELUS	KBH
8	17-03-07	REISSUED FOR CONSTRUCTION OFFSITE	KBH
7	16-11-09	REISSUED FOR CONSTRUCTION OFFSITE	KBH
6	16-10-26	IFC OFFSITE FINAL COMMENTS	KBH
5	16-10-13	ISSUED FOR CONSTRUCTION OFFSITE	KBH

engineer of record	K.B.H.	scales	hor: 1:100	vert: 1:50
designed by	N.G.B.	file no.	16159	
drawn by	A.A.P.	drawing no.	X-OS-1	
date	2016-05-13			

COPYRIGHT RESERVED. THIS DRAWING AND DESIGN ARE, AND AT ALL TIMES REMAIN THE EXCLUSIVE PROPERTY OF CREUS ENGINEERING LTD. AND CANNOT BE USED, REPRODUCED OR DISTRIBUTED WITHOUT WRITTEN CONSENT.  
 © 2016 CREUS ENGINEERING LTD.







### DRAWING LEGEND

	EXISTING	PROP.	TO BE REMOVED
LEGAL LINE	---	---	---
EASMENT	---	---	---
WATERMAIN	---	---	---
SANITARY	---	---	---
STORM	---	---	---
HYDRO	---	---	---
TEL.	---	---	---
STREETLIGHT	---	---	---
GAS	---	---	---
	EXISTING	PROP.	TO BE REMOVED
FIRE HYDRANT	⊗	⊗	⊗
GATE VALVE	⊗	⊗	⊗
AIR VALVE	⊗	⊗	⊗
REDUCER	⊗	⊗	⊗
INSPECTION CHAMBER	⊗	⊗	⊗
CATCHBASIN (STD/SI)	⊗	⊗	⊗
CAP	⊗	⊗	⊗
MANHOLE	⊗	⊗	⊗
POWER POLE	⊗	⊗	⊗
STREETLIGHT	⊗	⊗	⊗

approved

client

580049 BC LTD.

project

THE RIDGE AT PEMBERTON  
 PHASE 1  
 PEMBERTON, BC



title

CROSS SECTIONS  
 OFFSITE ROAD (STA 0+180-0+200)




no.	(y/m/d)	revision	ch/d
11	18-02-06	PROJECT RECORDS OFFSITE	KBH
10	17-10-17	PROJECT RECORDS OFFSITE	KBH
9	17-09-19	UPDATED OFFSETS	KBH
8	17-08-15	UPDATE WITH HYDRO & TELLUS	KBH
7	17-03-07	REISSUED FOR CONSTRUCTION OFFSITE	KBH
6	16-11-09	REISSUED FOR CONSTRUCTION OFFSITE	KBH
5	16-10-26	IFC OFFSITE FINAL COMMENTS	KBH
4	16-10-13	ISSUED FOR CONSTRUCTION OFFSITE	KBH

COPYRIGHT RESERVED. THIS DRAWING AND DESIGN ARE, AND AT ALL TIMES REMAIN THE EXCLUSIVE PROPERTY OF CREUS ENGINEERING LTD. AND CANNOT BE USED, REPRODUCED OR DISTRIBUTED WITHOUT WRITTEN CONSENT.  
 © 2018 CREUS ENGINEERING LTD.

engineer of record: K.B.H. scales: hor: 1:100 vert: 1:50  
 designed by: N.G.B. file no.: 16159  
 drawn by: A.A.P. drawing no.: X-OS-3  
 date: 2016-05-13

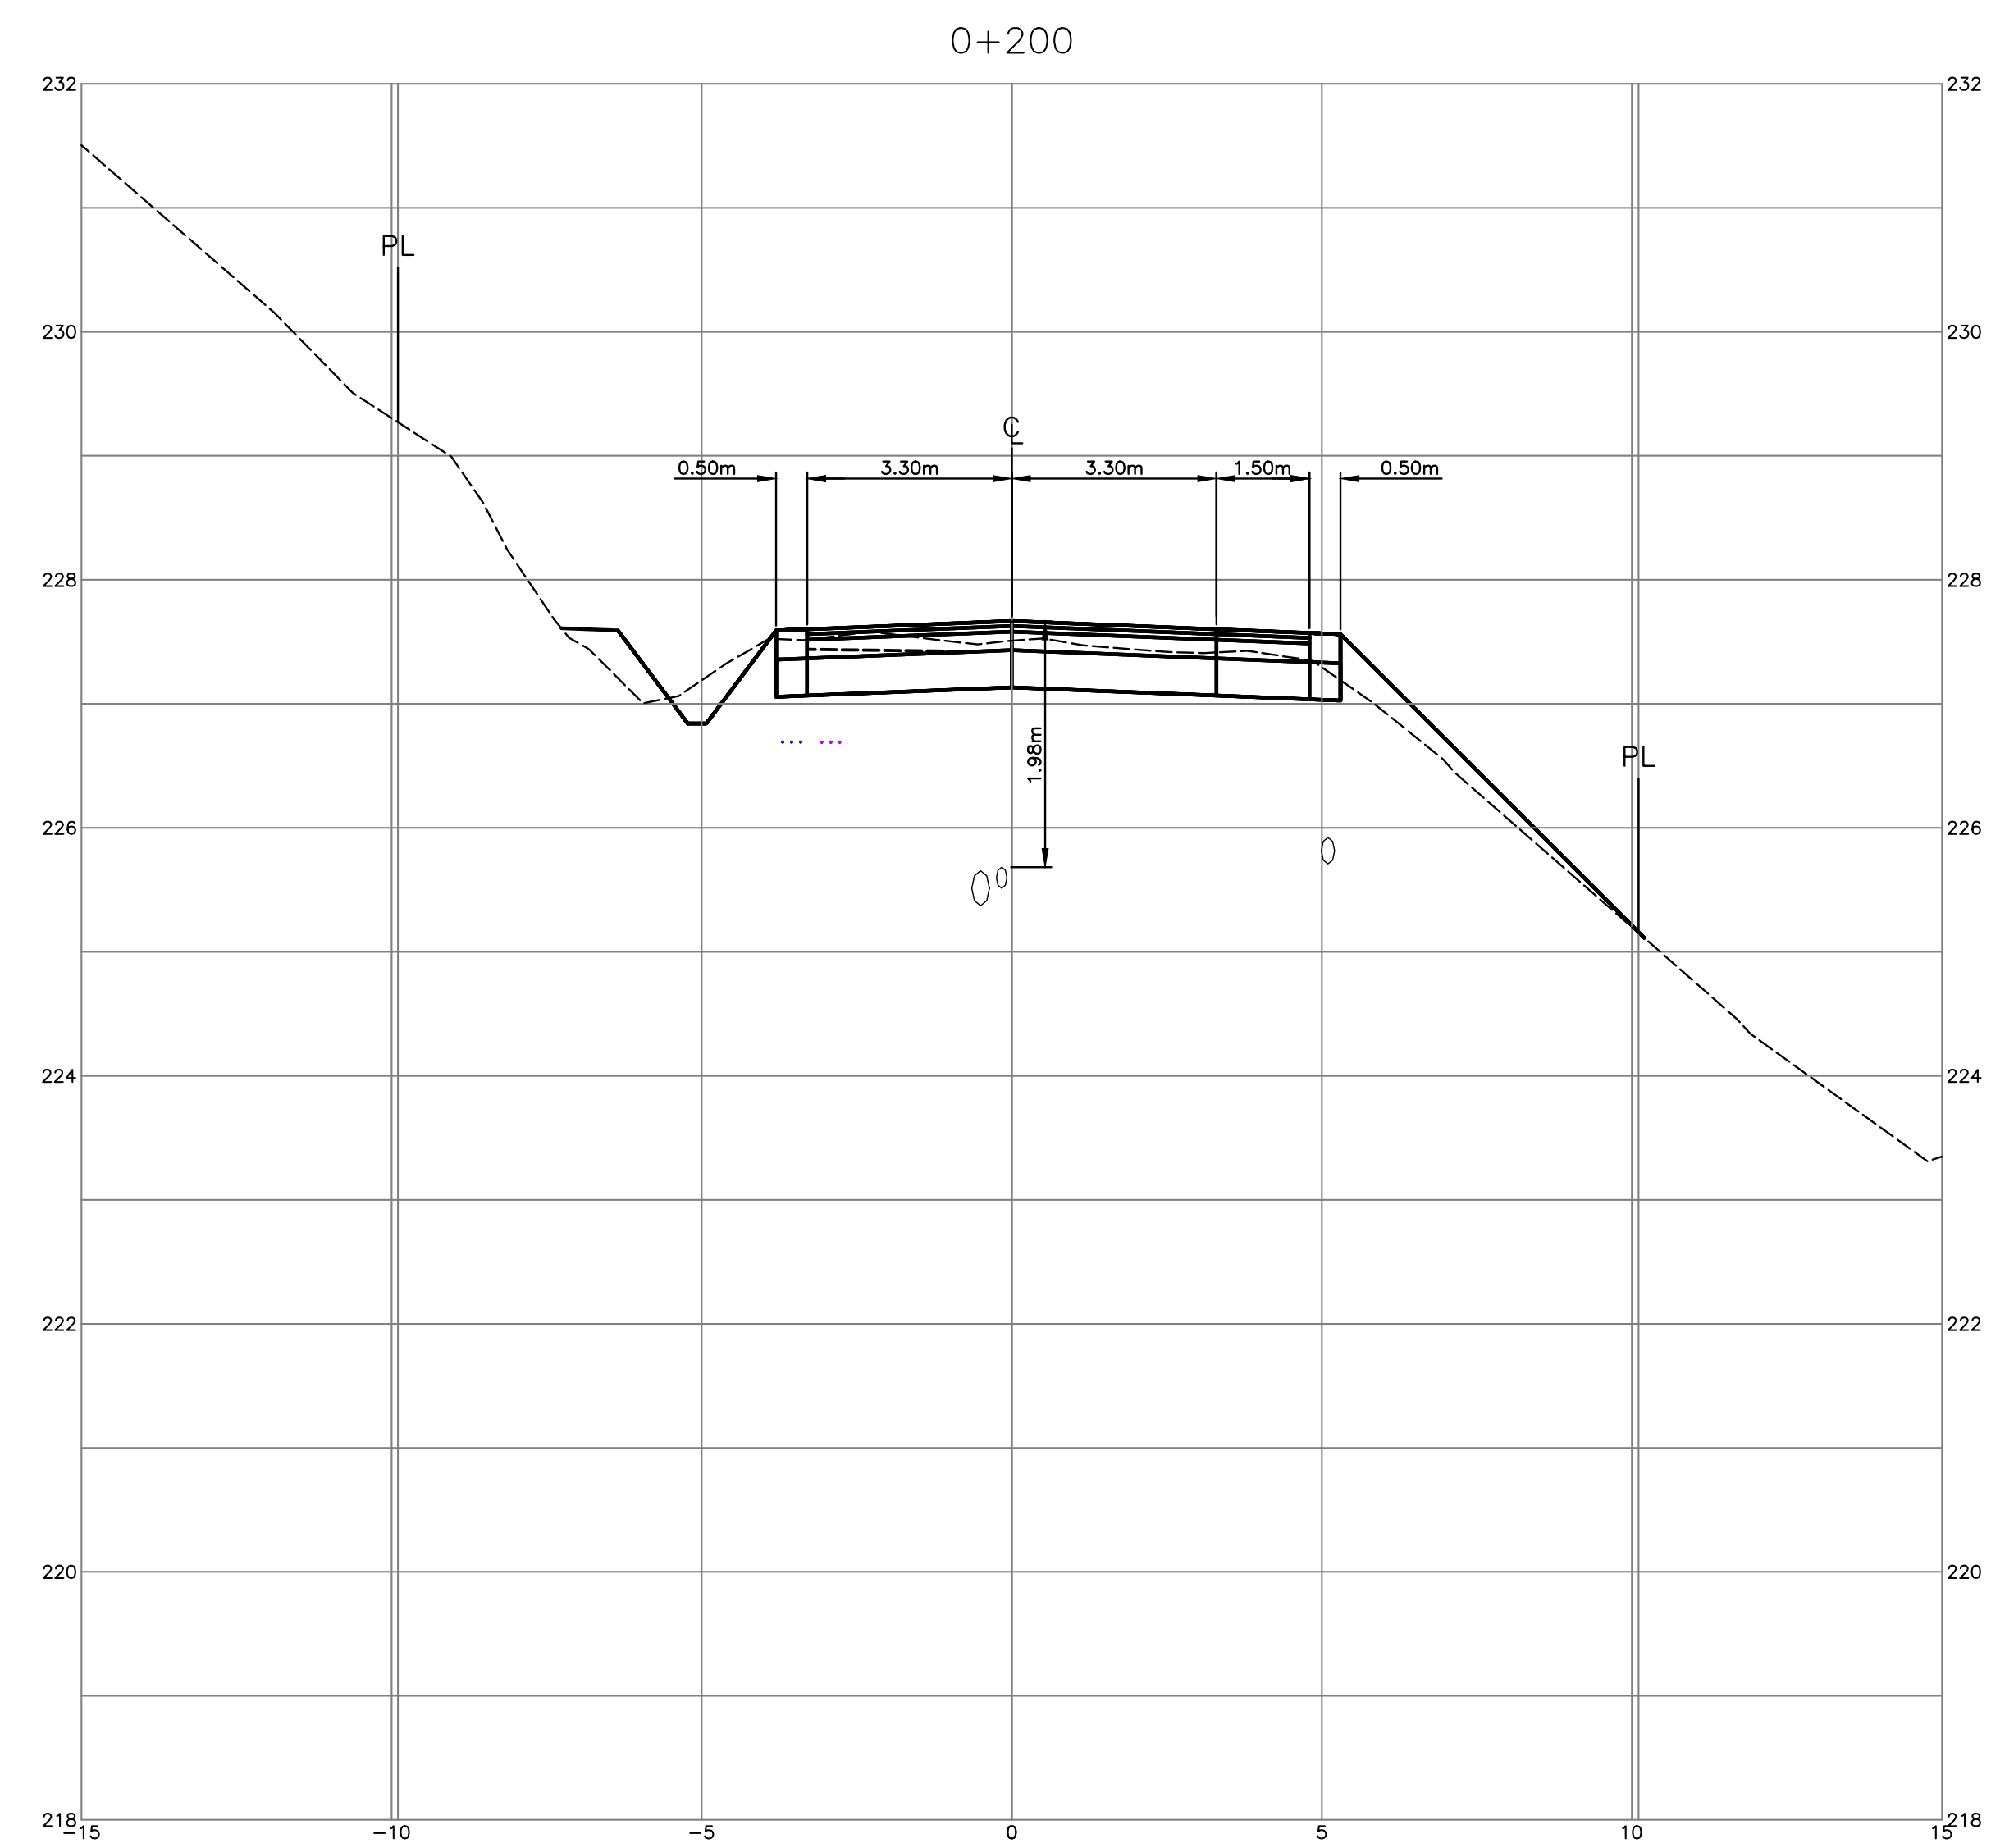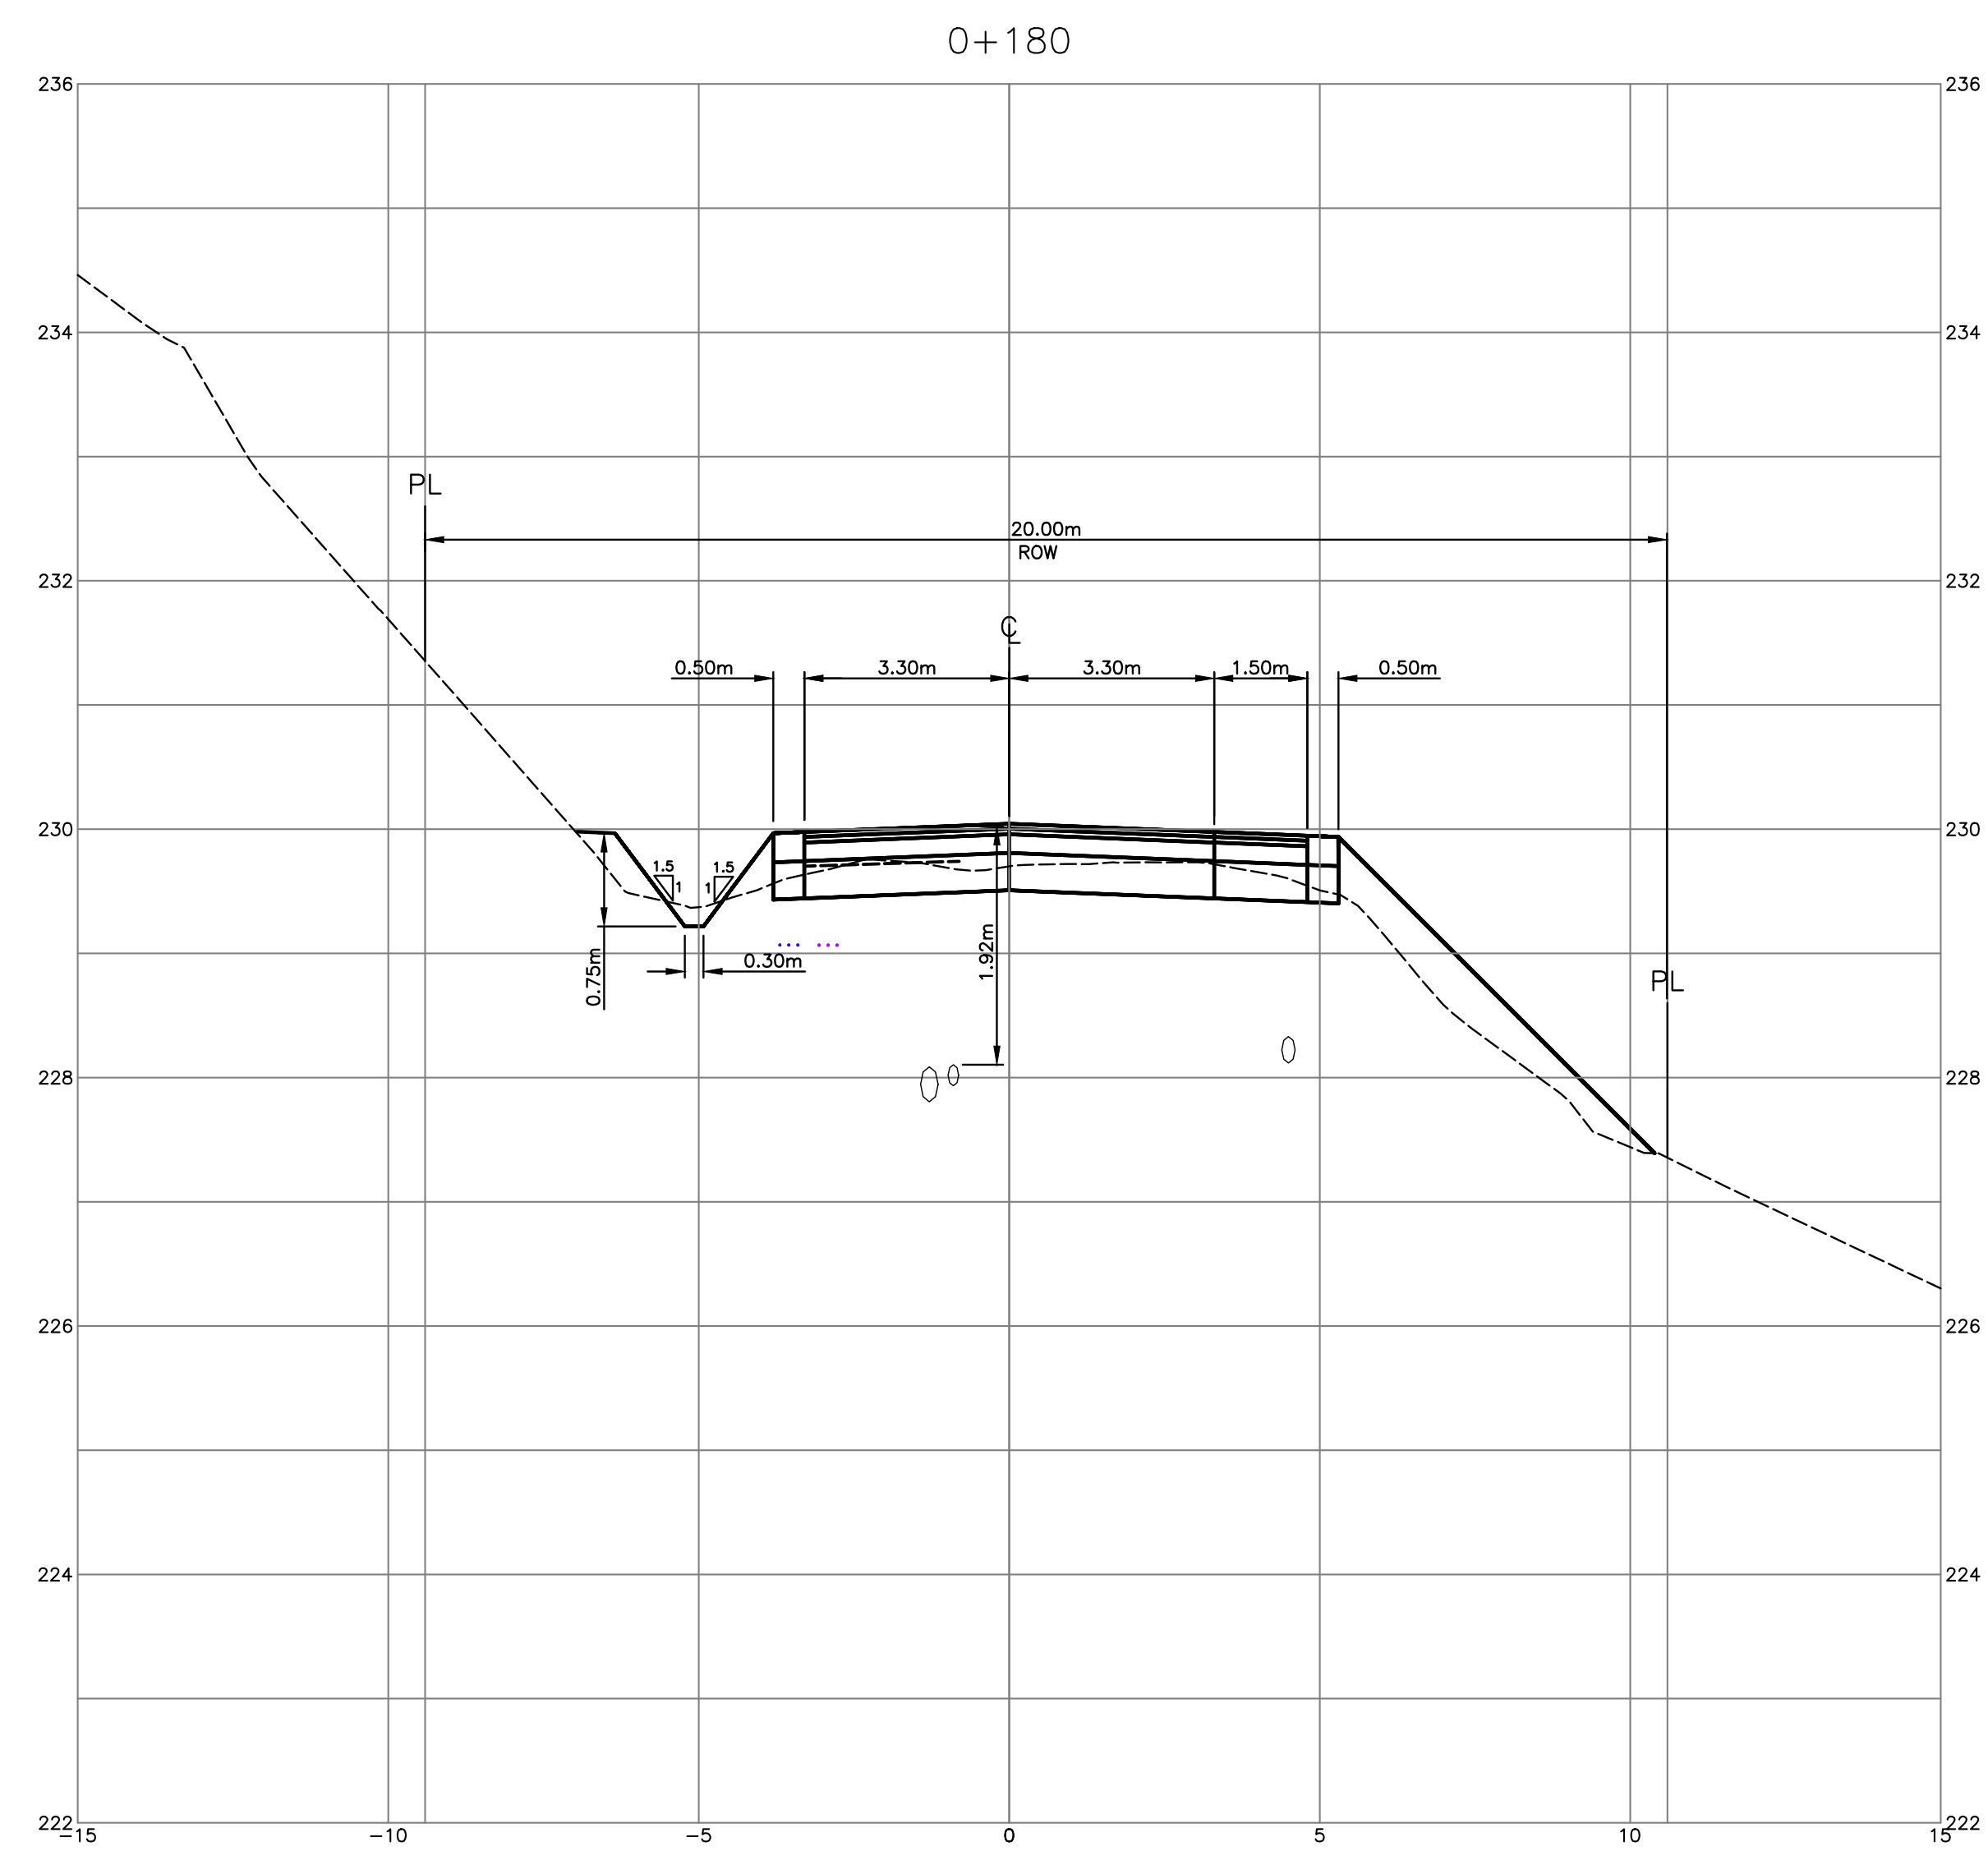



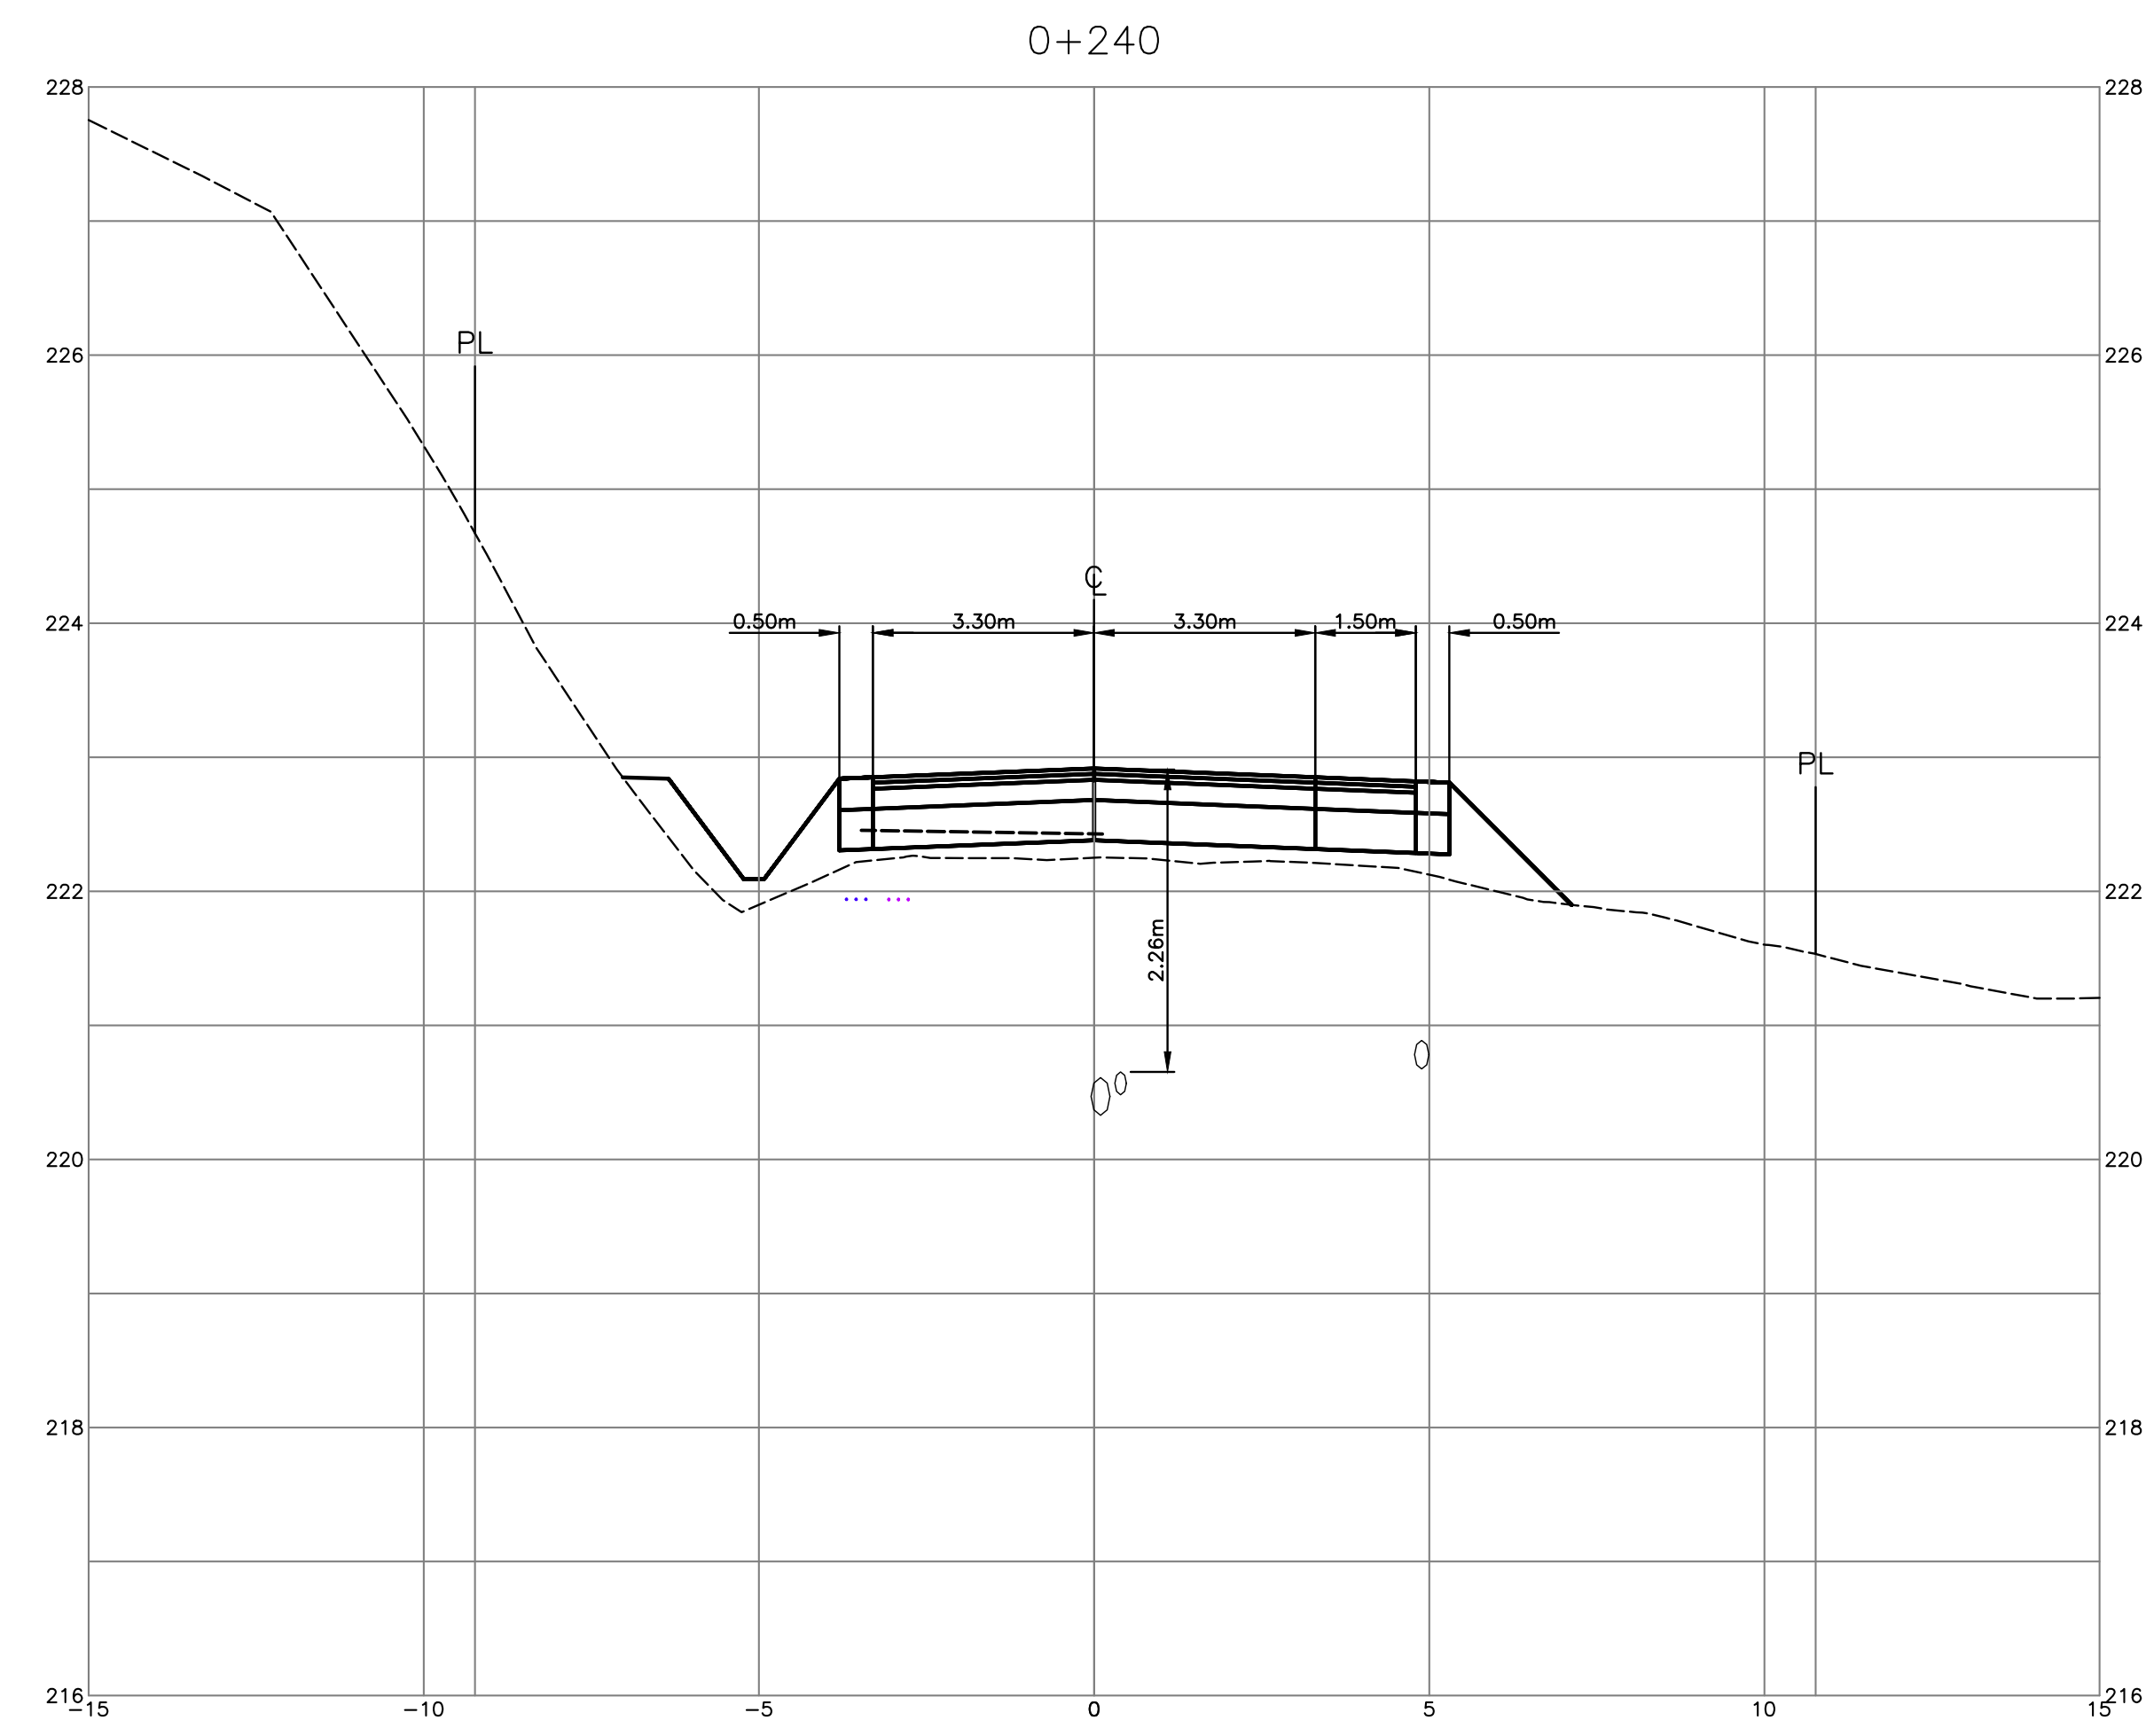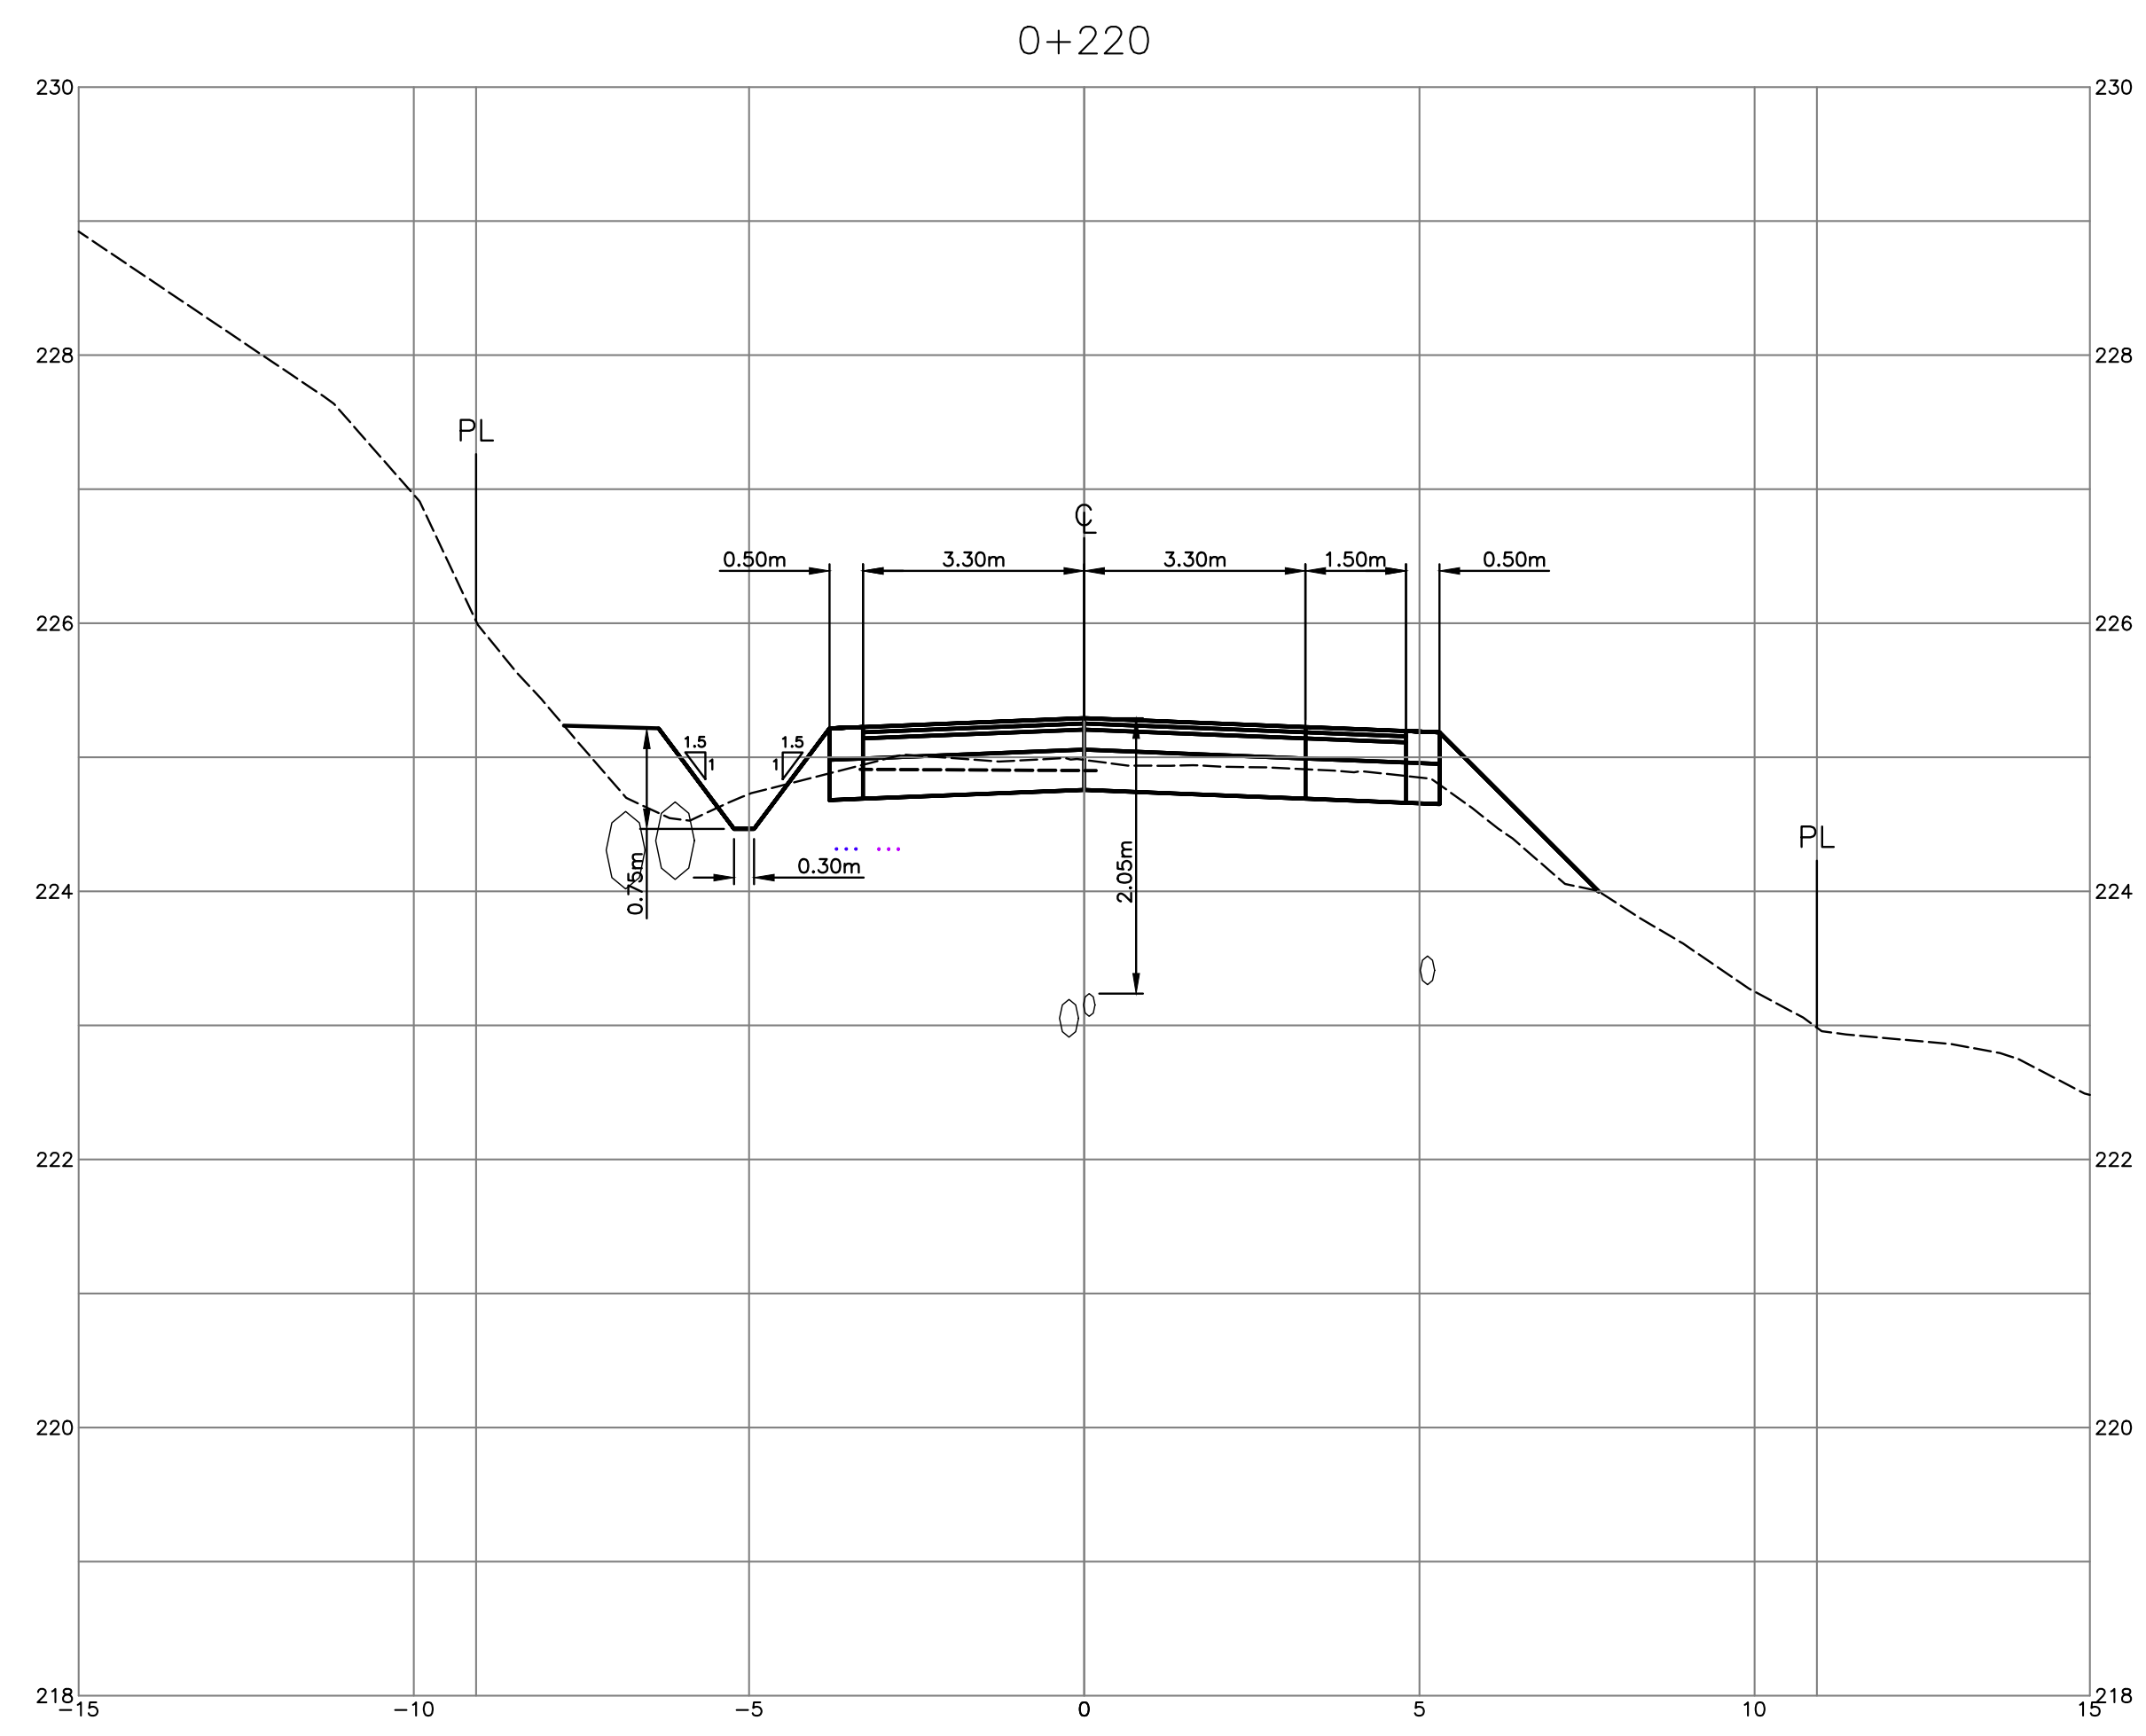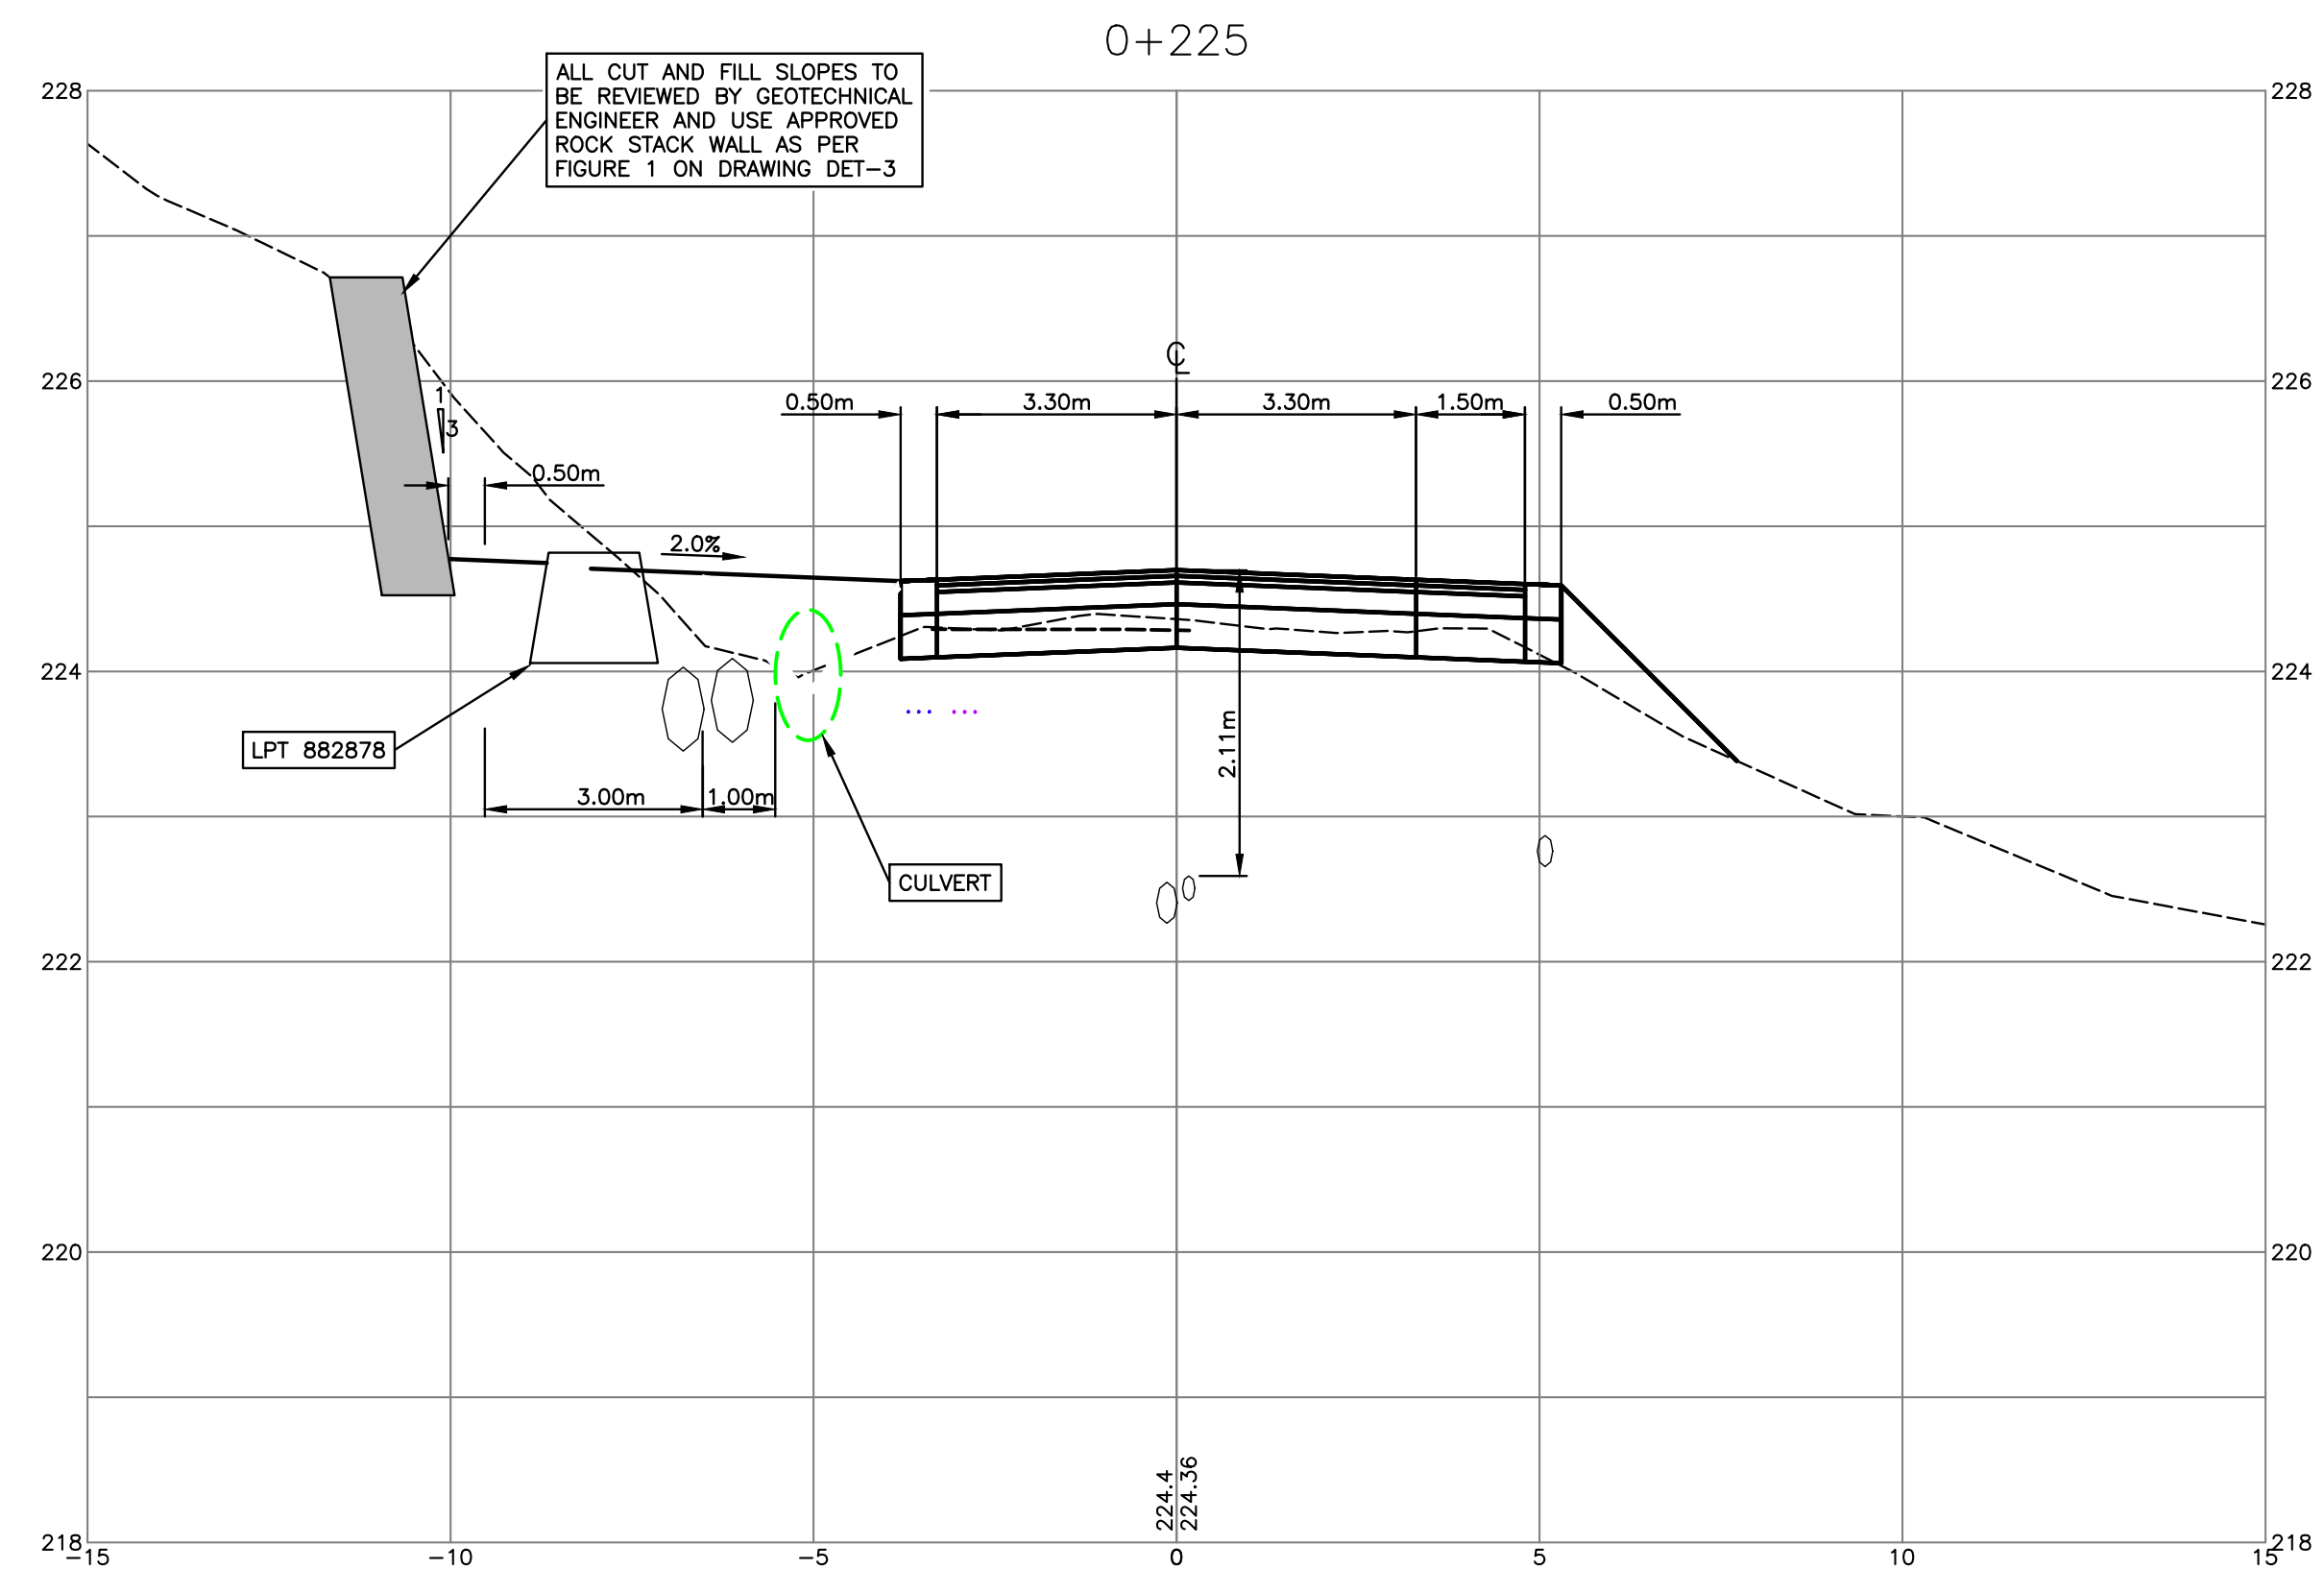

### DRAWING LEGEND

	EXISTING	PROP.	TO BE REMOVED
LEGAL LINE	---	---	---
EASMENT	---	---	---
WATERMAIN	---	---	---
SANITARY	---	---	---
STORM	---	---	---
HYDRO	---	---	---
TEL	---	---	---
STREETLIGHT	---	---	---
GAS	---	---	---

	EXISTING	PROP.	TO BE REMOVED
FIRE HYDRANT	⊗	⊗	⊗
GATE VALVE	⊕	⊕	⊕
AIR VALVE	⊙	⊙	⊙
REDUCER	⊖	⊖	⊖
INSPECTION CHAMBER	⊕	⊕	⊕
CATCHBASIN (STD/SI)	⊕	⊕	⊕
CAP	⊕	⊕	⊕
MANHOLE	⊕	⊕	⊕
POWER POLE	⊕	⊕	⊕
STREETLIGHT	⊕	⊕	⊕

approved

client

580049 BC LTD.

project

THE RIDGE AT PEMBERTON  
 PHASE 1  
 PEMBERTON, BC

title

CROSS SECTIONS  
 OFFSITE ROAD (STA 0+220-0+240)

no.	(y/m/d)	revision	chk'd
10	18-02-06	PROJECT RECORDS OFFSITE	KBH
9	17-10-17	PROJECT RECORDS OFFSITE	KBH
8	17-08-15	UPDATE WITH HYDRO & TELUS	KBH
7	17-03-07	REISSUED FOR CONSTRUCTION OFFSITE	KBH
6	16-11-09	REISSUED FOR CONSTRUCTION OFFSITE	KBH
5	16-10-26	IFC OFFSITE FINAL COMMENTS	KBH
4	16-10-13	ISSUED FOR CONSTRUCTION OFFSITE	KBH
3	16-09-19	ISSUED FOR VOP FINAL COMMENTS	KBH

copyright reserved. THIS DRAWING AND DESIGN ARE, AND AT ALL TIMES REMAIN THE EXCLUSIVE PROPERTY OF CREUS ENGINEERING LTD. AND CANNOT BE USED, REPRODUCED OR DISTRIBUTED WITHOUT WRITTEN CONSENT.  
 © 2016 CREUS ENGINEERING LTD.

current rev. # 10

engineer of record	scale	hor. 1:100	vert. 1:50
K.B.H.			
designed by	N.G.B.	file no.	16159
drawn by	A.A.P.	drawing no.	X-OS-4
date	2016-05-13		



### DRAWING LEGEND

	EXISTING	PROP.	TO BE REMOVED
LEGAL LINE	---	---	---
EASMENT	---	---	---
WATERMAIN	---	---	---
SANITARY	---	---	---
STORM	---	---	---
HYDRO	---	---	---
TEL	---	---	---
STREETLIGHT	---	---	---
GAS	---	---	---
	EXISTING	PROP.	TO BE REMOVED
FIRE HYDRANT	⊗	⊗	⊗
GATE VALVE	⊗	⊗	⊗
AIR VALVE	⊗	⊗	⊗
REDUCER	⊗	⊗	⊗
INSPECTION CHAMBER	⊗	⊗	⊗
CATCHBASIN (STD/SI)	⊗	⊗	⊗
CAP	⊗	⊗	⊗
MANHOLE	⊗	⊗	⊗
POWER POLE	⊗	⊗	⊗
STREETLIGHT	⊗	⊗	⊗

approved

client  
**580049 BC LTD.**



project  
**THE RIDGE AT PEMBERTON  
 PHASE 1  
 PEMBERTON, BC**

title  
**CROSS SECTIONS  
 OFFSITE ROAD (STA 0+260-0+280)**

no.	(y/m/d)	revision	chd/d
12	18-02-06	PROJECT RECORDS OFFSITE	KBH
11	18-01-09	PROJECT RECORDS OFFSITE	KBH
10	17-10-17	PROJECT RECORDS OFFSITE	KBH
9	17-09-19	UPDATED OFFSETS	KBH
8	17-08-15	UPDATE WITH HYDRO & TELUS	KBH
7	17-03-07	REISSUED FOR CONSTRUCTION OFFSITE	KBH
6	16-11-09	REISSUED FOR CONSTRUCTION OFFSITE	KBH
5	16-10-26	IFC OFFSITE FINAL COMMENTS	KBH

COPYRIGHT RESERVED. THIS DRAWING AND DESIGN ARE, AND AT ALL TIMES REMAIN THE EXCLUSIVE PROPERTY OF CREUS ENGINEERING LTD. AND CANNOT BE USED, REPRODUCED OR DISTRIBUTED WITHOUT WRITTEN CONSENT.  
 © 2018 CREUS ENGINEERING LTD.

engineer of record	file no.
K.B.H.	16159
designed by	drawn by
N.G.B.	A.A.P.
date	2016-05-13
hor: 1:100	vert: 1:50
drawing no.	X-OS-5

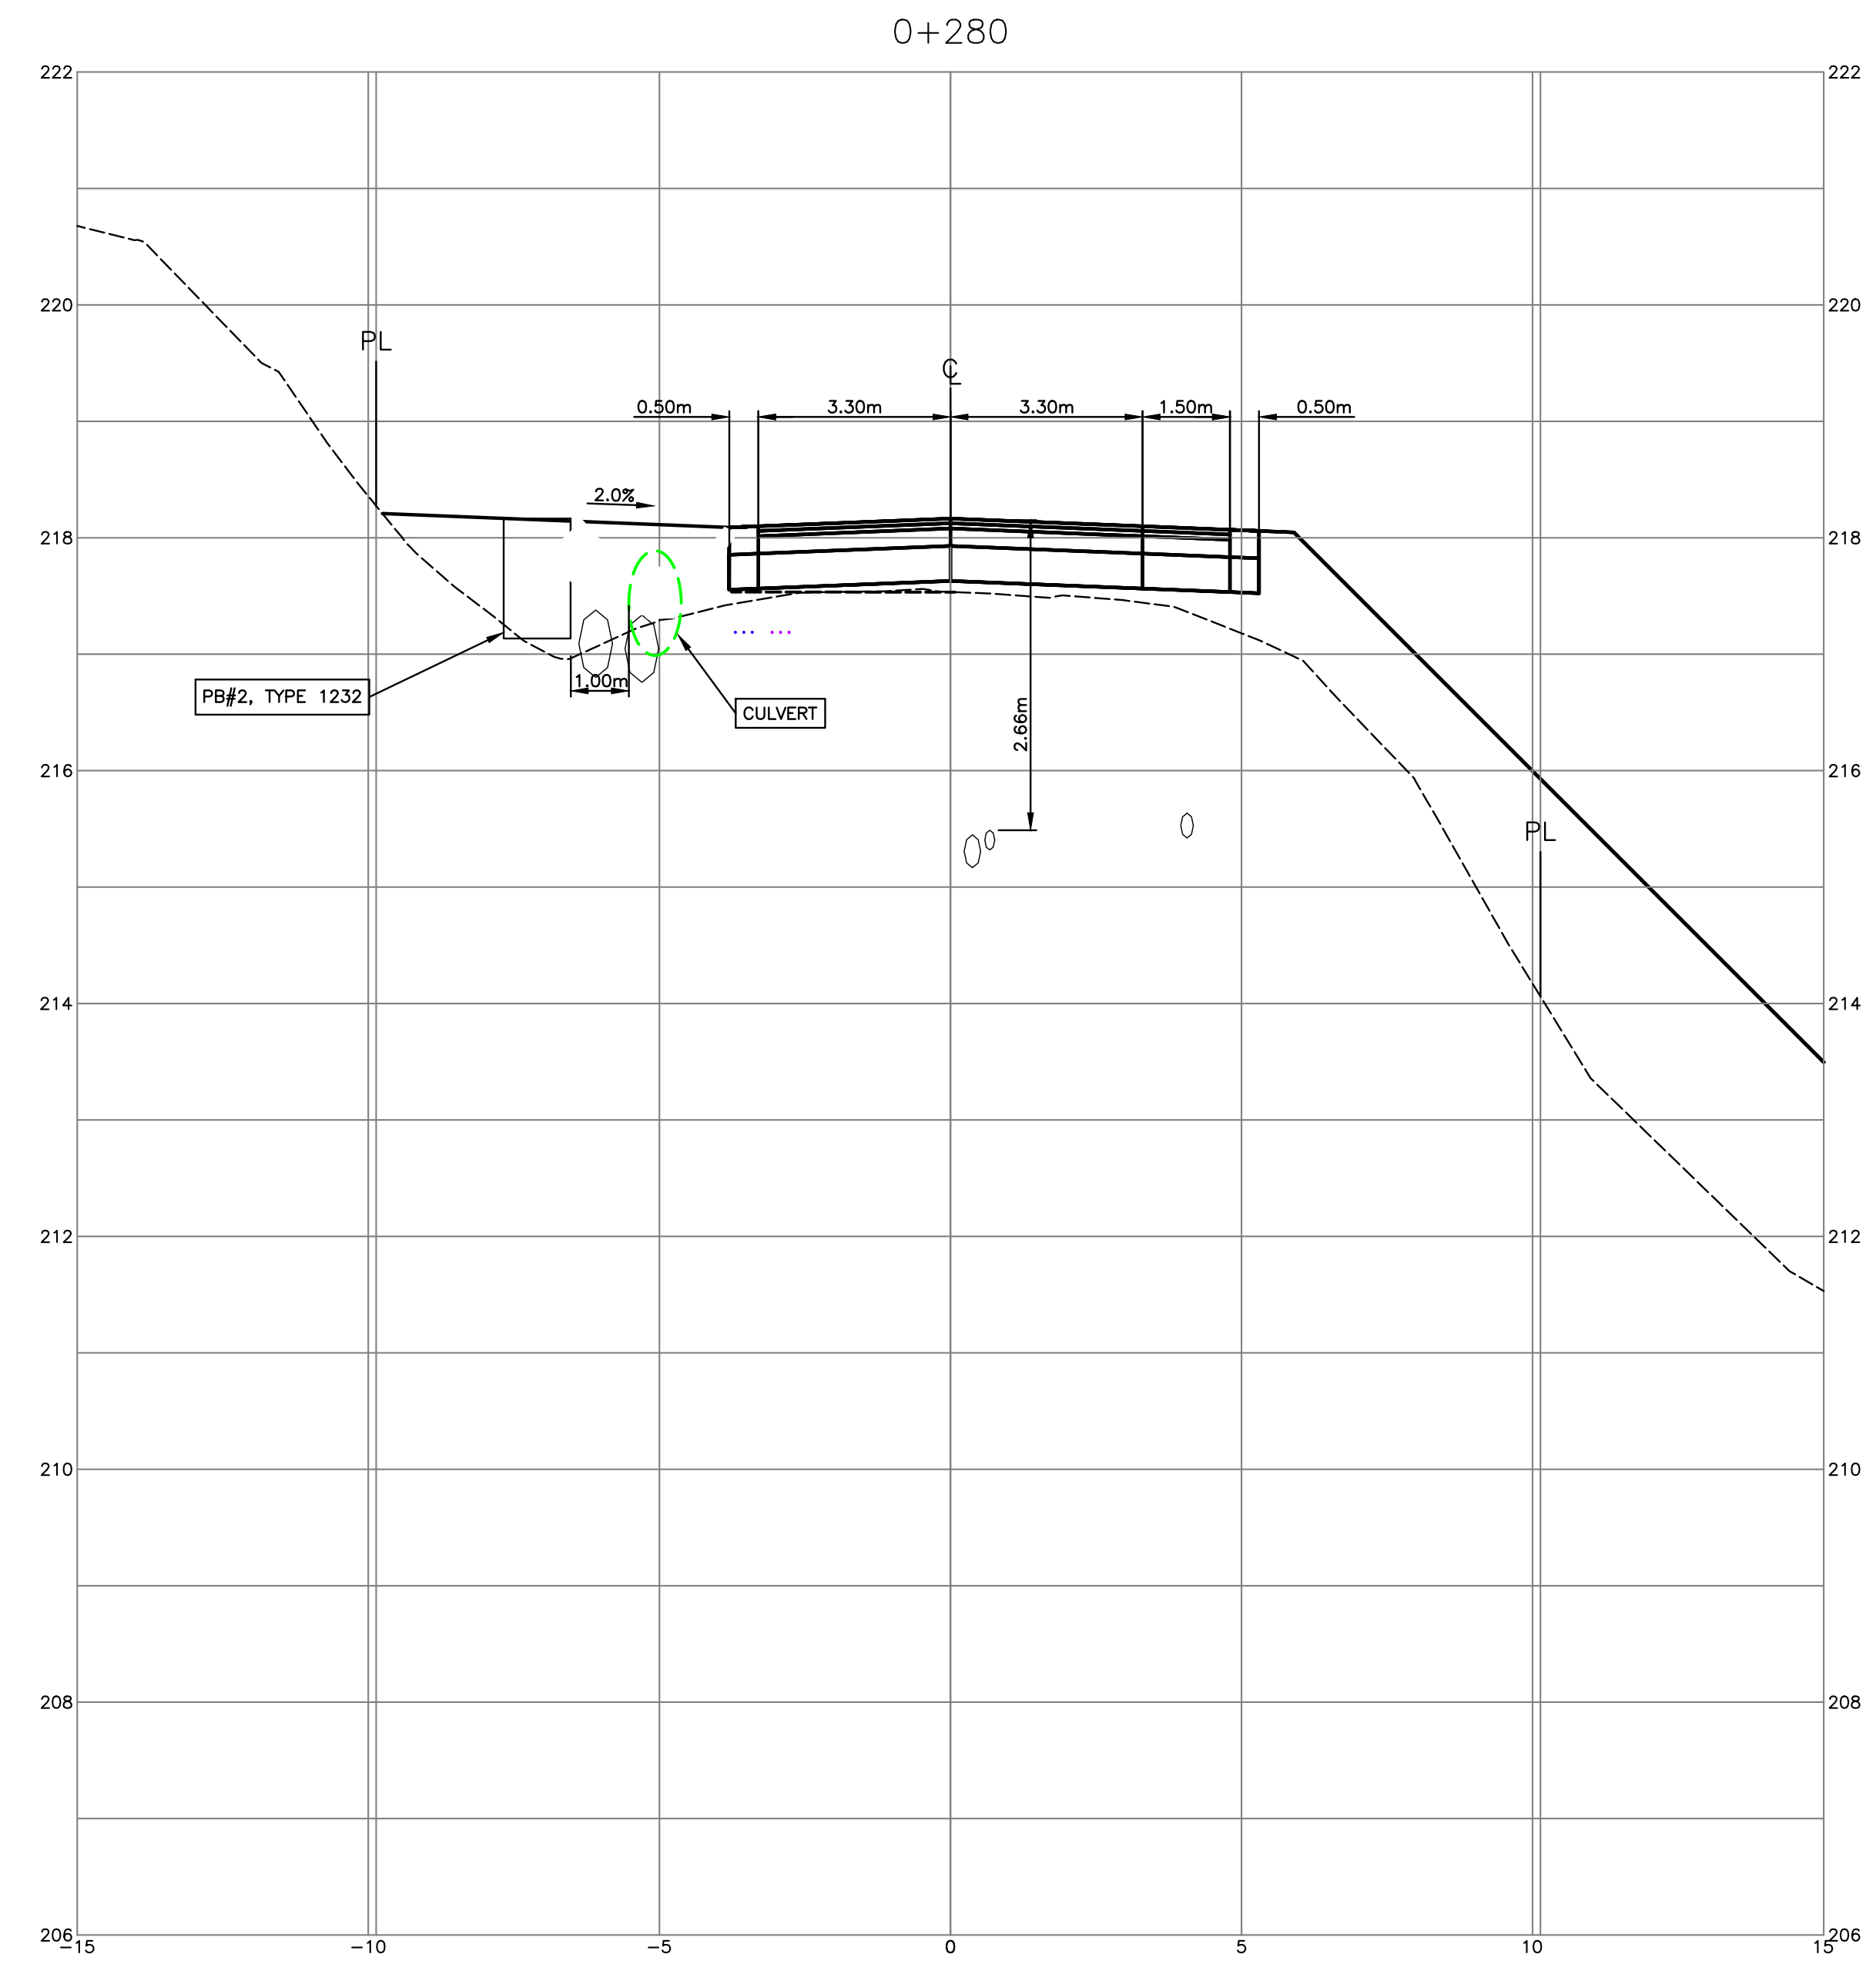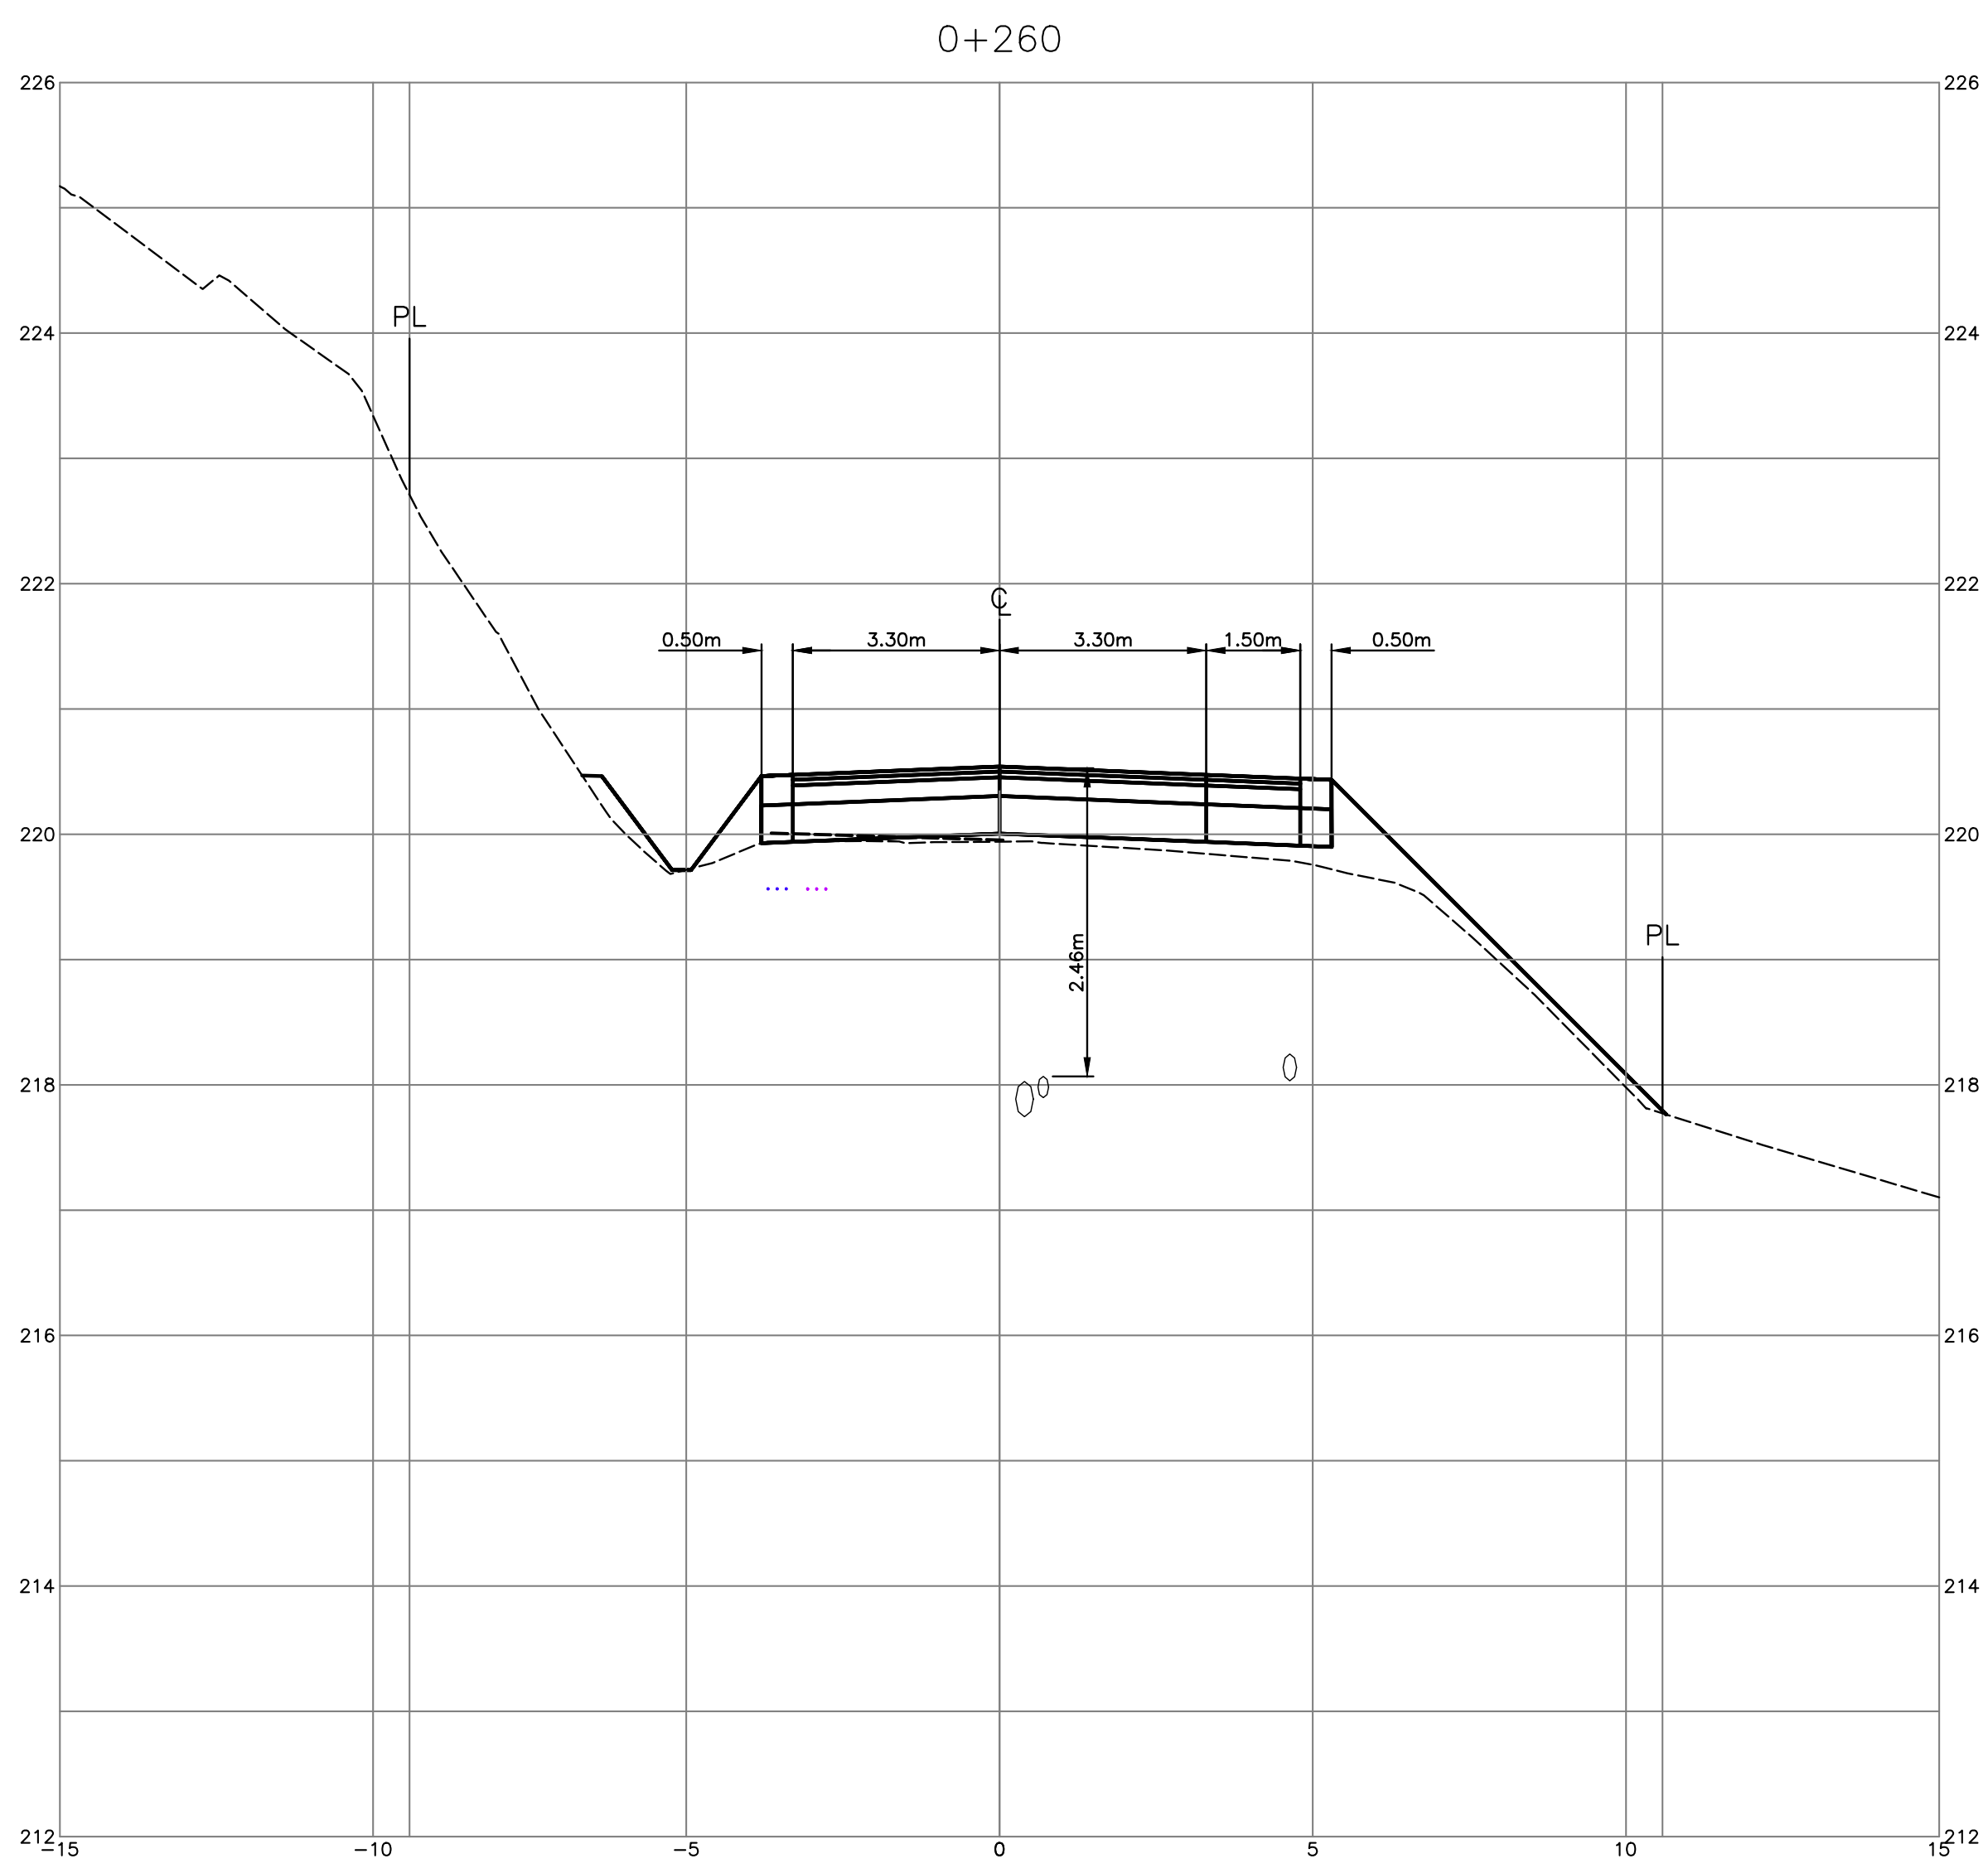



### DRAWING LEGEND

	EXISTING	PROP.	TO BE REMOVED
LEGAL LINE	---	---	---
EASMENT	---	---	---
WATERMAIN	---	---	---
SANITARY	---	---	---
STORM	---	---	---
HYDRO	---	---	---
TEL	---	---	---
STREETLIGHT	---	---	---
GAS	---	---	---
FIRE HYDRANT	⊗	⊗	⊗
GATE VALVE	⊕	⊕	⊕
AIR VALVE	⊙	⊙	⊙
REDUCER	⊖	⊖	⊖
INSPECTION CHAMBER	⊖	⊖	⊖
CATCHBASIN (STD/SI)	⊖	⊖	⊖
CAP	⊖	⊖	⊖
MANHOLE	⊖	⊖	⊖
POWER POLE	⊖	⊖	⊖
STREETLIGHT	⊖	⊖	⊖

approved

client

580049 BC LTD.

project

THE RIDGE AT PEMBERTON  
 PHASE 1  
 PEMBERTON, BC

title

CROSS SECTIONS  
 OFFSITE ROAD (STA 0+300-0+320)

no.	(y/m/d)	revision	chk'd
10	18-02-06	PROJECT RECORDS OFFSITE	KBH
9	17-10-17	PROJECT RECORDS OFFSITE	KBH
8	17-09-19	UPDATED OFFSETS	KBH
7	17-08-15	UPDATE WITH HYDRO & TELLUS	KBH
6	17-03-07	REISSUED FOR CONSTRUCTION OFFSITE	KBH
5	16-10-26	IFC OFFSITE FINAL COMMENTS	KBH
4	16-10-13	ISSUED FOR CONSTRUCTION OFFSITE	KBH
3	16-09-19	ISSUED FOR VOP FINAL COMMENTS	KBH



COPYRIGHT RESERVED. THIS DRAWING AND DESIGN ARE, AND AT ALL TIMES REMAIN THE EXCLUSIVE PROPERTY OF CREUS ENGINEERING LTD. AND CANNOT BE USED, REPRODUCED OR DISTRIBUTED WITHOUT WRITTEN CONSENT.  
 ©2018 CREUS ENGINEERING LTD.

engineer of record K.B.H. scales hor: 1:100 vert: 1:50

designed by N.G.B. file no. 16159

drawn by A.A.P. drawing no. X-OS-6

date 2016-05-13

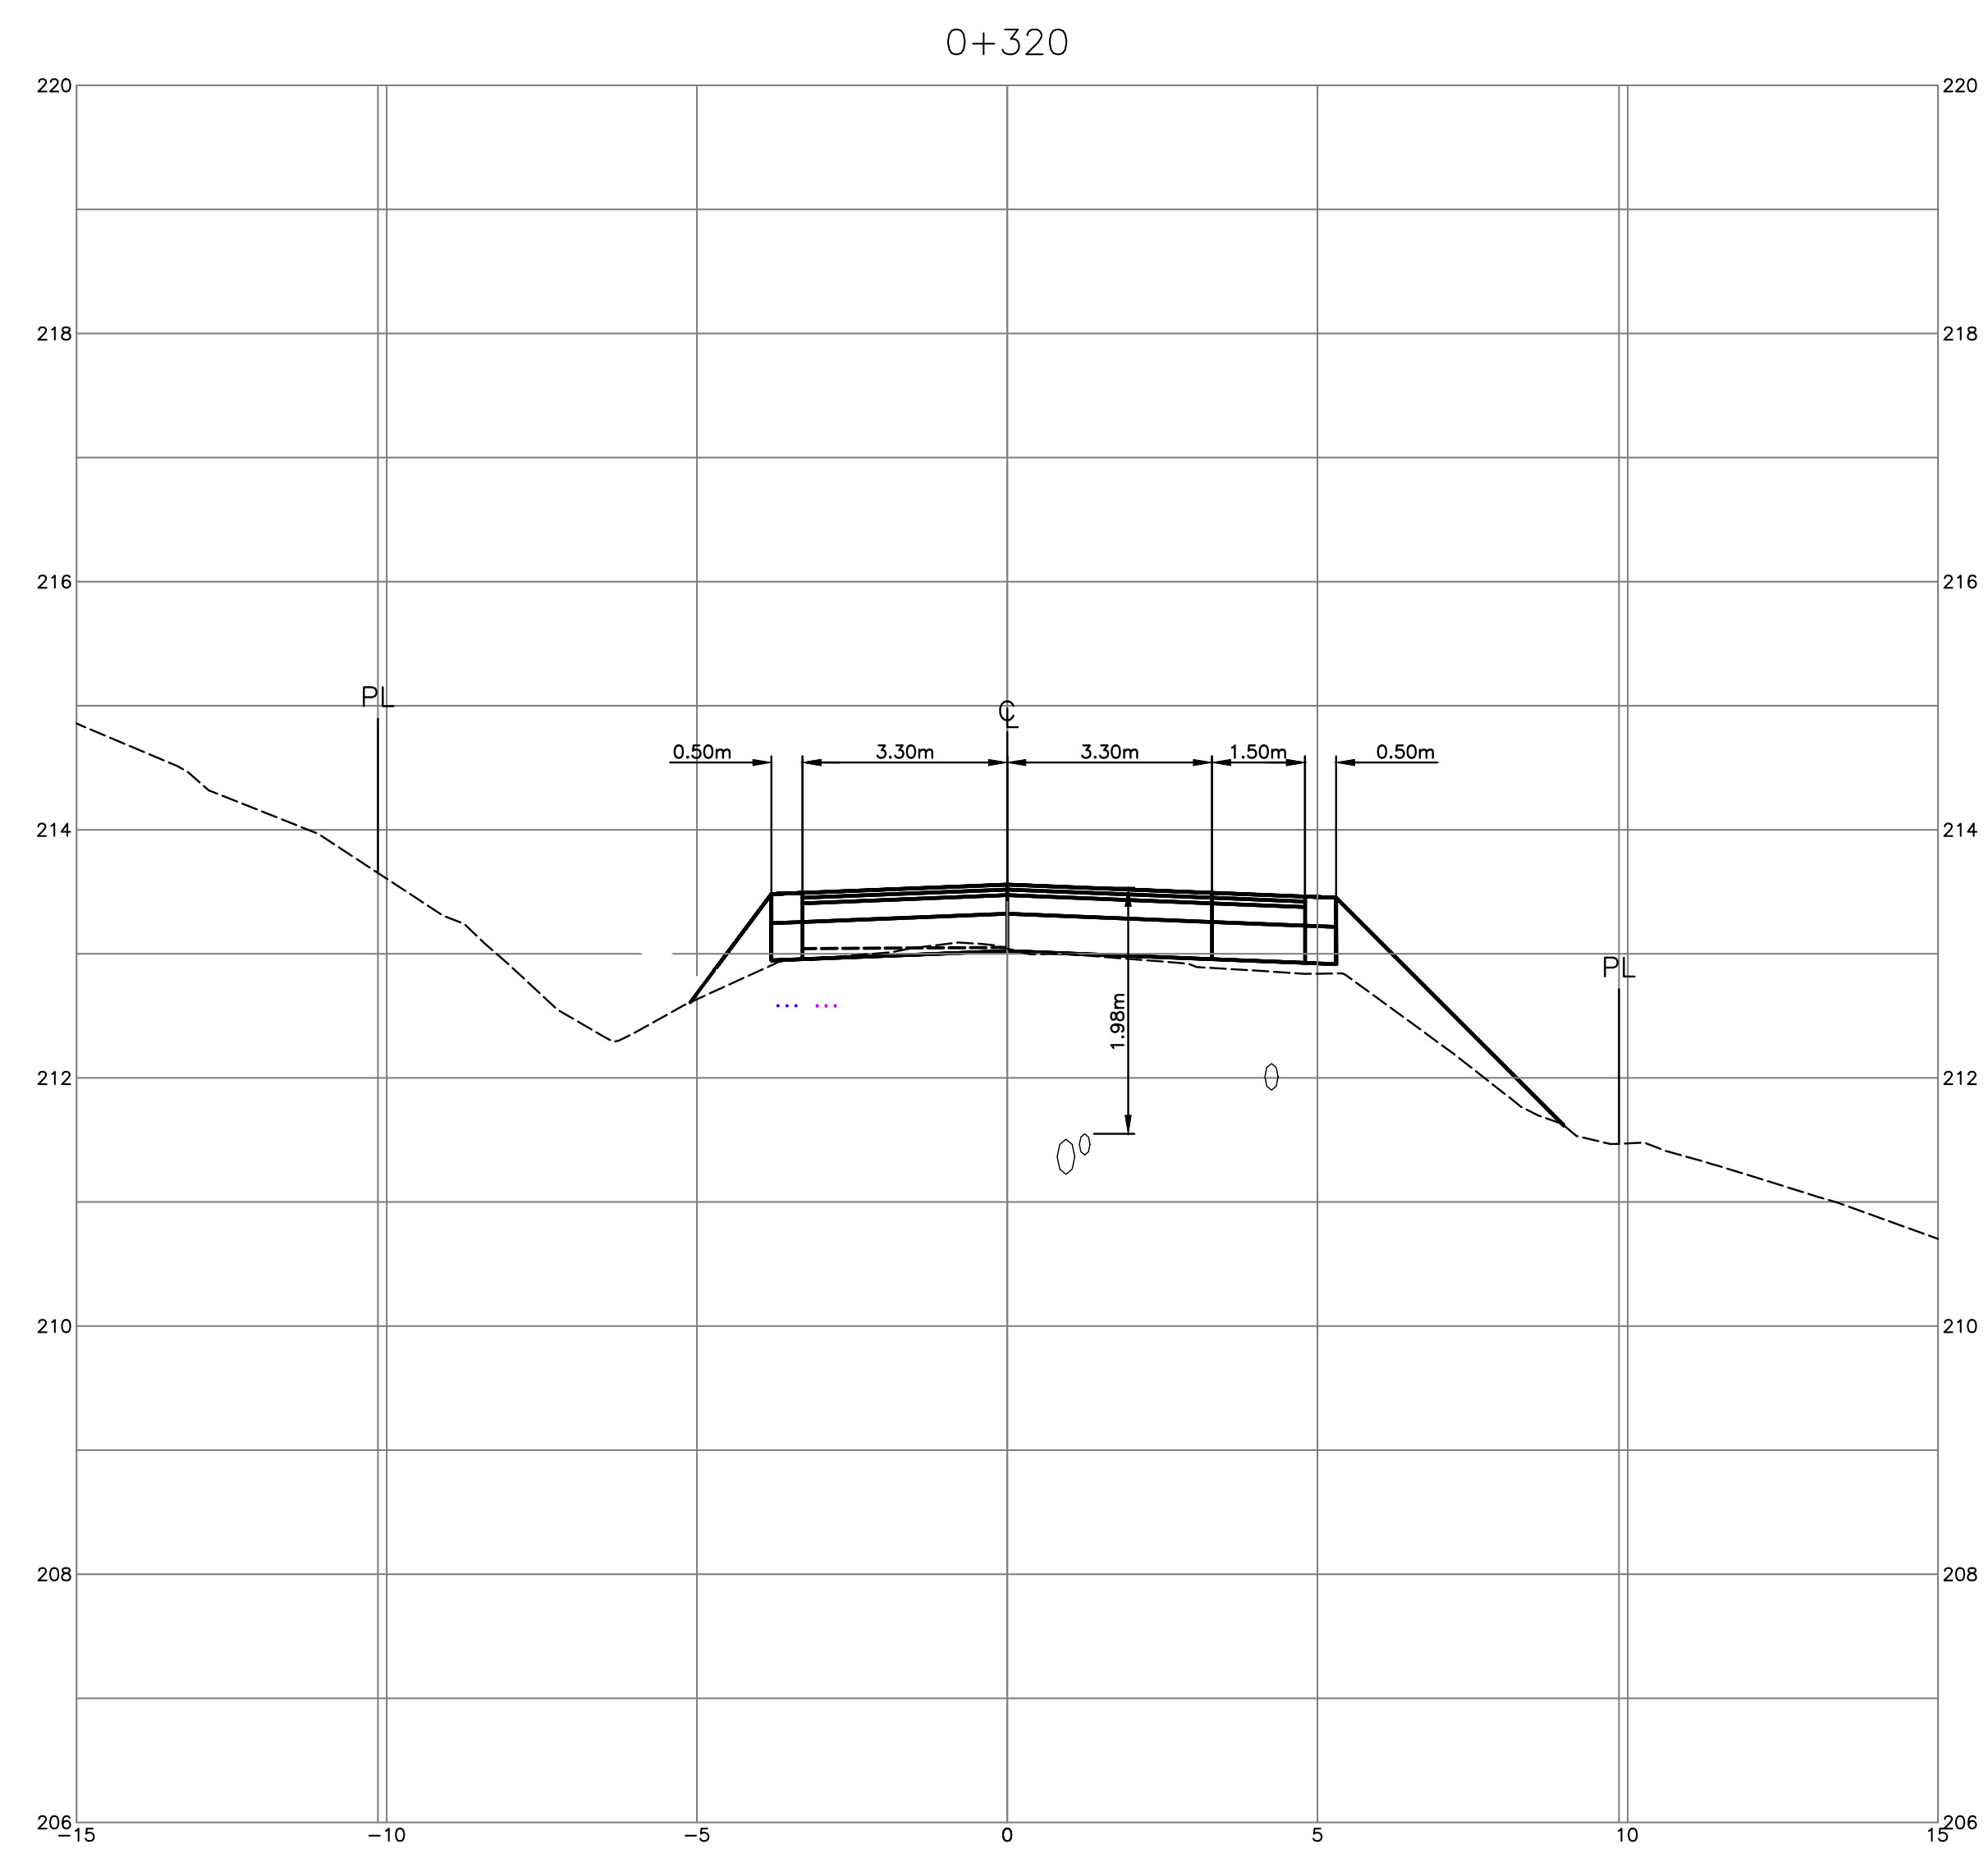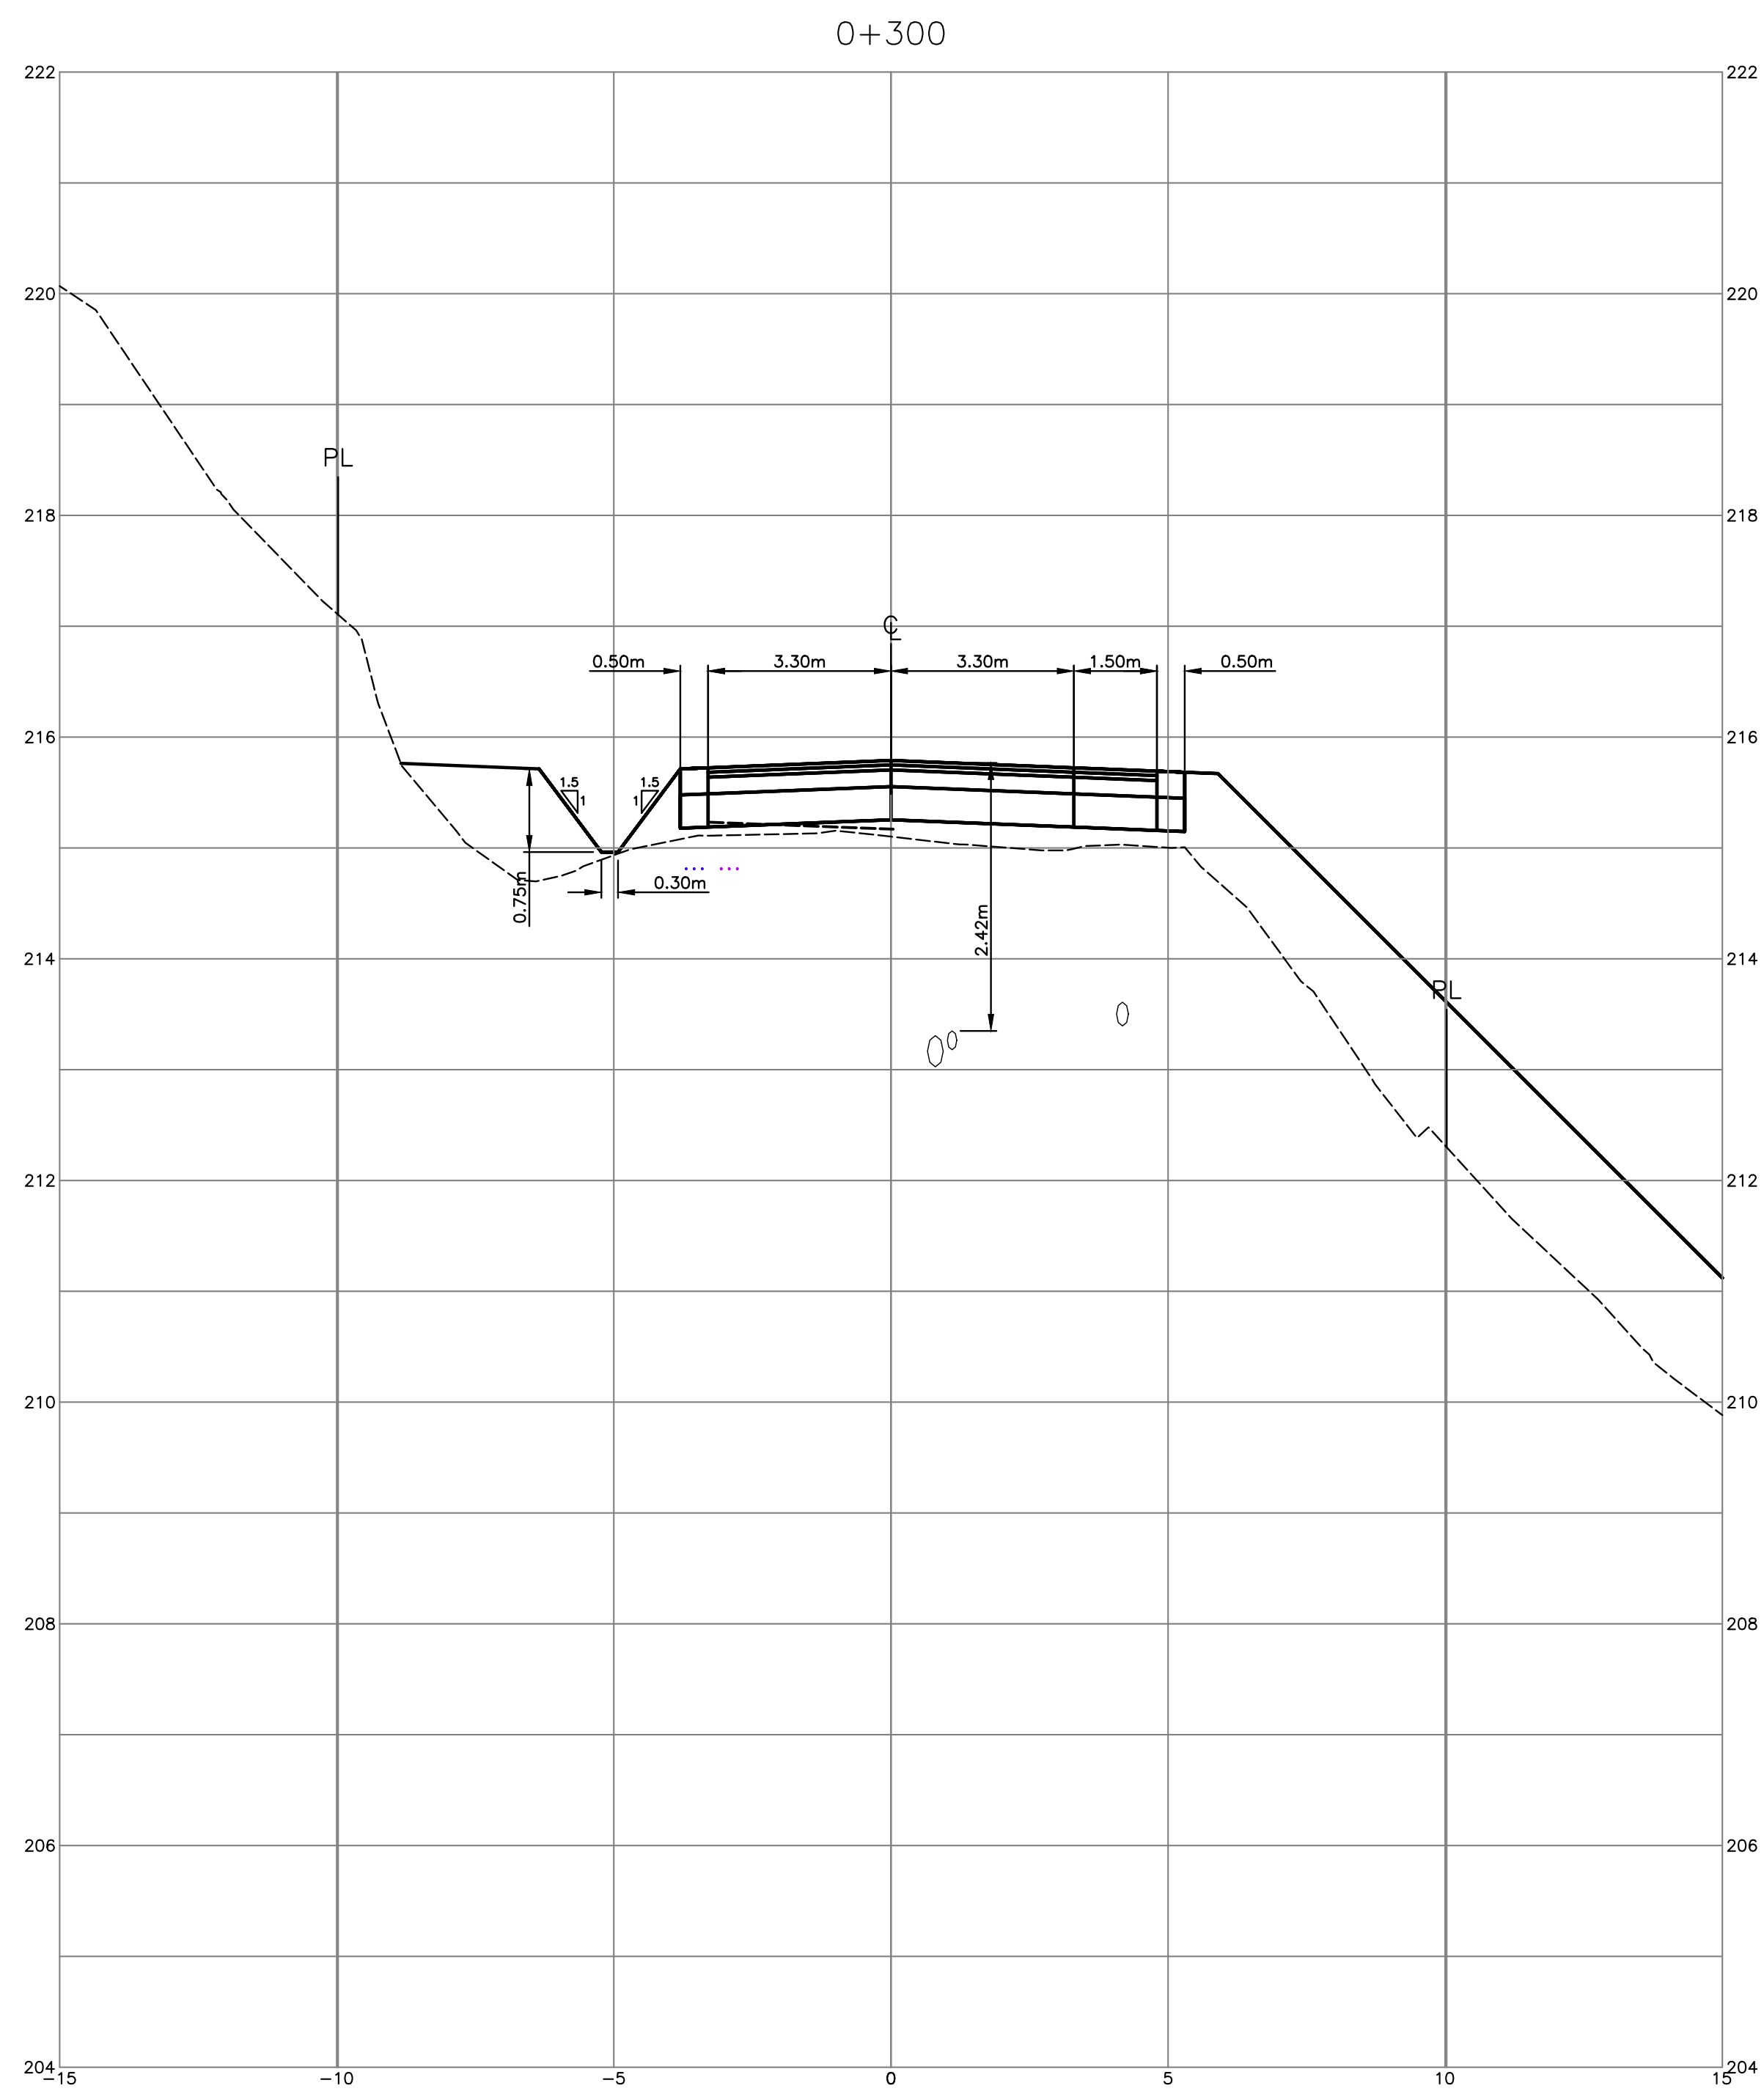



### DRAWING LEGEND

	EXISTING	PROP.	TO BE REMOVED
LEGAL LINE	---	---	---
EASEMENT	---	---	---
WATERMAIN	---	---	---
SANITARY	---	---	---
STORM	---	---	---
HYDRO	---	---	---
TEL	---	---	---
STREETLIGHT	---	---	---
GAS	---	---	---
	EXISTING	PROP.	TO BE REMOVED
FIRE HYDRANT	⊗	⊗	⊗
GATE VALVE	⊕	⊕	⊕
AIR VALVE	⊙	⊙	⊙
REDUCER	⊖	⊖	⊖
INSPECTION CHAMBER	⊕	⊕	⊕
CATCHBASIN (STD/SI)	⊕/⊖	⊕/⊖	⊕/⊖
CAP	⊕	⊕	⊕
MANHOLE	⊕	⊕	⊕
POWER POLE	⊕	⊕	⊕
STREETLIGHT	⊕	⊕	⊕

approved

client

580049 BC LTD.

project

THE RIDGE AT PEMBERTON  
 PHASE 1  
 PEMBERTON, BC

title





CROSS SECTIONS  
 OFFSITE ROAD (STA 0+340-0+400)

no.	(y/m/d)	revision	chk'd
12	18-02-06	PROJECT RECORDS OFFSITE	KBH
11	17-10-17	PROJECT RECORDS OFFSITE	KBH
10	17-09-19	UPDATED OFFSETS	KBH
9	17-08-15	UPDATE WITH HYDRO & TELLUS	KBH
8	17-03-07	REISSUED FOR CONSTRUCTION OFFSITE	KBH
7	16-11-09	REISSUED FOR CONSTRUCTION OFFSITE	KBH
6	16-11-09	REISSUED FOR CONSTRUCTION OFFSITE	KBH
5	16-10-26	IFC OFFSITE FINAL COMMENTS	KBH

COPYRIGHT RESERVED. THIS DRAWING AND DESIGN ARE, AND AT ALL TIMES REMAIN THE EXCLUSIVE PROPERTY OF CREUS ENGINEERING LTD. AND CANNOT BE USED, REPRODUCED OR DISTRIBUTED WITHOUT WRITTEN CONSENT.  
 © 2018 CREUS ENGINEERING LTD.

current rev. # **12**

engineer of record	file no.	hor. scale	vert. scale
K.B.H.	16159	1:100	1:50
designed by N.G.B.	drawn by A.A.P.	date 2016-05-13	drawing no. X-OS-7

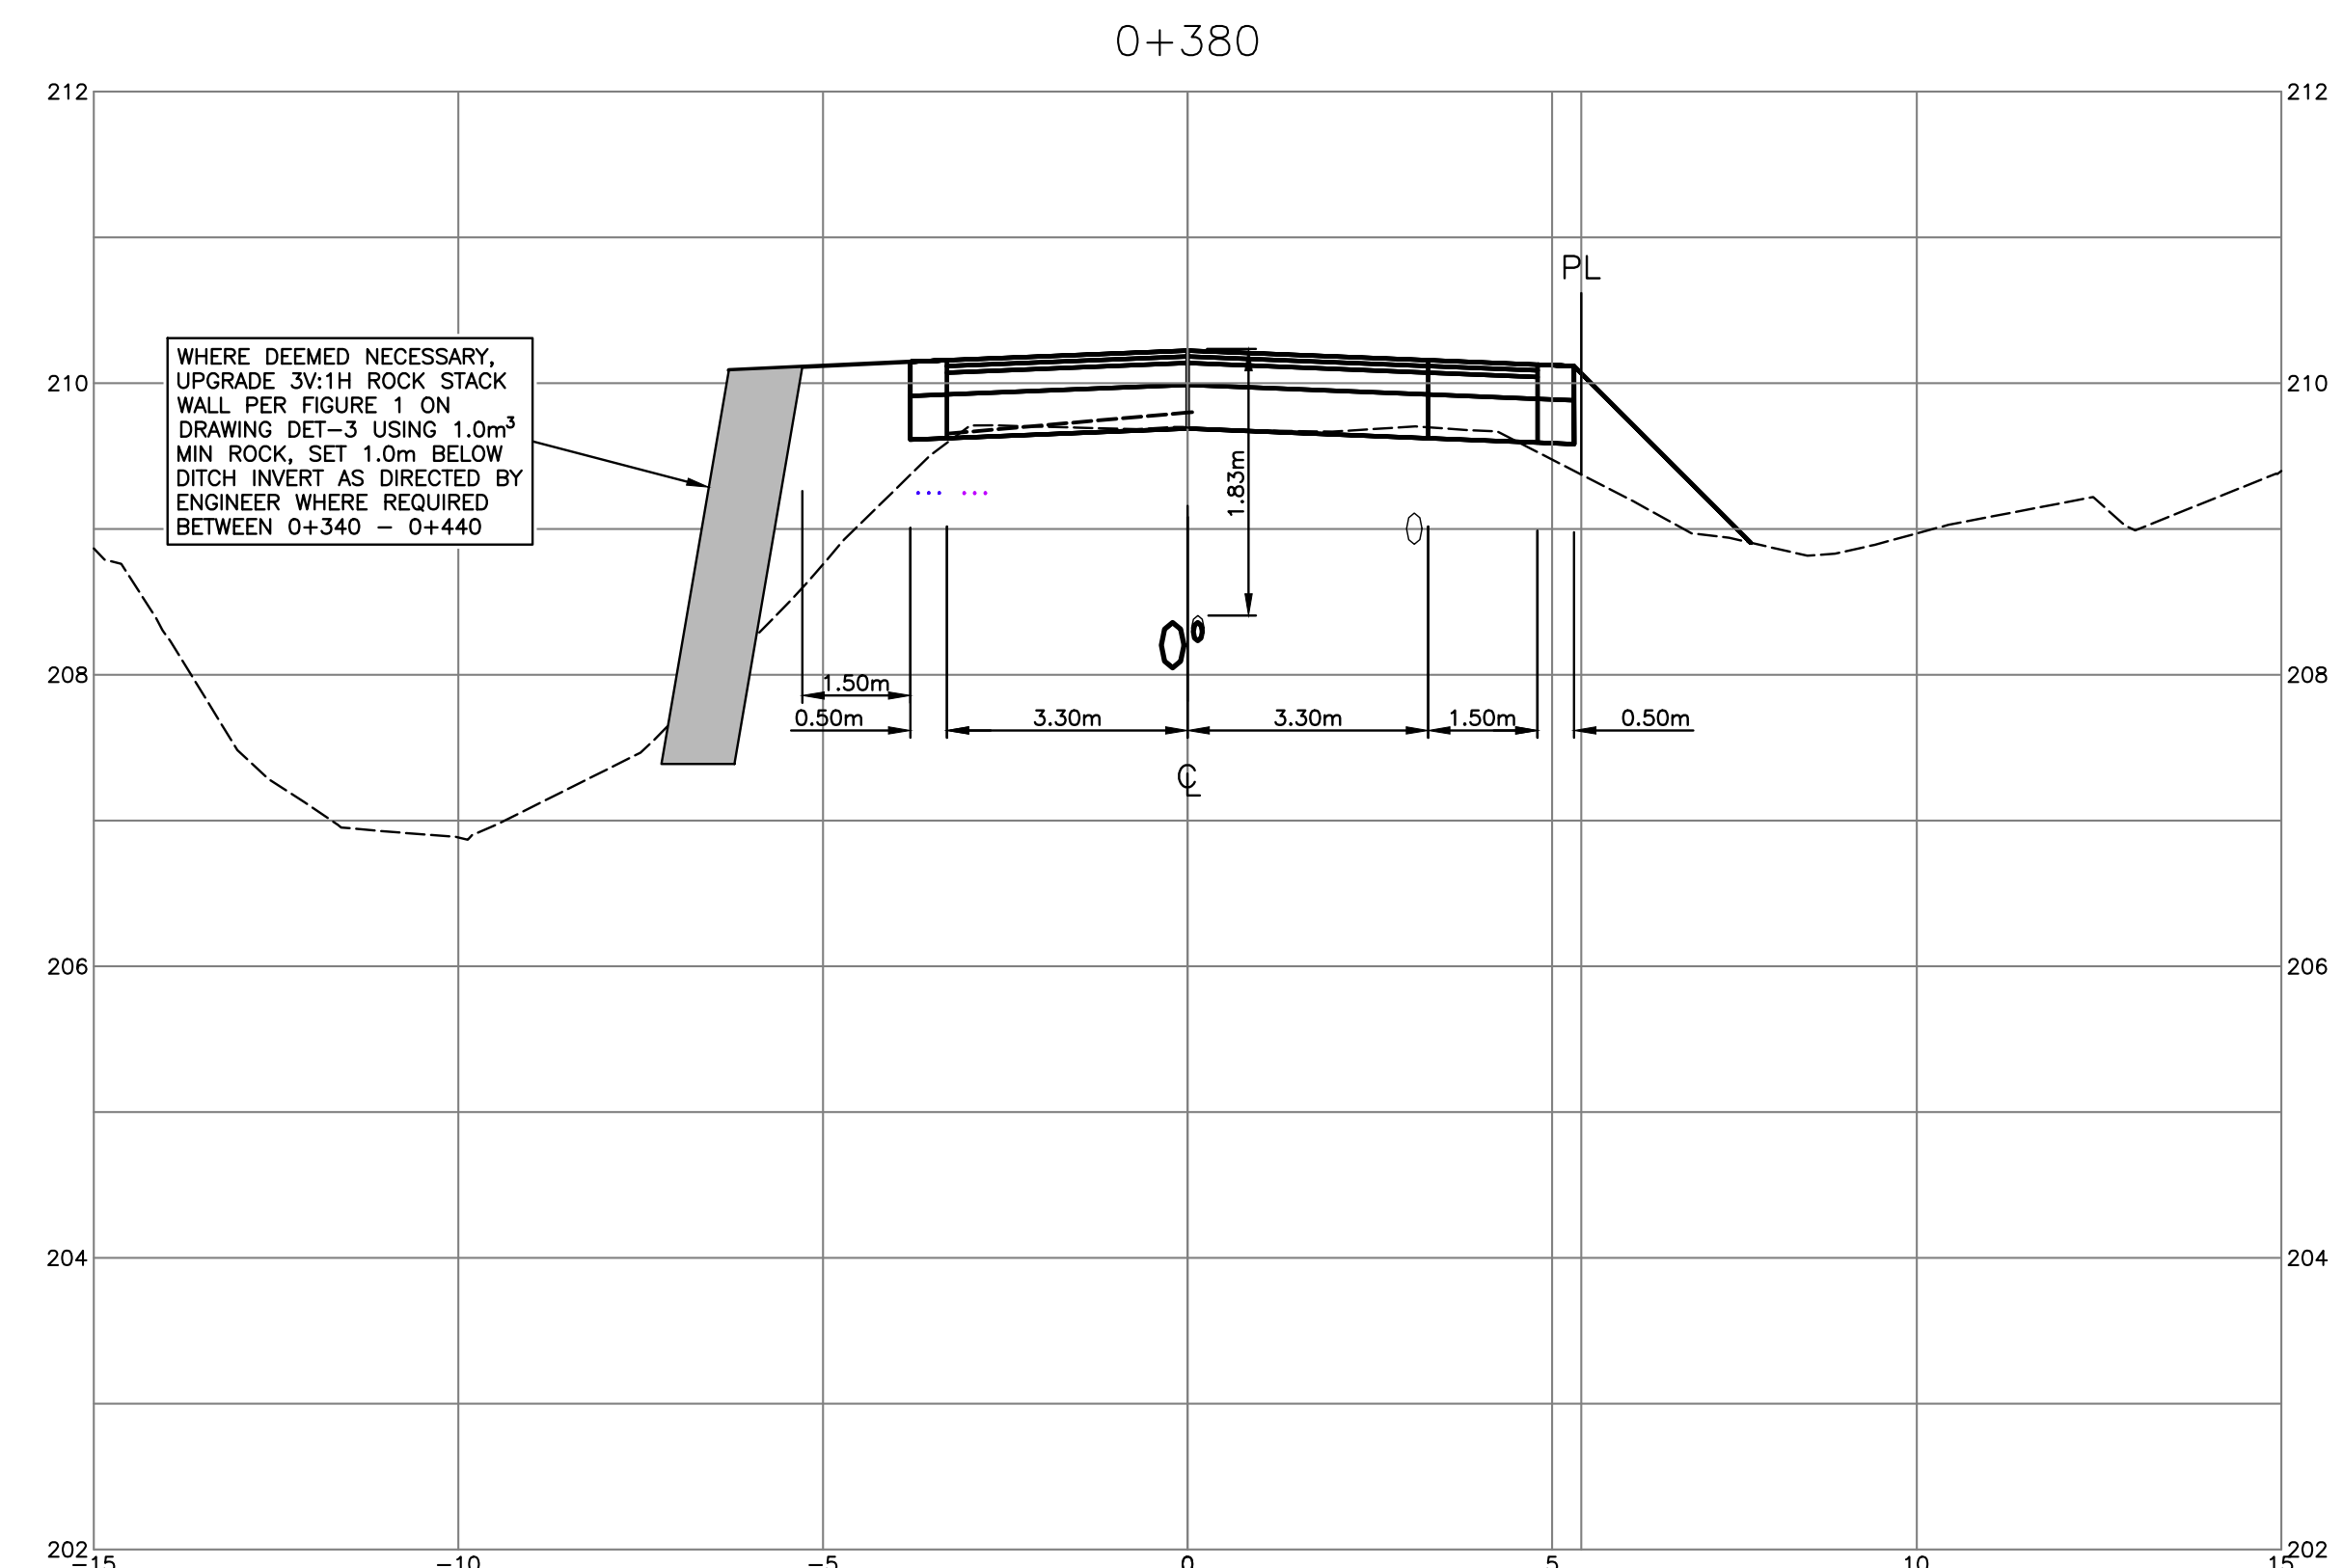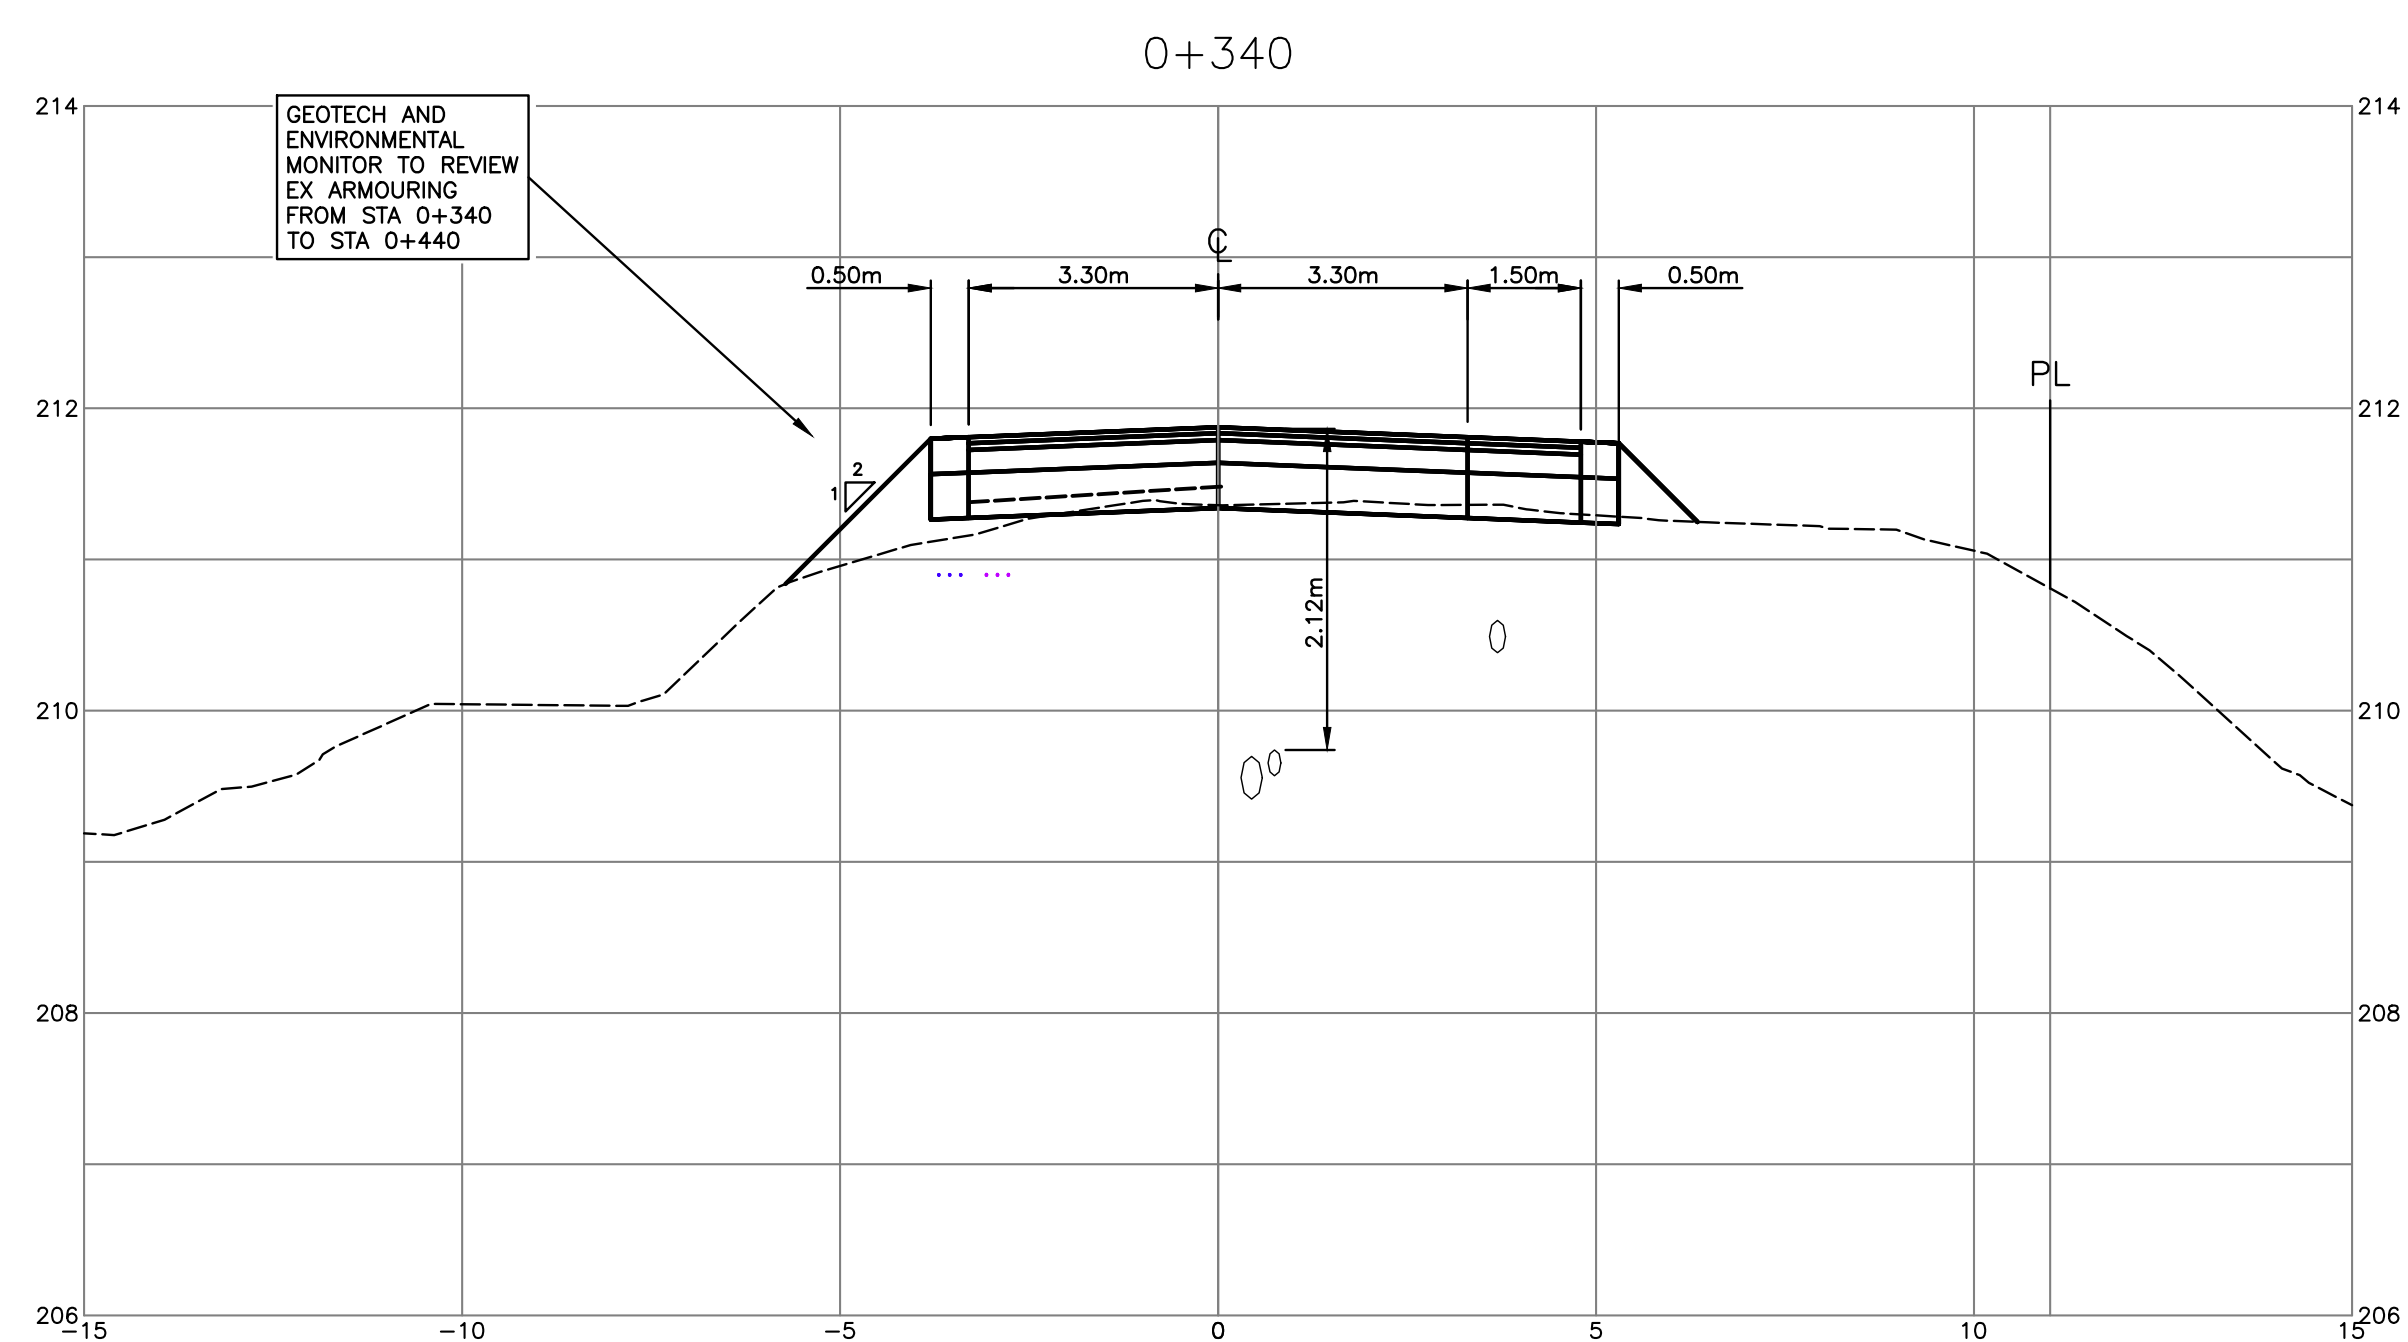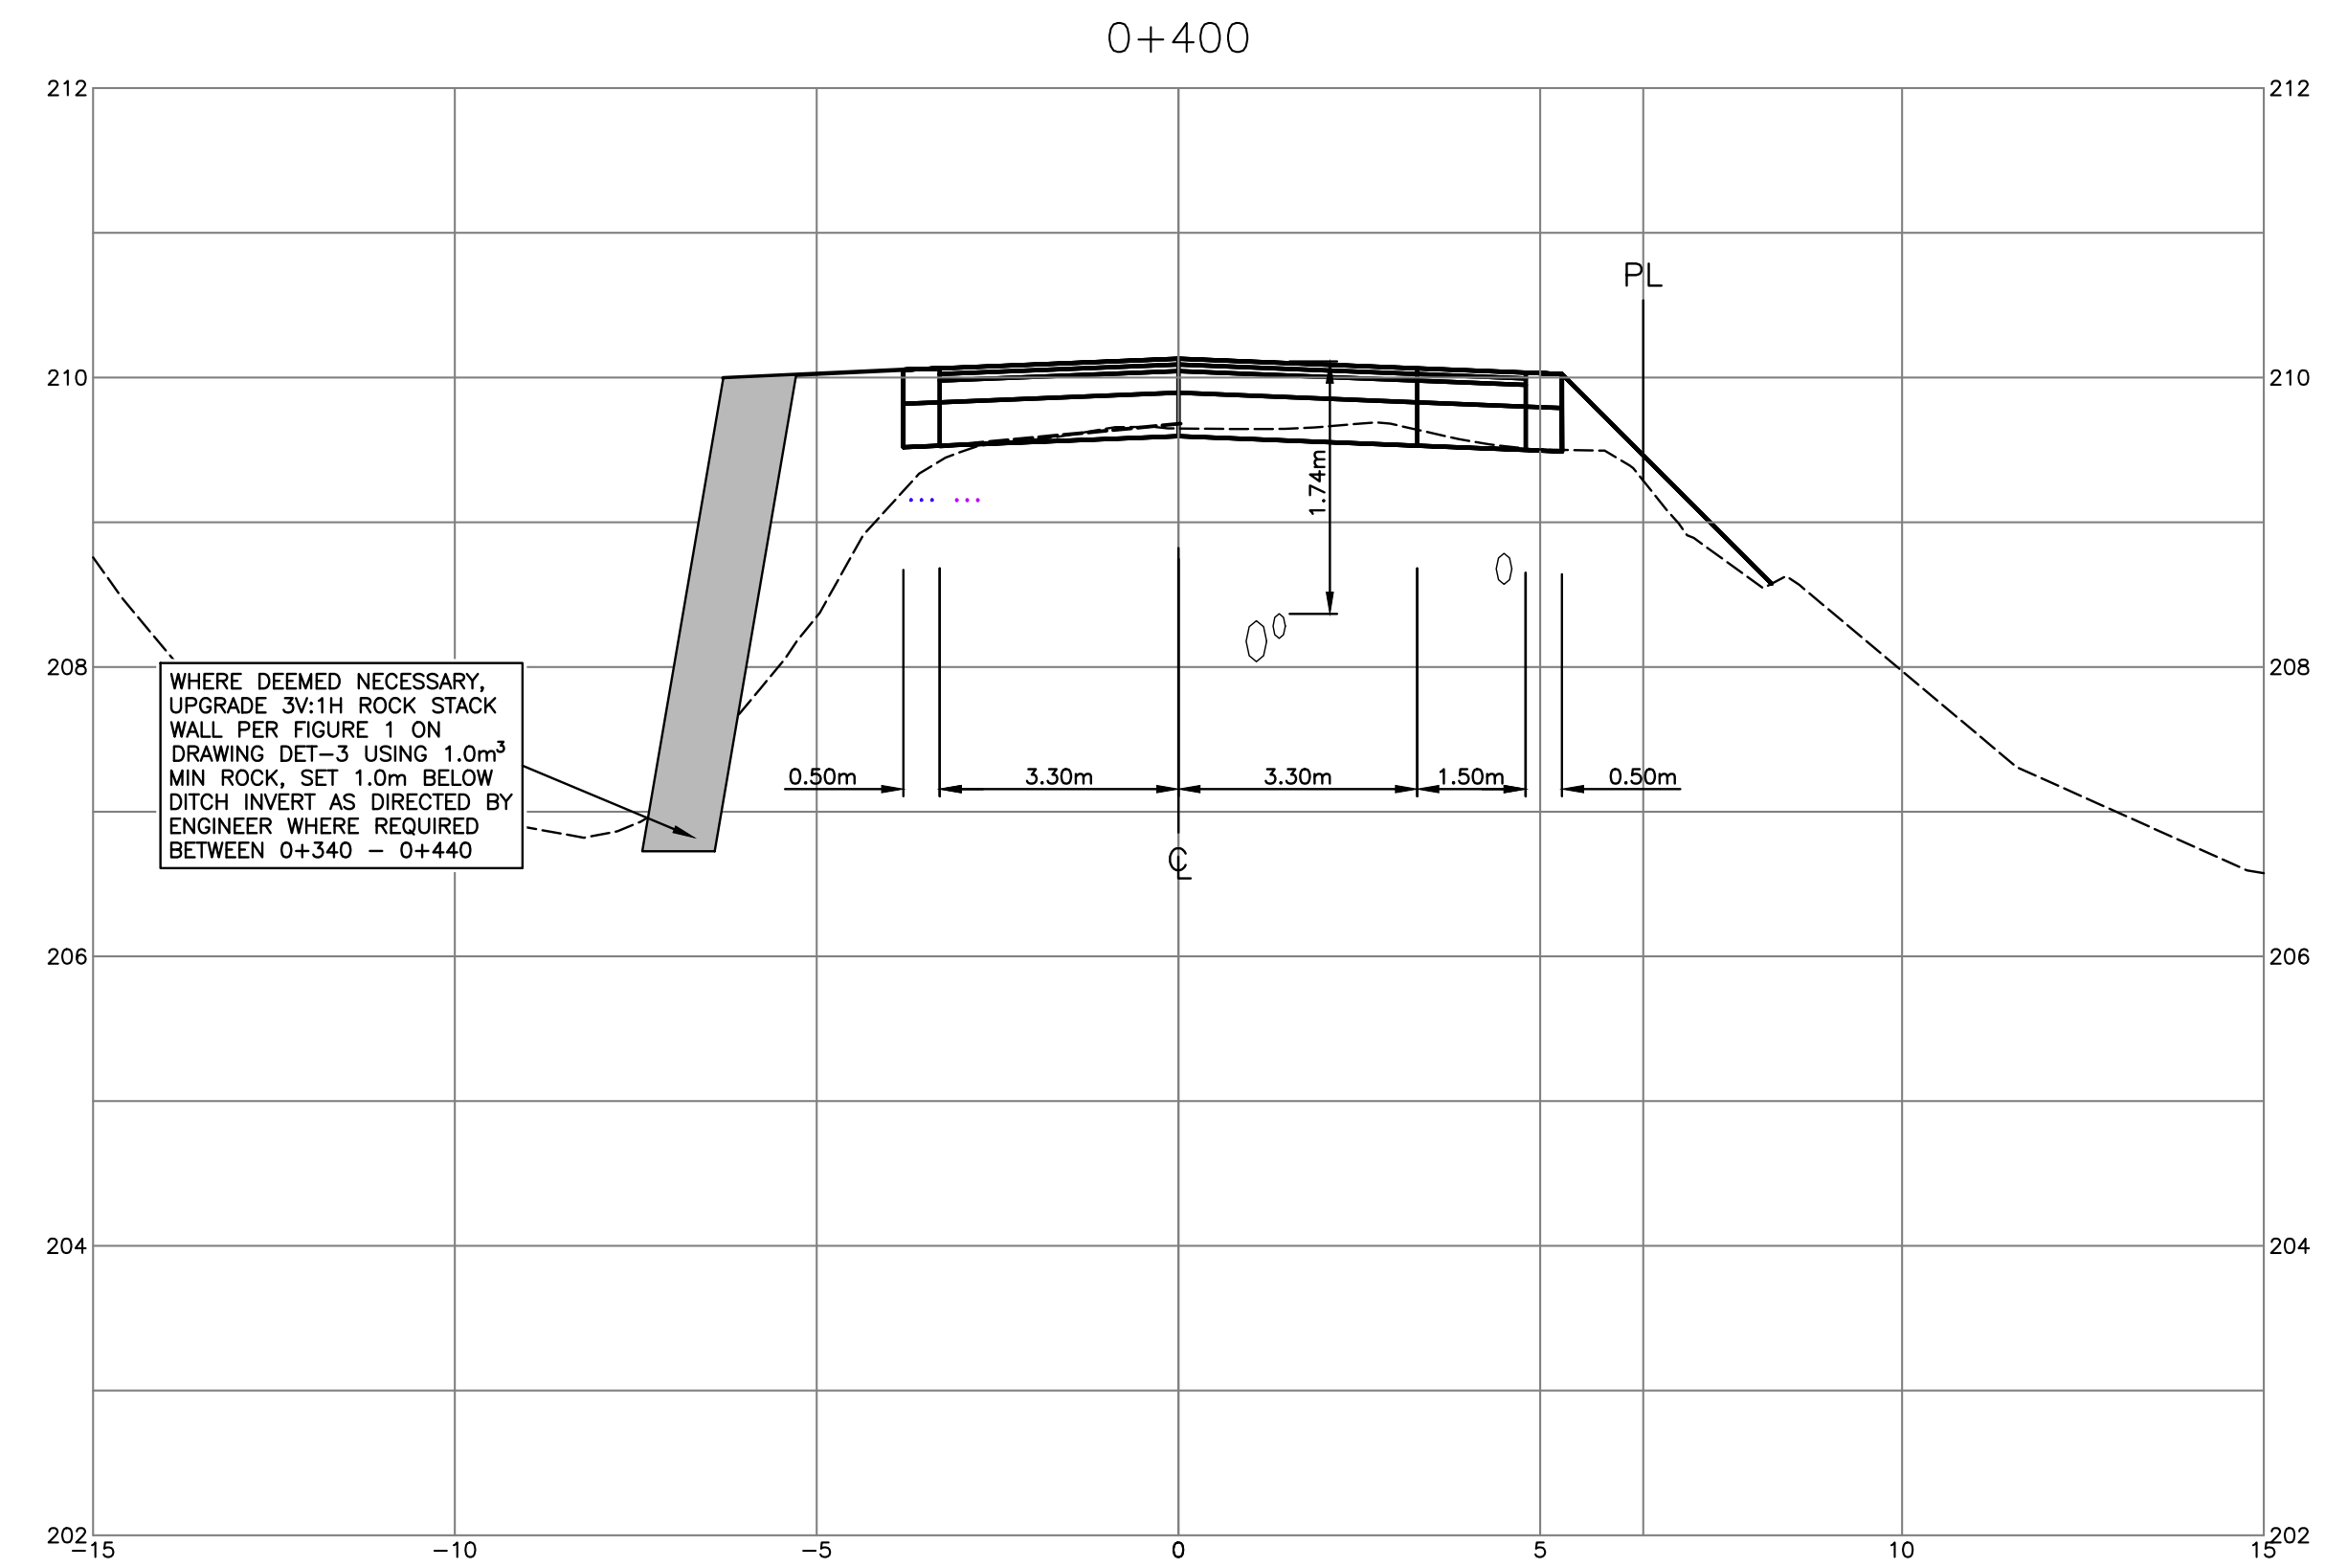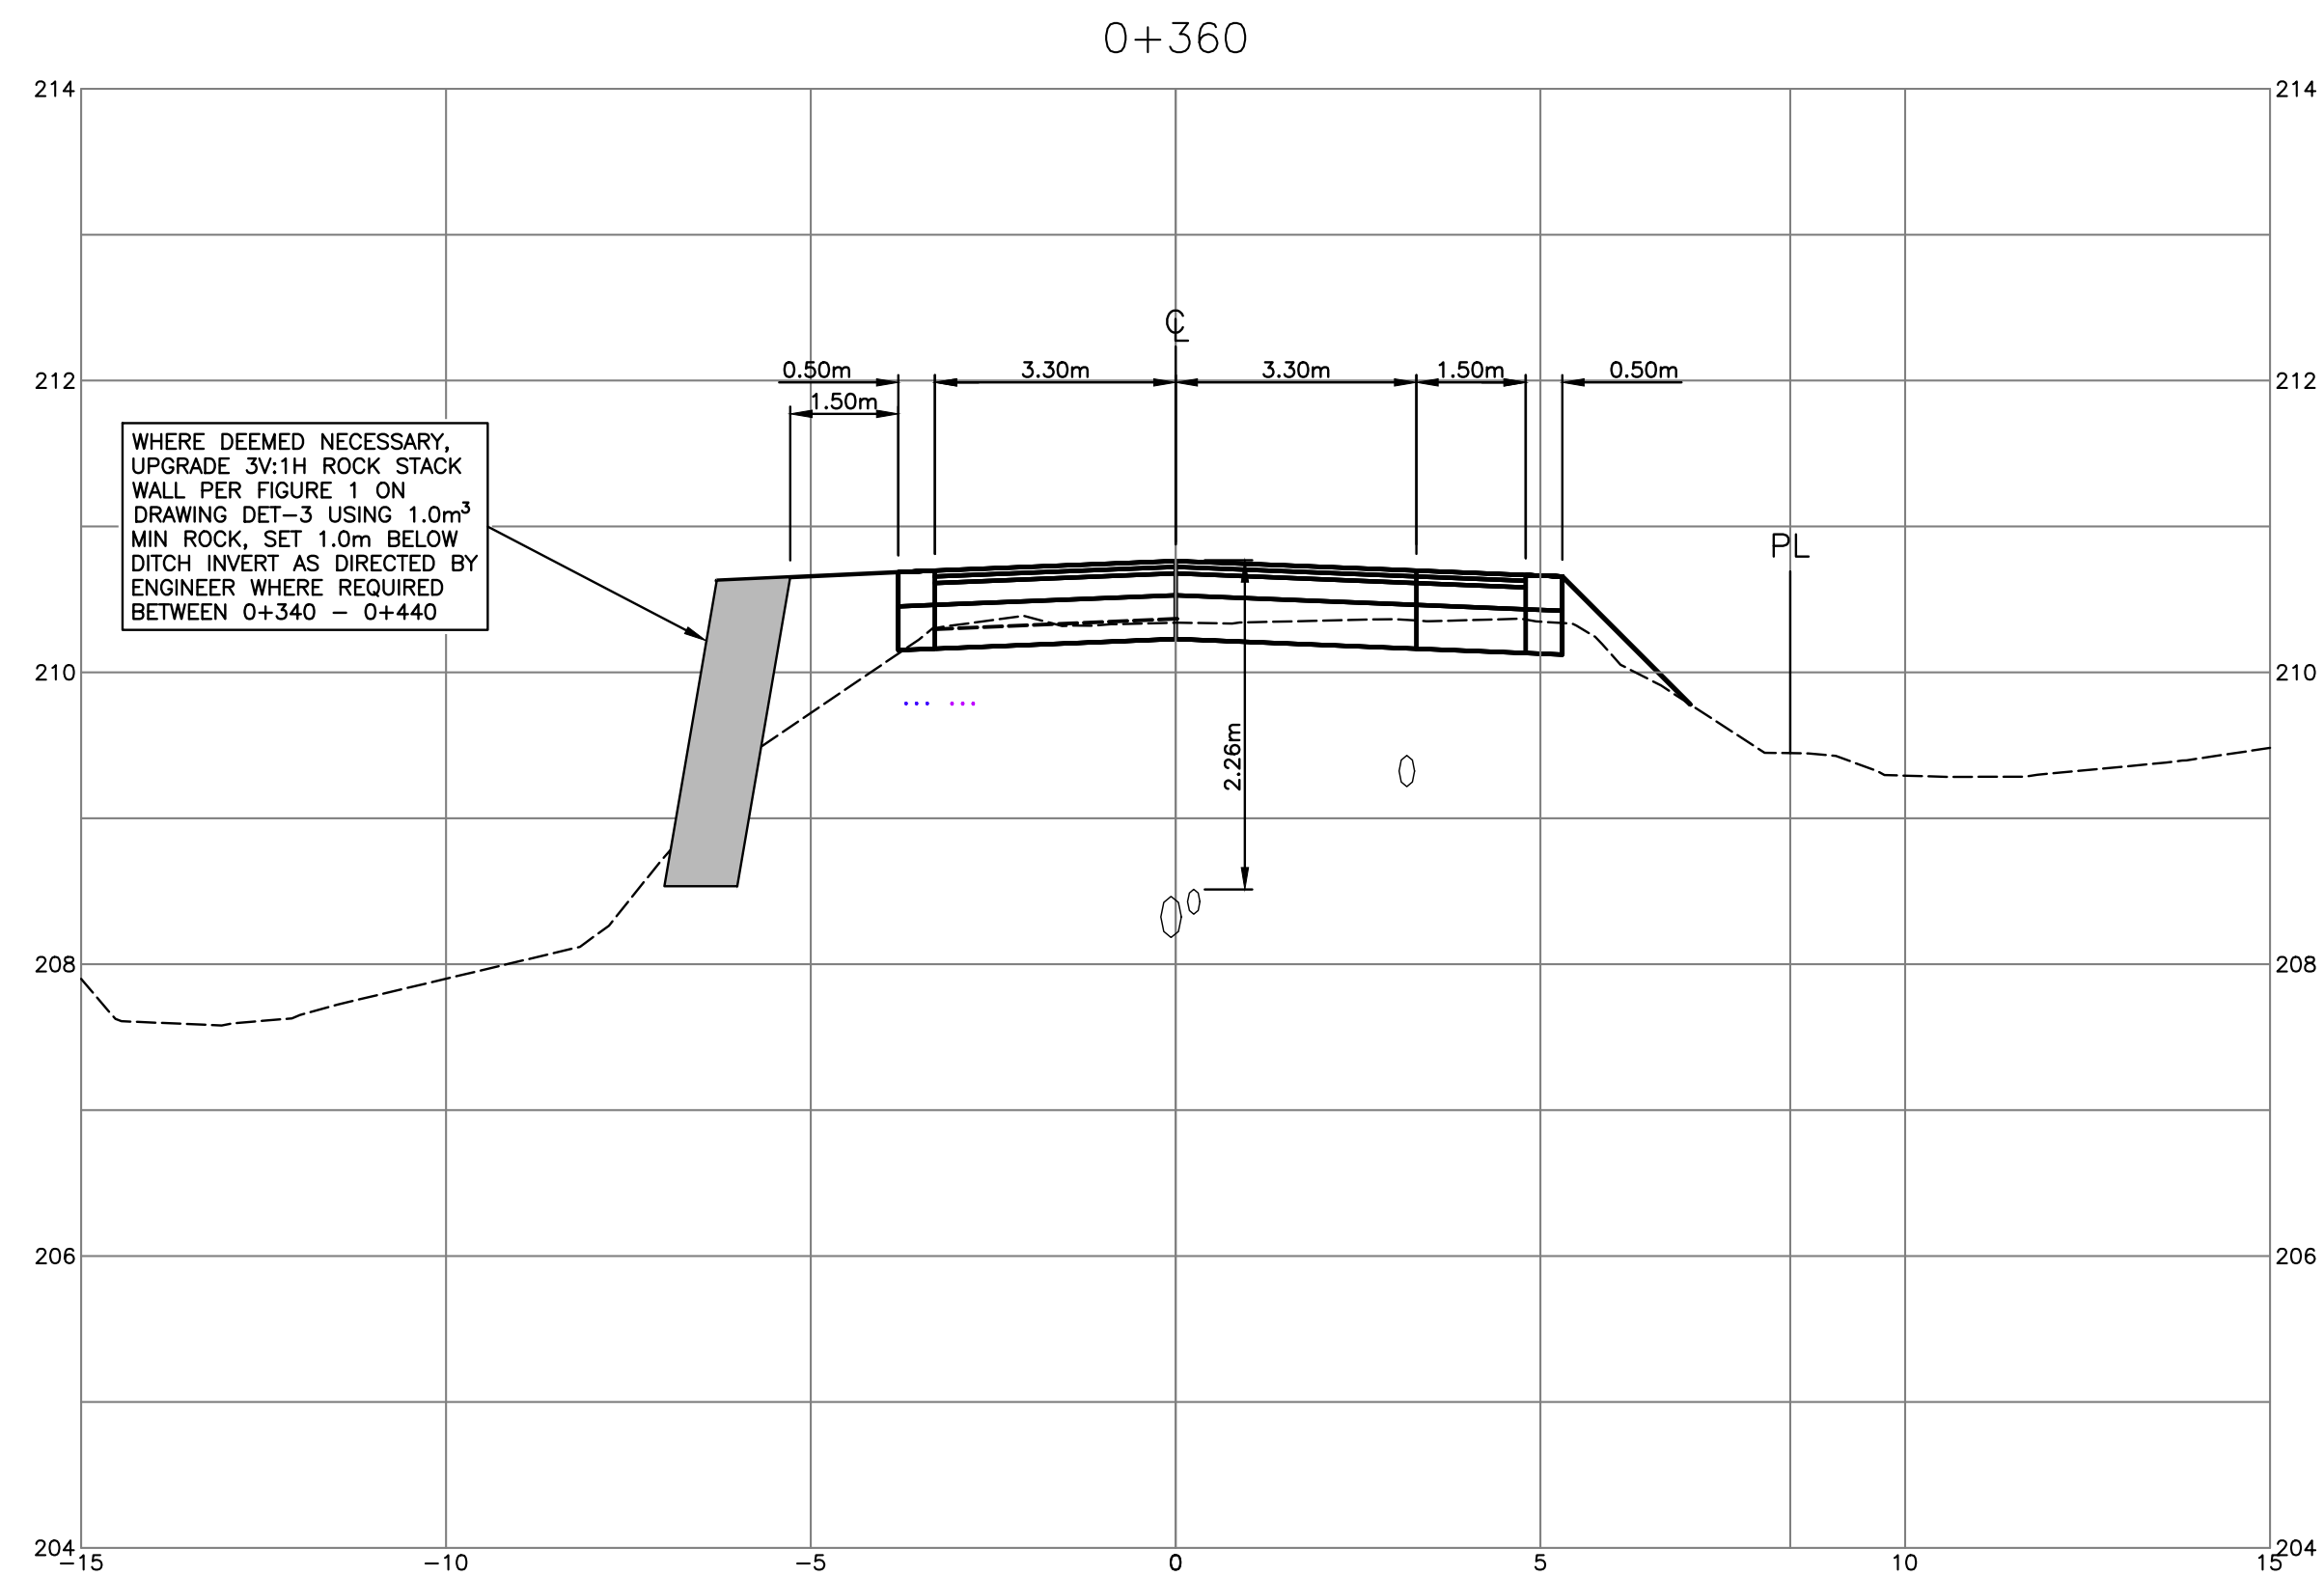



### DRAWING LEGEND

	EXISTING	PROP.	TO BE REMOVED
LEGAL LINE	---	---	---
EASMENT	---	---	---
WATERMAIN	---	---	---
SANITARY	---	---	---
STORM	---	---	---
HYDRO TEL	---	---	---
STREETLIGHT	---	---	---
GAS	---	---	---
FIRE HYDRANT	⊗	⊗	⊗
GATE VALVE	⊗	⊗	⊗
AIR VALVE	⊗	⊗	⊗
REDUCER	⊗	⊗	⊗
INSPECTION CHAMBER	⊗	⊗	⊗
CATCHBASIN (STD/SI)	⊗	⊗	⊗
CAP	⊗	⊗	⊗
MANHOLE	⊗	⊗	⊗
POWER POLE	⊗	⊗	⊗
STREETLIGHT	⊗	⊗	⊗

approved

client  
**580049 BC LTD.**




project  
**THE RIDGE AT PEMBERTON  
 PHASE 1  
 PEMBERTON, BC**

title  
**CROSS SECTIONS  
 OFFSITE ROAD (STA 0+420-0+460)**

no.	(y/m/d)	revision	chn/d
11	18-02-06	PROJECT RECORDS OFFSITE	KBH
10	17-10-17	PROJECT RECORDS OFFSITE	KBH
9	17-09-19	UPDATED OFFSETS	KBH
8	17-08-15	UPDATE WITH HYDRO & TELUS	KBH
7	17-03-07	REISSUED FOR CONSTRUCTION OFFSITE	KBH
6	16-11-09	REISSUED FOR CONSTRUCTION OFFSITE	KBH
5	16-10-26	IFC OFFSITE FINAL COMMENTS	KBH
4	16-10-13	ISSUED FOR CONSTRUCTION OFFSITE	KBH

COPYRIGHT RESERVED. THIS DRAWING AND DESIGN ARE, AND AT ALL TIMES REMAIN THE EXCLUSIVE PROPERTY OF CREUS ENGINEERING LTD. AND CANNOT BE USED, REPRODUCED OR DISTRIBUTED WITHOUT WRITTEN CONSENT.  
 ©2018 CREUS ENGINEERING LTD.

engineer of record	K.B.H.	scales	hor: 1:100 vert: 1:50
designed by	N.G.B.	file no.	<b>16159</b>
drawn by	A.A.P.	drawing no.	<b>X-OS-8</b>
date	2016-05-13		

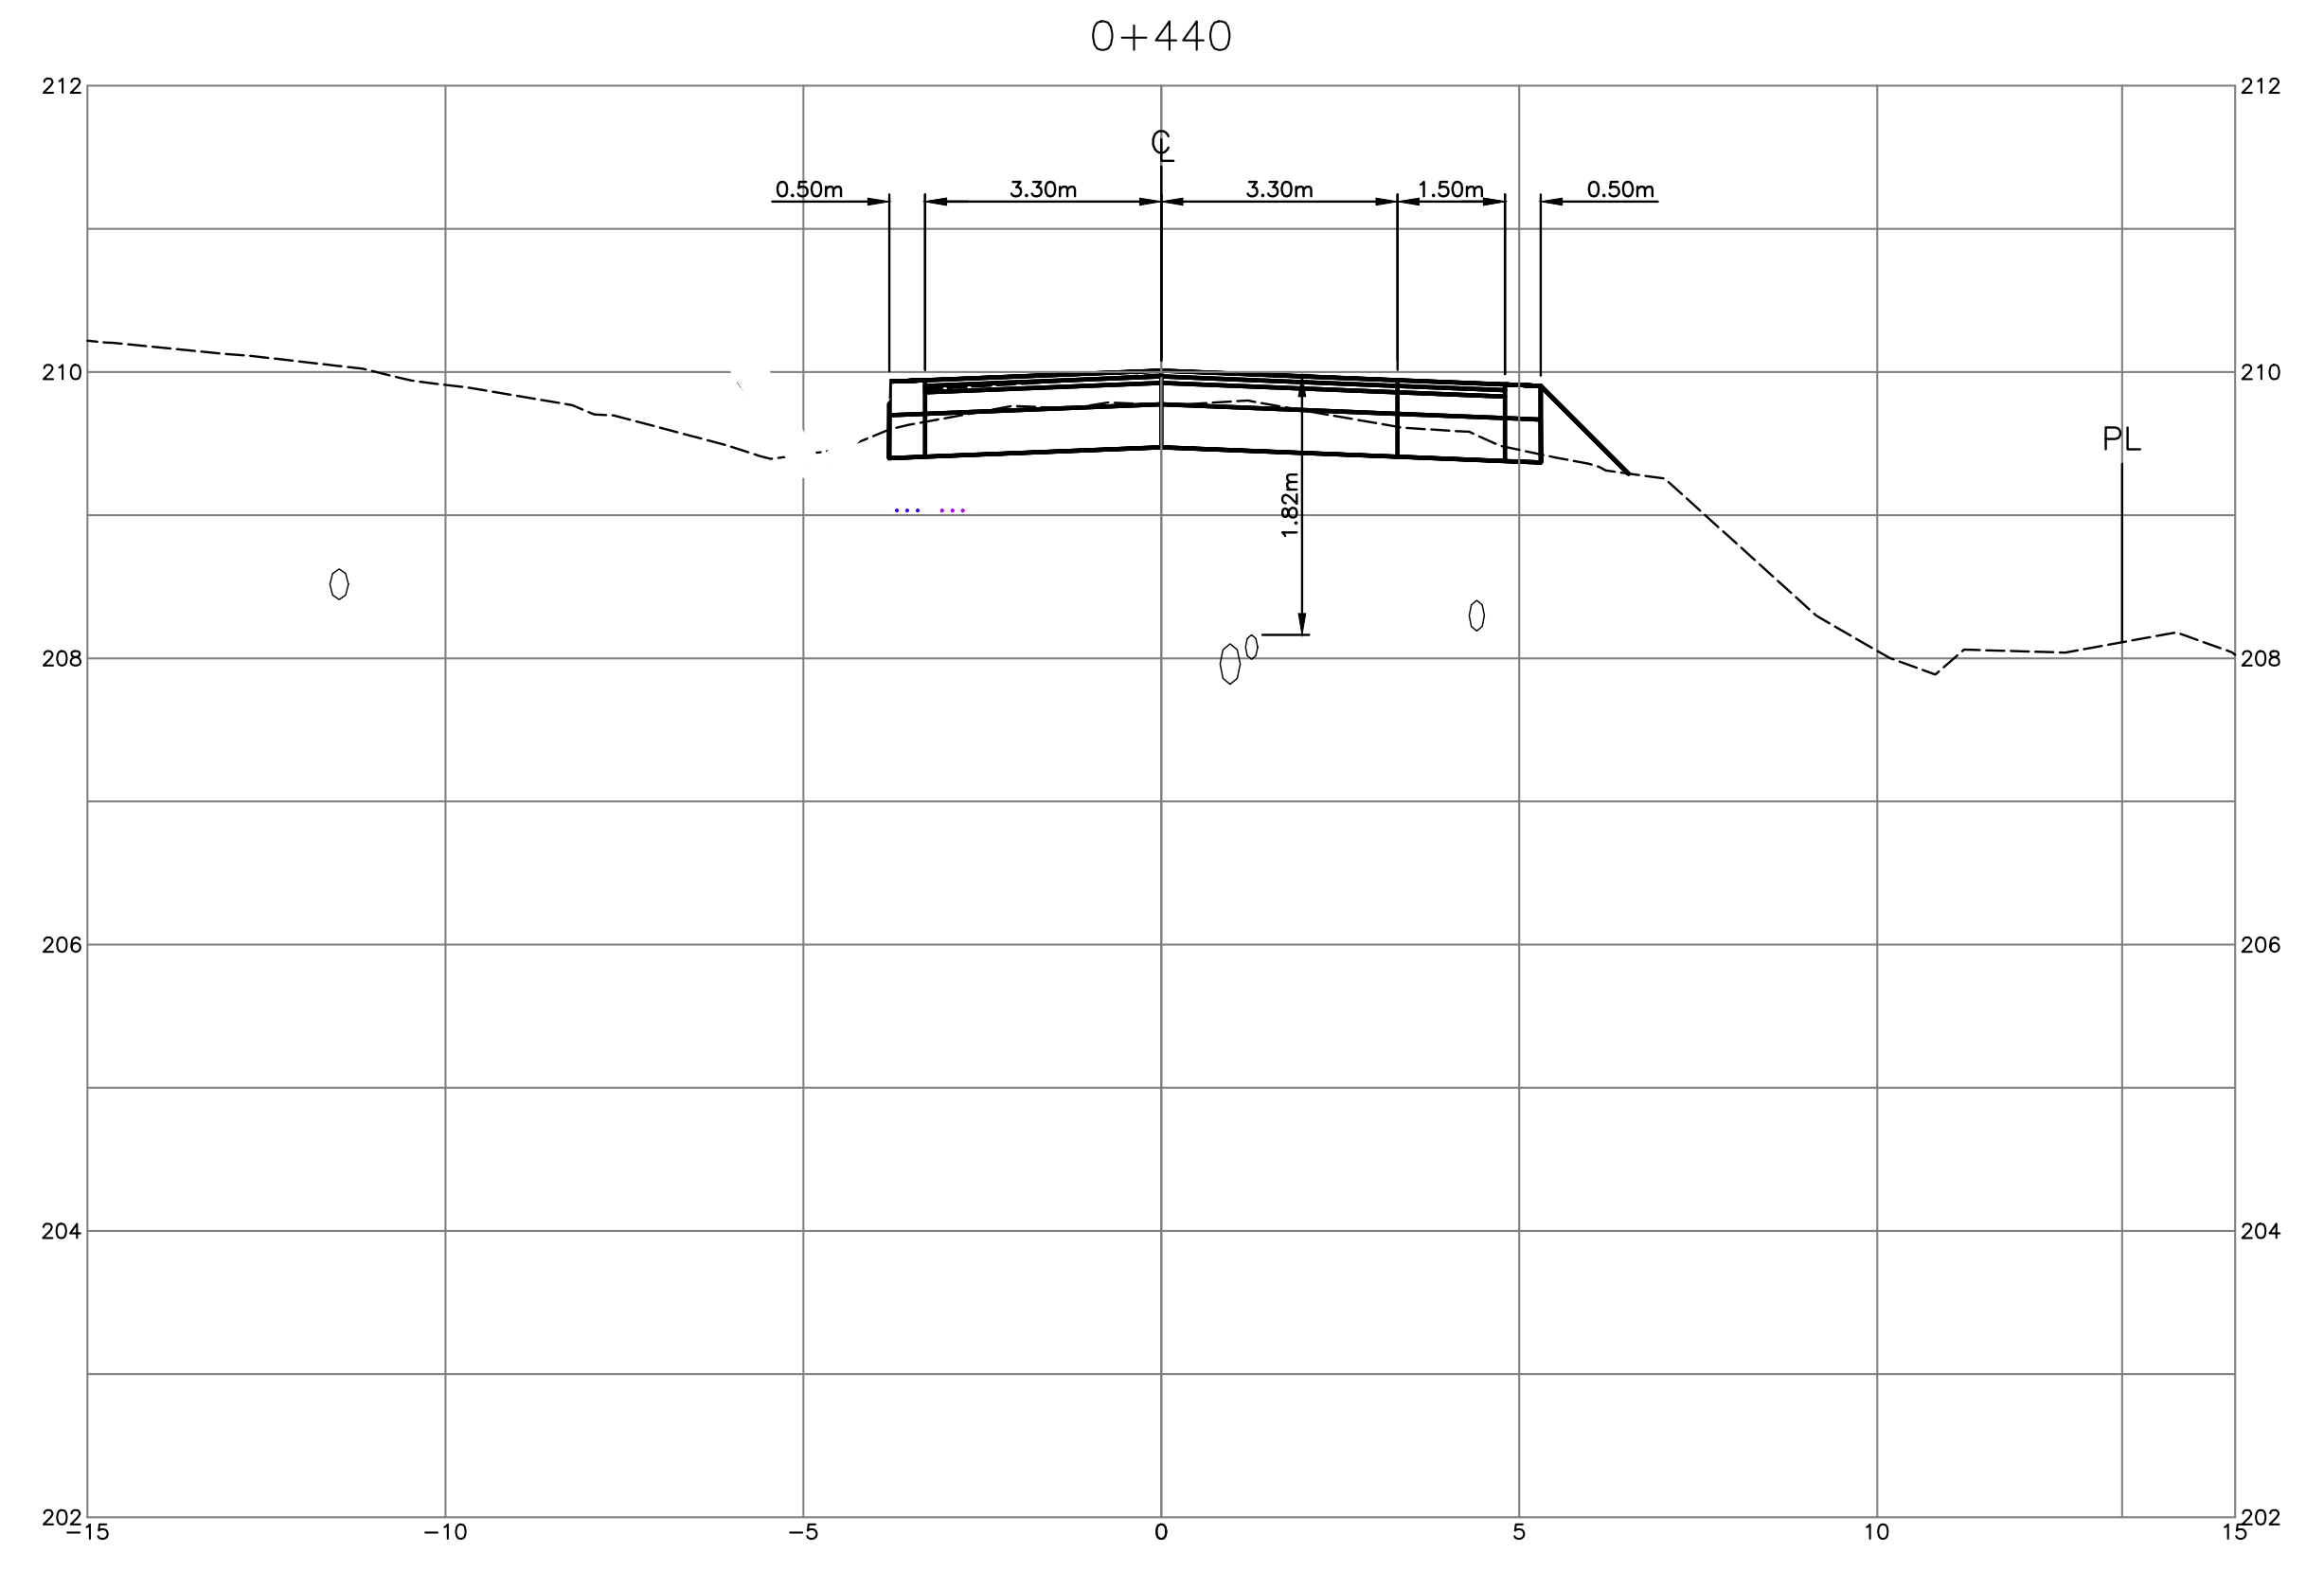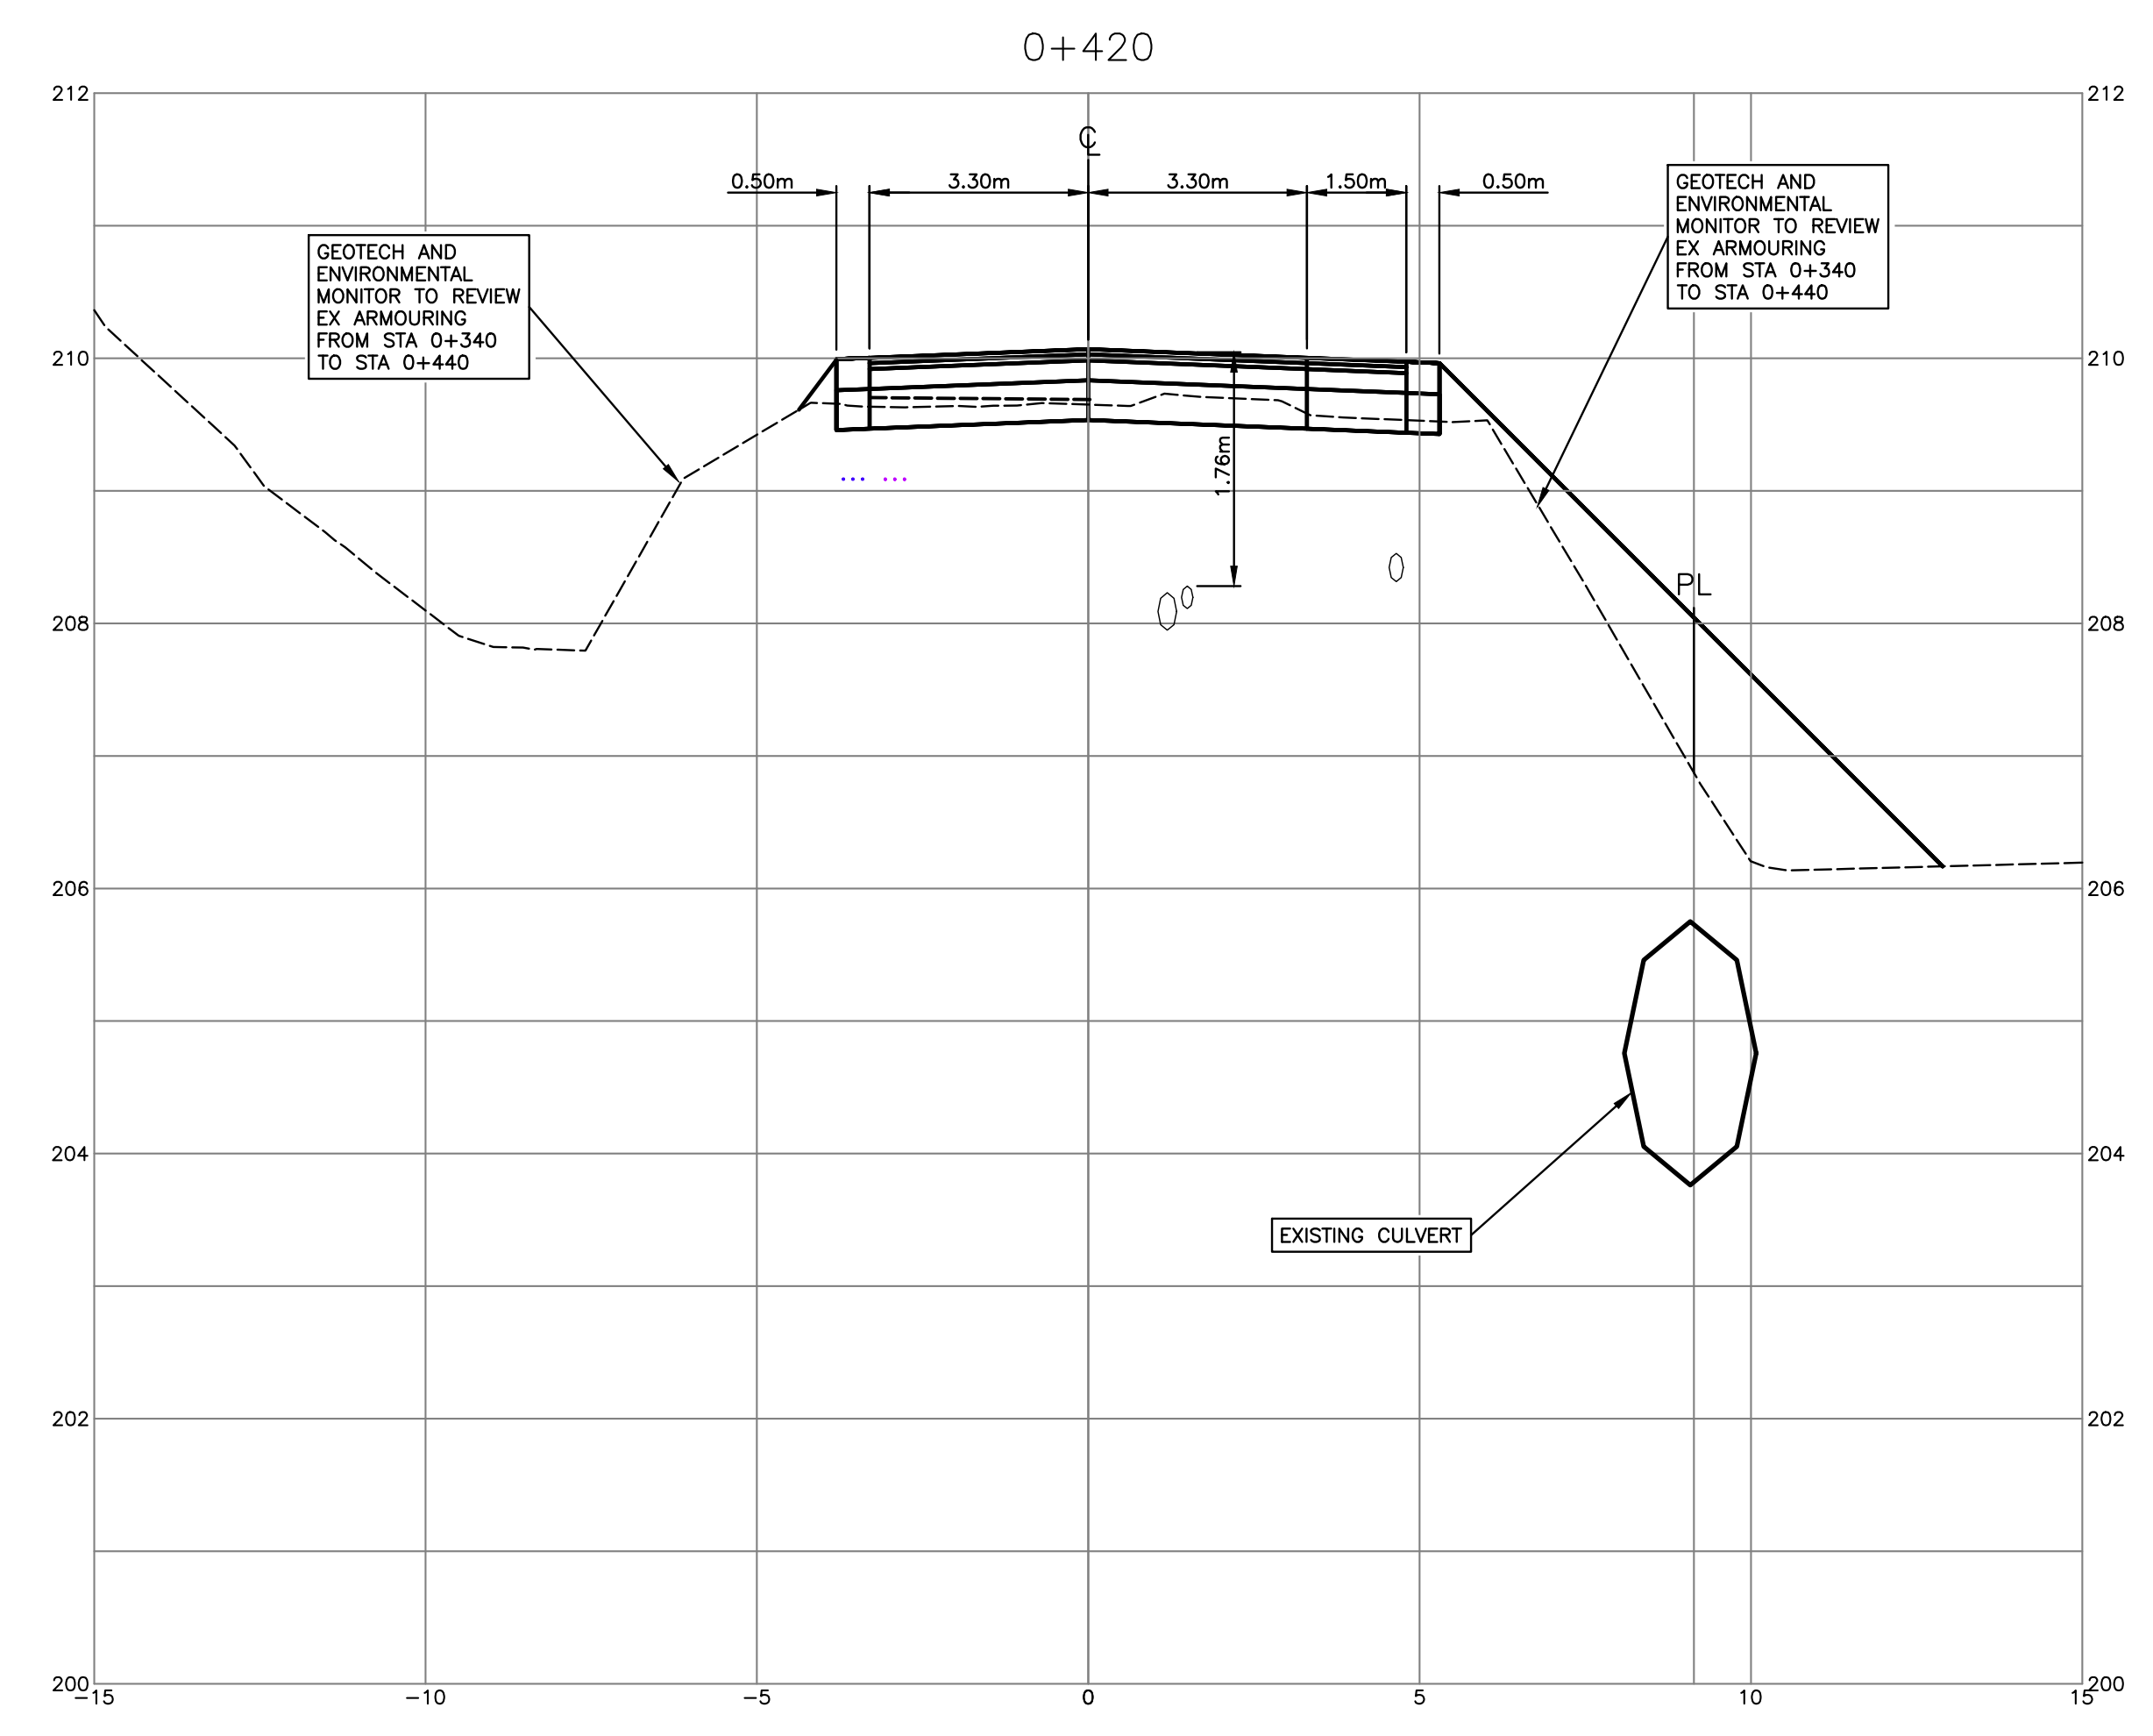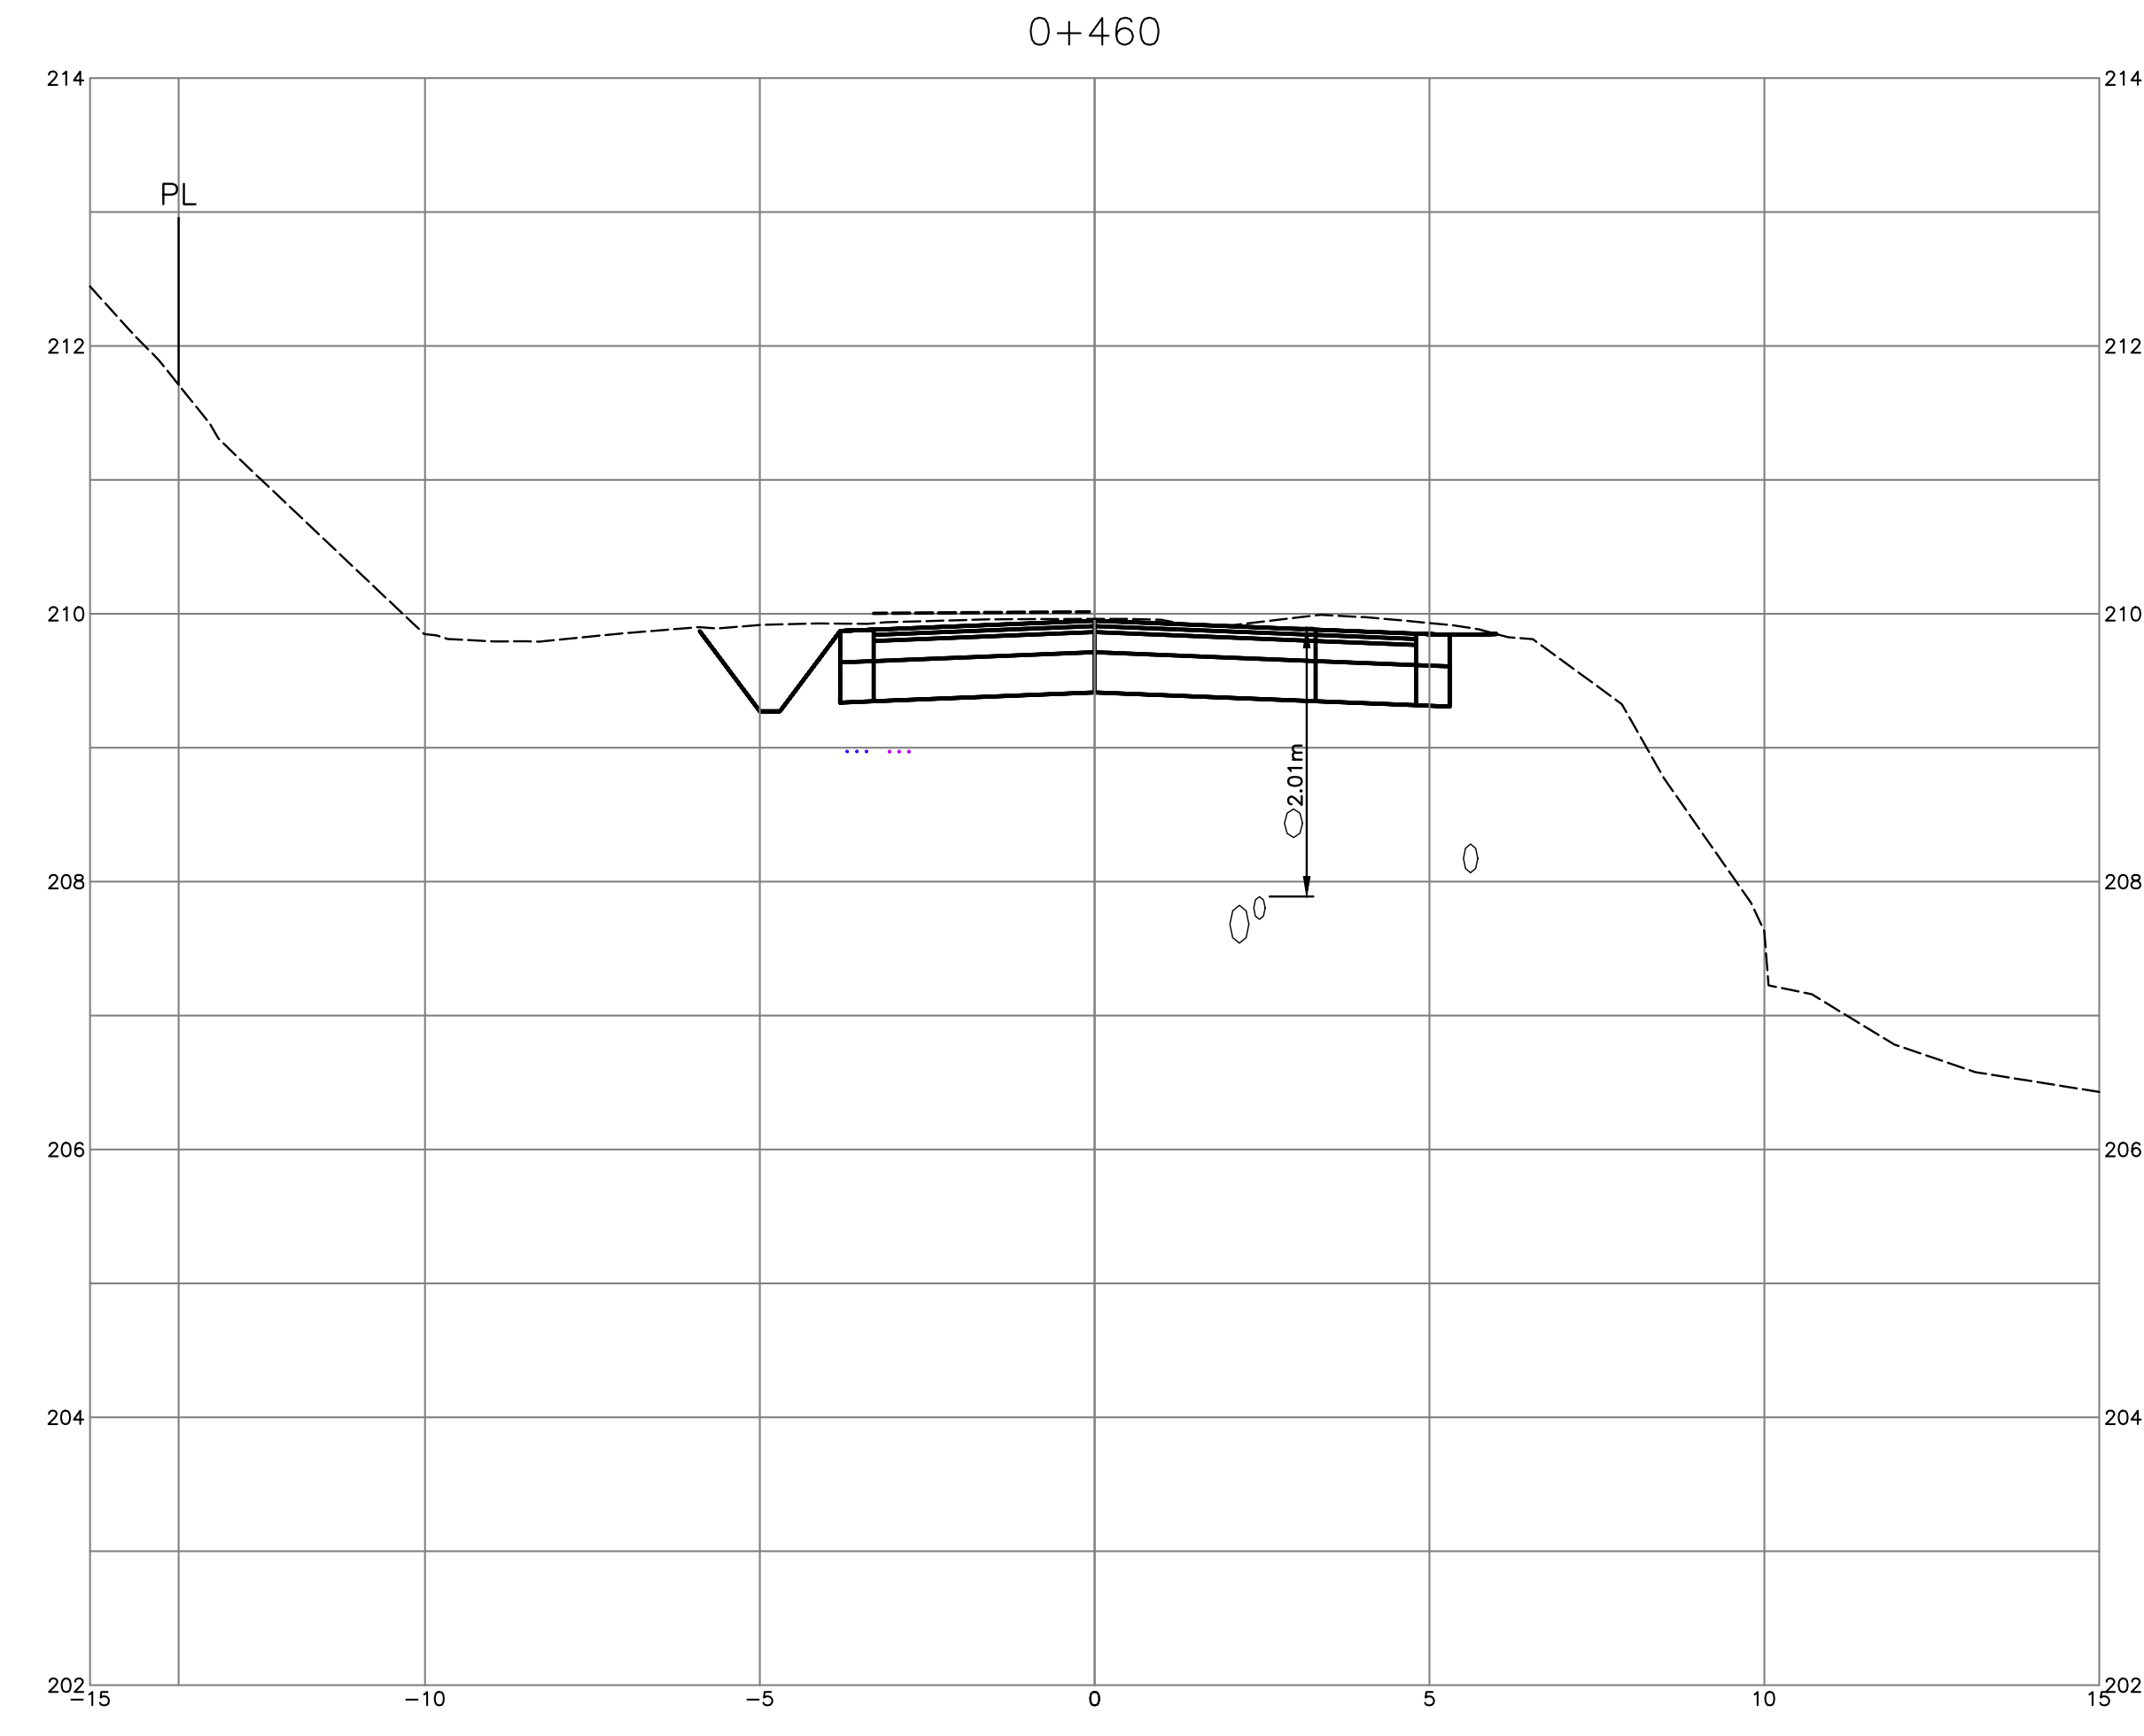



### DRAWING LEGEND

	EXISTING	PROP.	TO BE REMOVED
LEGAL LINE	---	---	---
EASMENT	---	---	---
WATERMAIN	---	---	---
SANITARY	---	---	---
STORM	---	---	---
HYDRO	---	---	---
TEL	---	---	---
STREETLIGHT	---	---	---
GAS	---	---	---
	EXISTING	PROP.	TO BE REMOVED
FIRE HYDRANT	⊗	⊗	⊗
GATE VALVE	⊗	⊗	⊗
AIR VALVE	⊗	⊗	⊗
REDUCER	⊗	⊗	⊗
INSPECTION CHAMBER	⊗	⊗	⊗
CATCHBASIN (STD/SI)	⊗	⊗	⊗
CAP	⊗	⊗	⊗
MANHOLE	⊗	⊗	⊗
POWER POLE	⊗	⊗	⊗
STREETLIGHT	⊗	⊗	⊗

approved

client  
**580049 BC LTD.**



project  
**THE RIDGE AT PEMBERTON  
 PHASE 1  
 PEMBERTON, BC**

title  
**CROSS SECTIONS  
 OFFSITE ROAD (STA 0+480-0+500)**

no.	(y/m/d)	revision	ch/k/d
11	18-02-06	PROJECT RECORDS OFFSITE	KBH
10	17-10-17	PROJECT RECORDS OFFSITE	KBH
9	17-09-19	UPDATED OFFSETS	KBH
8	17-08-15	UPDATE WITH HYDRO & TELLUS	KBH
7	17-03-07	REISSUED FOR CONSTRUCTION OFFSITE	KBH
6	16-11-09	REISSUED FOR CONSTRUCTION OFFSITE	KBH
5	16-10-26	IFC OFFSITE FINAL COMMENTS	KBH
4	16-10-13	ISSUED FOR CONSTRUCTION OFFSITE	KBH

copyright reserved. THIS DRAWING AND DESIGN ARE, AND AT ALL TIMES REMAIN THE EXCLUSIVE PROPERTY OF CREUS ENGINEERING LTD. AND CANNOT BE USED, REPRODUCED OR DISTRIBUTED WITHOUT WRITTEN CONSENT.  
 © 2016 CREUS ENGINEERING LTD.

engineer of record	file no.
K.B.H.	16159
designed by	drawn by
N.G.B.	A.A.P.
date	2016-05-13
hor: 1:100	vert: 1:50
drawing no.	X-OS-9

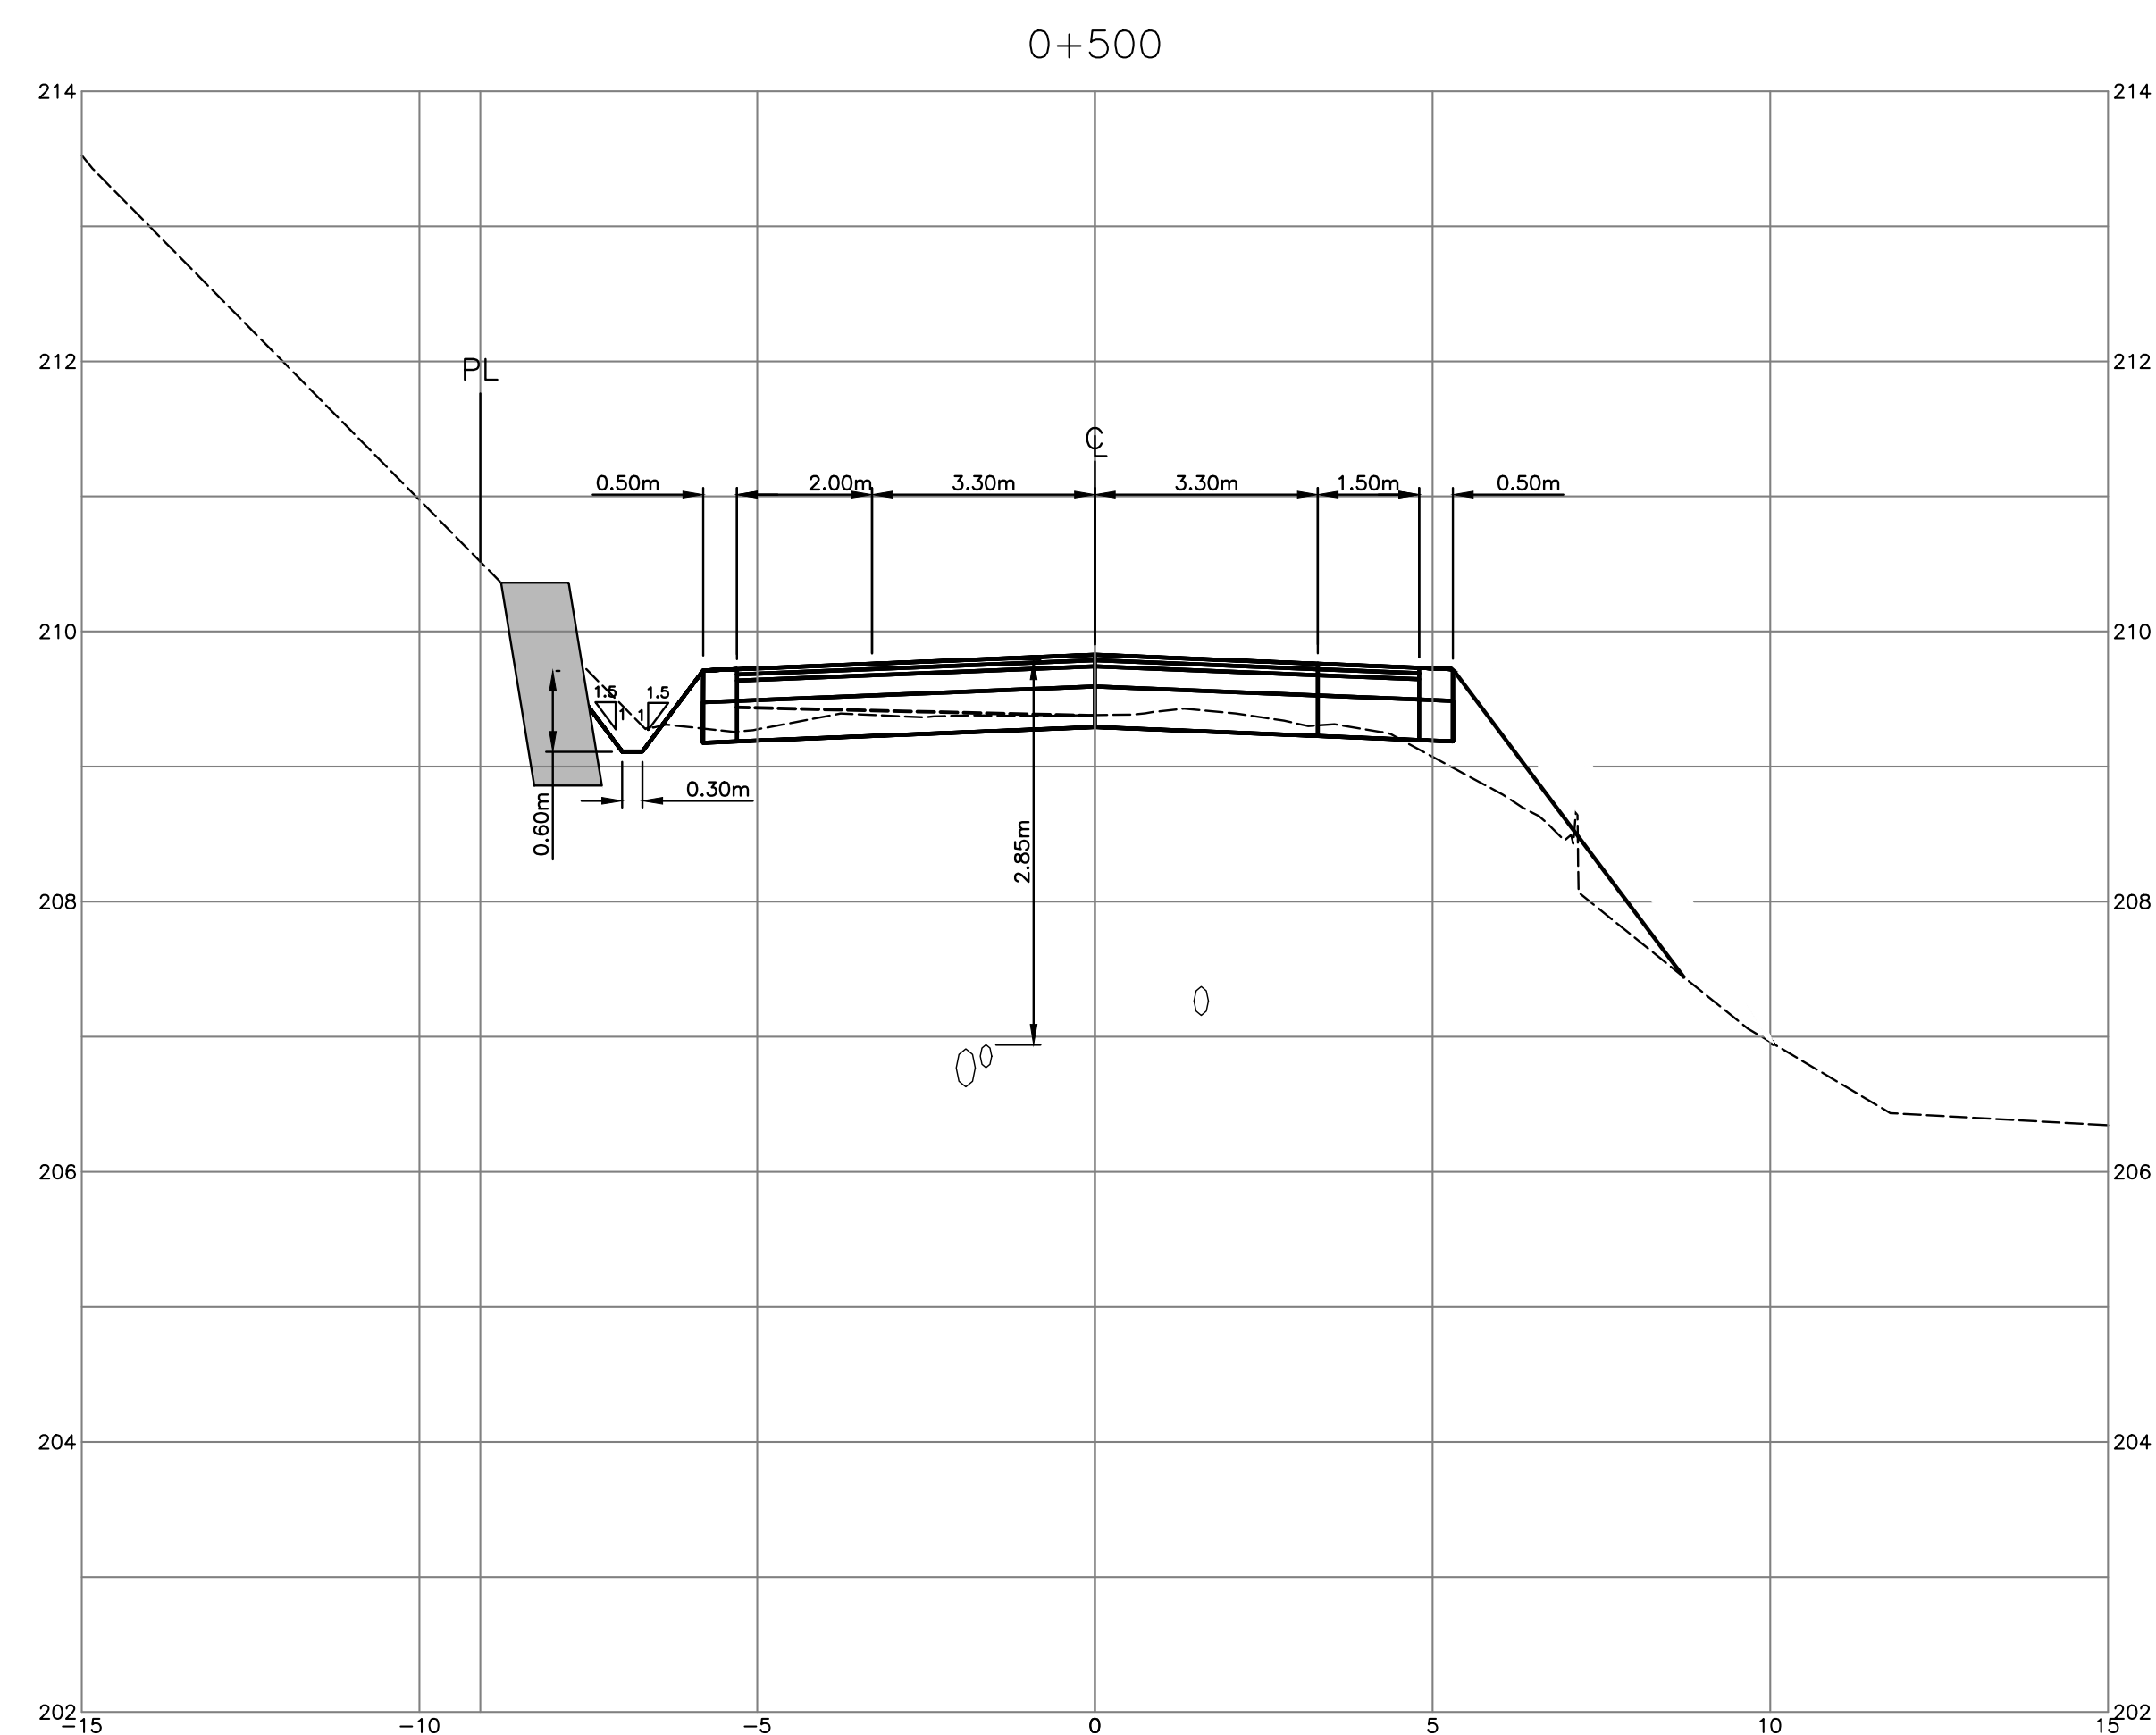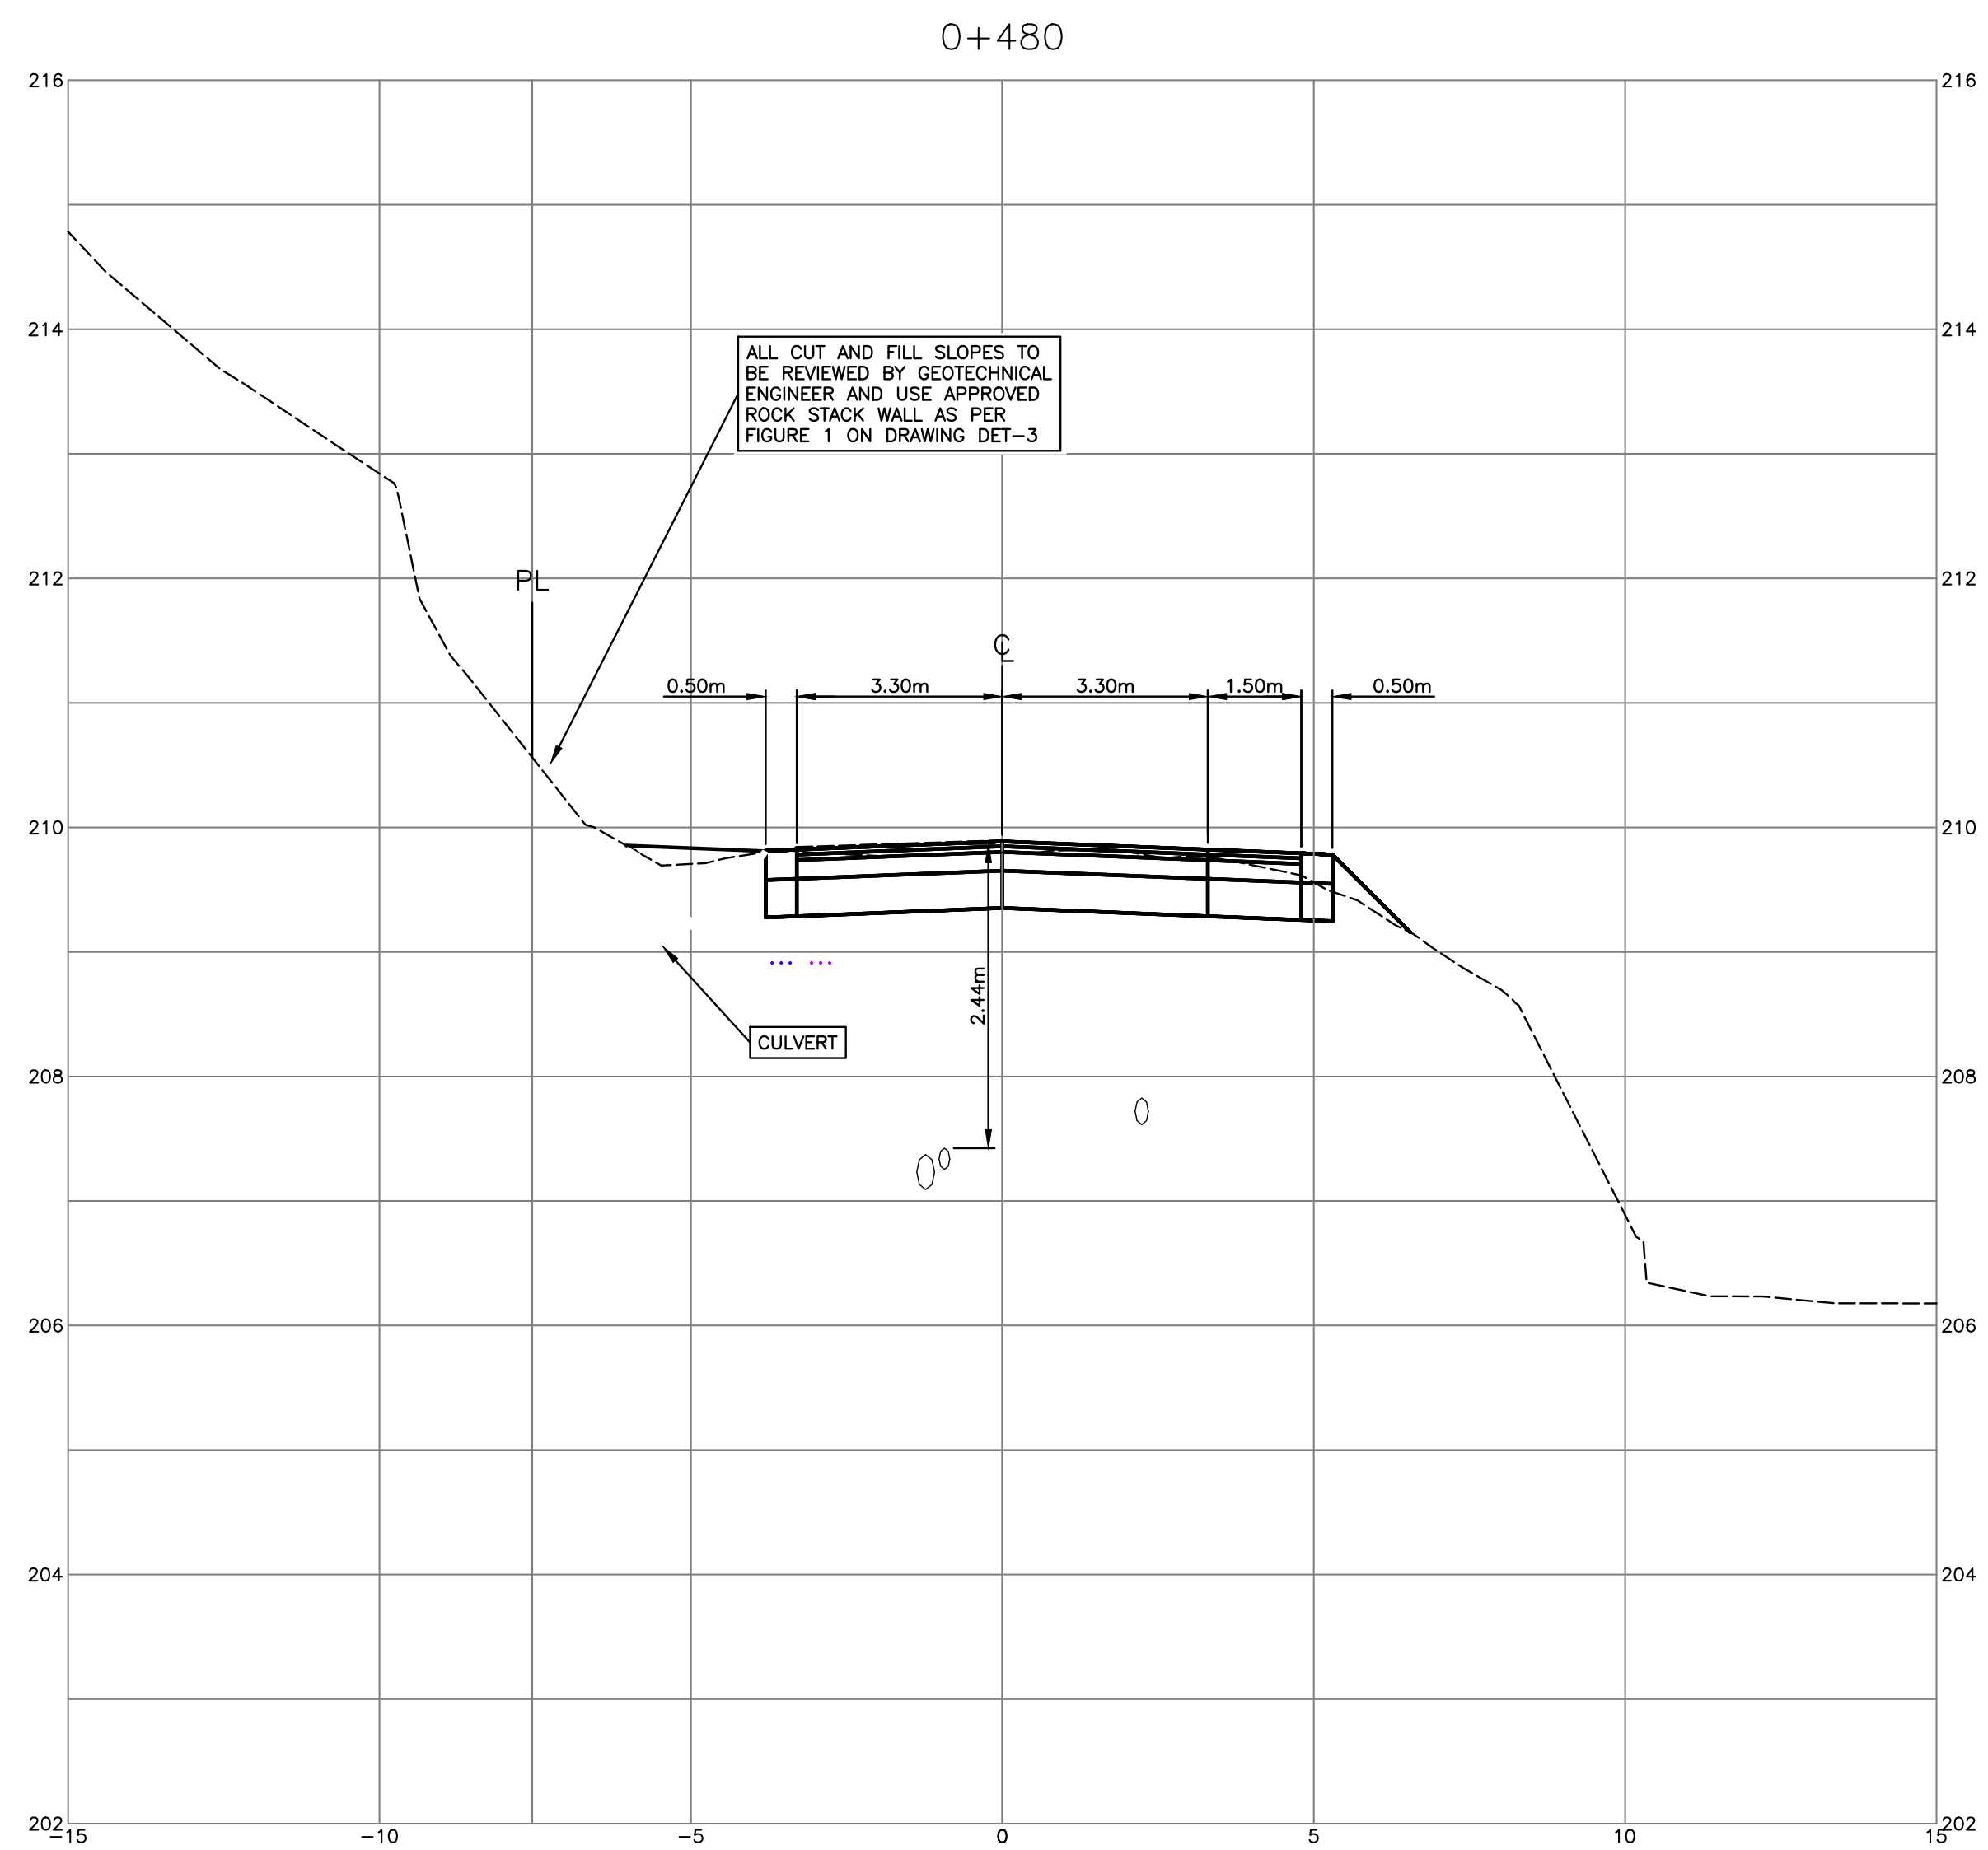



### DRAWING LEGEND

	EXISTING	PROP.	TO BE REMOVED
LEGAL LINE	---	---	---
EASMENT	---	---	---
WATERMAIN	---	---	---
SANITARY	---	---	---
STORM	---	---	---
HYDRO	---	---	---
TEL.	---	---	---
STREETLIGHT	---	---	---
GAS	---	---	---
FIRE HYDRANT	⊗	⊗	⊗
GATE VALVE	⊗	⊗	⊗
AIR VALVE	⊗	⊗	⊗
REDUCER	⊗	⊗	⊗
INSPECTION CHAMBER	⊗	⊗	⊗
CATCHBASIN (STD/SI)	⊗	⊗	⊗
CAP	⊗	⊗	⊗
MANHOLE	⊗	⊗	⊗
POWER POLE	⊗	⊗	⊗
STREETLIGHT	⊗	⊗	⊗

approved

client

580049 BC LTD.

project

THE RIDGE AT PEMBERTON  
 PHASE 1  
 PEMBERTON, BC



title

CROSS SECTIONS  
 OFFSITE ROAD (STA 0+520-0+540)



no.	(y/m/d)	revision	chk'd
11	18-02-06	PROJECT RECORDS OFFSITE	KBH
10	17-10-17	PROJECT RECORDS OFFSITE	KBH
9	17-09-19	UPDATED OFFSETS	KBH
8	17-08-15	UPDATE WITH HYDRO & TELLUS	KBH
7	17-03-07	REISSUED FOR CONSTRUCTION OFFSITE	KBH
6	16-11-09	REISSUED FOR CONSTRUCTION OFFSITE	KBH
5	16-10-26	IFC OFFSITE FINAL COMMENTS	KBH
4	16-10-13	ISSUED FOR CONSTRUCTION OFFSITE	KBH

COPYRIGHT RESERVED. THIS DRAWING AND DESIGN ARE, AND AT ALL TIMES REMAIN THE EXCLUSIVE PROPERTY OF CREUS ENGINEERING LTD. AND CANNOT BE USED, REPRODUCED OR DISTRIBUTED WITHOUT WRITTEN CONSENT.  
 © 2018 CREUS ENGINEERING LTD.

engineer of record: K.B.H. scales: hor: 1:100 vert: 1:50  
 designed by: N.G.B. file no.: 16159  
 drawn by: A.A.P. drawing no.: X-OS-10  
 date: 2016-05-13

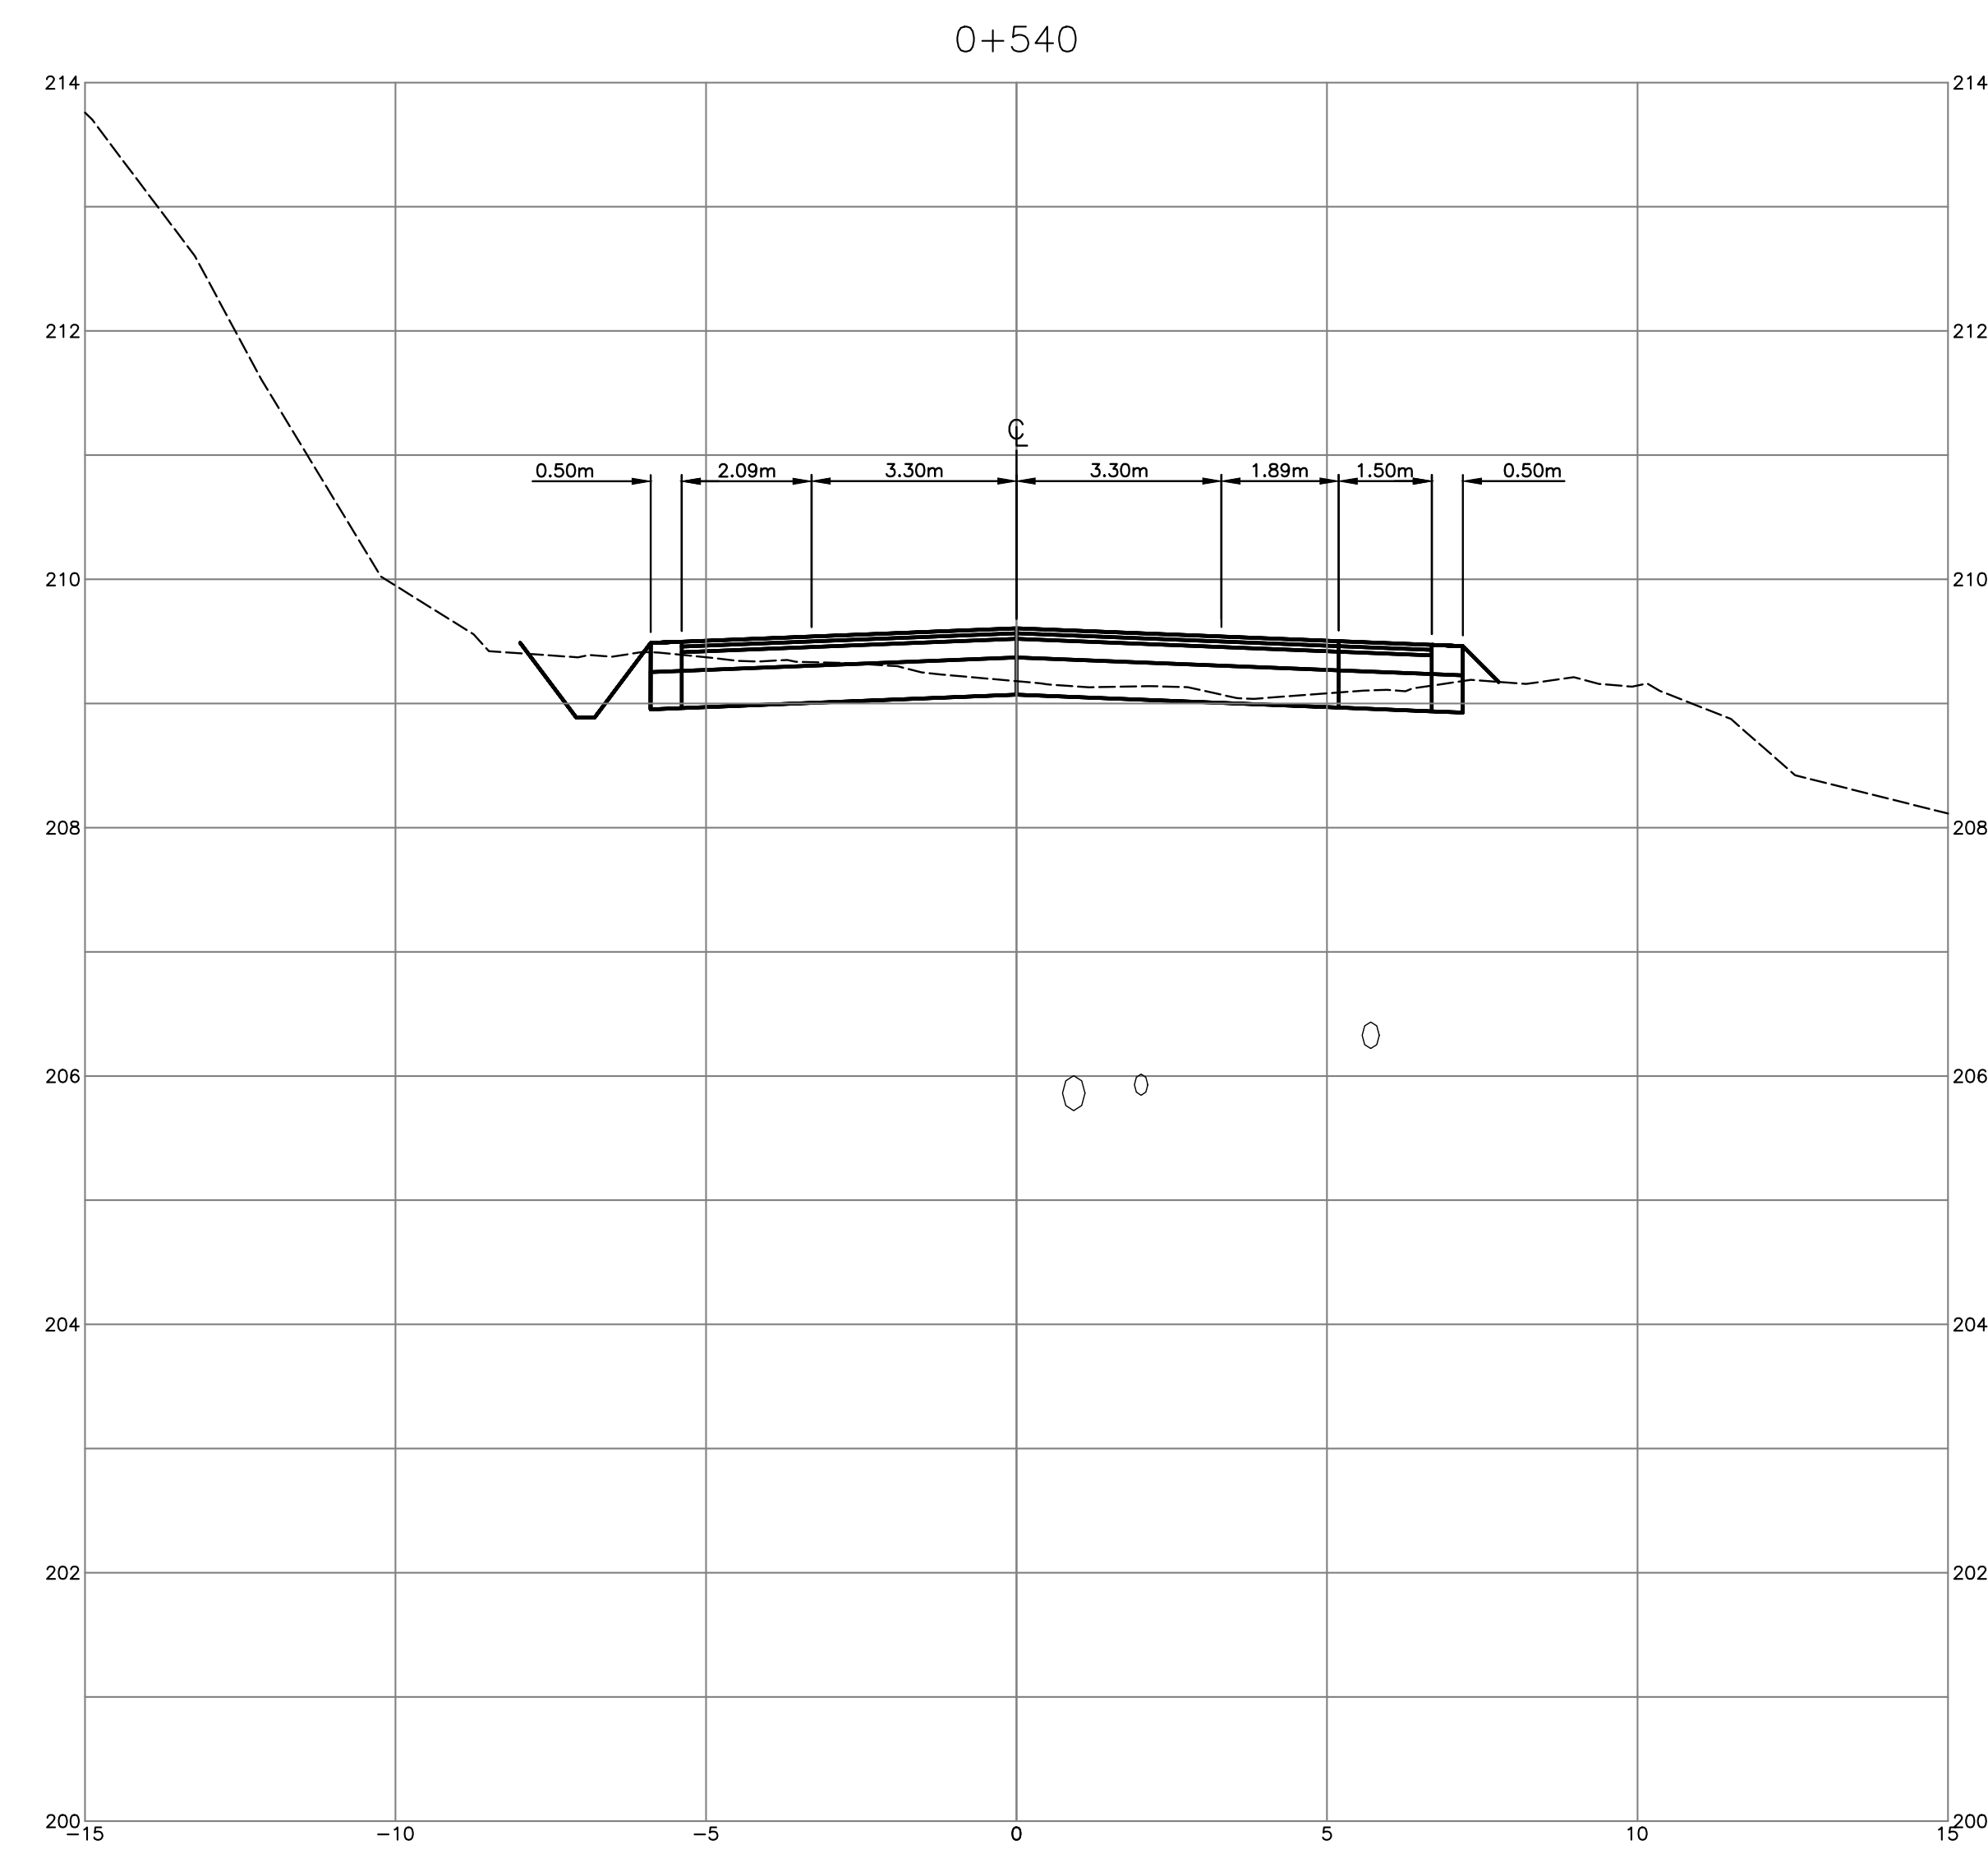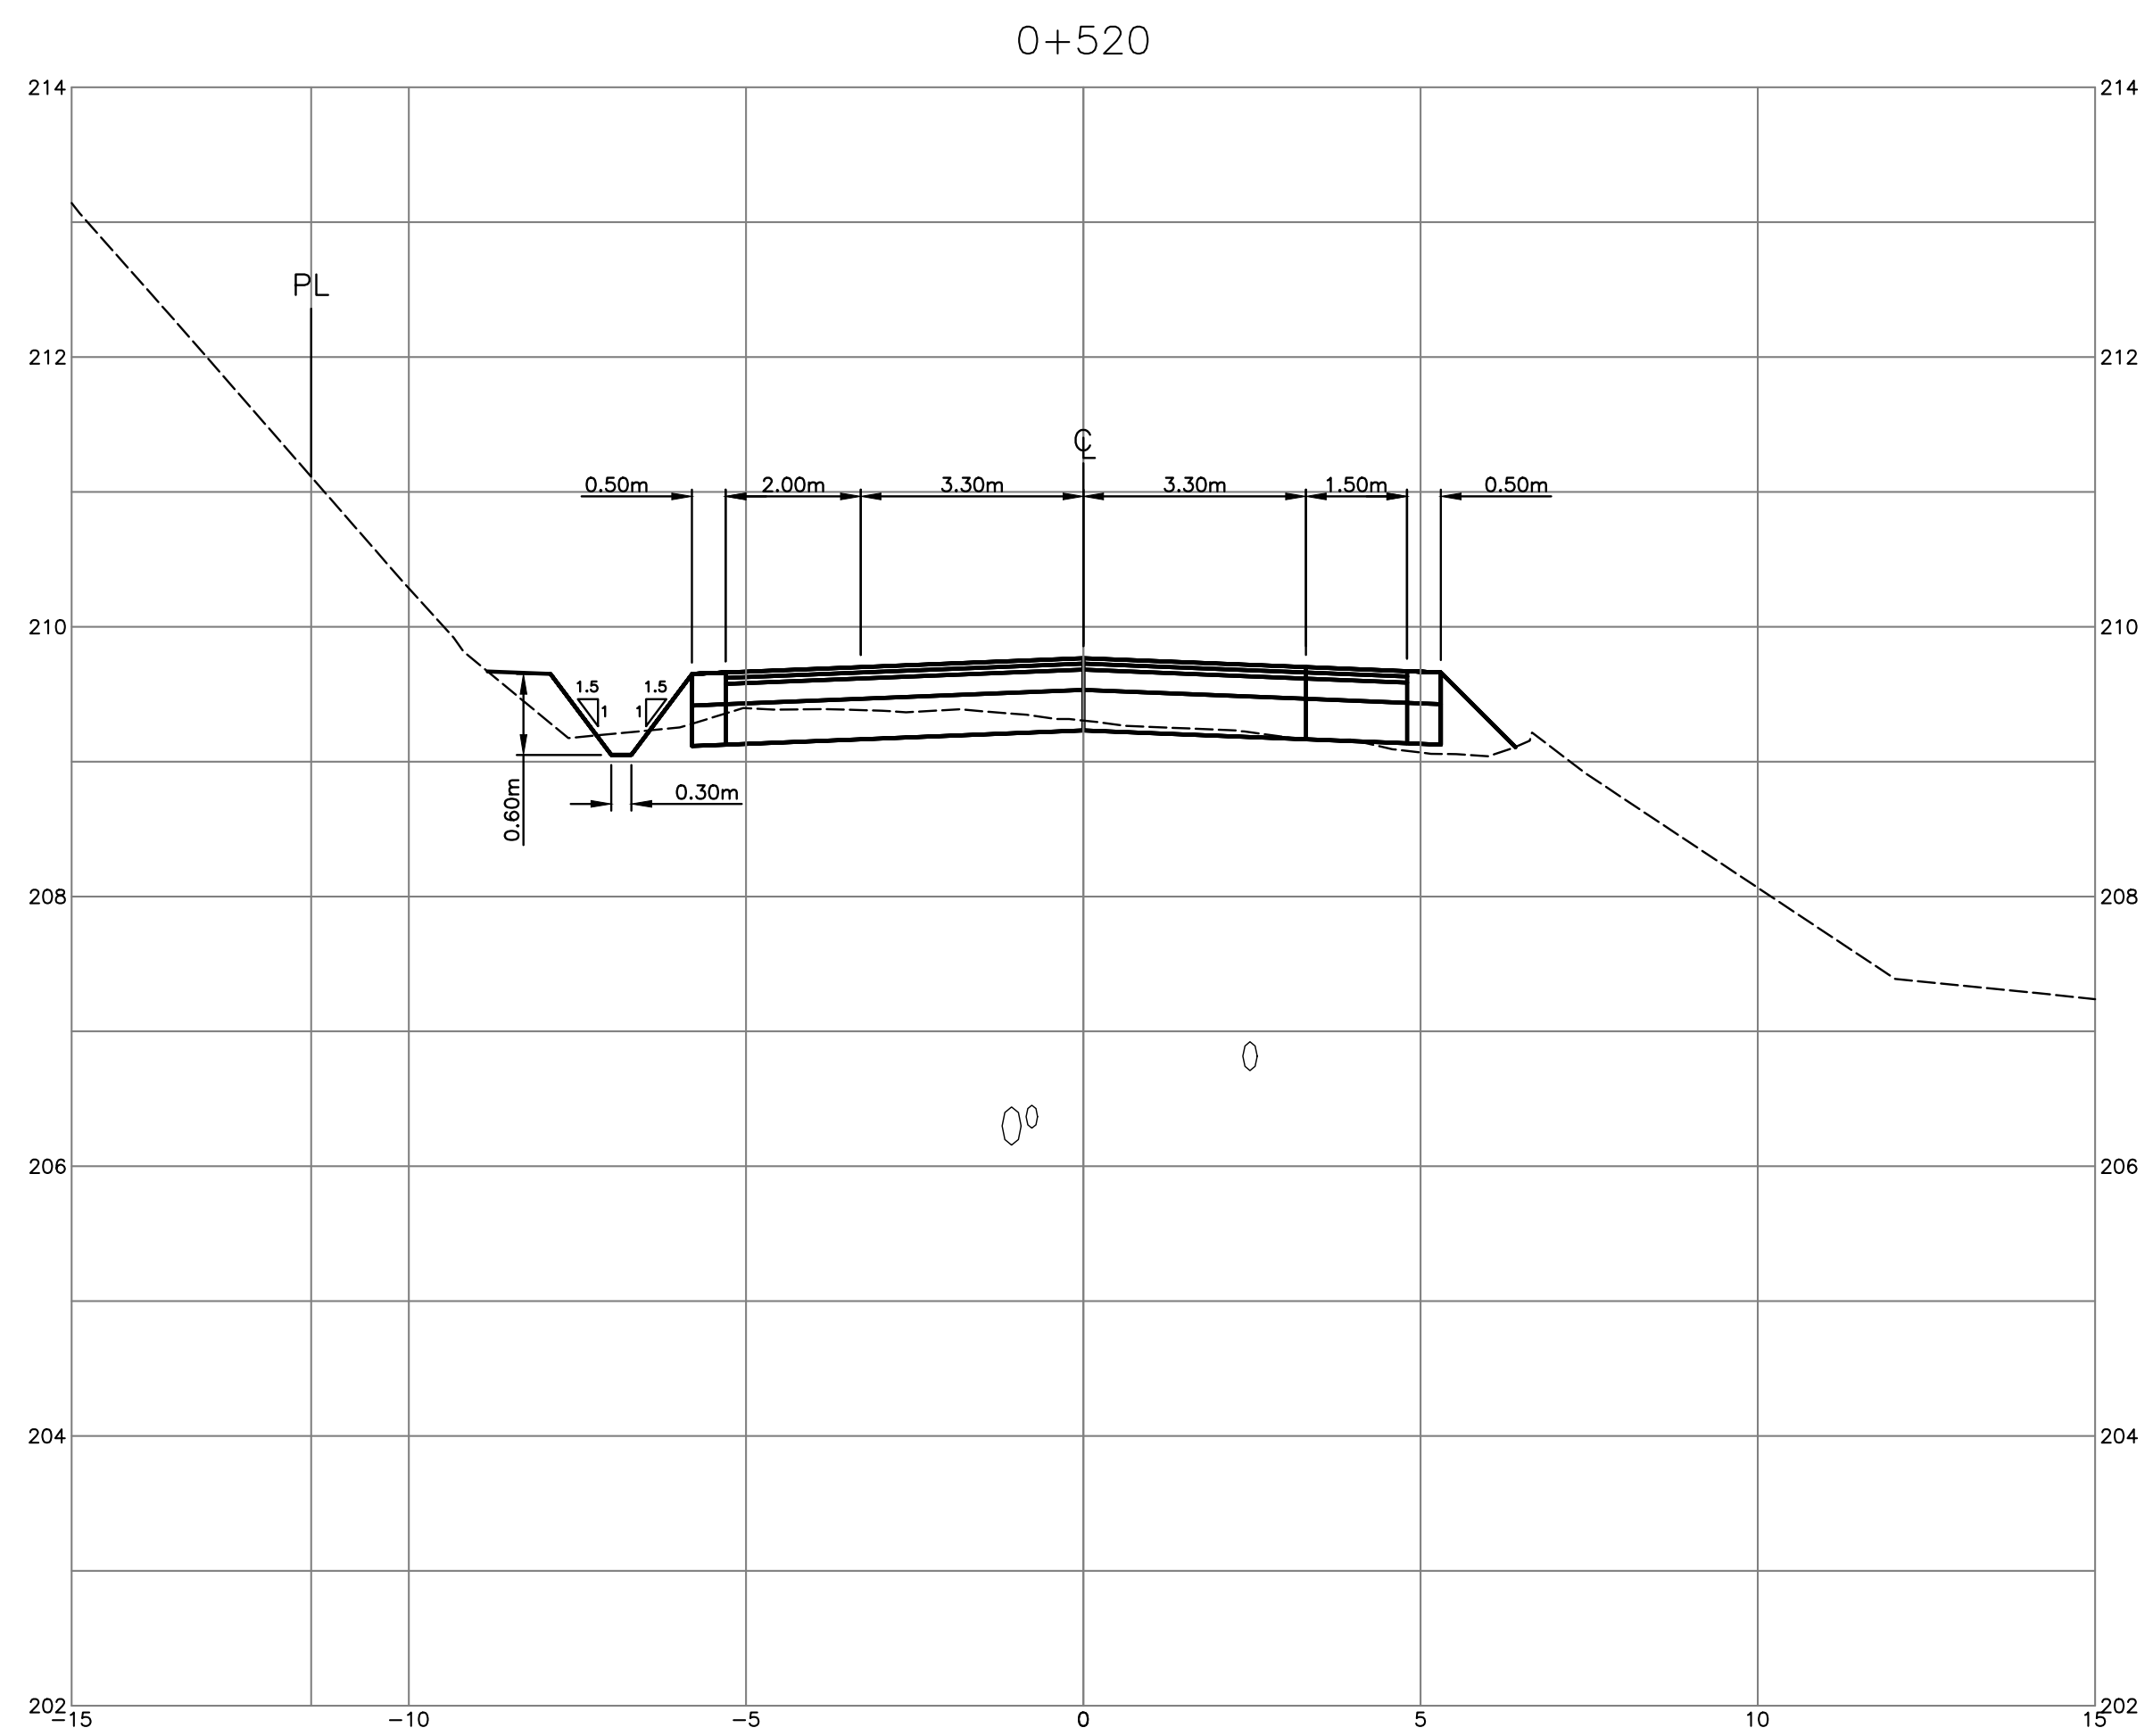



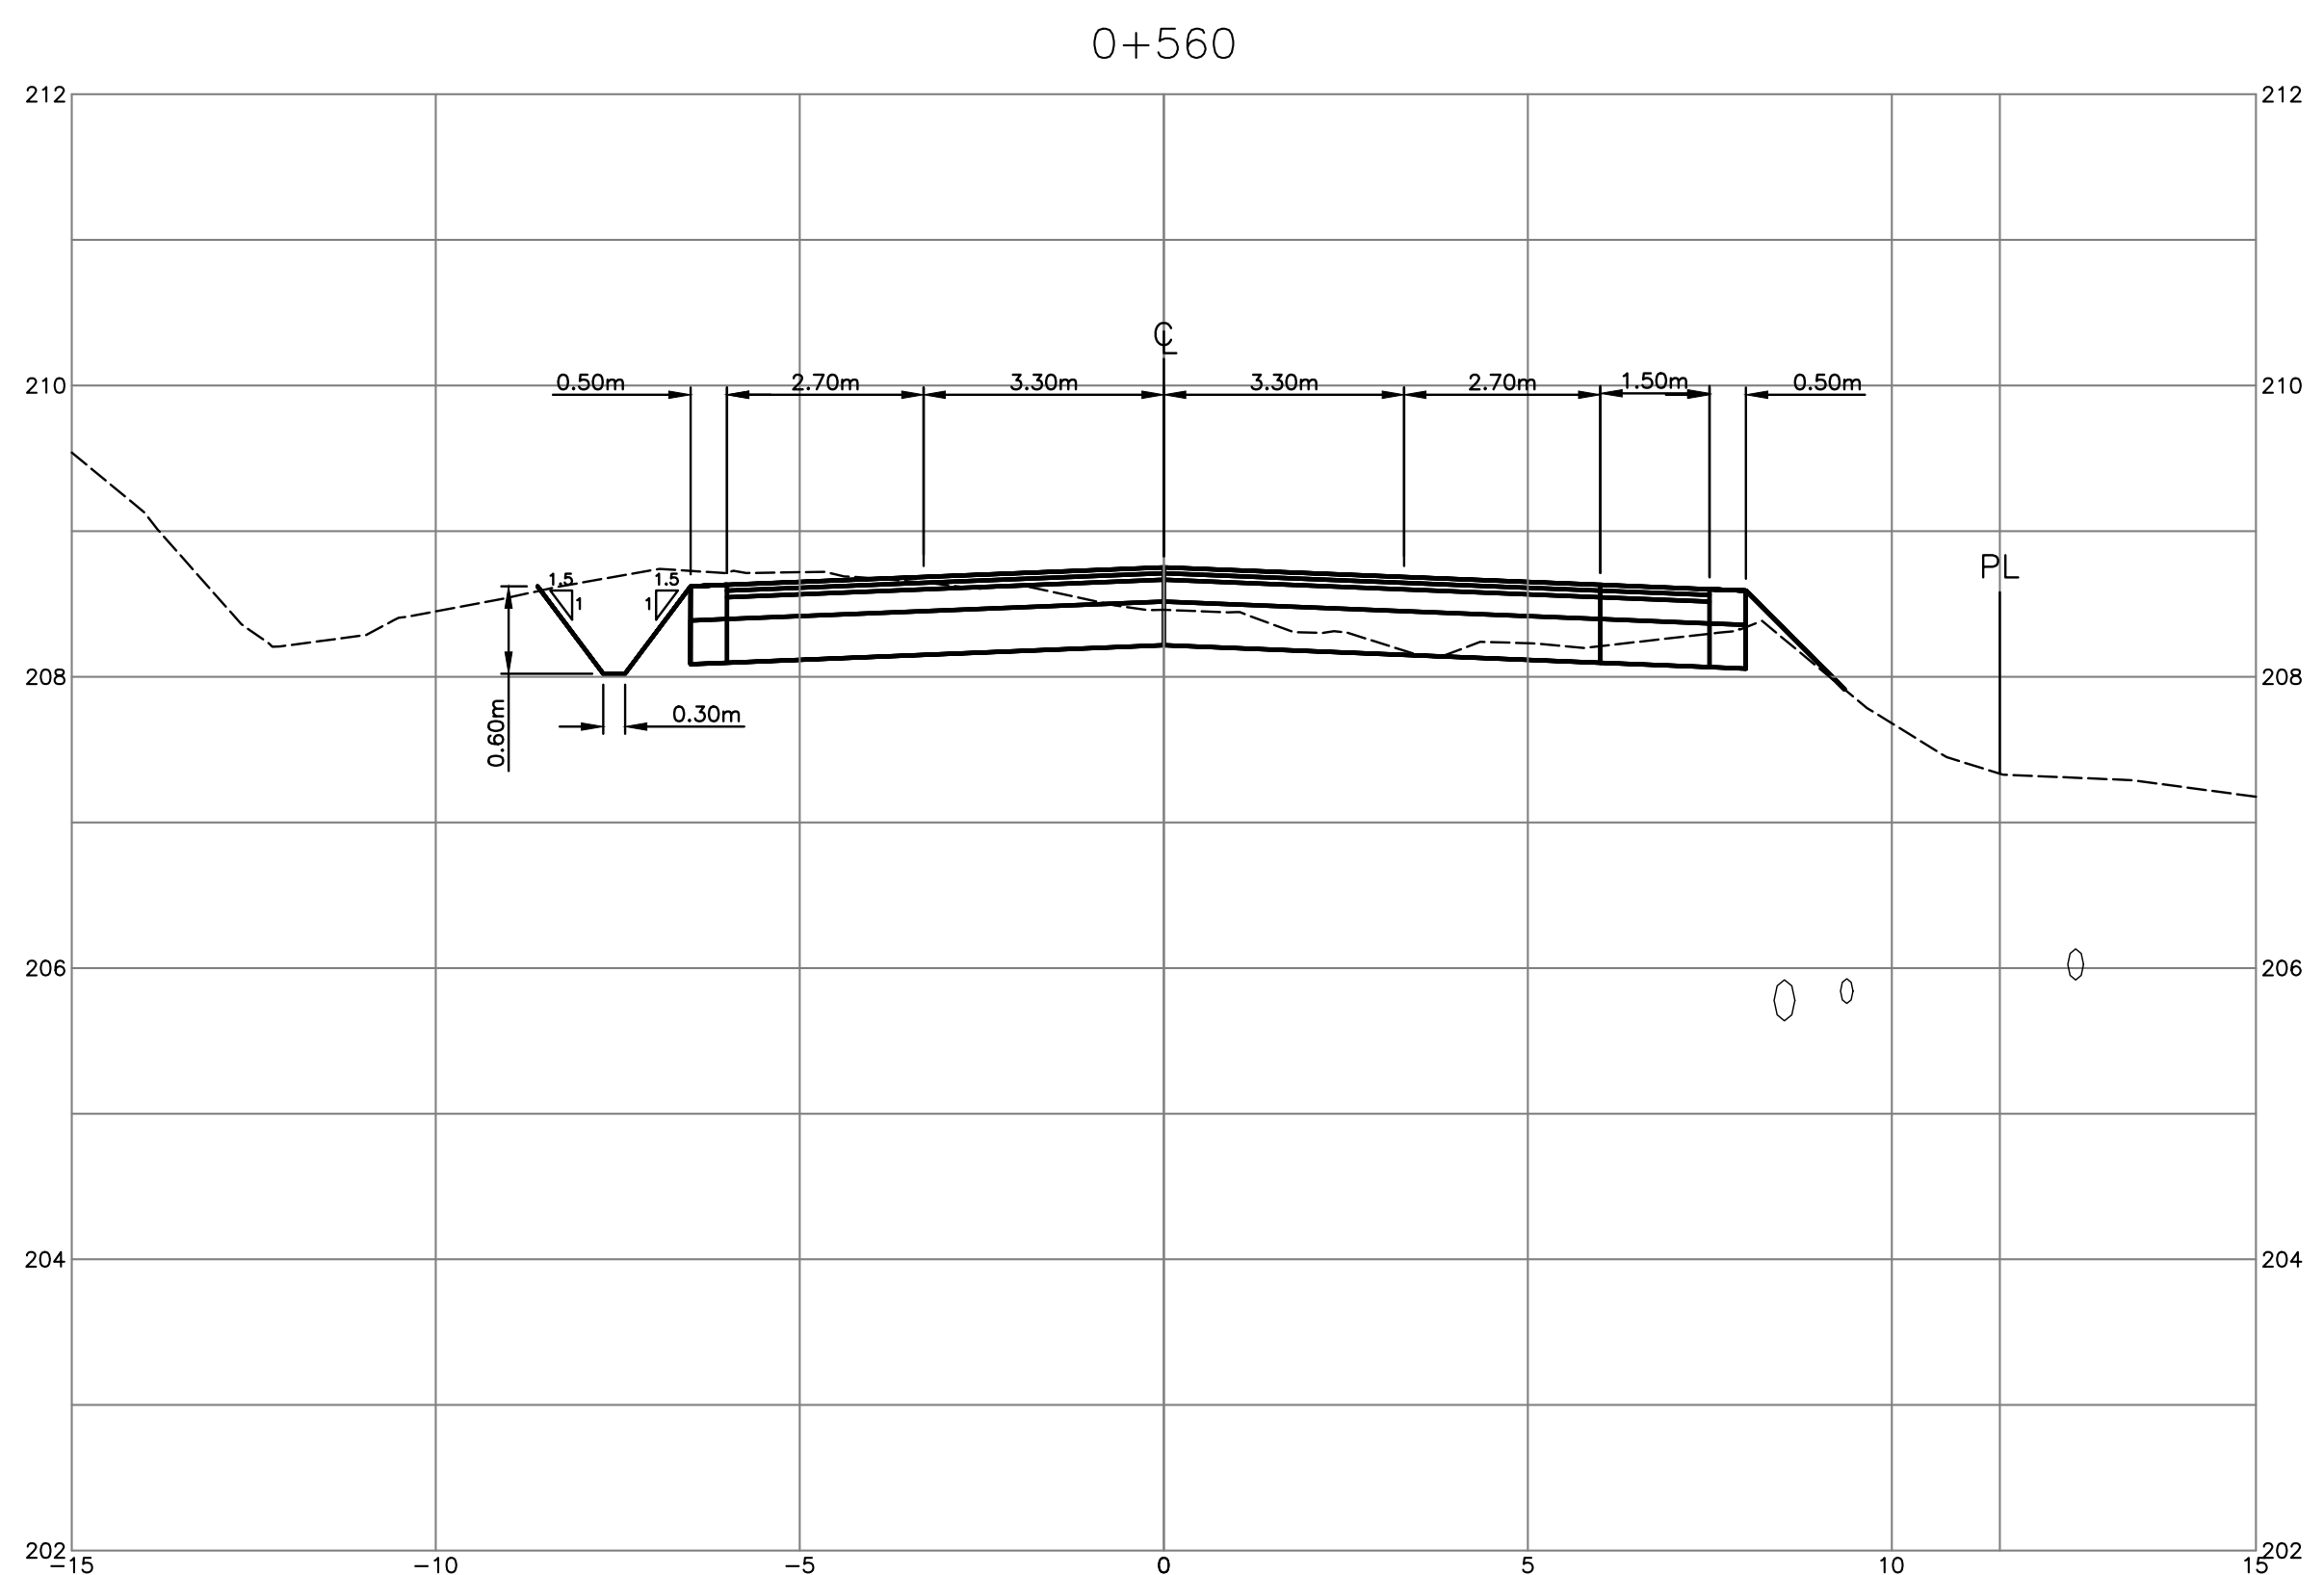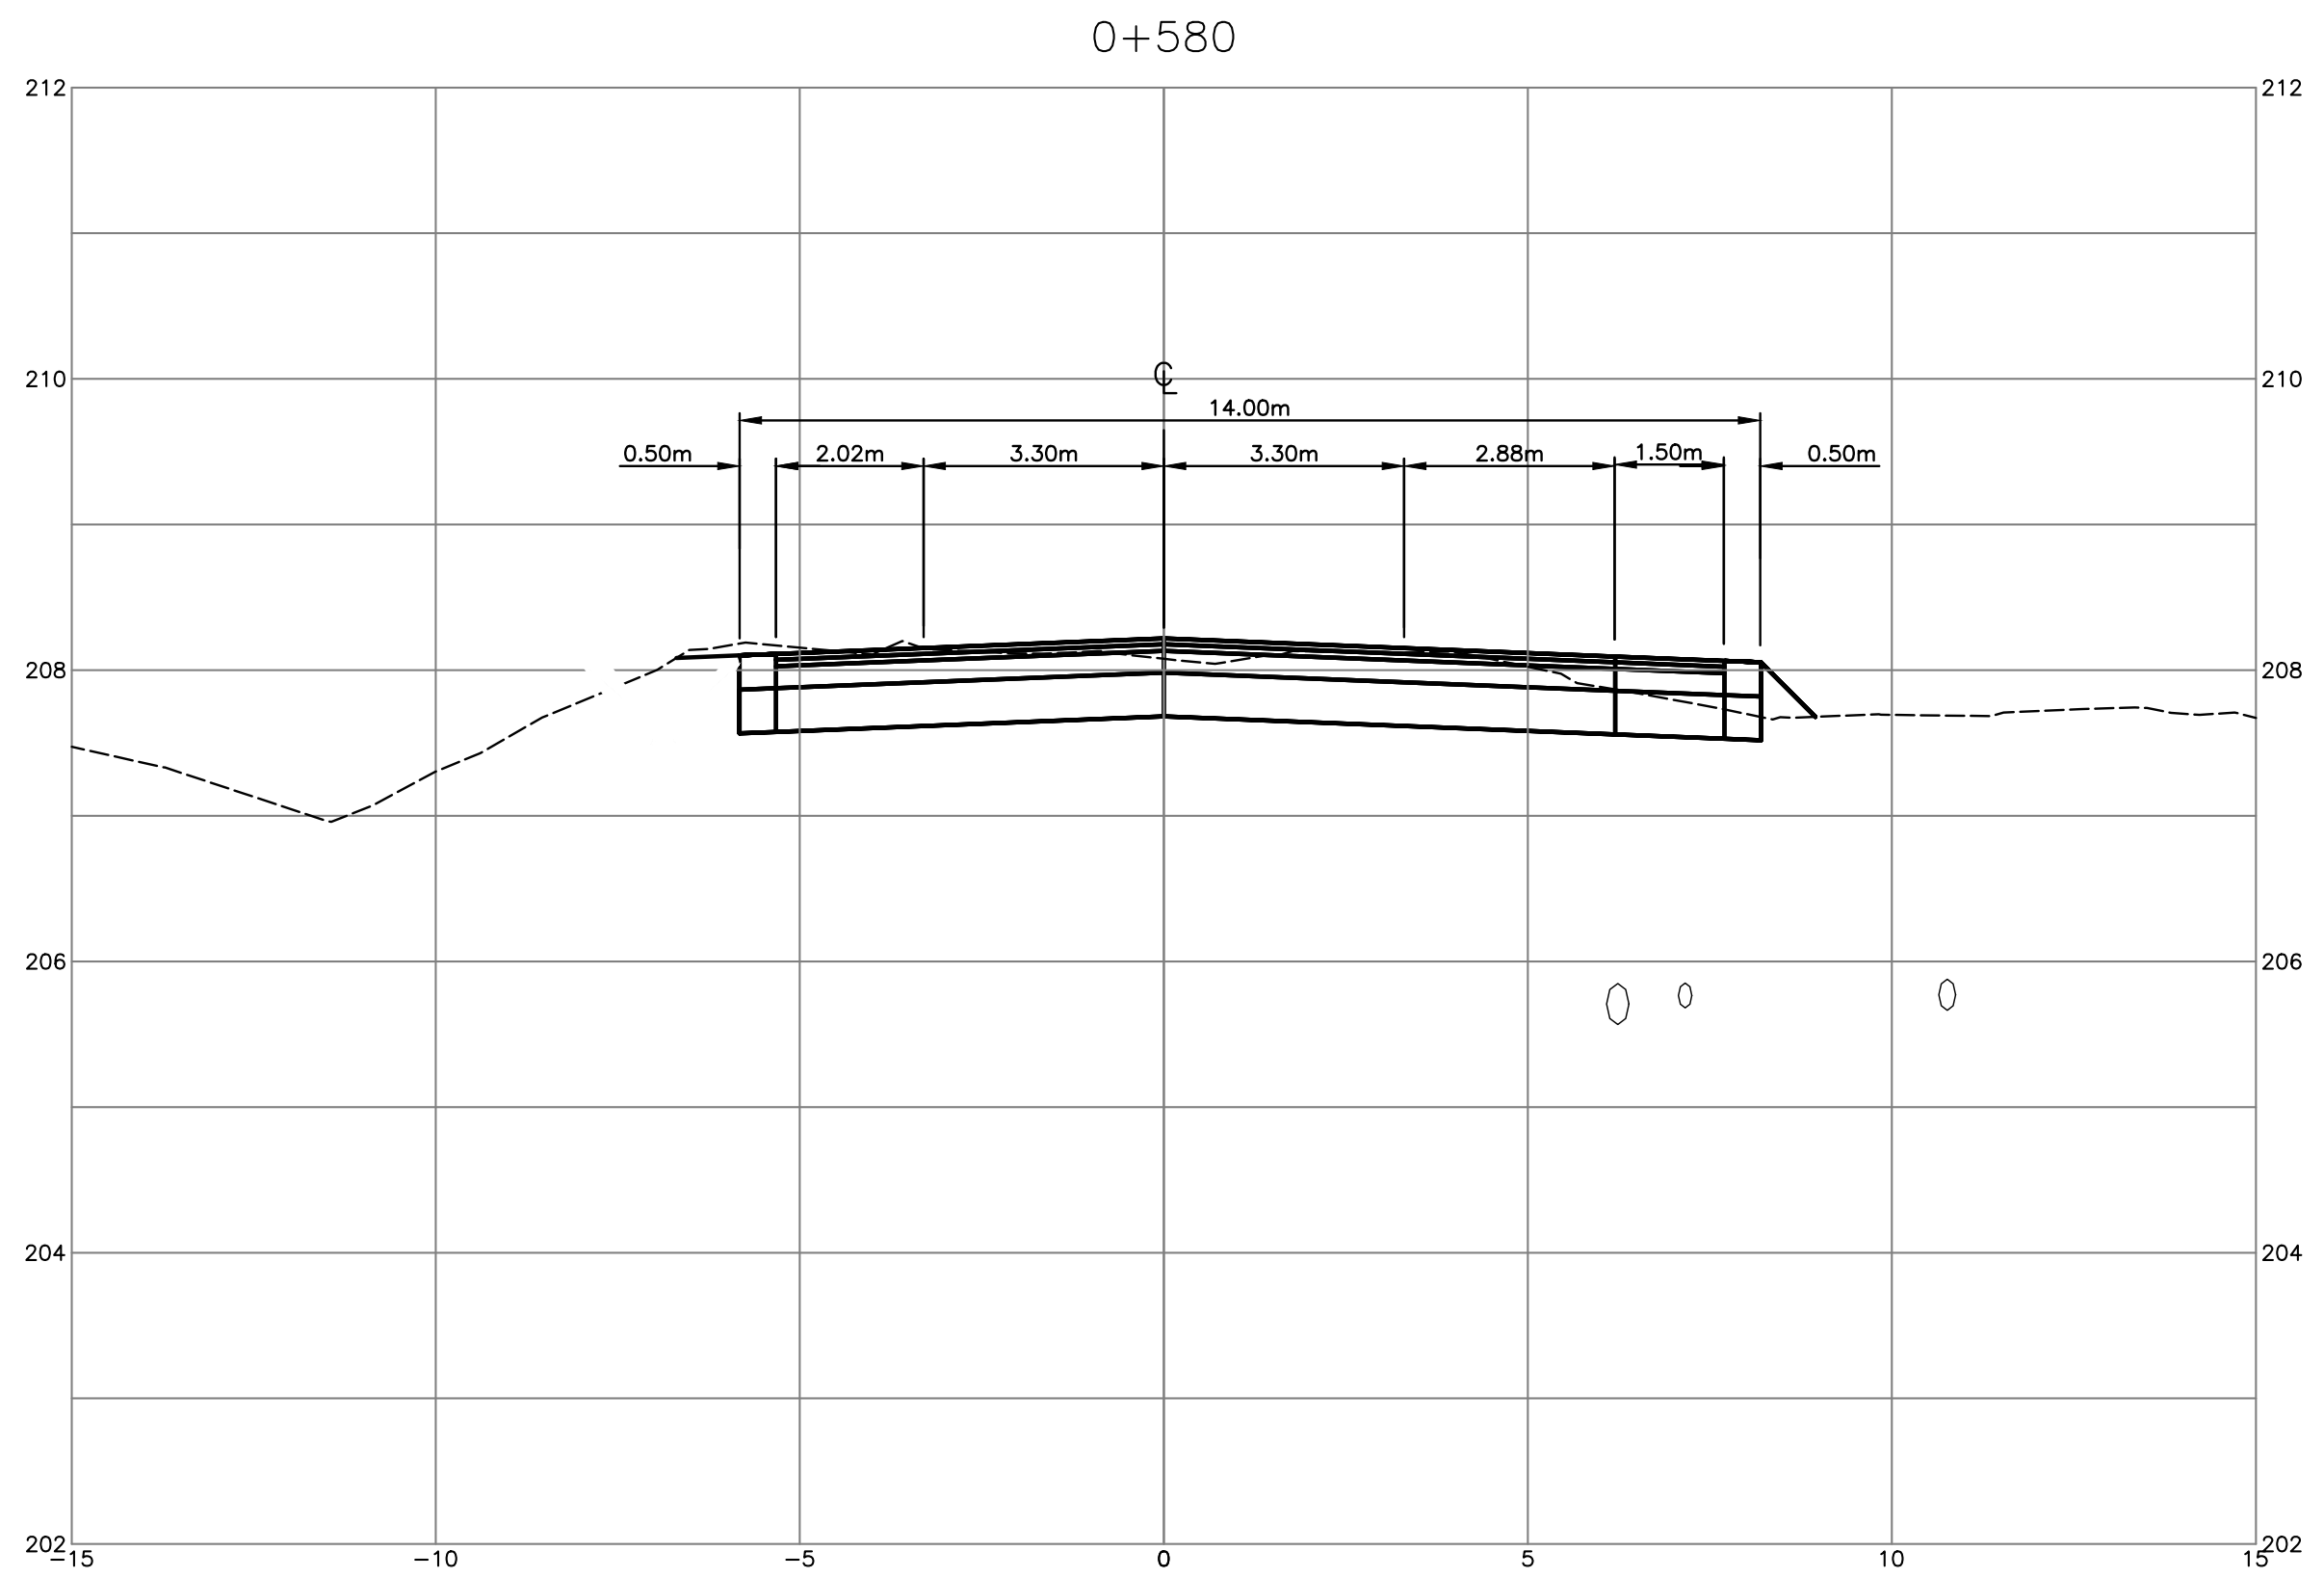

### DRAWING LEGEND

	EXISTING	PROP.	TO BE REMOVED
LEGAL LINE	---	---	---
EASMENT	---	---	---
WATERMAIN	---	---	---
SANITARY	---	---	---
STORM	---	---	---
HYDRO	---	---	---
TEL.	---	---	---
STREETLIGHT	---	---	---
GAS	---	---	---
FIRE HYDRANT	⊗	⊗	⊗
GATE VALVE	⊗	⊗	⊗
AIR VALVE	⊗	⊗	⊗
REDUCER	⊗	⊗	⊗
INSPECTION CHAMBER	⊗	⊗	⊗
CATCHBASIN (STD/SI)	⊗	⊗	⊗
CAP	⊗	⊗	⊗
MANHOLE	⊗	⊗	⊗
POWER POLE	⊗	⊗	⊗
STREETLIGHT	⊗	⊗	⊗

approved

client

580049 BC LTD.

project

THE RIDGE AT PEMBERTON  
 PHASE 1  
 PEMBERTON, BC

title

CROSS SECTIONS  
 OFFSITE ROAD (STA 0+560-0+580)

no.	(y/m/d)	revision	chk'd
11	18-02-06	PROJECT RECORDS OFFSITE	KBH
10	17-10-17	PROJECT RECORDS OFFSITE	KBH
9	17-09-19	UPDATED OFFSETS	KBH
8	17-08-15	UPDATE WITH HYDRO & TELLUS	KBH
7	17-03-07	REISSUED FOR CONSTRUCTION OFFSITE	KBH
6	16-11-09	REISSUED FOR CONSTRUCTION OFFSITE	KBH
5	16-10-26	IFC OFFSITE FINAL COMMENTS	KBH
4	16-10-13	ISSUED FOR CONSTRUCTION OFFSITE	KBH


COPYRIGHT RESERVED. THIS DRAWING AND DESIGN ARE, AND AT ALL TIMES REMAIN THE EXCLUSIVE PROPERTY OF CREUS ENGINEERING LTD. AND CANNOT BE USED, REPRODUCED OR DISTRIBUTED WITHOUT WRITTEN CONSENT.  
 © 2018 CREUS ENGINEERING LTD.

current rev. # 11

engineer of record	designer	drawn by	date	scales	hor.	vert.	file no.	drawing no.
K.B.H.	N.G.B.	A.A.P.	2016-05-13	hor. 1:100	vert. 1:50		16159	X-OS-11



MMCD STANDARD DETAIL DRAWINGS

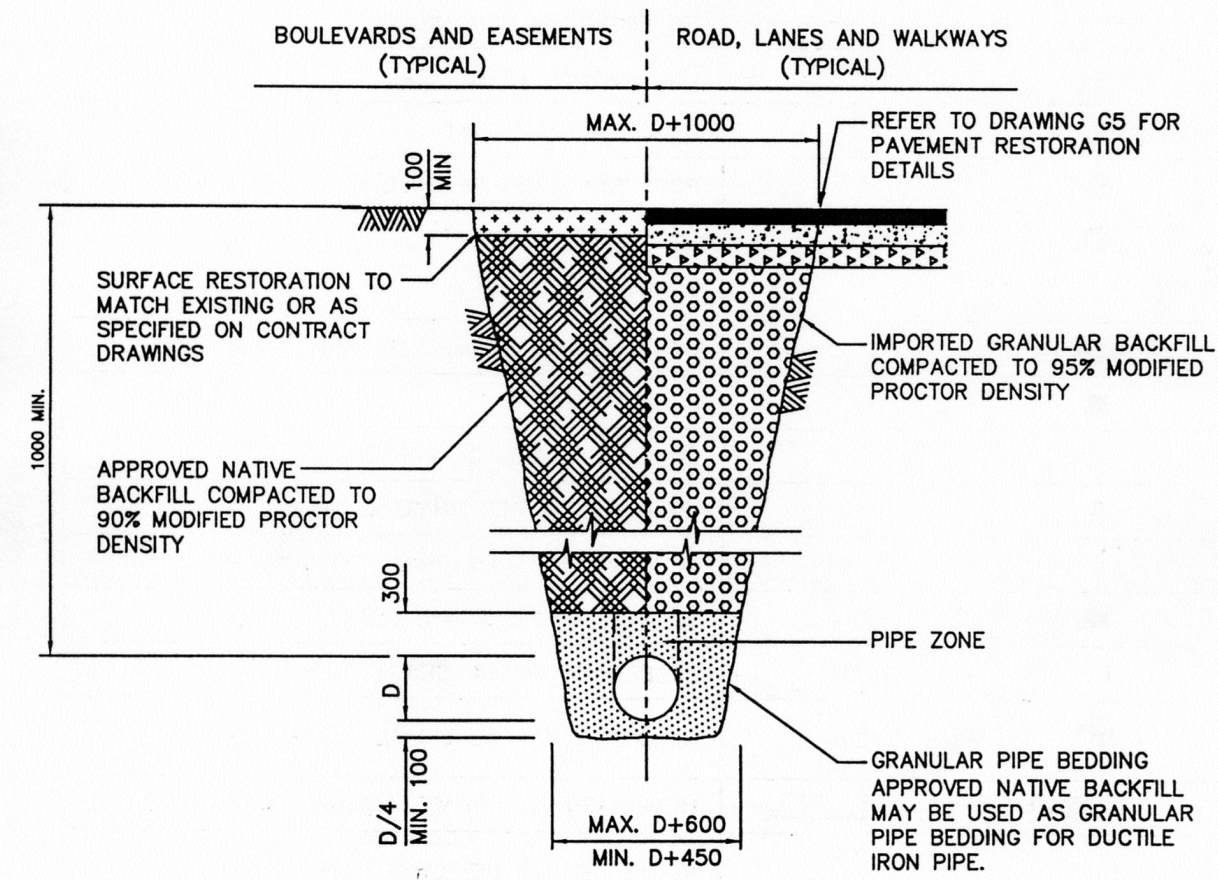


NOTE: 1. TRENCHING TO COMPLY WITH ALL REQUIREMENTS OF THE WORKERS' COMPENSATION BOARD.  
2. REFER TO CONTRACT DRAWINGS AND SECTION 02233 FOR DETAILED SPECIFICATIONS.

UTILITY TRENCH

DRAWING NUMBER:  
**G4**

MMCD STANDARD DETAIL DRAWINGS

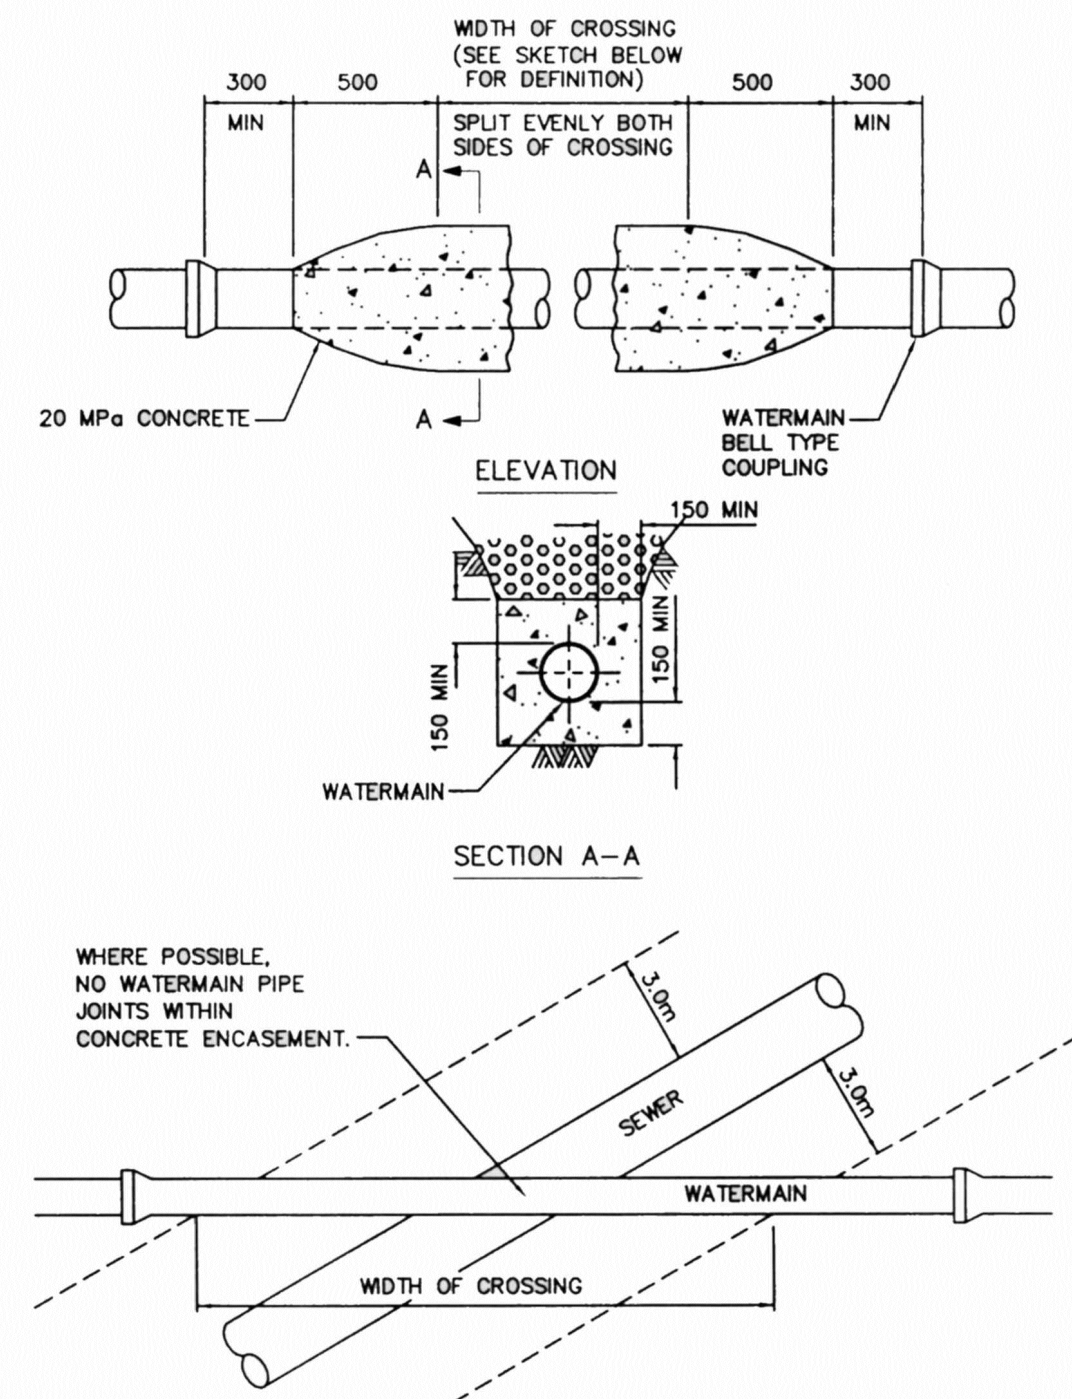


NOTE: 1. THIS STANDARD IS APPLICABLE TO WATERMAIN/SEWER SEPARATION ONLY. SEE DRAWING G7 FOR CONCRETE PROTECTION OF UNDERGROUND UTILITIES.  
2. REFER TO CONTRACT DRAWINGS AND SECTION 02233 FOR DETAILED SPECIFICATIONS.

CONCRETE ENCASUREMENT FOR WATERMAIN/SEWER SEPARATION

DRAWING NUMBER:  
**G6**

MMCD STANDARD DETAIL DRAWINGS

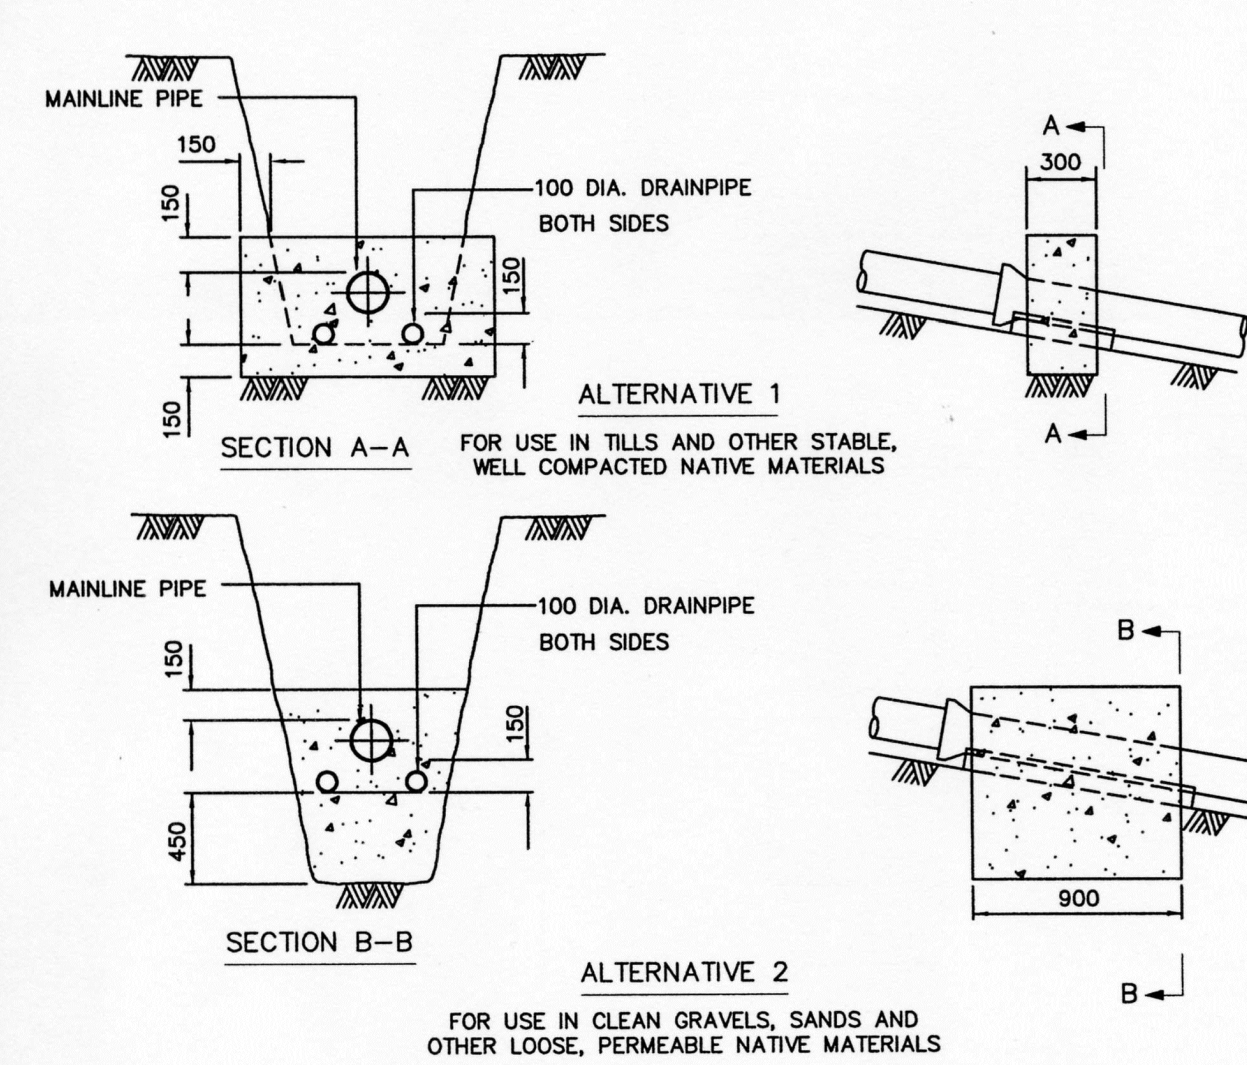

MAXIMUM SPACING OF ANCHOR BLOCKS (SEE NOTE 4)


SANITARY AND STORM GRAVITY SEWERS		WATERMANS AND FORCEMANS	
SLOPE	MAX. SPACING	SLOPE	MAX. SPACING
15% - 20%	25m	10% OR GREATER	10m
20% - 35%	20m		
35% - 50%	15m		
50% - OVER	10m		

NOTE: 1. APPLICABLE TO ALL PIPE MATERIALS.  
2. USE ALTERNATIVES 1 OR 2 AS SPECIFIED ON CONTRACT DRAWINGS.  
3. USE 20 MPa CONCRETE UNLESS SPECIFIED OTHERWISE ON CONTRACT DRAWINGS.  
4. REFER TO CONTRACT DRAWINGS FOR SPECIFIED SPACING IF OTHER THAN MAXIMUM SHOWN IN TABLE.

PIPE ANCHOR BLOCKS

DRAWING NUMBER:  
**G8**

MMCD STANDARD DETAIL DRAWINGS

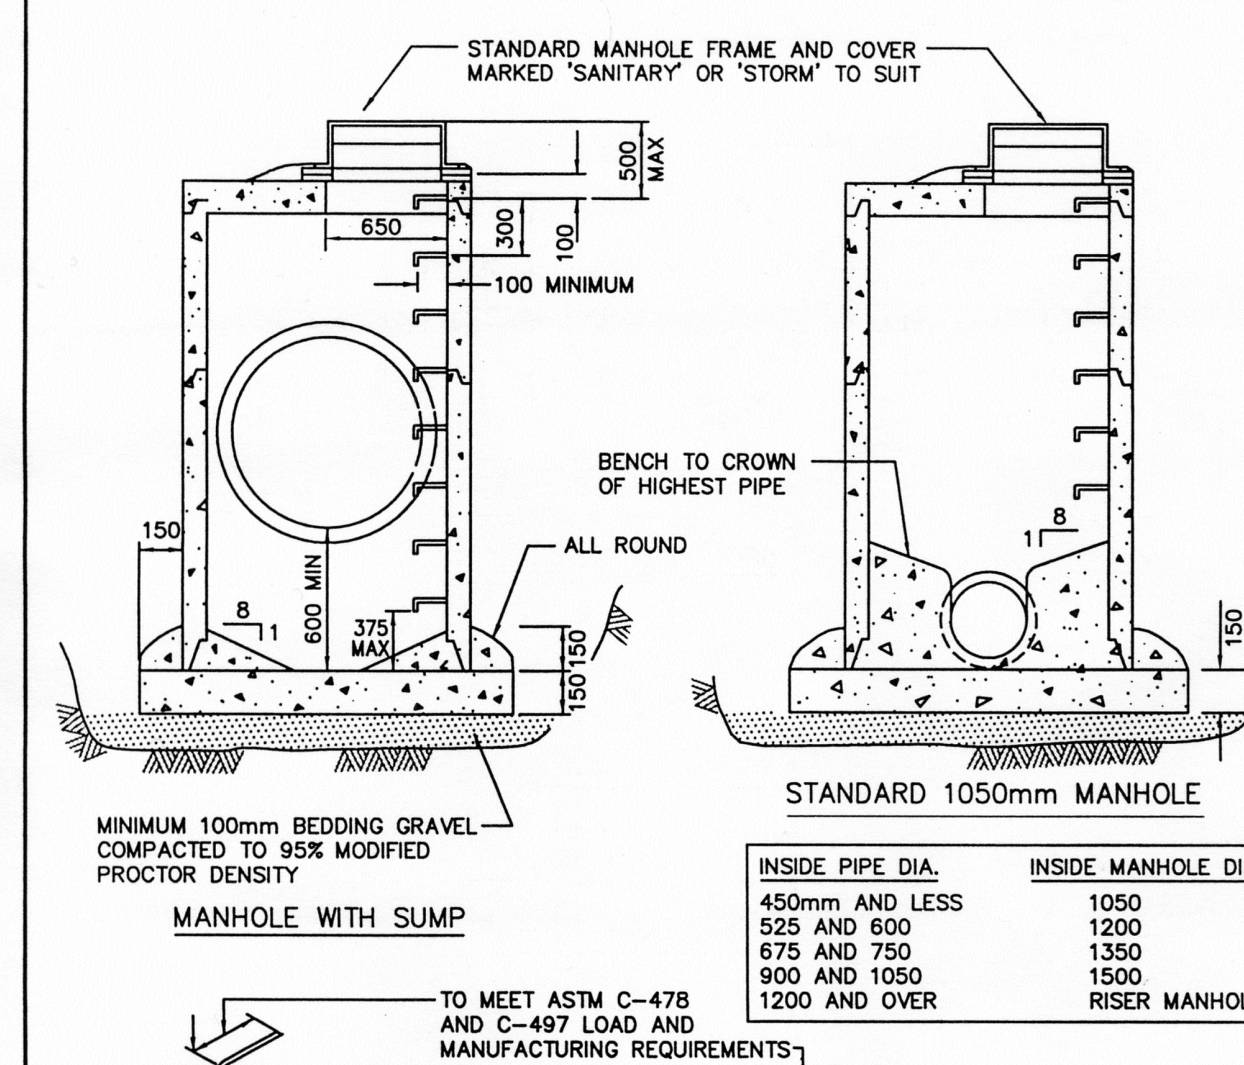


INSIDE PIPE DIA.	INSIDE MANHOLE DIA.
450mm AND LESS	1050
525 AND 600	1200
675 AND 750	1350
900 AND 1050	1500
1200 AND OVER	RISER MANHOLE

NOTE: 1. DETAILS ARE DRAWN FOR PRECAST RISERS ON CAST-IN-PLACE BASE. PRECAST BASES APPROVED BY CONTRACT ADMINISTRATOR ARE ACCEPTABLE.  
2. MAXIMUM DEPTH TO FIRST RUNG IS 500mm. WHEN HANDHOLD IS INSTALLED BETWEEN TOP AND FIRST RUNG, MAXIMUM DEPTH MAY BE INCREASED TO 660mm.  
3. FOR MANHOLES OVER 1200mm DIA. BASE THICKNESS TO BE 200mm.  
4. REFER TO DRAWING S2 FOR CONNECTION DETAILS.  
5. REFER TO CONTRACT DRAWINGS AND SECTION 02725 FOR DETAILED SPECIFICATIONS.

STANDARD AND SUMP MANHOLES

DRAWING NUMBER:  
**S1**

MMCD STANDARD DETAIL DRAWINGS

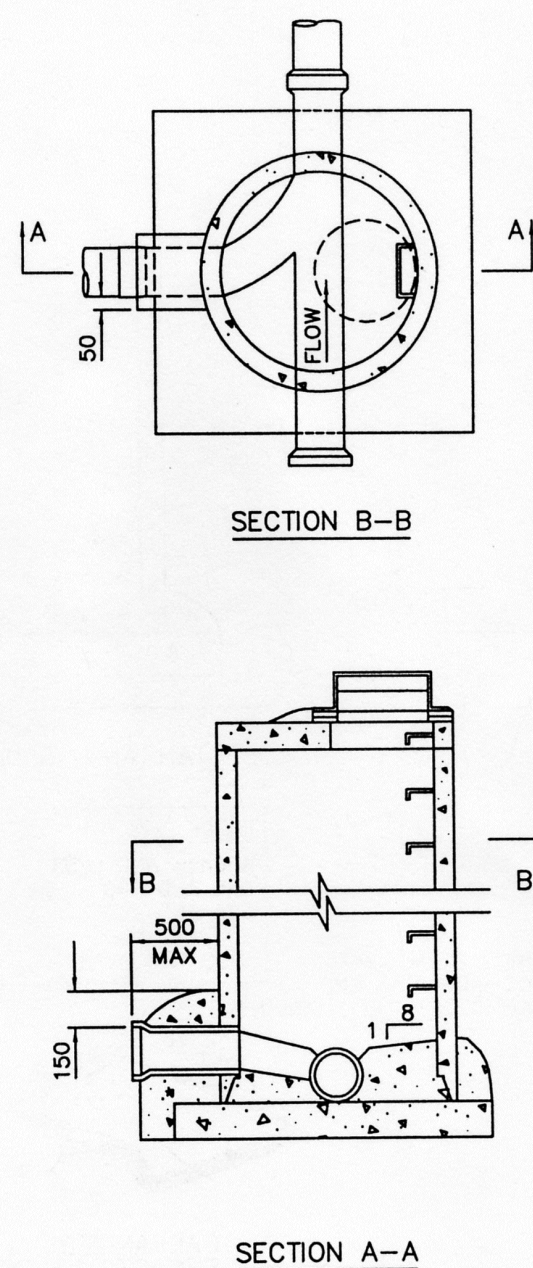


NOTE: 1. THIS DRAWING SHOWS CONNECTION DETAILS ONLY, REFER TO DRAWING S1 FOR ALL OTHER DETAILS PERTAINING TO MANHOLE REQUIREMENTS AND INSTALLATION.  
2. REFER TO CONTRACT DRAWINGS AND SECTION 02725 FOR DETAILED SPECIFICATIONS.

STANDARD MANHOLE CONNECTION DETAILS

DRAWING NUMBER:  
**S2**

MMCD STANDARD DETAIL DRAWINGS

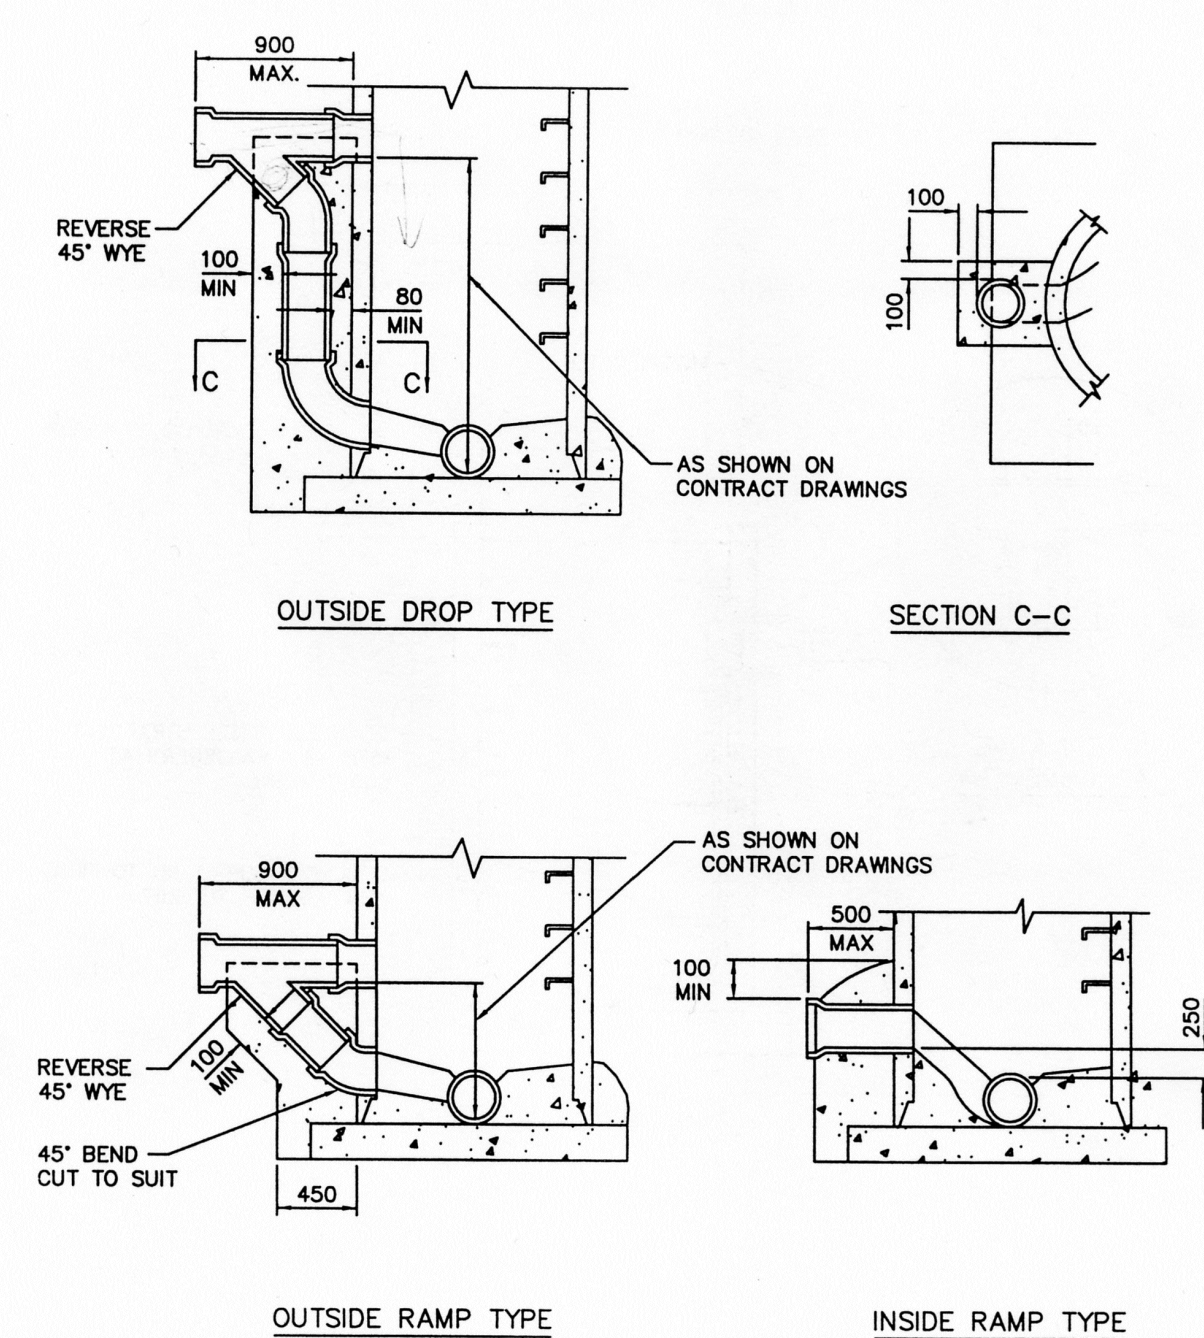


NOTE: 1. THIS DRAWING SHOWS CONNECTION DETAILS ONLY, REFER TO DRAWING S1 FOR ALL OTHER DETAILS PERTAINING TO MANHOLE REQUIREMENTS AND INSTALLATION.  
2. REFER TO CONTRACT DRAWINGS AND SECTION 02725 FOR DETAILED SPECIFICATIONS.

MANHOLE CONNECTION DETAILS - DROP AND RAMP TYPE

DRAWING NUMBER:  
**S3**

MMCD STANDARD DETAIL DRAWINGS

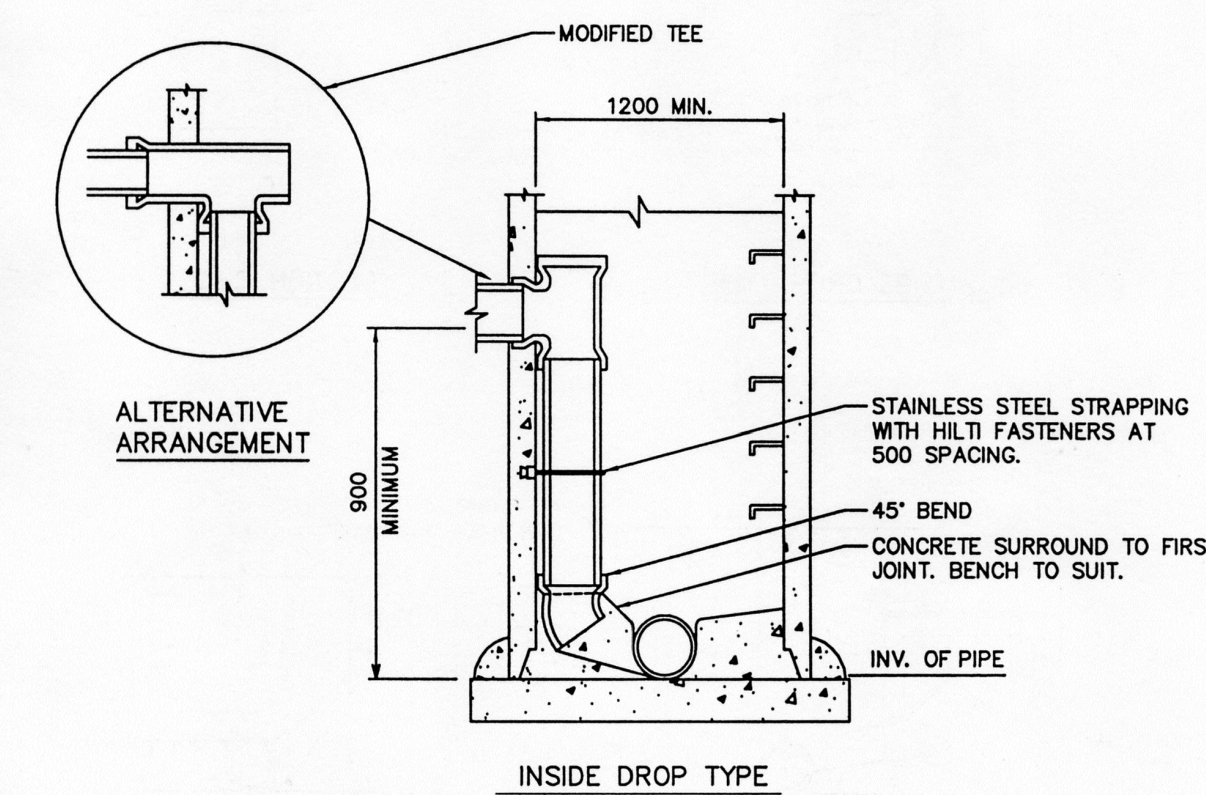


NOTE: 1. INSIDE DROP TO BE USED ONLY WHERE SPECIFIED BY CONTRACT ADMINISTRATOR.  
2. ALL INSIDE PIPE AND FITTINGS PVC DR 28/35  
3. THIS DRAWING SHOWS INSIDE DROP ONLY. SEE DRAWING S1 FOR ALL OTHER DETAILS PERTAINING TO MANHOLE REQUIREMENTS.  
4. REFER TO CONTRACT DRAWINGS AND SECTION 02725 FOR DETAILED SPECIFICATIONS

INSIDE DROP MANHOLE

DRAWING NUMBER:  
**S4**

MMCD STANDARD DETAIL DRAWINGS

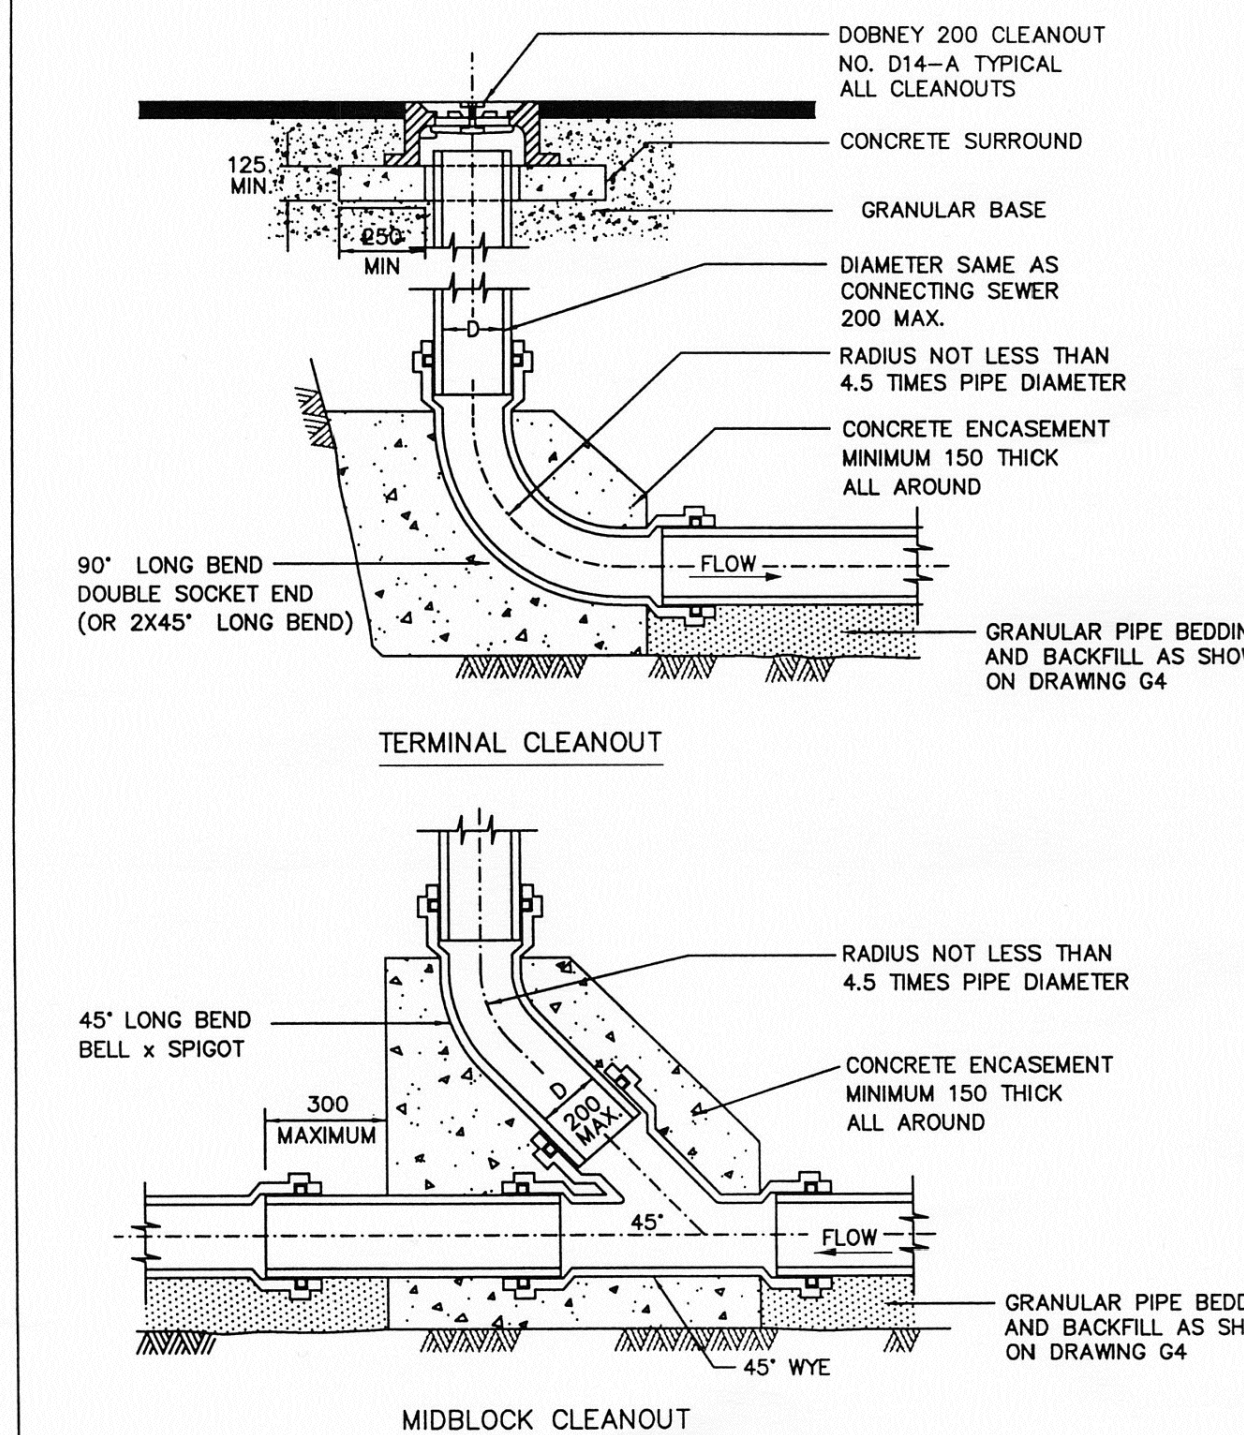

NOTE: 1. ALL PIPE FITTINGS PVC DR28 c/w GASKETS

SEWER CLEANOUT

DRAWING NUMBER:  
**S6**

SITE MAP

DRAWING LEGEND

	EXISTING	PROP.	TO BE REMOVED
LEGAL LINE EASMENT	---	---	---
WATERMAIN	---	---	---
SANITARY	---	---	---
STORM	---	---	---
HYDRO	---	---	---
TEL	---	---	---
STREETLIGHT	---	---	---
GAS	---	---	---
FIRE HYDRANT	---	---	---
GATE VALVE	---	---	---
AIR VALVE	---	---	---
REDUCER	---	---	---
INSPECTION CHAMBER	---	---	---
CATCHBASIN (STD/SI)	---	---	---
CAP	---	---	---
MANHOLE	---	---	---
POWER POLE	---	---	---
STREETLIGHT	---	---	---

approved

client

580049 BC LTD.

project

THE RIDGE AT PEMBERTON  
PHASE 1  
PEMBERTON, BC

title









DETAILS

no.	(y/m/d)	revision	chk'd
17	18-02-06	PROJECT RECORDS OFFSITE	KBH
16	18-02-06	PROJECT RECORDS ONSITE	KBH
15	17-10-17	PROJECT RECORDS OFFSITE	KBH
14	17-03-07	REISSUED FOR CONSTRUCTION OFFSITE	KBH
13	17-02-27	ISSUED FOR CONSTRUCTION ONSITE	KBH
12	16-11-09	REISSUED FOR CONSTRUCTION ONSITE	KBH
11	16-11-09	REISSUED FOR CONSTRUCTION OFFSITE	KBH
10	16-10-26	IFC OFFSITE FINAL COMMENTS	KBH

copyright reserved. THIS DRAWING AND DESIGN ARE AND AT ALL TIMES REMAIN THE EXCLUSIVE PROPERTY OF CREUS ENGINEERING LTD. AND CANNOT BE USED, REPRODUCED OR DISTRIBUTED WITHOUT WRITTEN CONSENT. ©2018 CREUS ENGINEERING LTD.

engineer of record	scale	hor.	vert.
K.B.H.			
designed by	file no.	16159	
N.G.B.			
drawn by	drawing no.	DET-1	
A.A.P.			
date	2016-05-13		



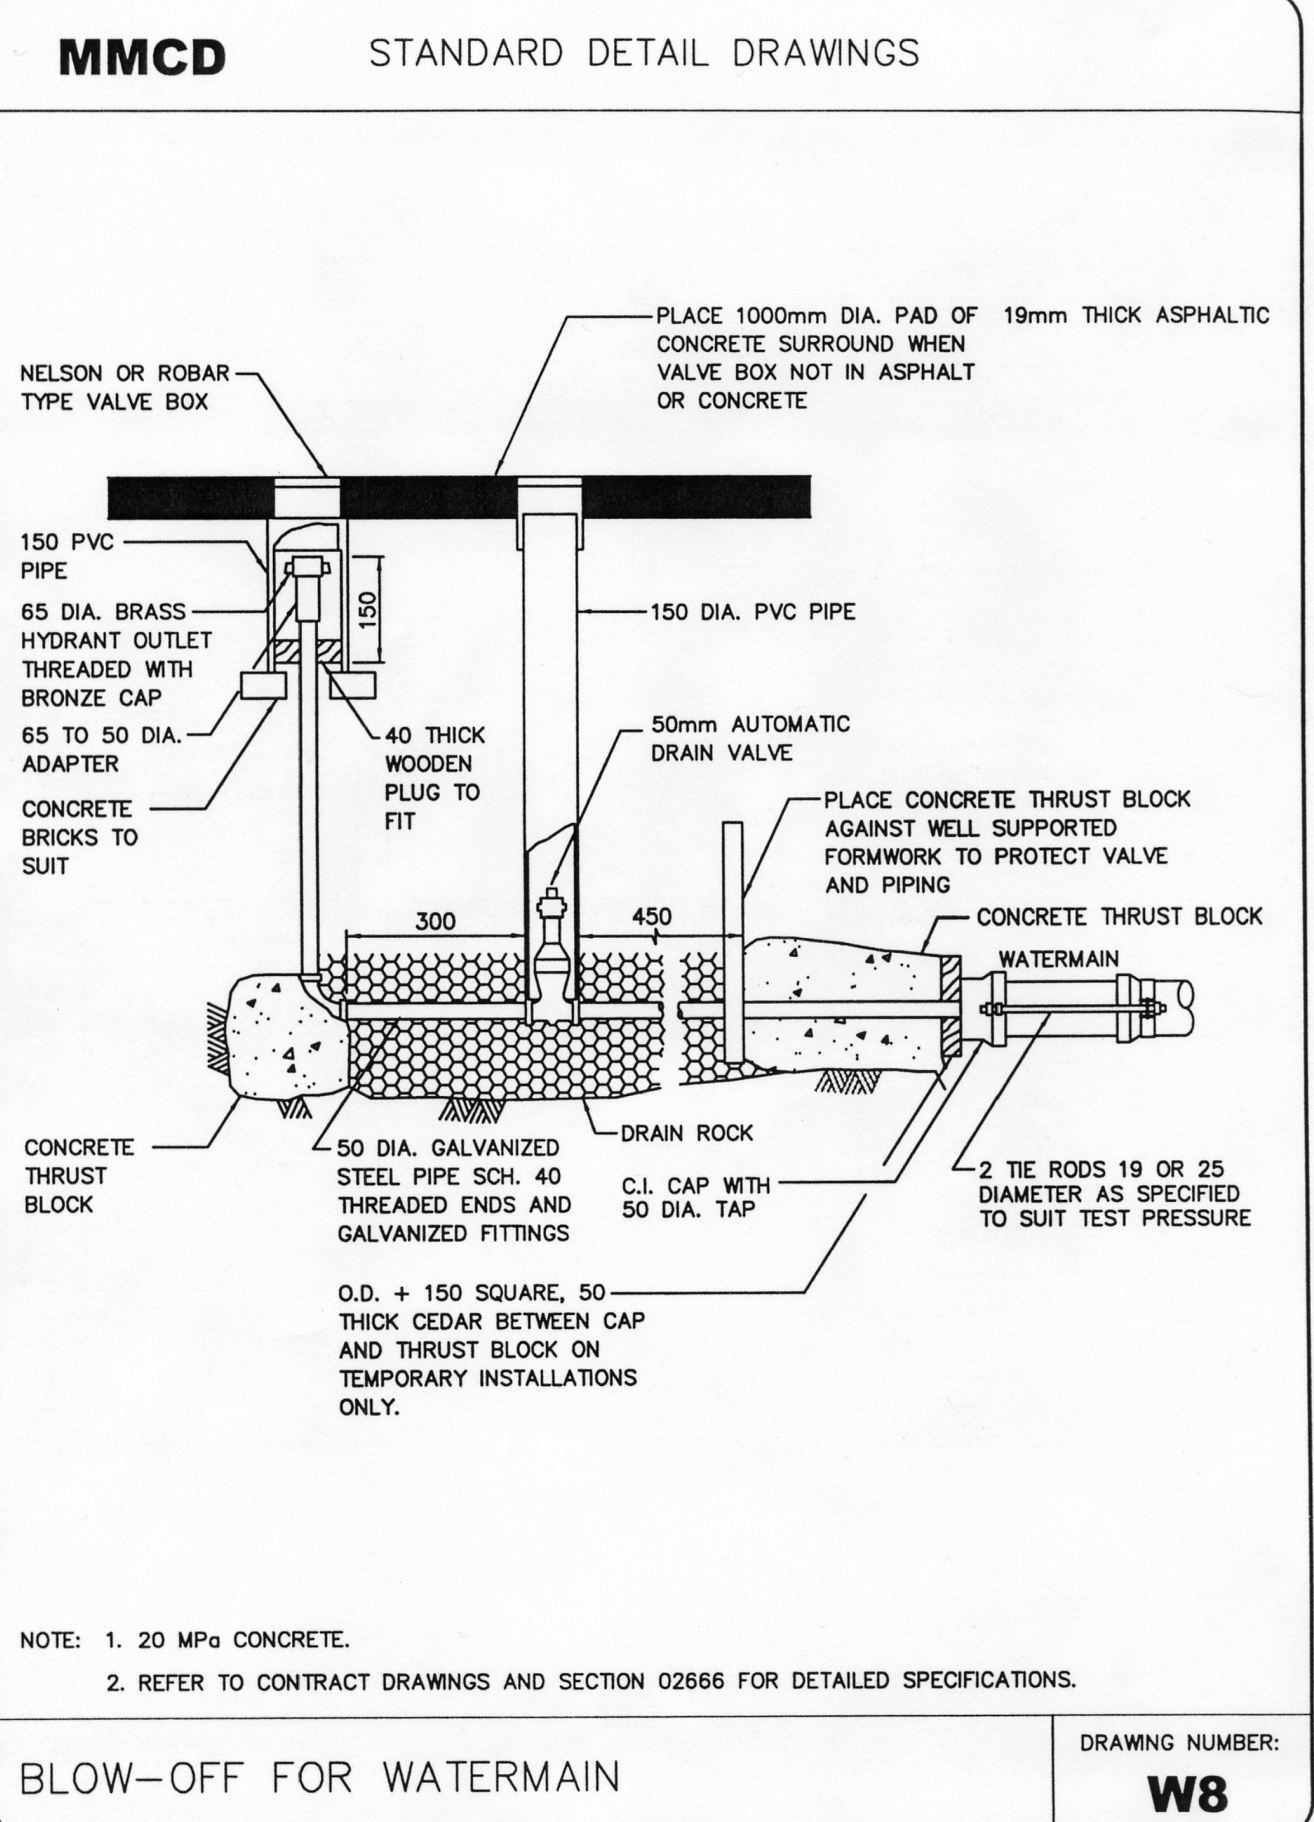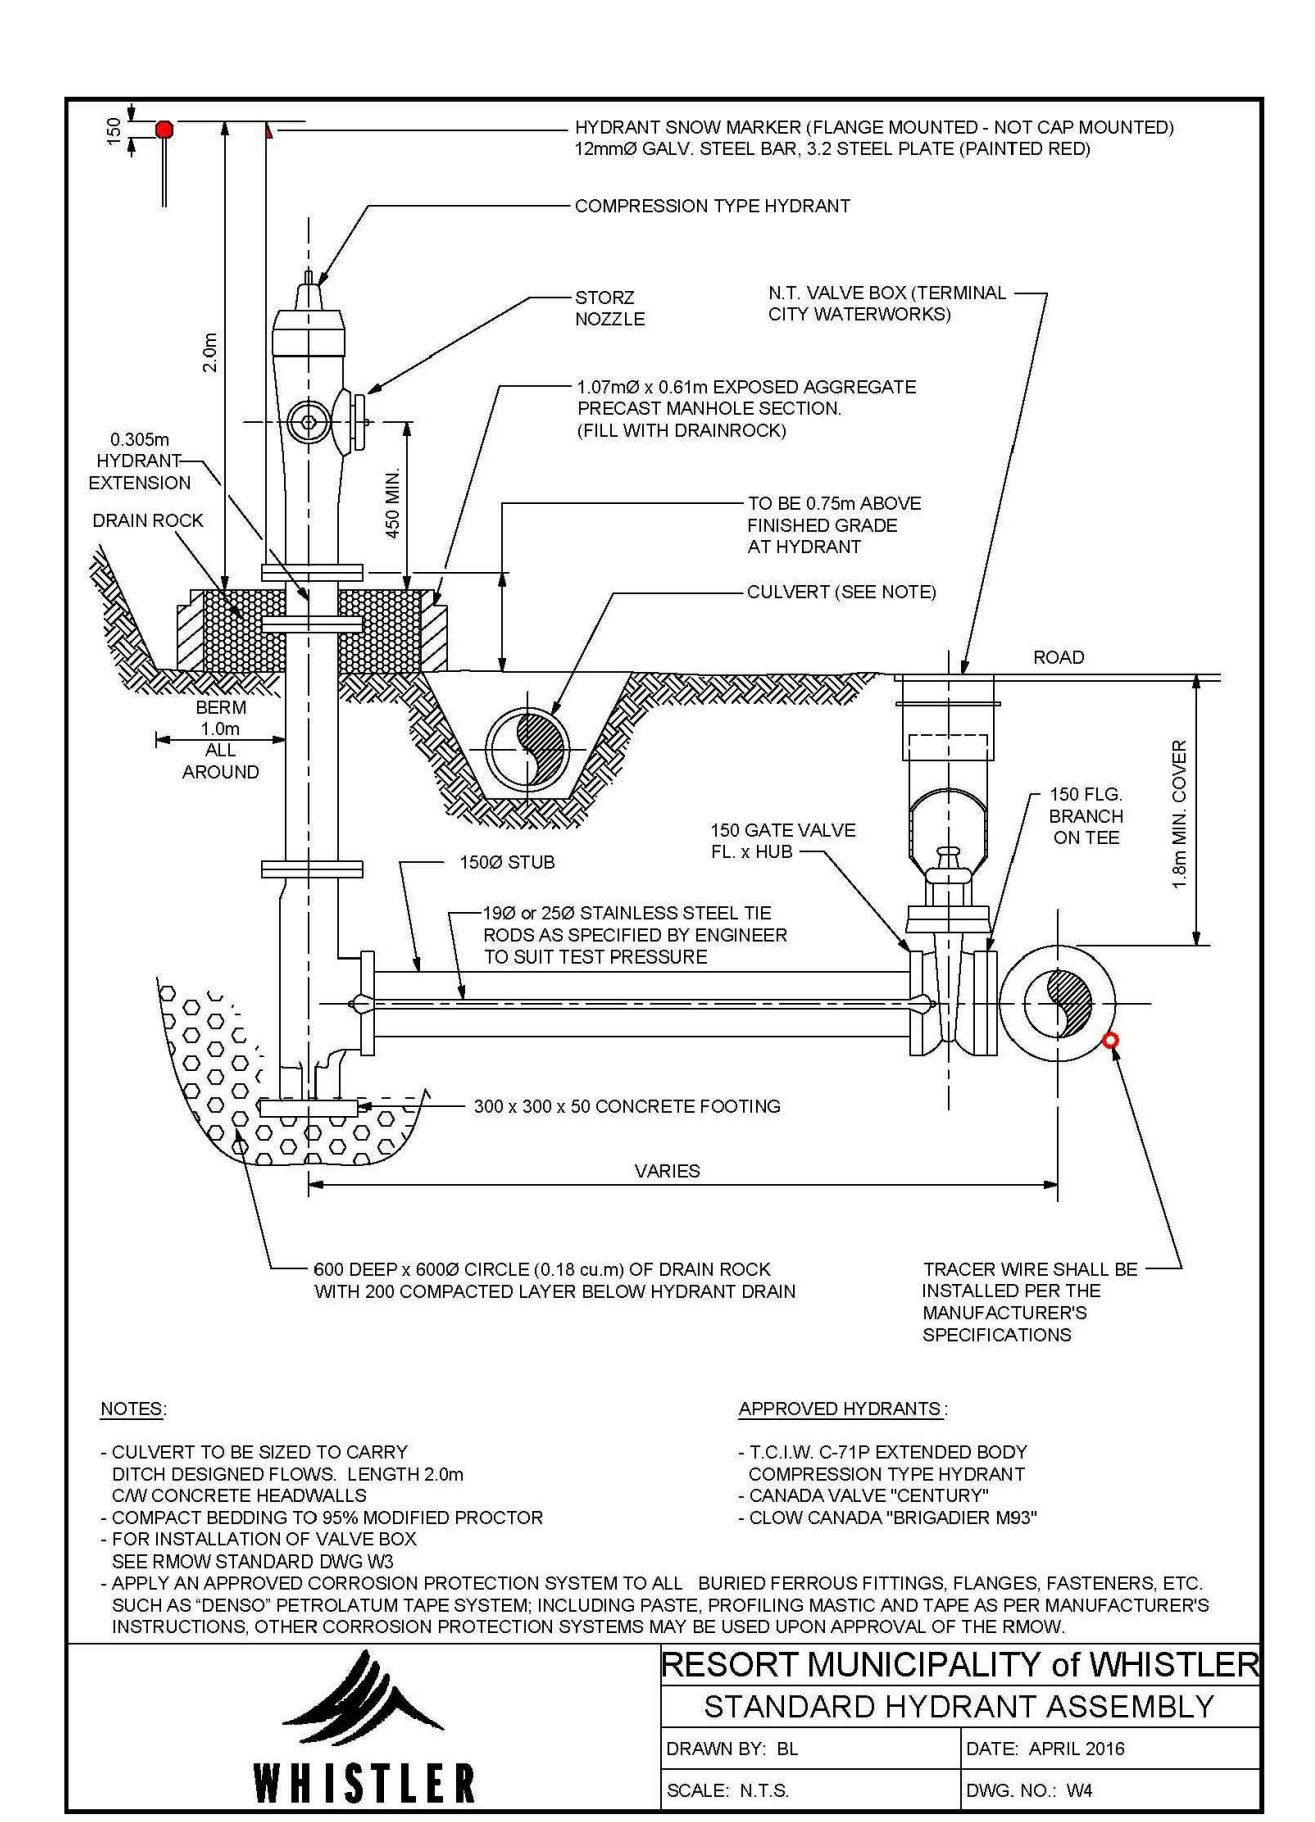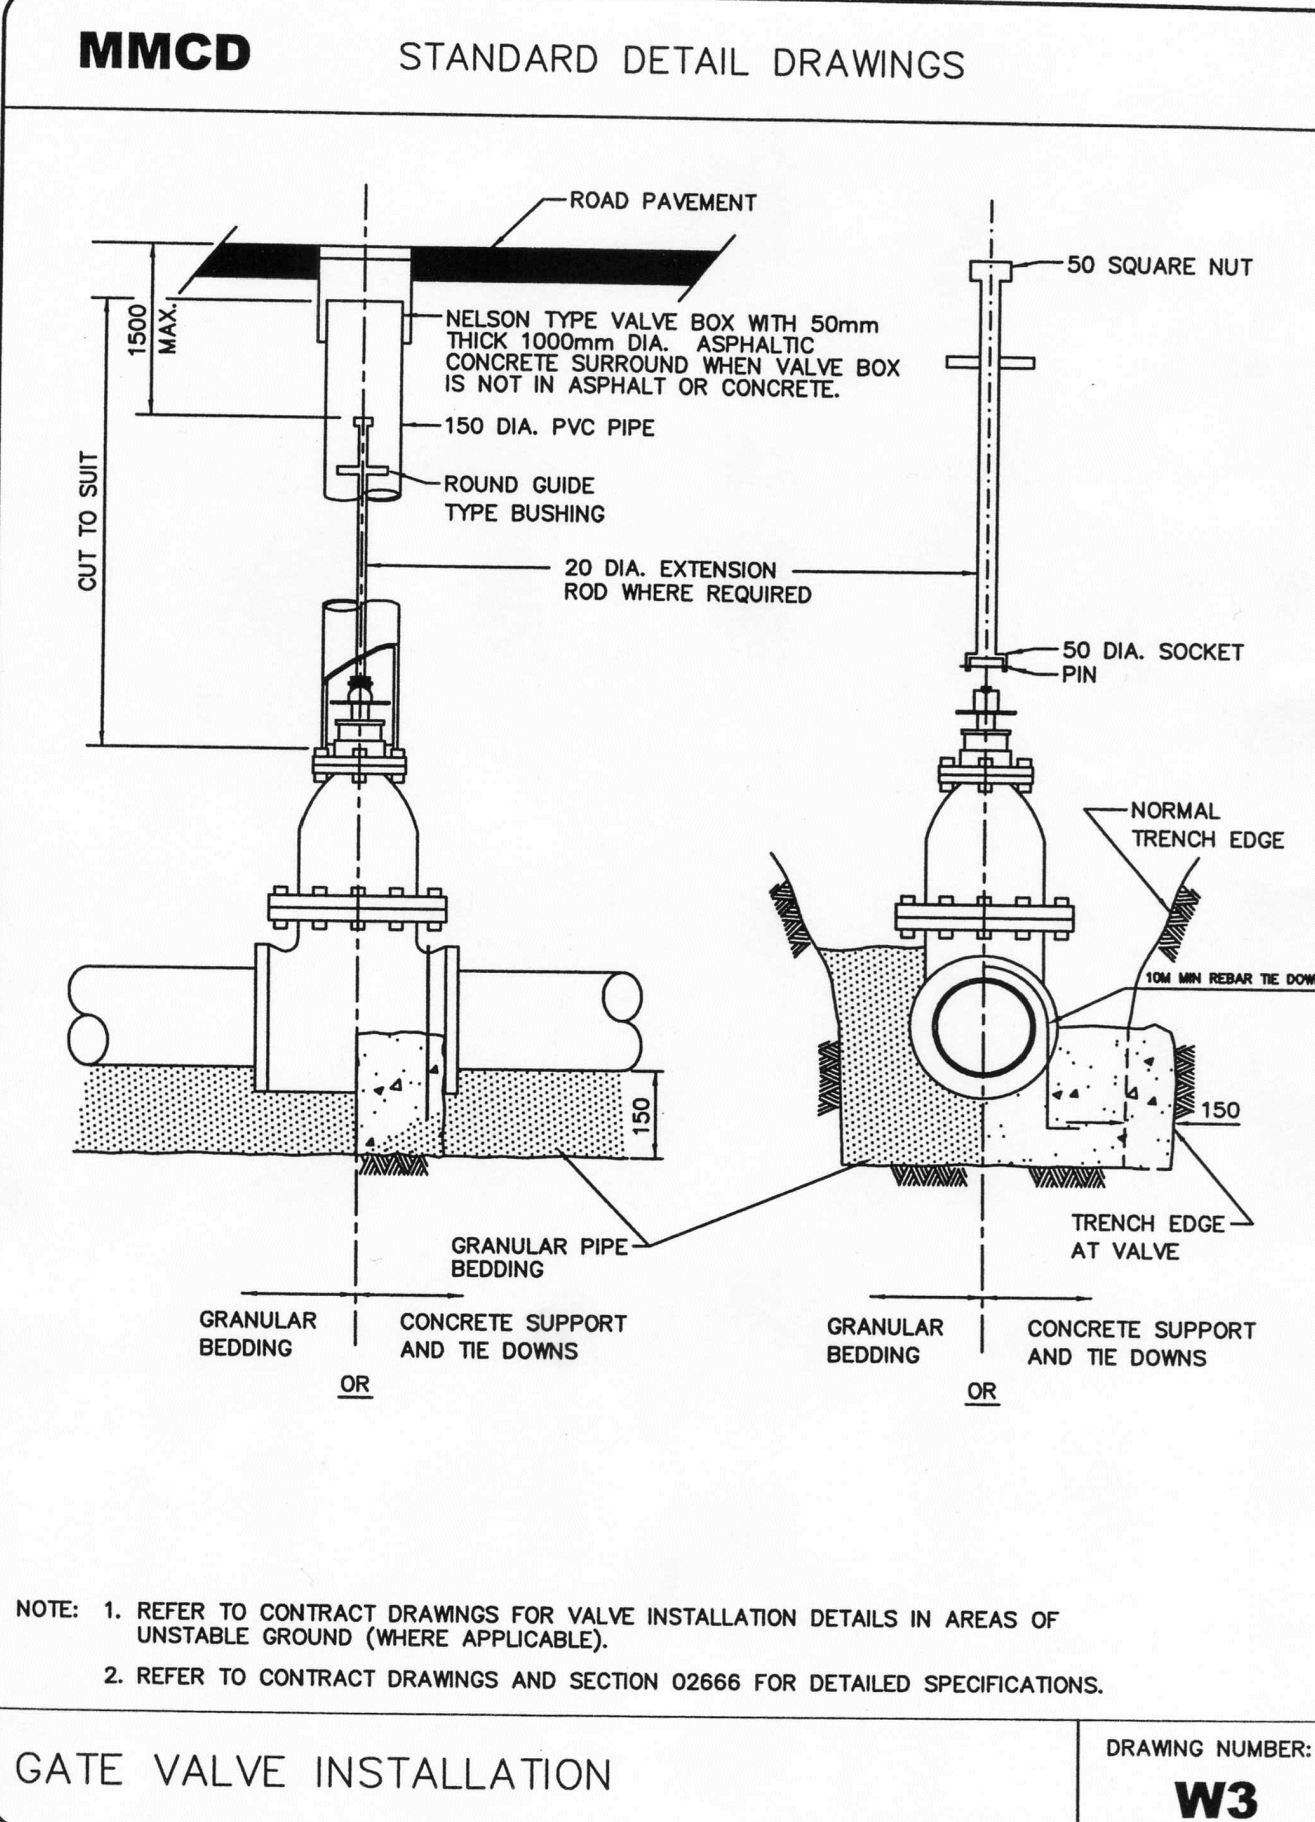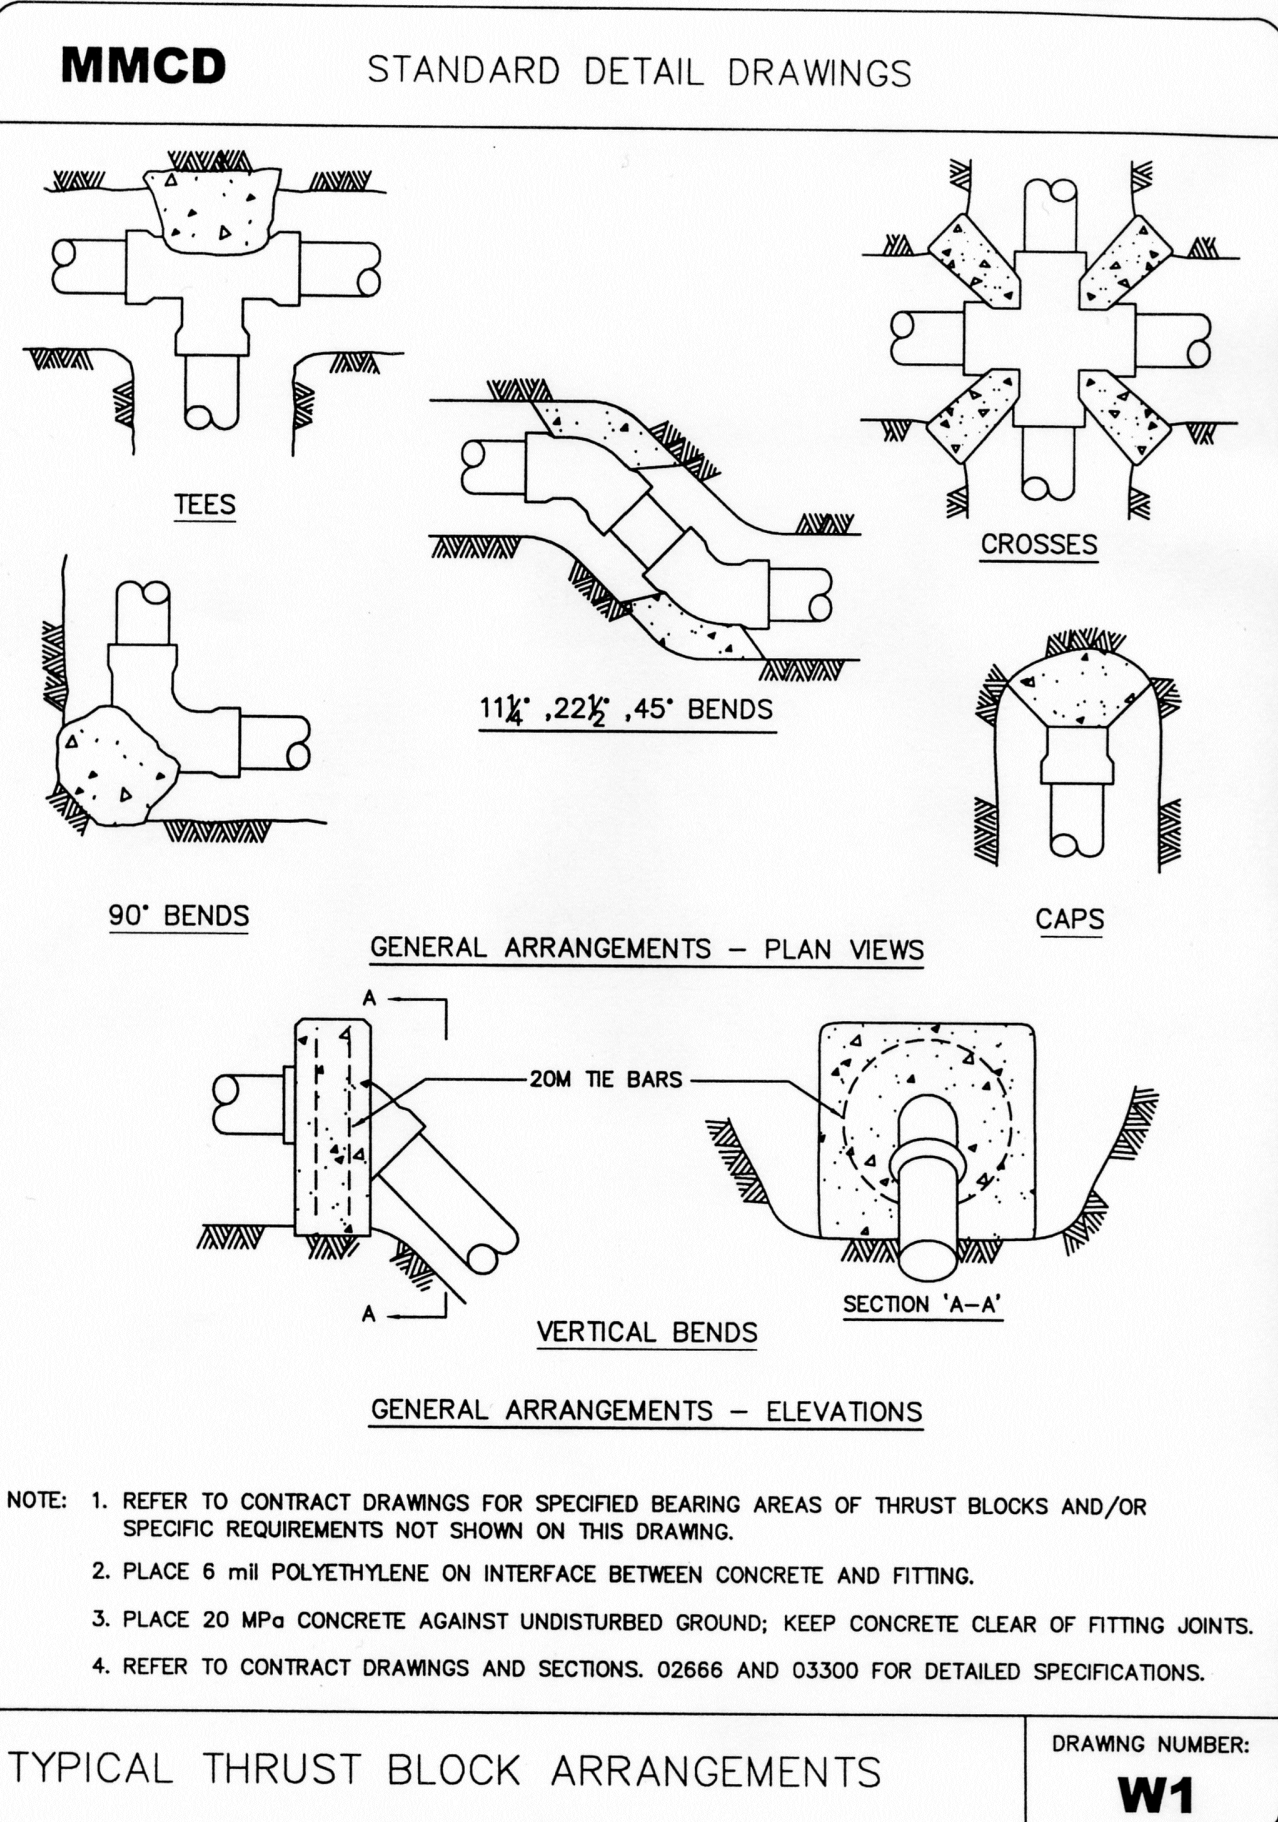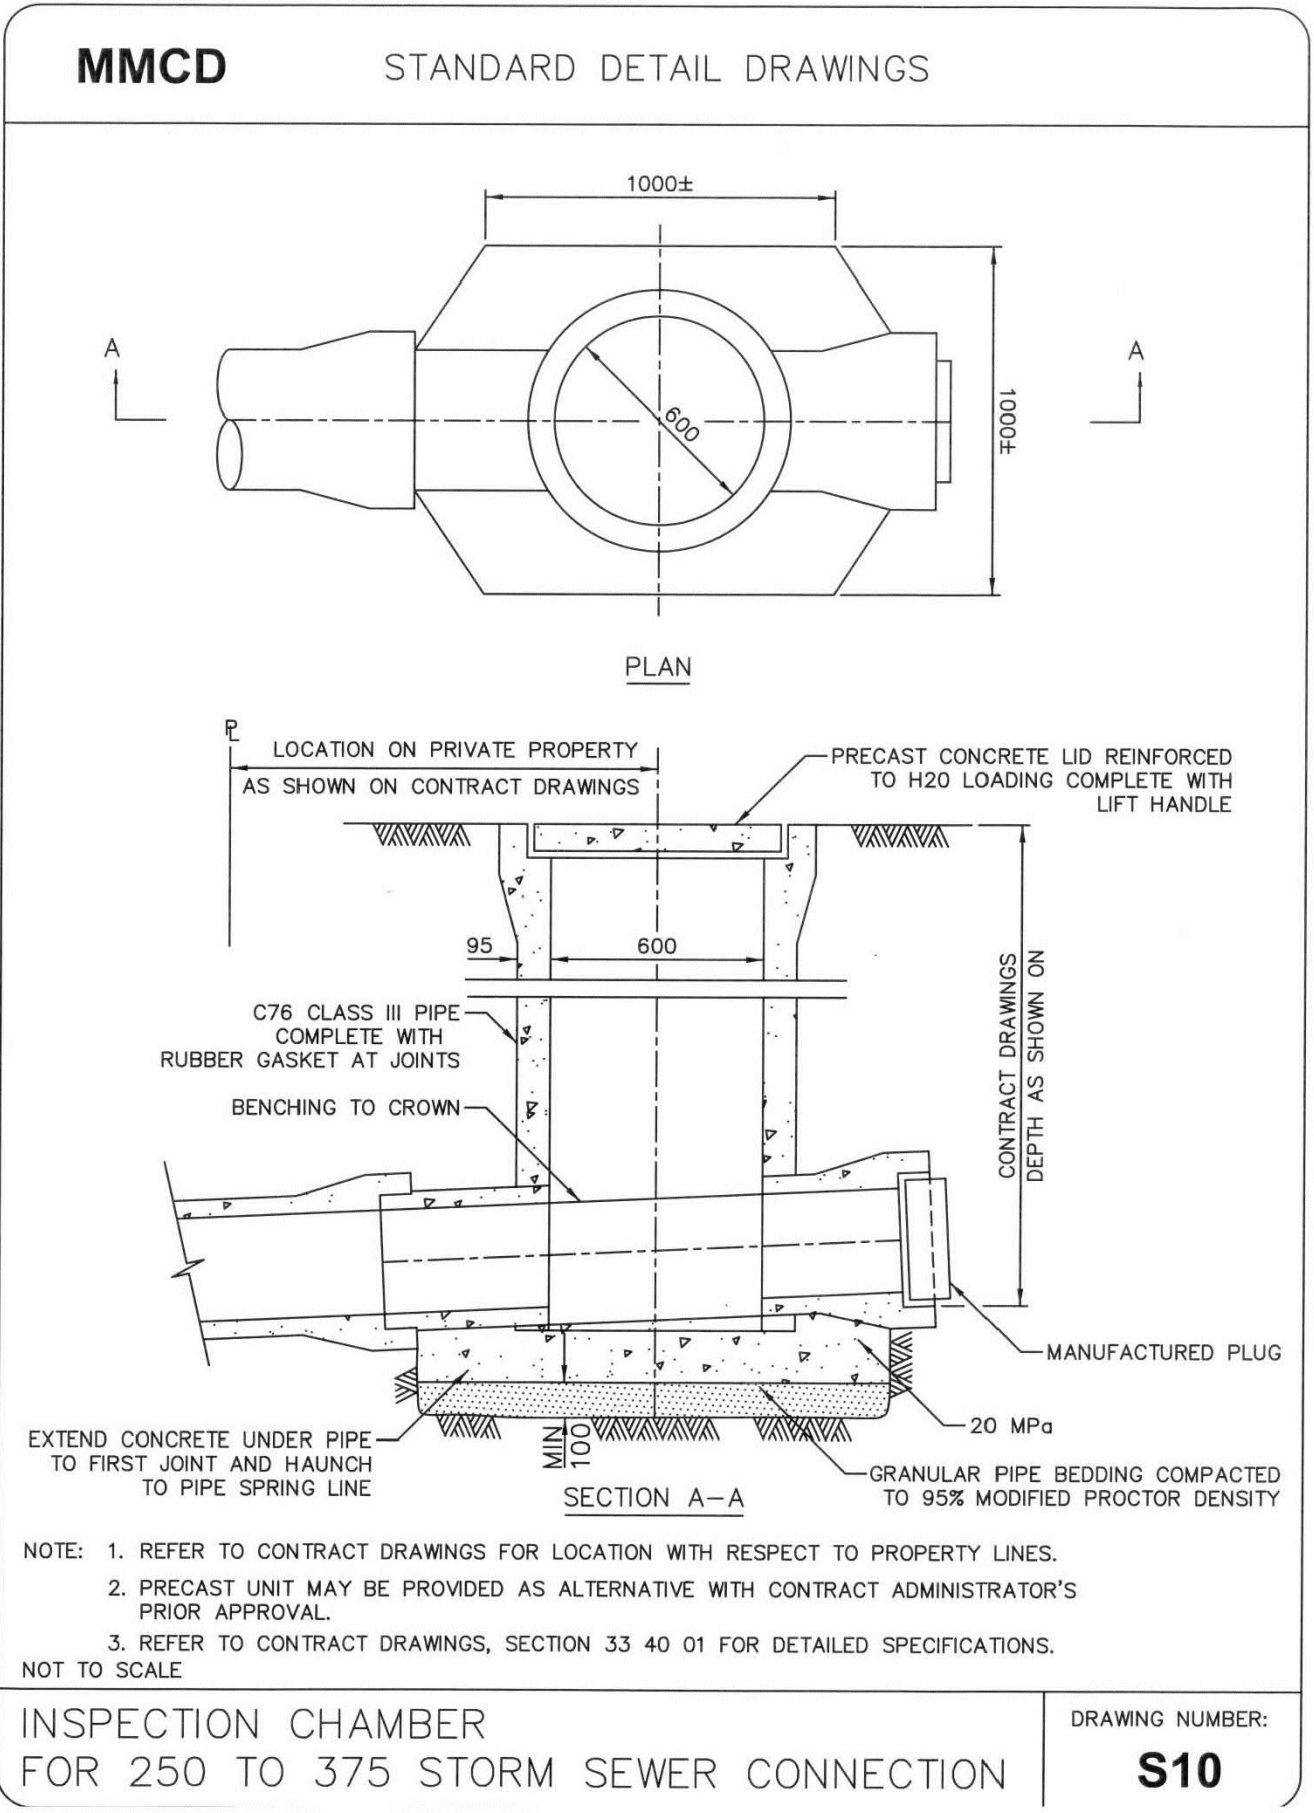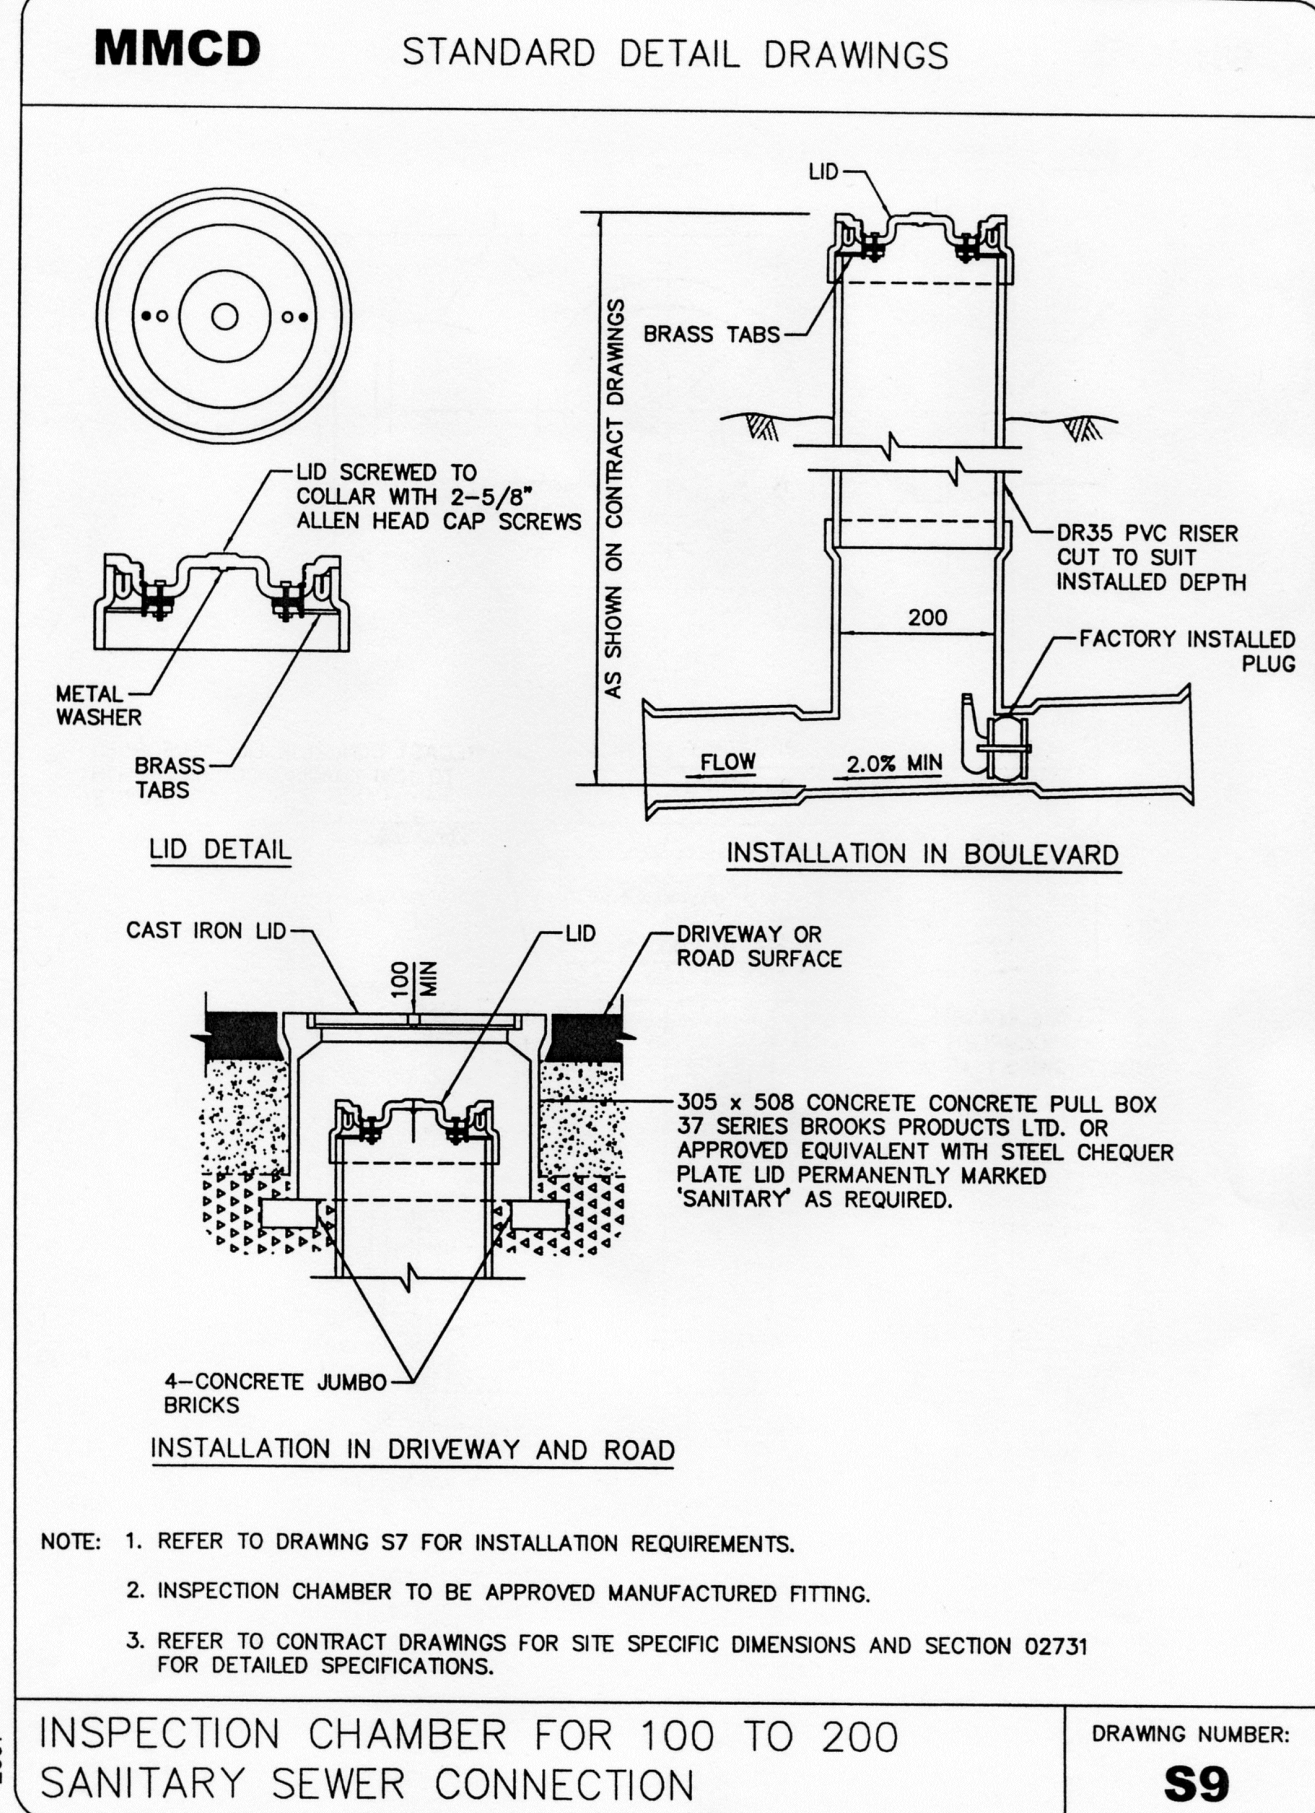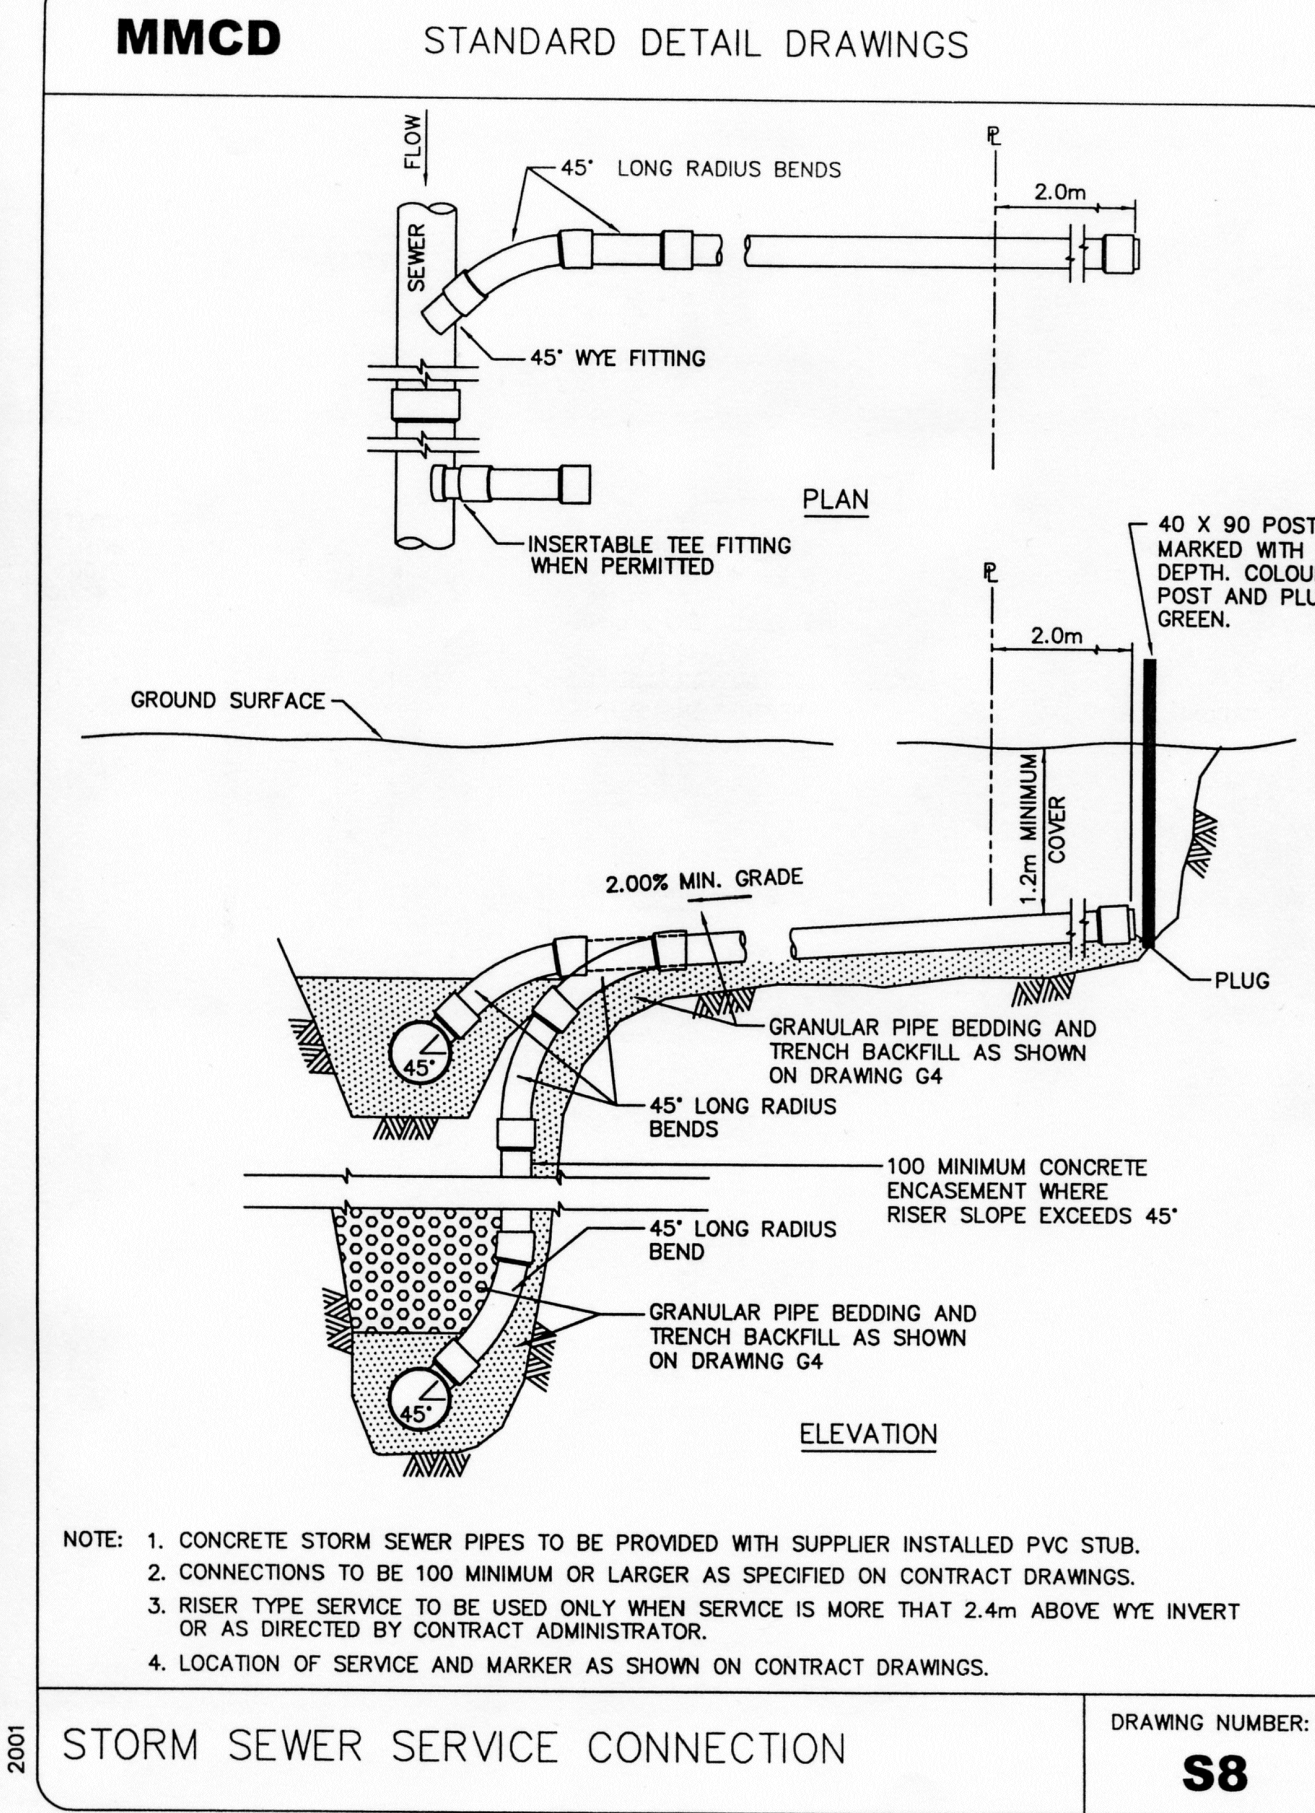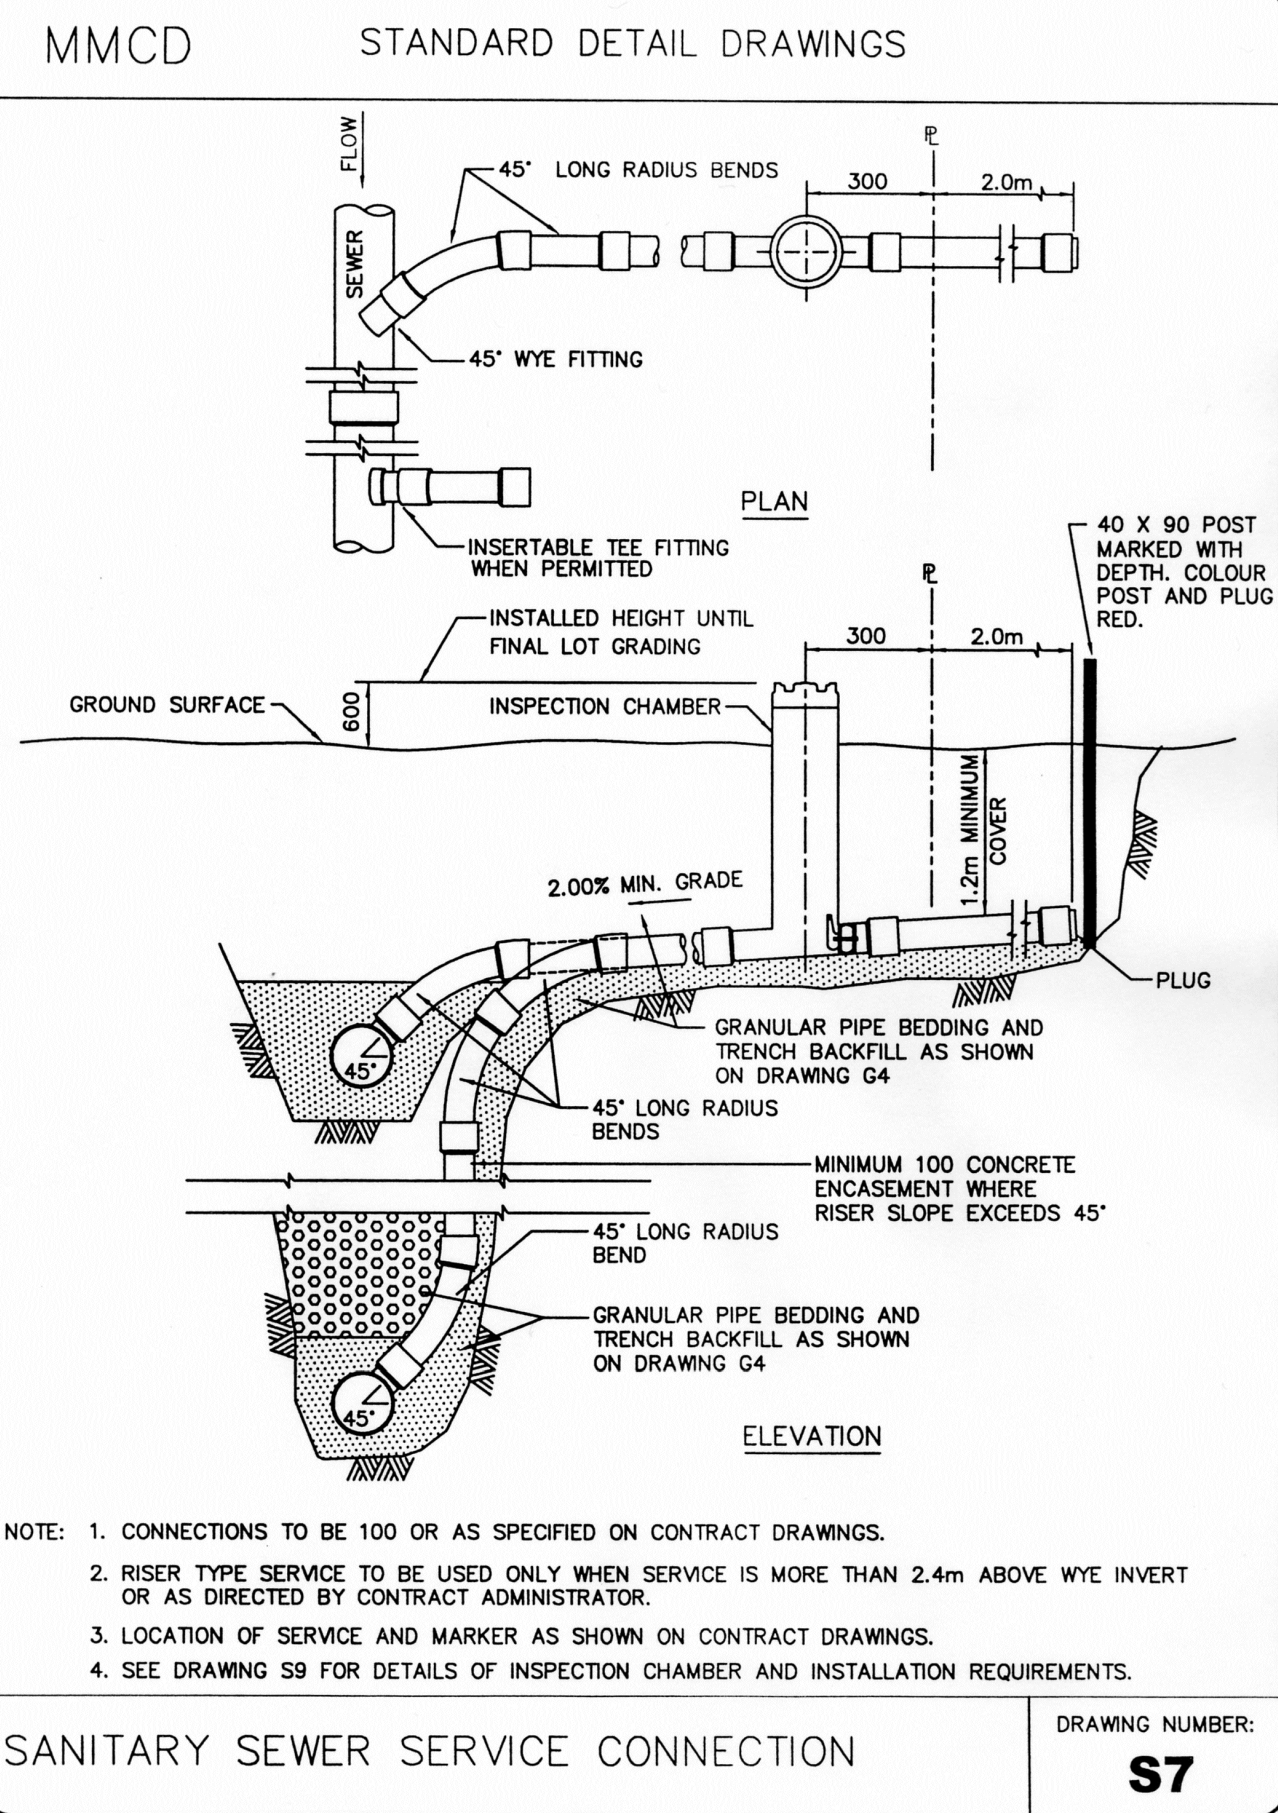

**SITE MAP**

**DRAWING LEGEND**

	EXISTING	PROP.	TO BE REMOVED
LEGAL LINE	---	---	---
EASMENT	---	---	---
WATERMAIN	---	---	---
SANITARY	---	---	---
STORM	---	---	---
HYDRO	---	---	---
TEL	---	---	---
STREETLIGHT	---	---	---
GAS	---	---	---

	EXISTING	PROP.	TO BE REMOVED
FIRE HYDRANT	---	---	---
GATE VALVE	---	---	---
AIR VALVE	---	---	---
REDUCER	---	---	---
INSPECTION CHAMBER	---	---	---
CATCHBASIN (STDSI)	---	---	---
CAP	---	---	---
MANHOLE	---	---	---
POWER POLE	---	---	---
STREETLIGHT	---	---	---

approved

client

580049 BC LTD.

project

THE RIDGE AT PEMBERTON  
 PHASE 1  
 PEMBERTON, BC

title

DETAILS


no.	(y/m/d)	revision	CHK'D
18	18-02-06	PROJECT RECORDS OFFSITE	KBH
17	18-02-06	PROJECT RECORDS ONSITE	KBH
16	17-10-17	PROJECT RECORDS OFFSITE	KBH
15	17-09-19	UPDATED OFFSETS	KBH
14	17-03-07	REISSUED FOR CONSTRUCTION OFFSITE	KBH
13	17-02-27	ISSUED FOR CONSTRUCTION ONSITE	KBH
12	16-11-09	REISSUED FOR CONSTRUCTION ONSITE	KBH
11	16-11-09	REISSUED FOR CONSTRUCTION OFFSITE	KBH

copyright reserved. THIS DRAWING AND DESIGN ARE, AND AT ALL TIMES REMAIN THE EXCLUSIVE PROPERTY OF CREUS ENGINEERING LTD. AND CANNOT BE USED, REPRODUCED OR DISTRIBUTED WITHOUT WRITTEN CONSENT. ©2018 CREUS ENGINEERING LTD.

engineer of record: K.B.H. scales: hor: - vert: -  
 designed by: N.G.B. file no.: 16159  
 drawn by: A.A.P. drawing no.:  
 date: 2016-05-13 DET-2




MMCD STANDARD DETAIL DRAWINGS

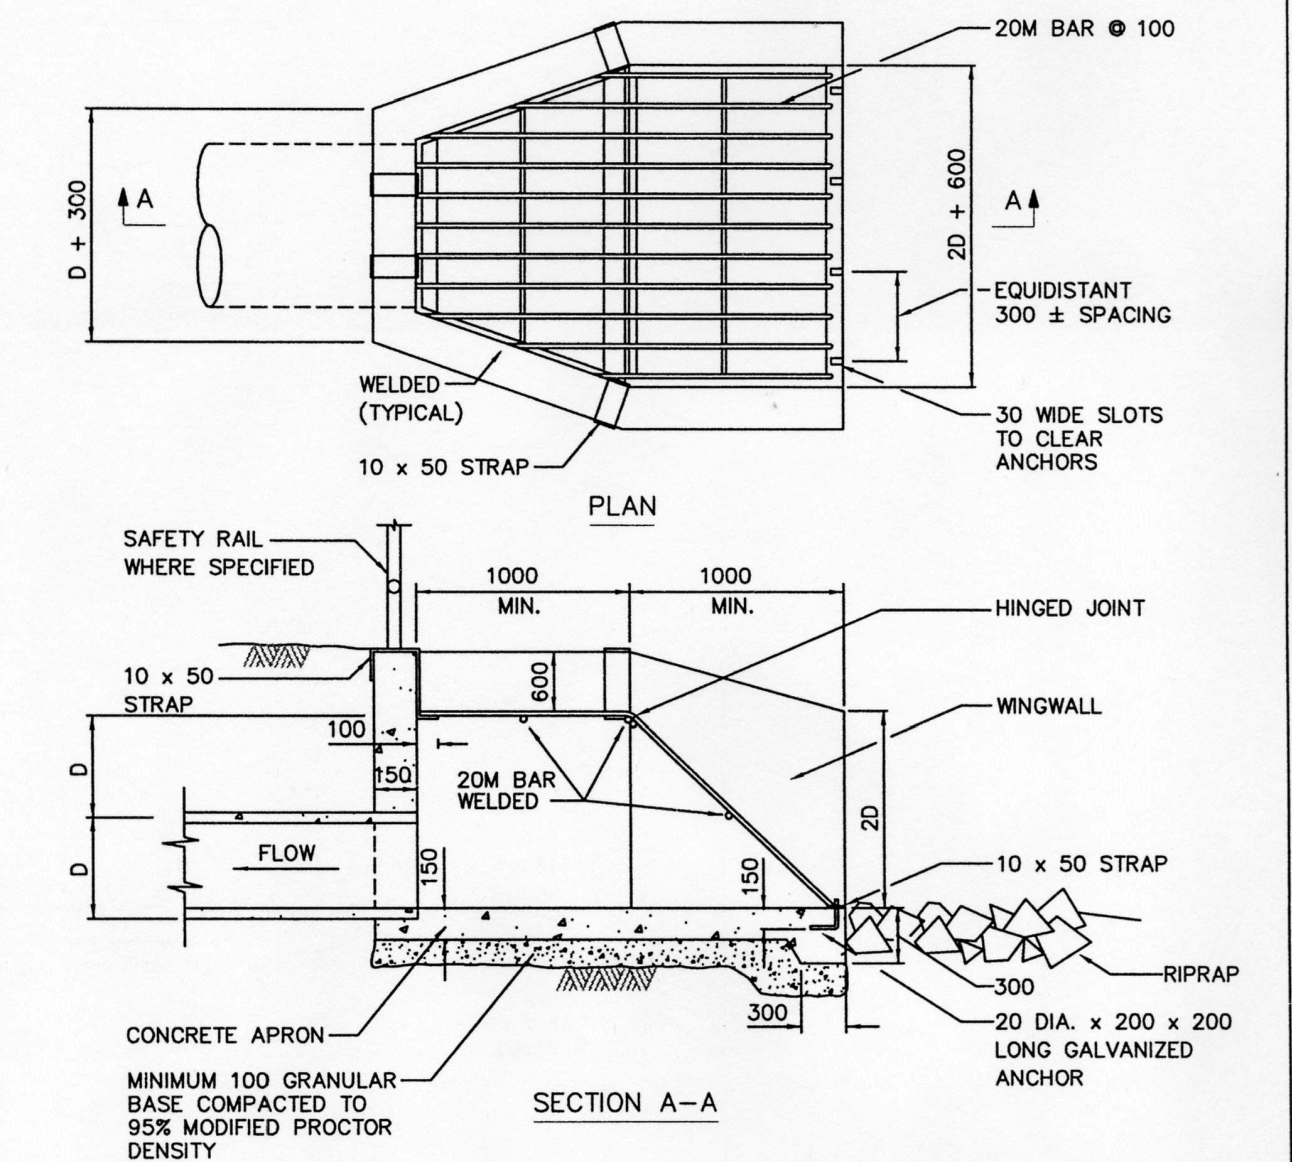

- NOTE: 1. INSTALL SAFETY HANDRAIL IF SPECIFIED ON CONTRACT DRAWINGS.  
 2. PRECAST UNIT MAY BE PROVIDED AS ALTERNATIVE WITH CONTRACT ADMINISTRATOR'S PRIOR APPROVAL.  
 3. ALL STEEL COMPONENTS TO BE HOT DIPPED GALVANIZED AFTER FABRICATION.  
 4. SAFETY GRILLAGE TO BE WELDED AT ALL JOINTS AND CONNECTIONS EXCEPT AT ANCHOR BOLTS.  
 5. REFER TO CONTRACT DRAWINGS FOR LOCATIONS AND SITE SPECIFIC DIMENSIONS. REFER TO SECTIONS 03200 AND 03300 FOR DETAILED SPECIFICATIONS.

DRAWING NUMBER: **S13**


STORM SEWER INLET WITH SAFETY GRILLAGE

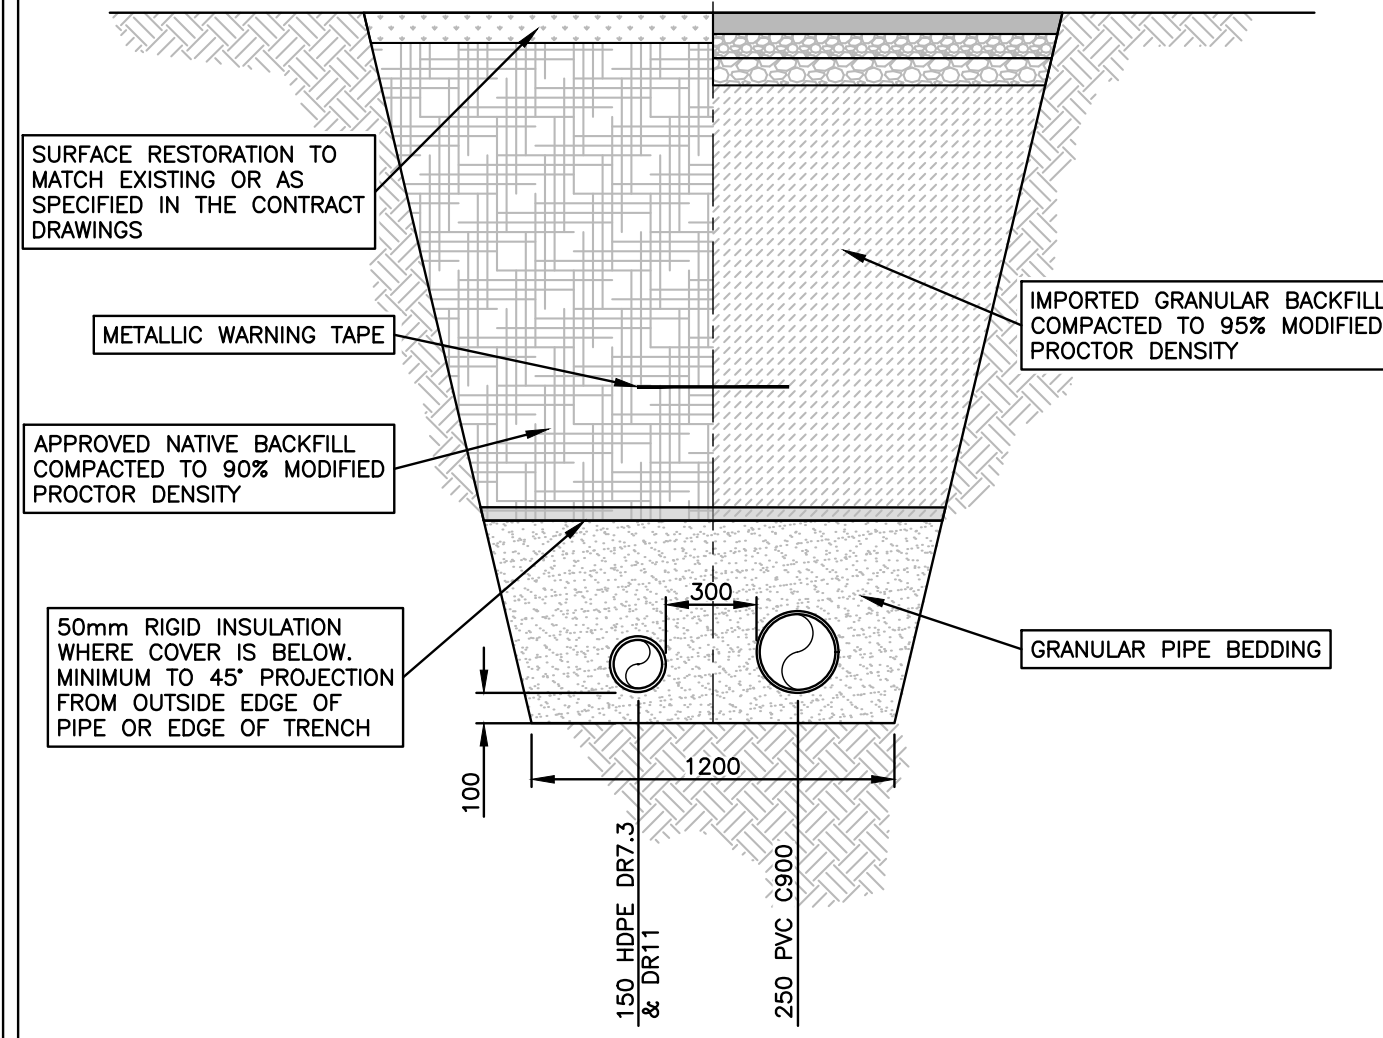

1. TRENCHING TO COMPLY WITH ALL REQUIREMENTS OF WORKSAFE BC.  
 2. REFER TO CONTRACT DRAWINGS, SECTION 31 23 01 FOR DETAILED SPECIFICATIONS.  
 3. LOCALLY LOWER 150 HDPE WM @ CROSSING TO ALLOW MIN 100mm COVER c/w SANDBAGS.


WATER MAIN COMMON TRENCH DETAIL

SCALE 1:25

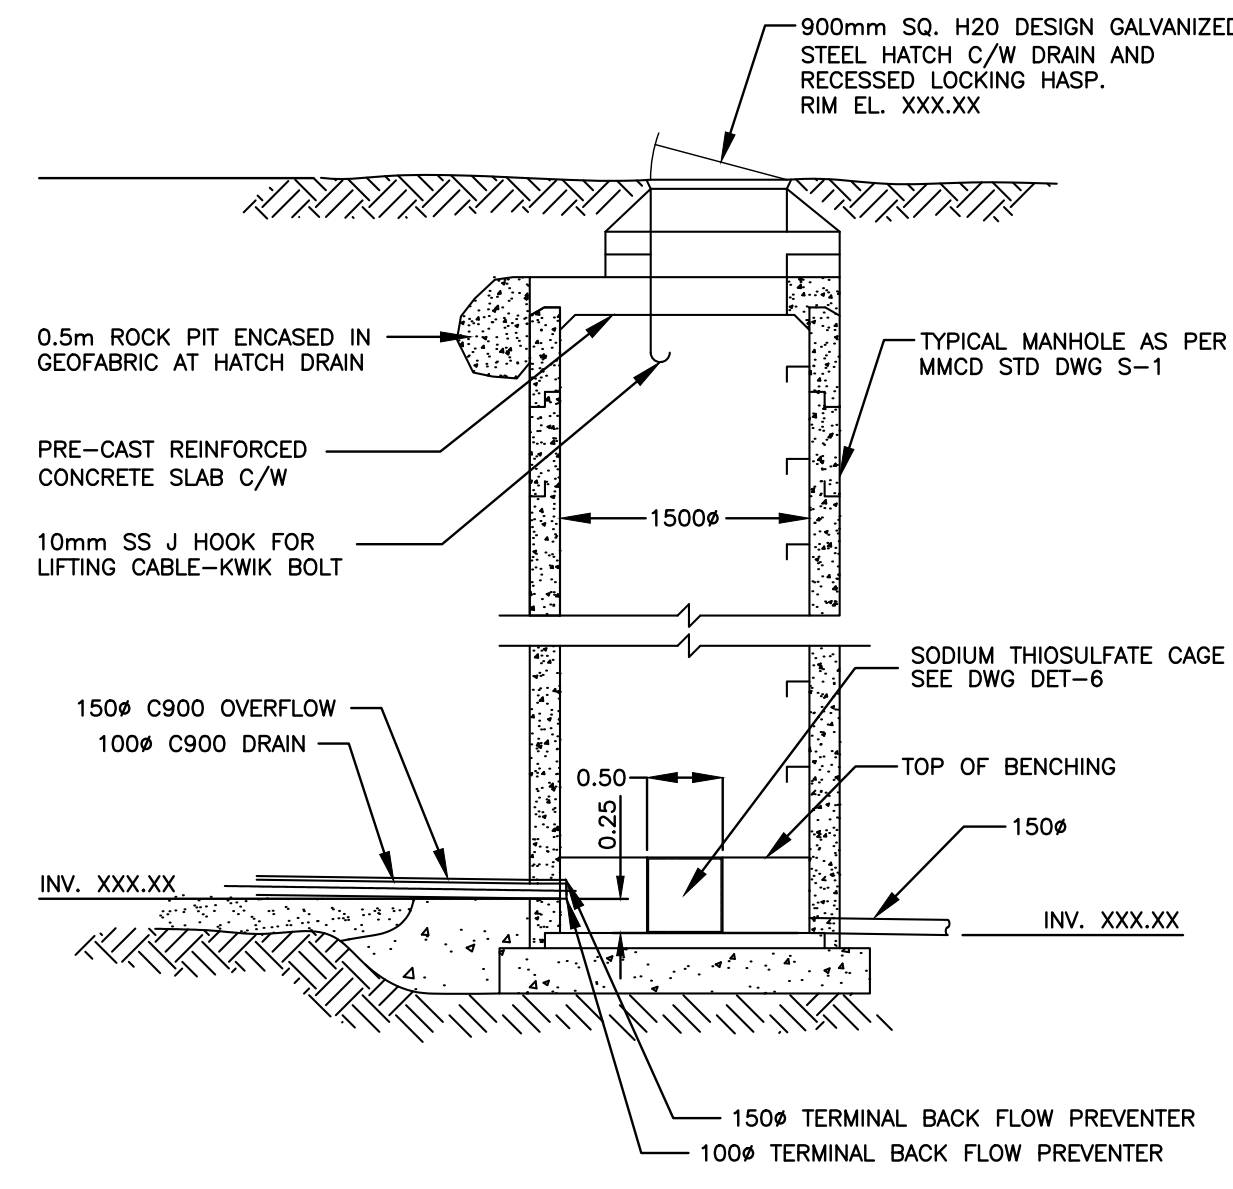

DECHLORINATION SUMP DETAIL

SCALE 1:50

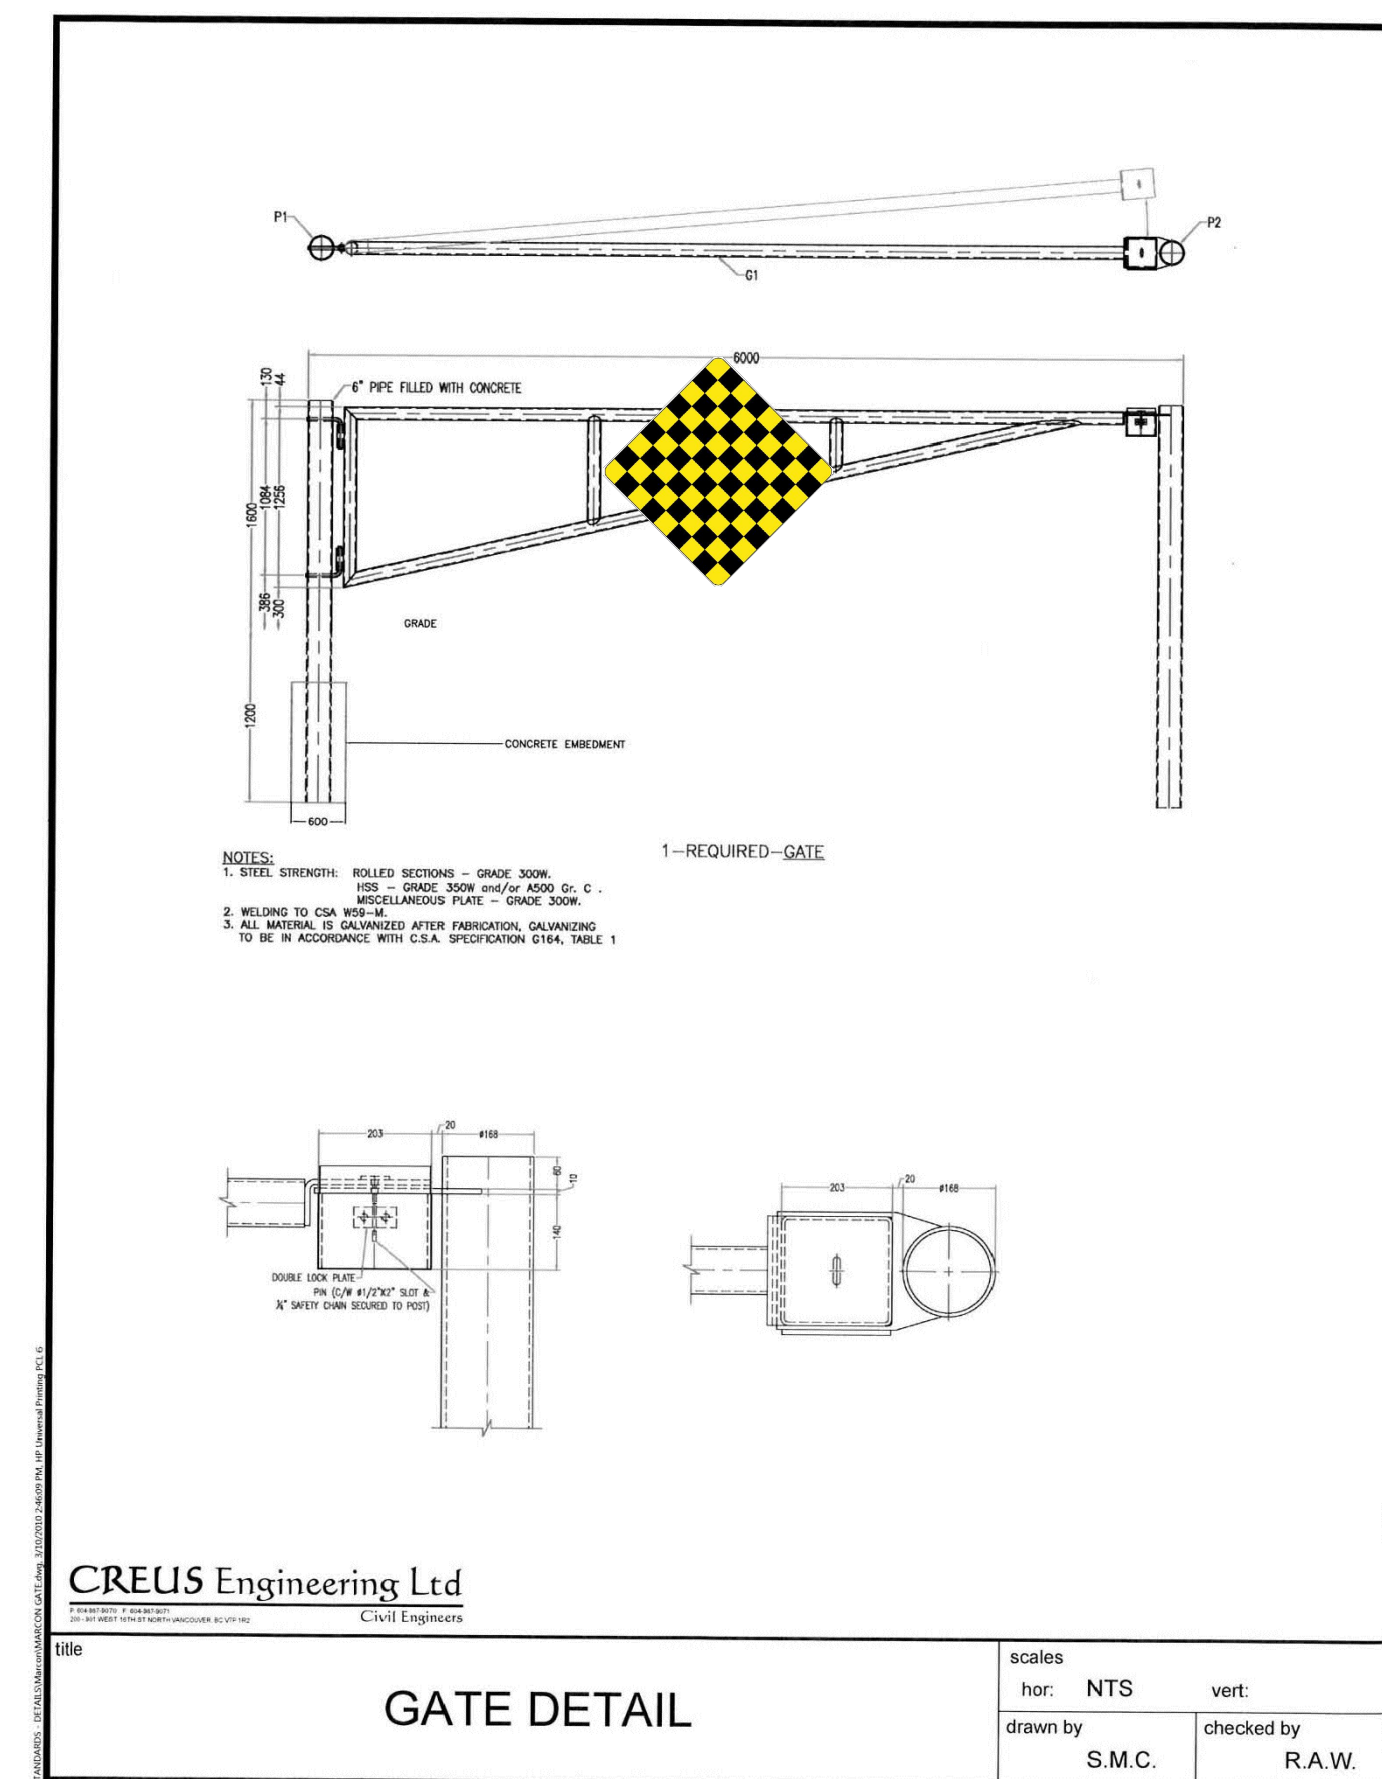

GATE DETAIL

Scale: hor: N.T.S. vert: N.T.S.  
 drawn by: S.M.C. checked by: R.A.W.

CREUS Engineering

Civil Engineers & Project Managers  
 SUITE 200-901 16TH ST WEST, NORTH VANCOUVER BC, V7P1R2  
 PH: 604-987-0070 WEBSITE: www.creus.ca

SITE MAP

DRAWING LEGEND

	EXISTING	PROP.	TO BE REMOVED
LEGAL LINE EASMENT	[Symbol]	[Symbol]	[Symbol]
WATERMAIN	[Symbol]	[Symbol]	[Symbol]
SANITARY	[Symbol]	[Symbol]	[Symbol]
STORM	[Symbol]	[Symbol]	[Symbol]
HYDRO	[Symbol]	[Symbol]	[Symbol]
TEL	[Symbol]	[Symbol]	[Symbol]
STREETLIGHT	[Symbol]	[Symbol]	[Symbol]
GAS	[Symbol]	[Symbol]	[Symbol]
FIRE HYDRANT	[Symbol]	[Symbol]	[Symbol]
GATE VALVE	[Symbol]	[Symbol]	[Symbol]
AIR VALVE	[Symbol]	[Symbol]	[Symbol]
REDUCER	[Symbol]	[Symbol]	[Symbol]
INSPECTION CHAMBER	[Symbol]	[Symbol]	[Symbol]
CATCHBASIN (STD/SI)	[Symbol]	[Symbol]	[Symbol]
CAP	[Symbol]	[Symbol]	[Symbol]
MANHOLE	[Symbol]	[Symbol]	[Symbol]
POWER POLE	[Symbol]	[Symbol]	[Symbol]
STREETLIGHT	[Symbol]	[Symbol]	[Symbol]

MUELLER® THERMAL-COIL® METER BOX



8F.1



The MUELLER THERMAL-COIL Meter Box provides a means to allow a meter to be read and maintained even though it is set deep in the ground to resist freezing. The THERMAL-COIL Meter Box is designed with the meter installed on a platform that normally sets near the bottom of the box where the ground temperature keeps it warmer. The meter and platform are connected to the service line by coils of polybutylene tubing which allow the meter and platform to be raised to the surface.

The body of the meter box is made from rigid PVC which has a high insulating "R" value to resist frost bridging inside the box. For extremely cold climates, an optional insulating pad is available which traps the relatively warm air rising from the earth inside the box.


MUELLER THERMAL-COIL Meter Boxes are shipped fully assembled, ready for meter installation. Their light weight saves shipping costs and makes installation a one man job in most cases. Every box is factory tested and has a 150 psig maximum working pressure rating.

MUELLER THERMAL-COIL Meter Boxes are available for 5/8" to 1" meters. A wide variety of end connections, control valves, box depths, lids and other options provide you with the meter set you need. Due to the almost endless combination of features available, each box is custom built to your specifications. See page 8F.2 for options and ordering instructions.

Manufactured under one or more of the following: U.S. Patent No. 4,614,113; 4,613,281



MUELLER THERMAL-COIL Meter Box Features

- Rigid .300 minimum wall PVC material holds shape and resists frost bridging
- Optional insulating pad traps earth's heat to prevent freezing in extremely cold climates
- White interior aids visibility
- Meter set is anchored to moveable platform to maintain alignment and stability
- Platform support and reinforcing ring add rigidity to box
- Poly coil tubing provides low friction loss equivalent to a typical conventional meter set of the same size and depth
- Male I.P. thread inlet and outlet connections accept a variety of MUELLER Service Fittings—see section 6
- Optional aluminum bottom available
- Large selection of optional lids

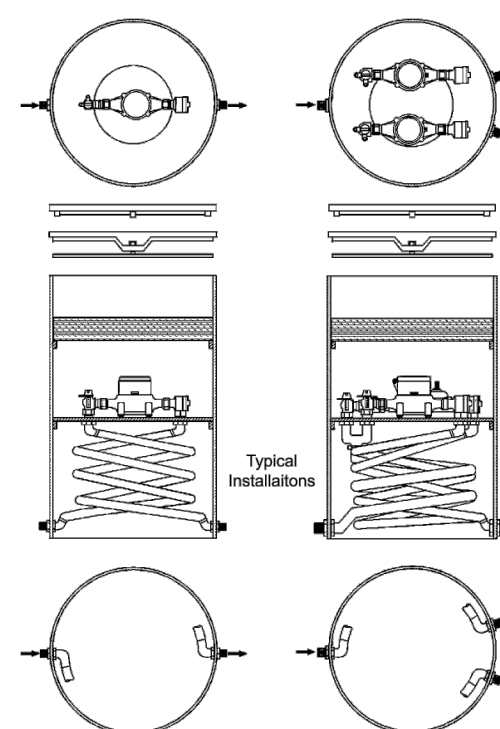


8F-PVC BOXES/VAULTS

MUELLER Valves and Couplings used in these meter box assemblies are manufactured and tested in accordance with ANSI/AWWA C900. Components in contact with potable water will also comply with latest requirements of the Federal Safe Drinking Water Act.

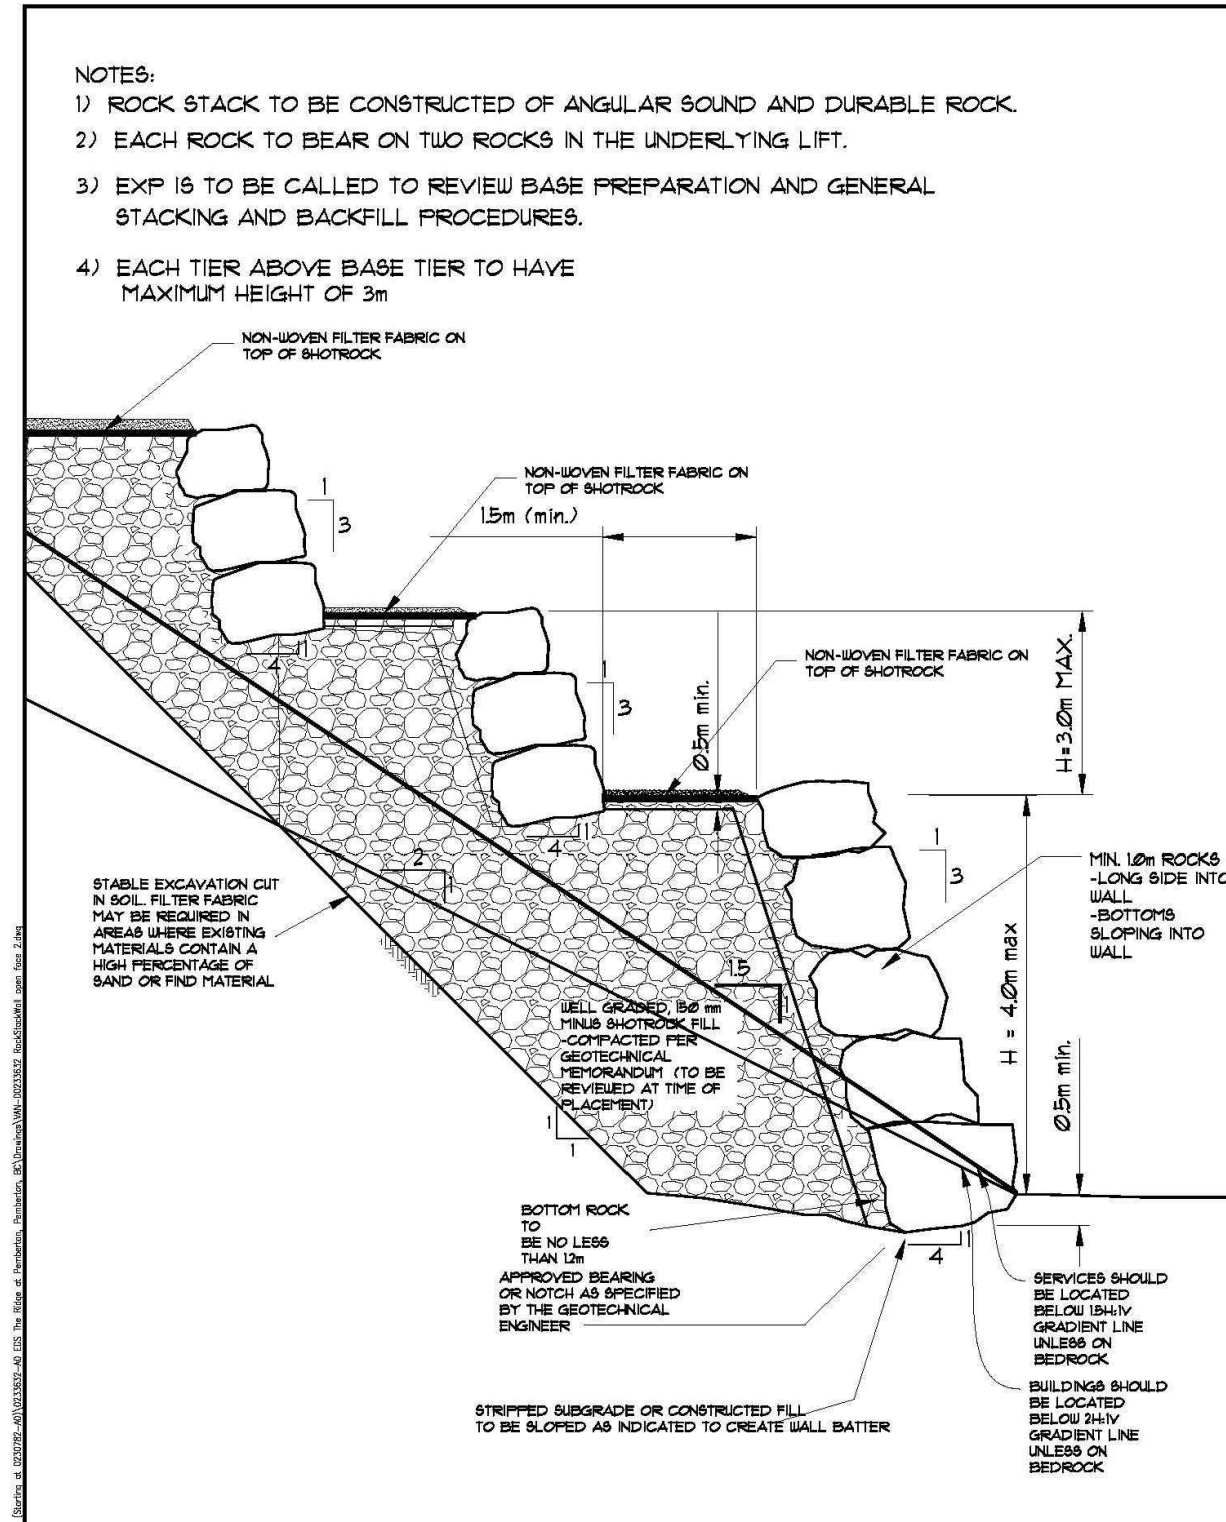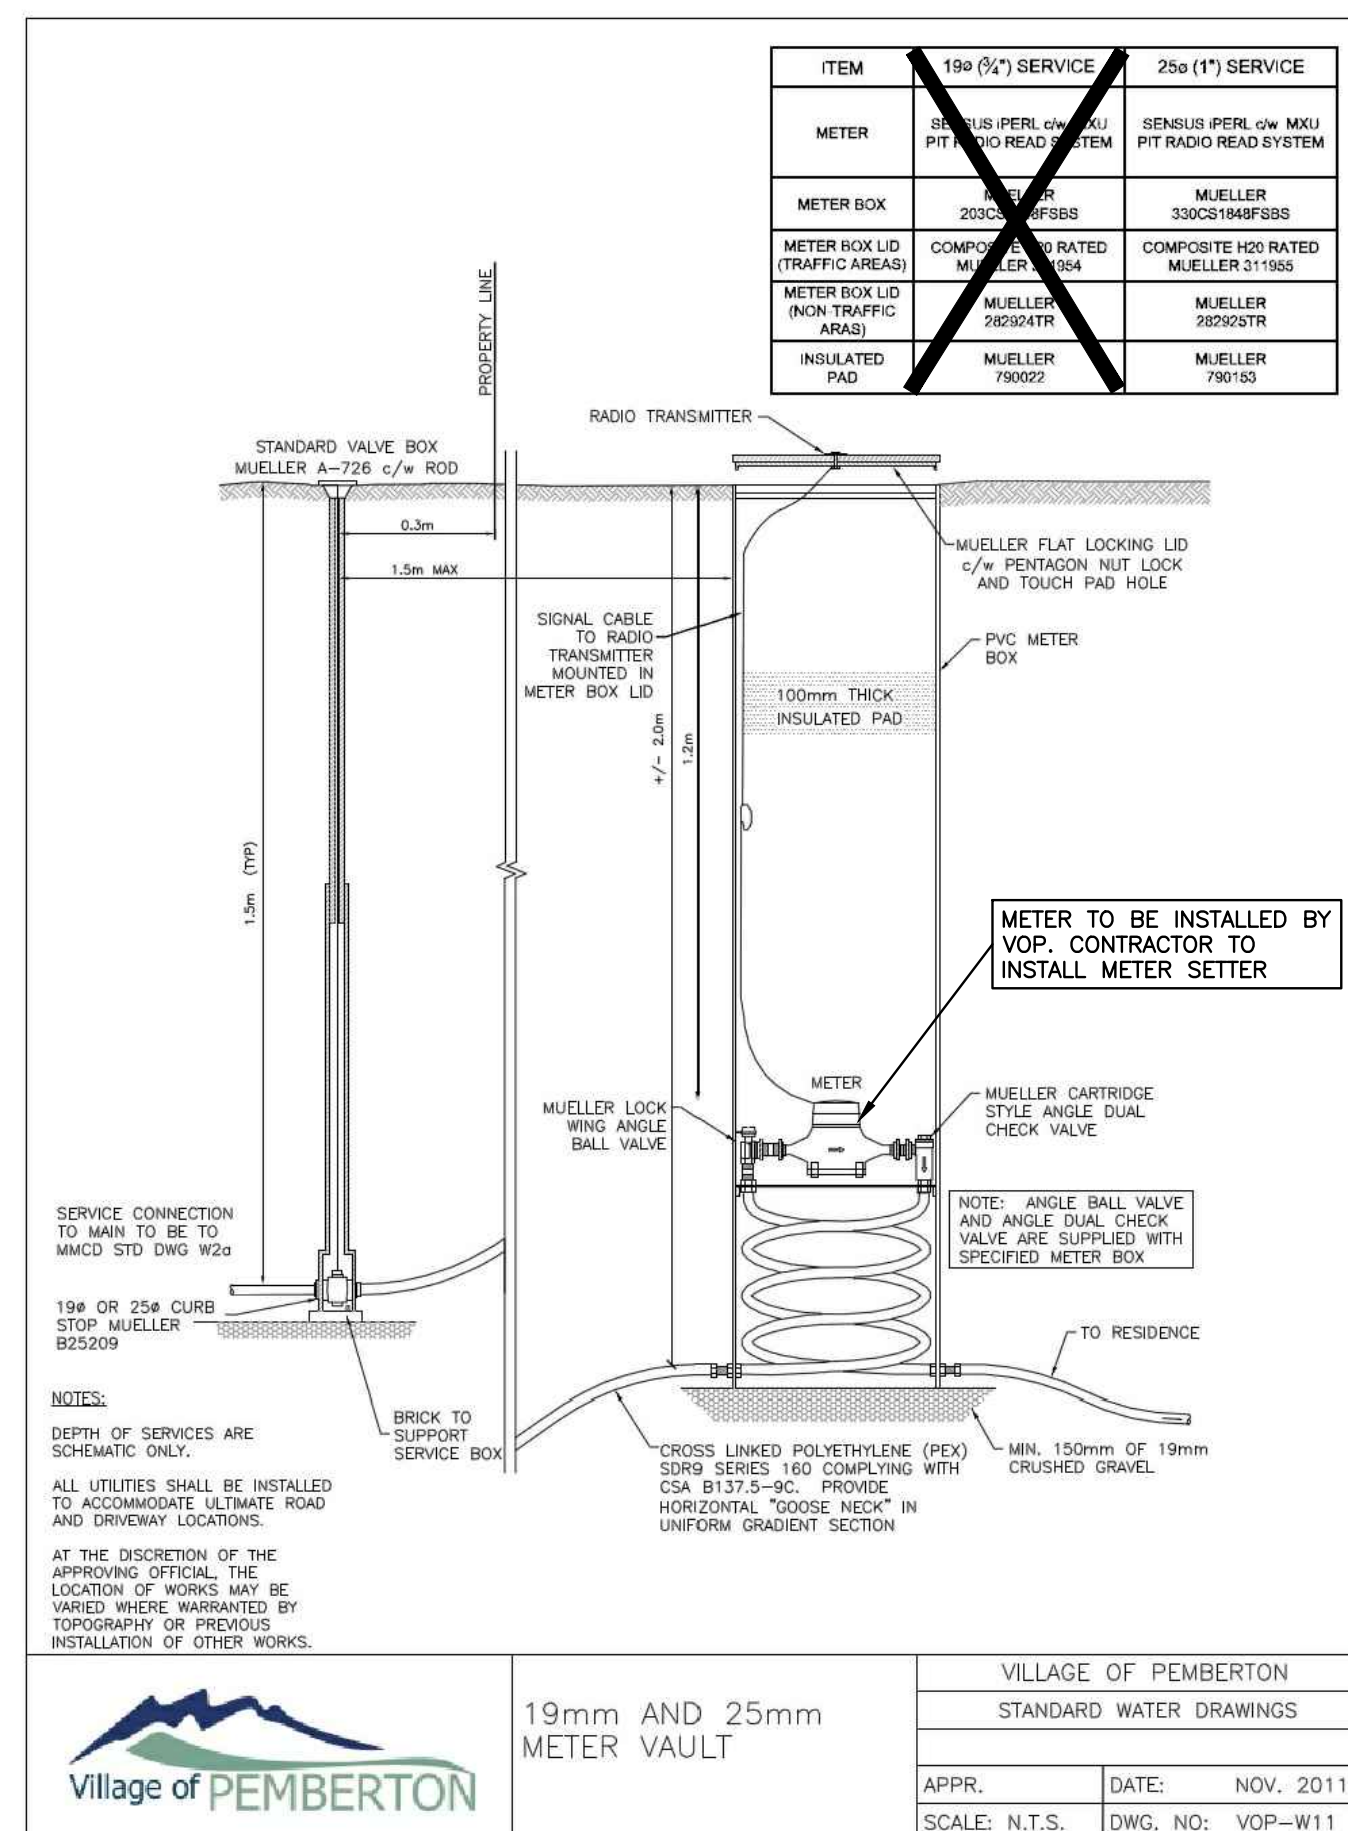

CLIENT	59004900 LTD.	TITLE	TYPICAL ROCK STACK WALL DETAIL - TERRACED
PROJECT	THE RIDGE AT PEMBERTON PEMBERTON, B.C.	DATE	2016-07-27
PROJECT NO.	VAN-00233632-A0	SCALE	NTS
DATE	2016-07-27	DWG NO.	FIGURE 1

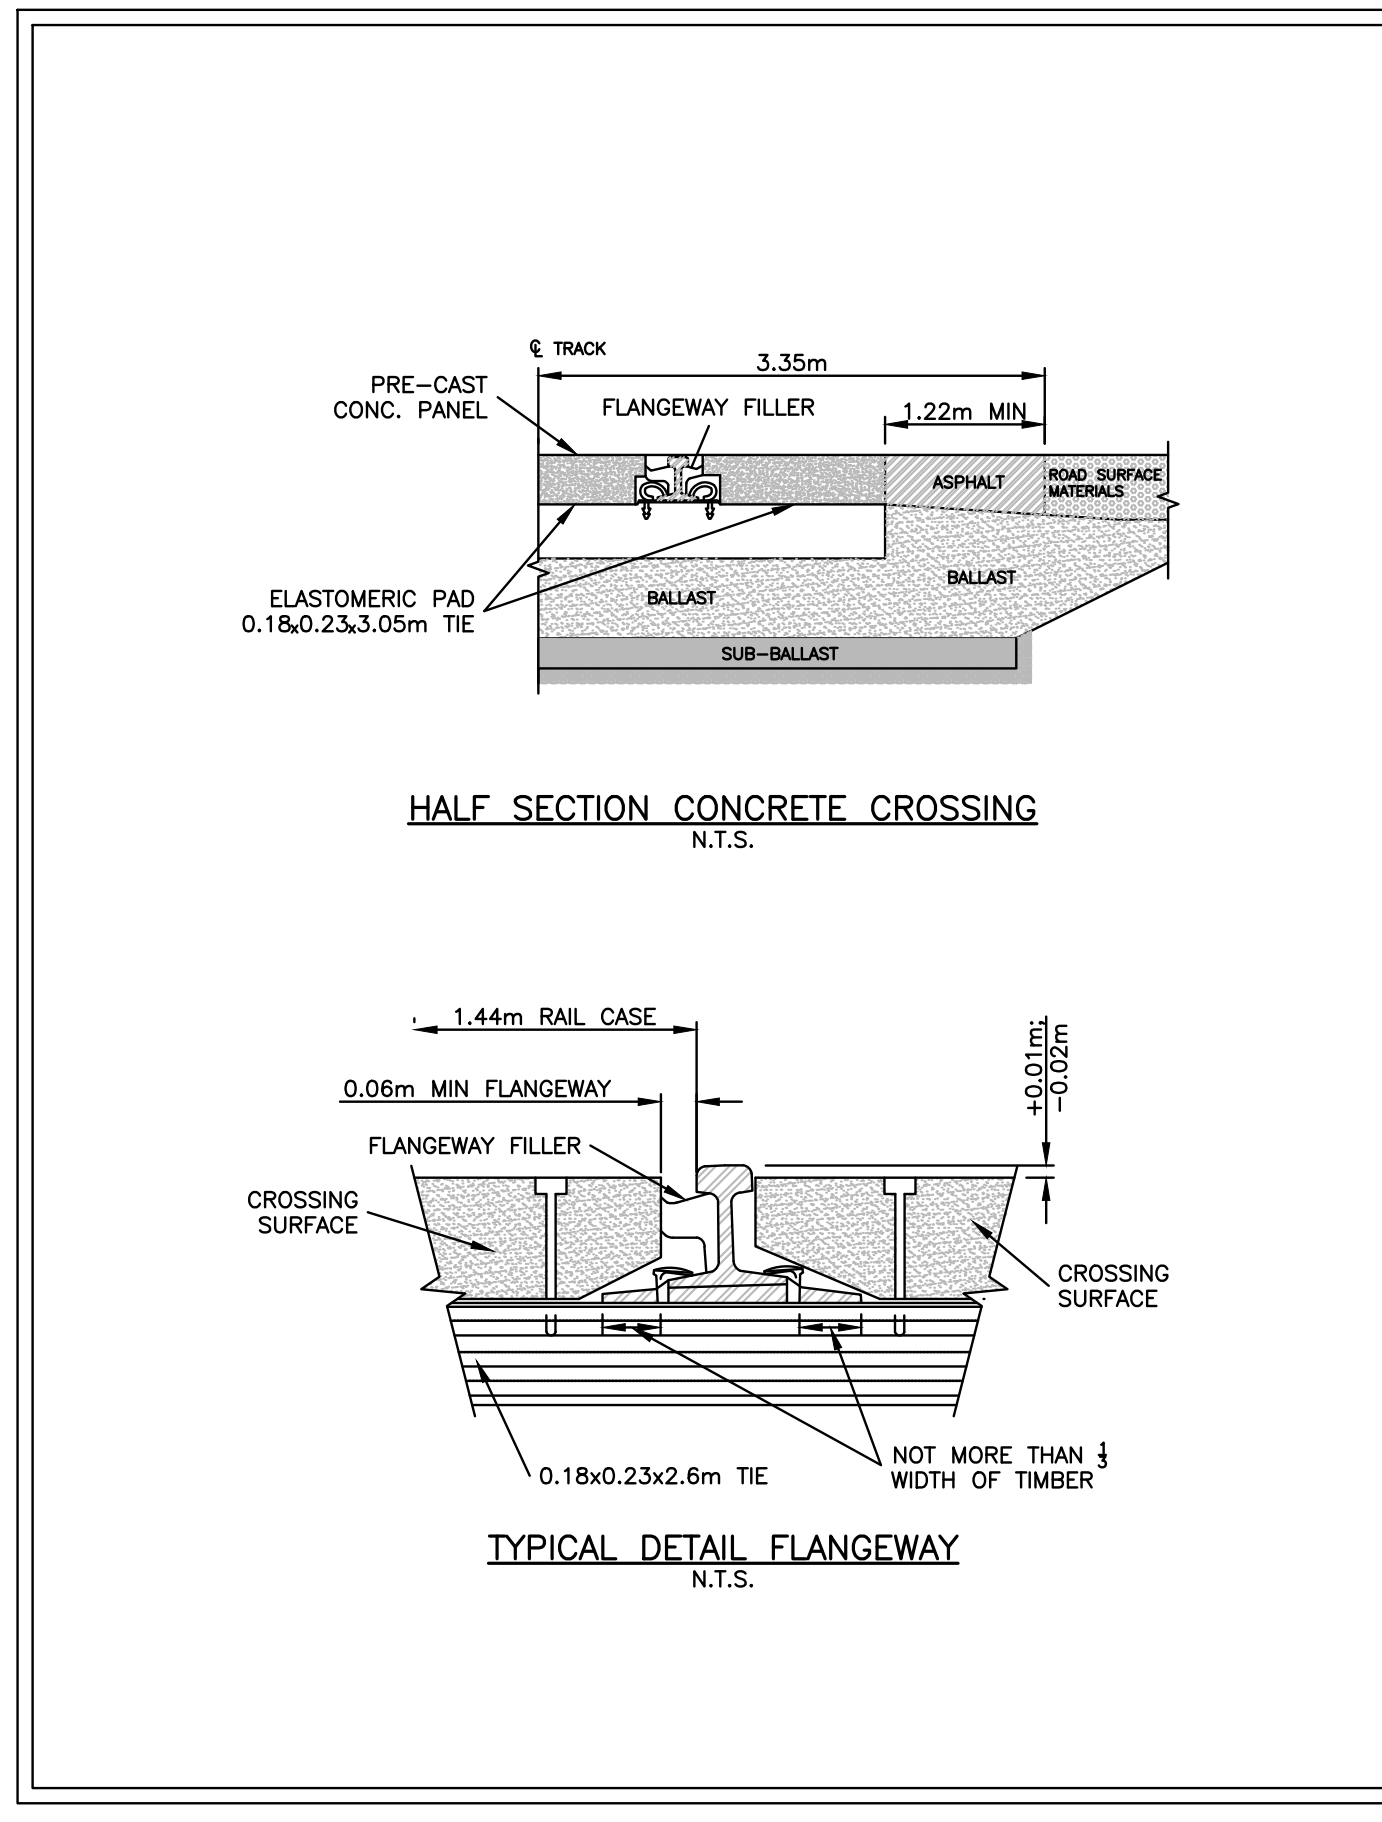

590049 BC LTD.

THE RIDGE AT PEMBERTON PHASE 1 PEMBERTON, BC









DETAILS

no.	(y/m/d)	revision	chk'd
19	18-02-06	PROJECT RECORDS OFFSITE	KBH
18	18-02-06	PROJECT RECORDS ONSITE	KBH
17	17-10-17	PROJECT RECORDS OFFSITE	KBH
16	17-03-07	REISSUED FOR CONSTRUCTION OFFSITE	KBH
15	17-02-27	ISSUED FOR CONSTRUCTION ONSITE	KBH
14	17-01-18	REISSUED FOR ADDENDA 1	KBH
13	16-11-09	REISSUED FOR CONSTRUCTION ONSITE	KBH
12	16-11-09	REISSUED FOR CONSTRUCTION OFFSITE	KBH

COPYRIGHT RESERVED. THIS DRAWING AND DESIGN ARE AND AT ALL TIMES REMAIN THE EXCLUSIVE PROPERTY OF CREUS ENGINEERING LTD. AND CANNOT BE USED, REPRODUCED OR DISTRIBUTED WITHOUT WRITTEN CONSENT. ©2016 CREUS ENGINEERING LTD.

engineer of record	K.B.H.	scale	hor: - vert: -
designed by	N.G.B.	file no.	16159
drawn by	A.A.P.	drawing no.	DET-3
date	2016-05-13		



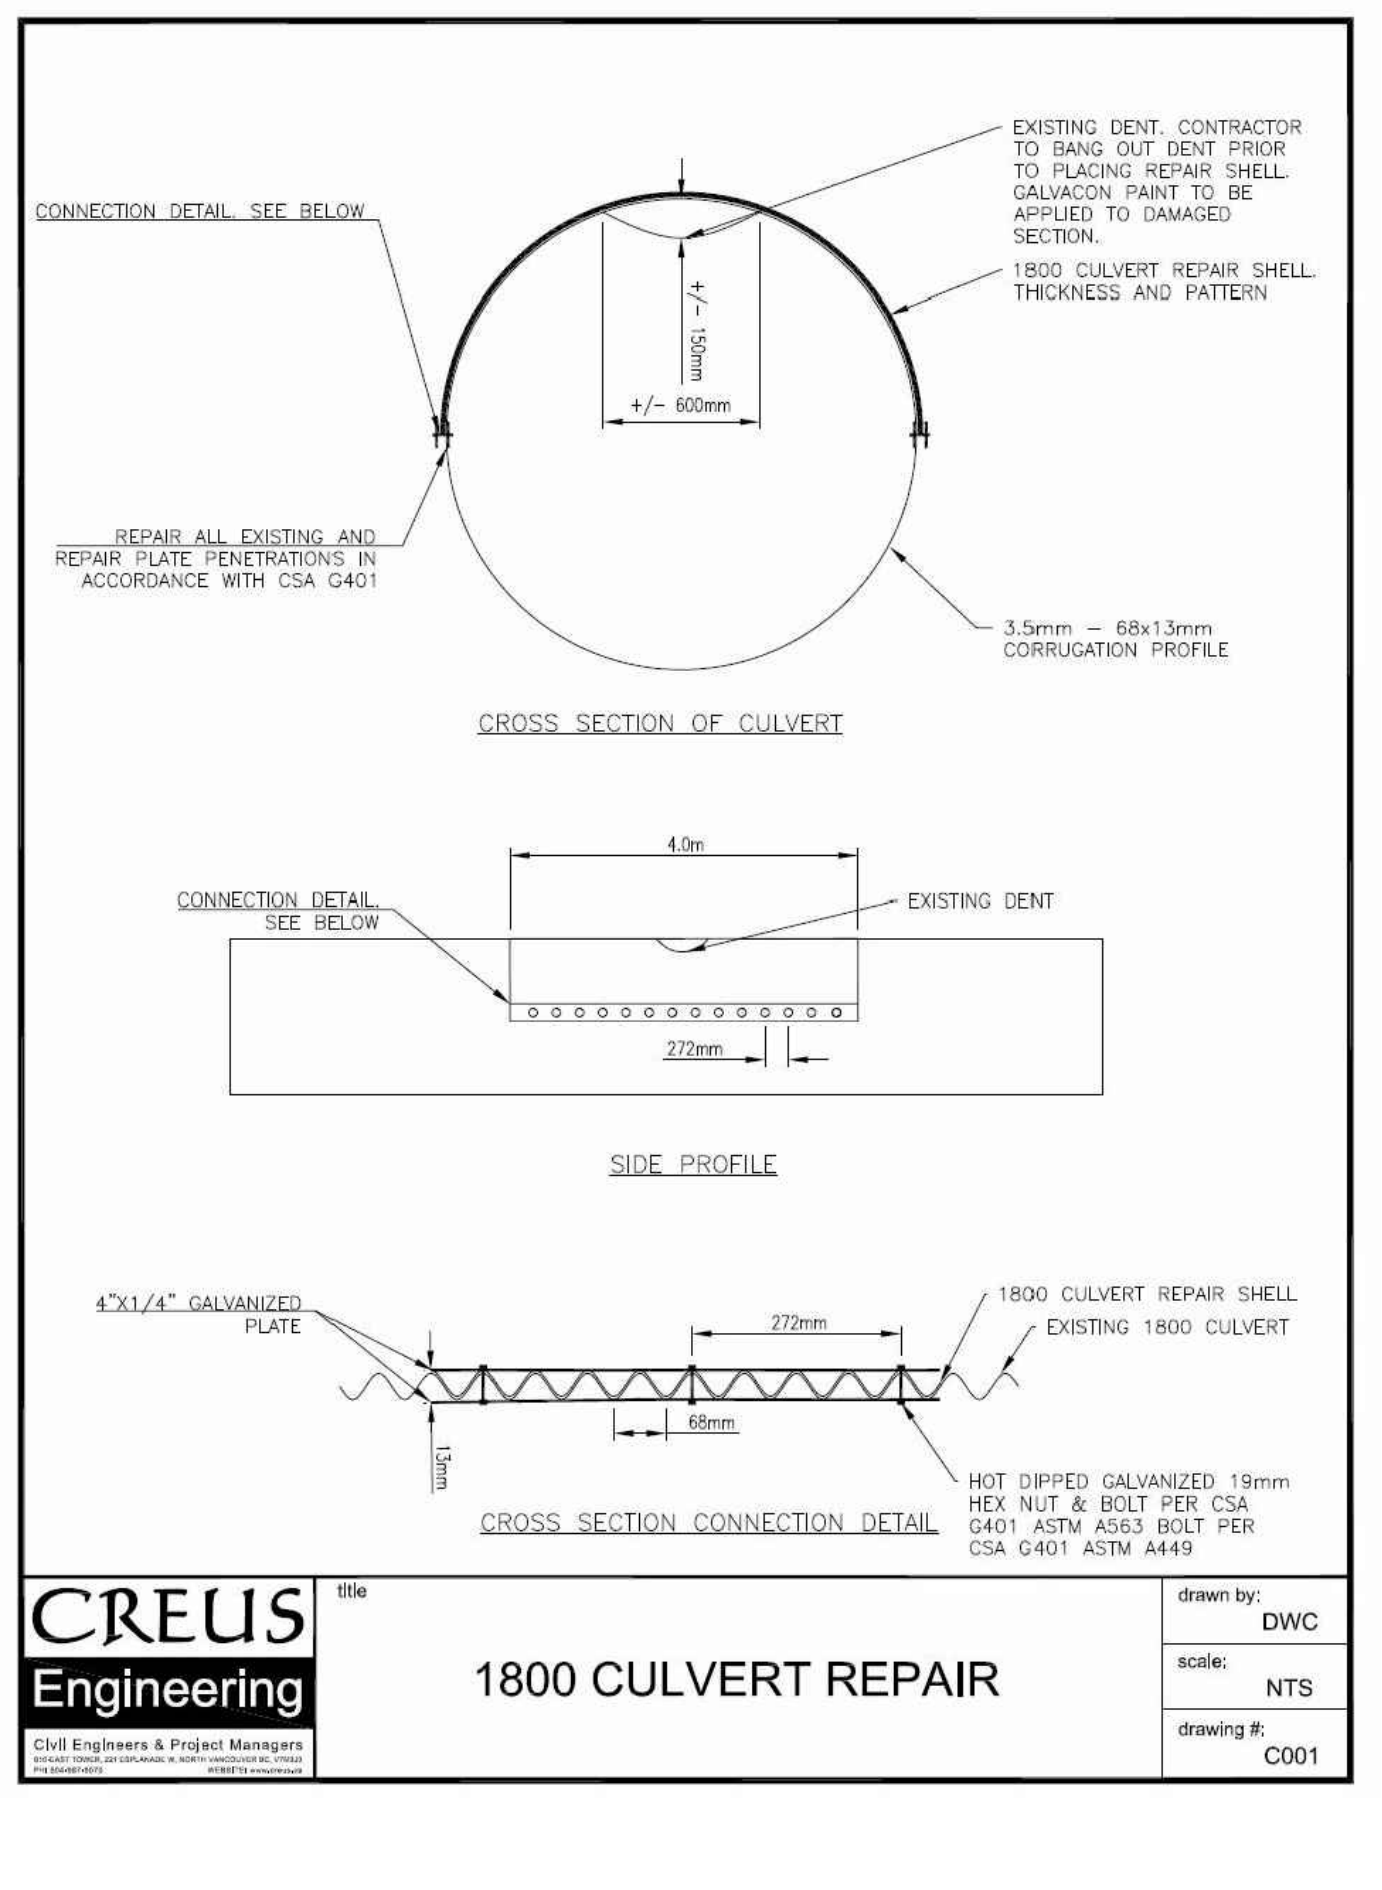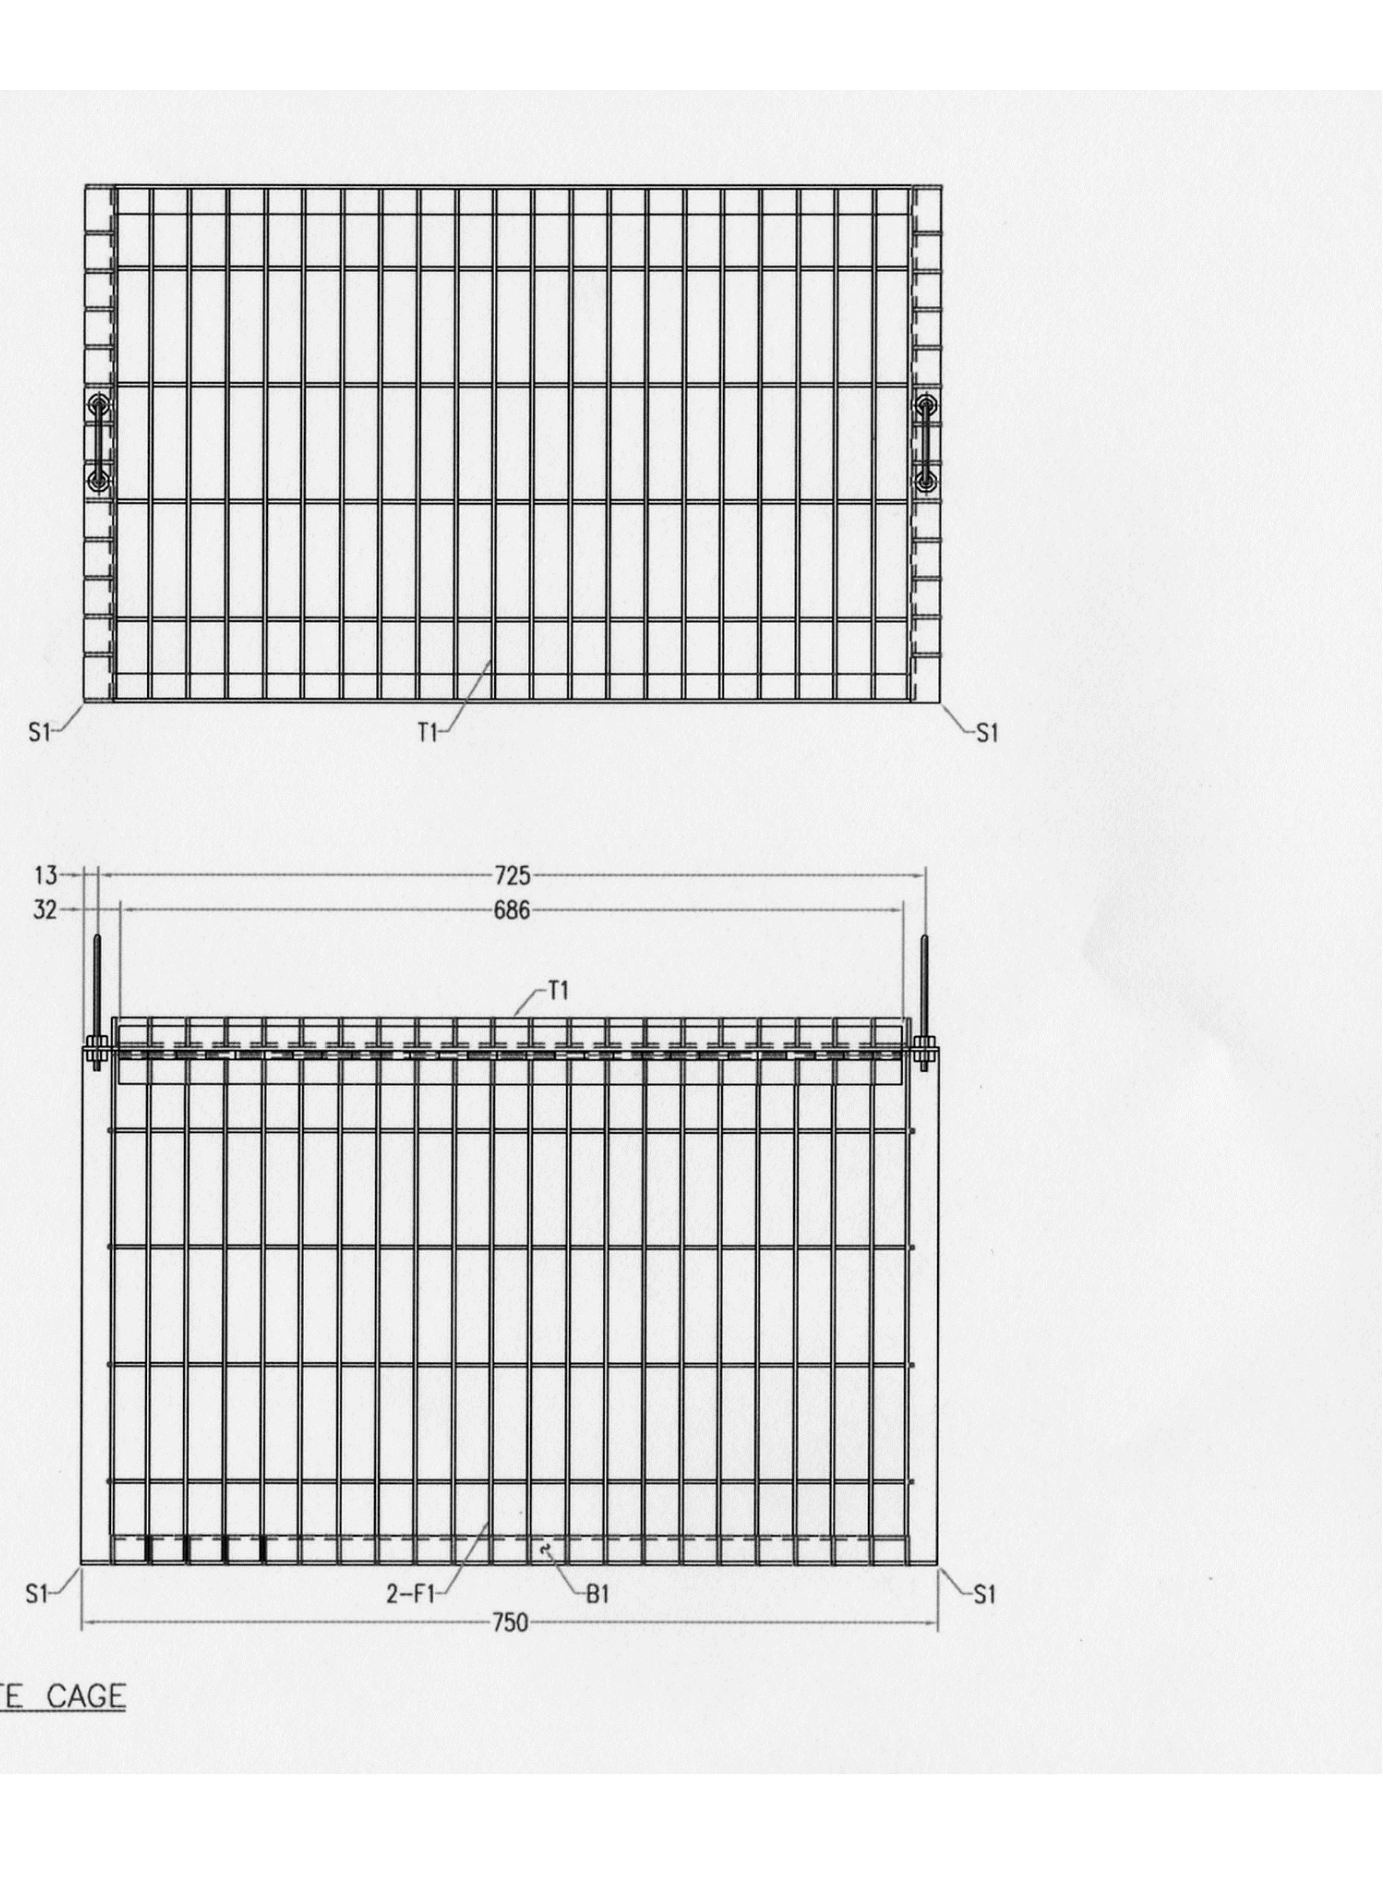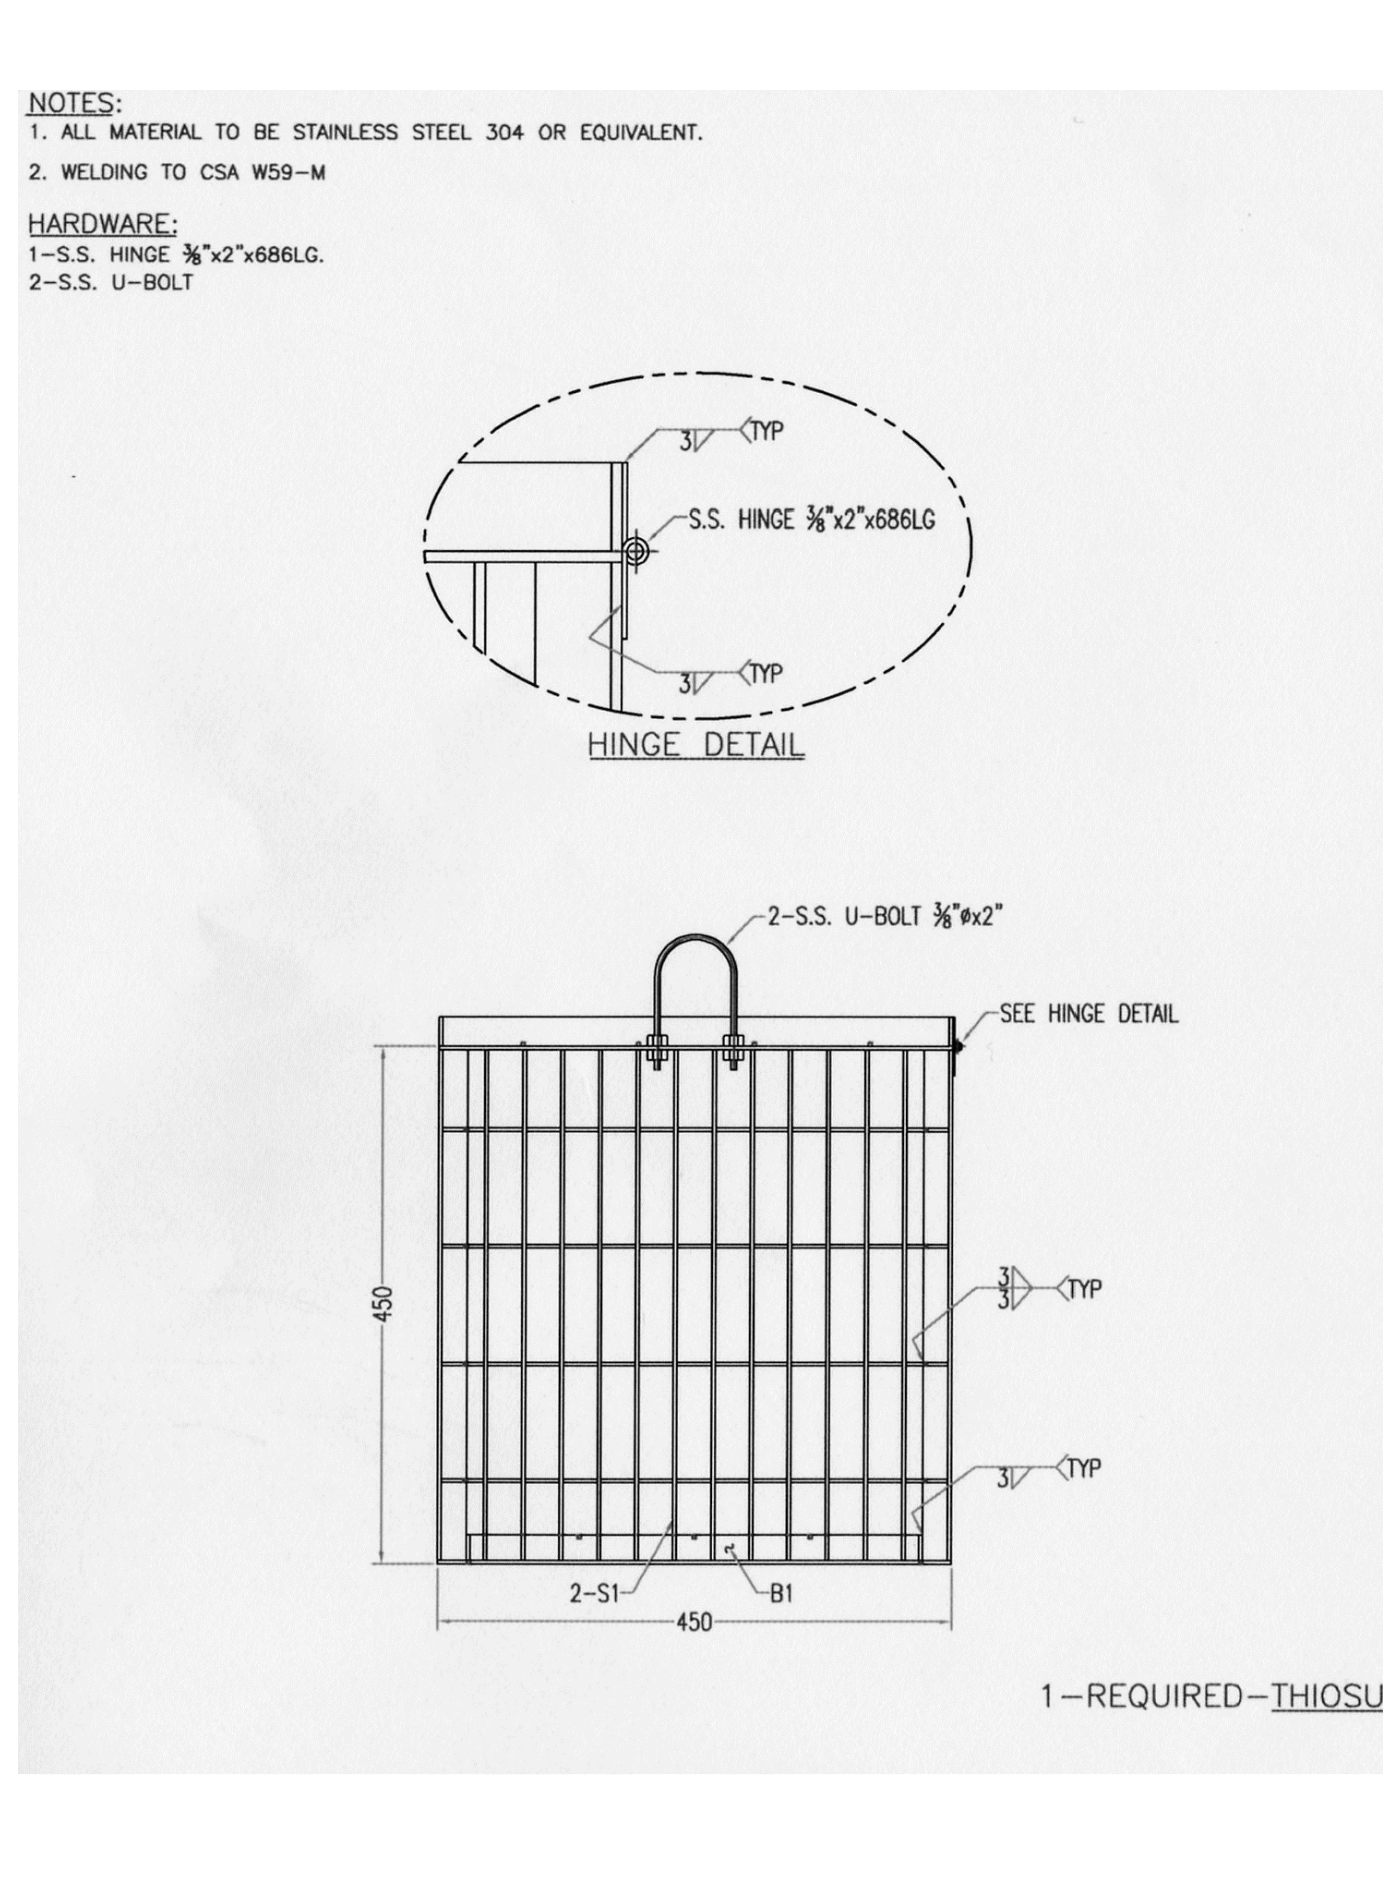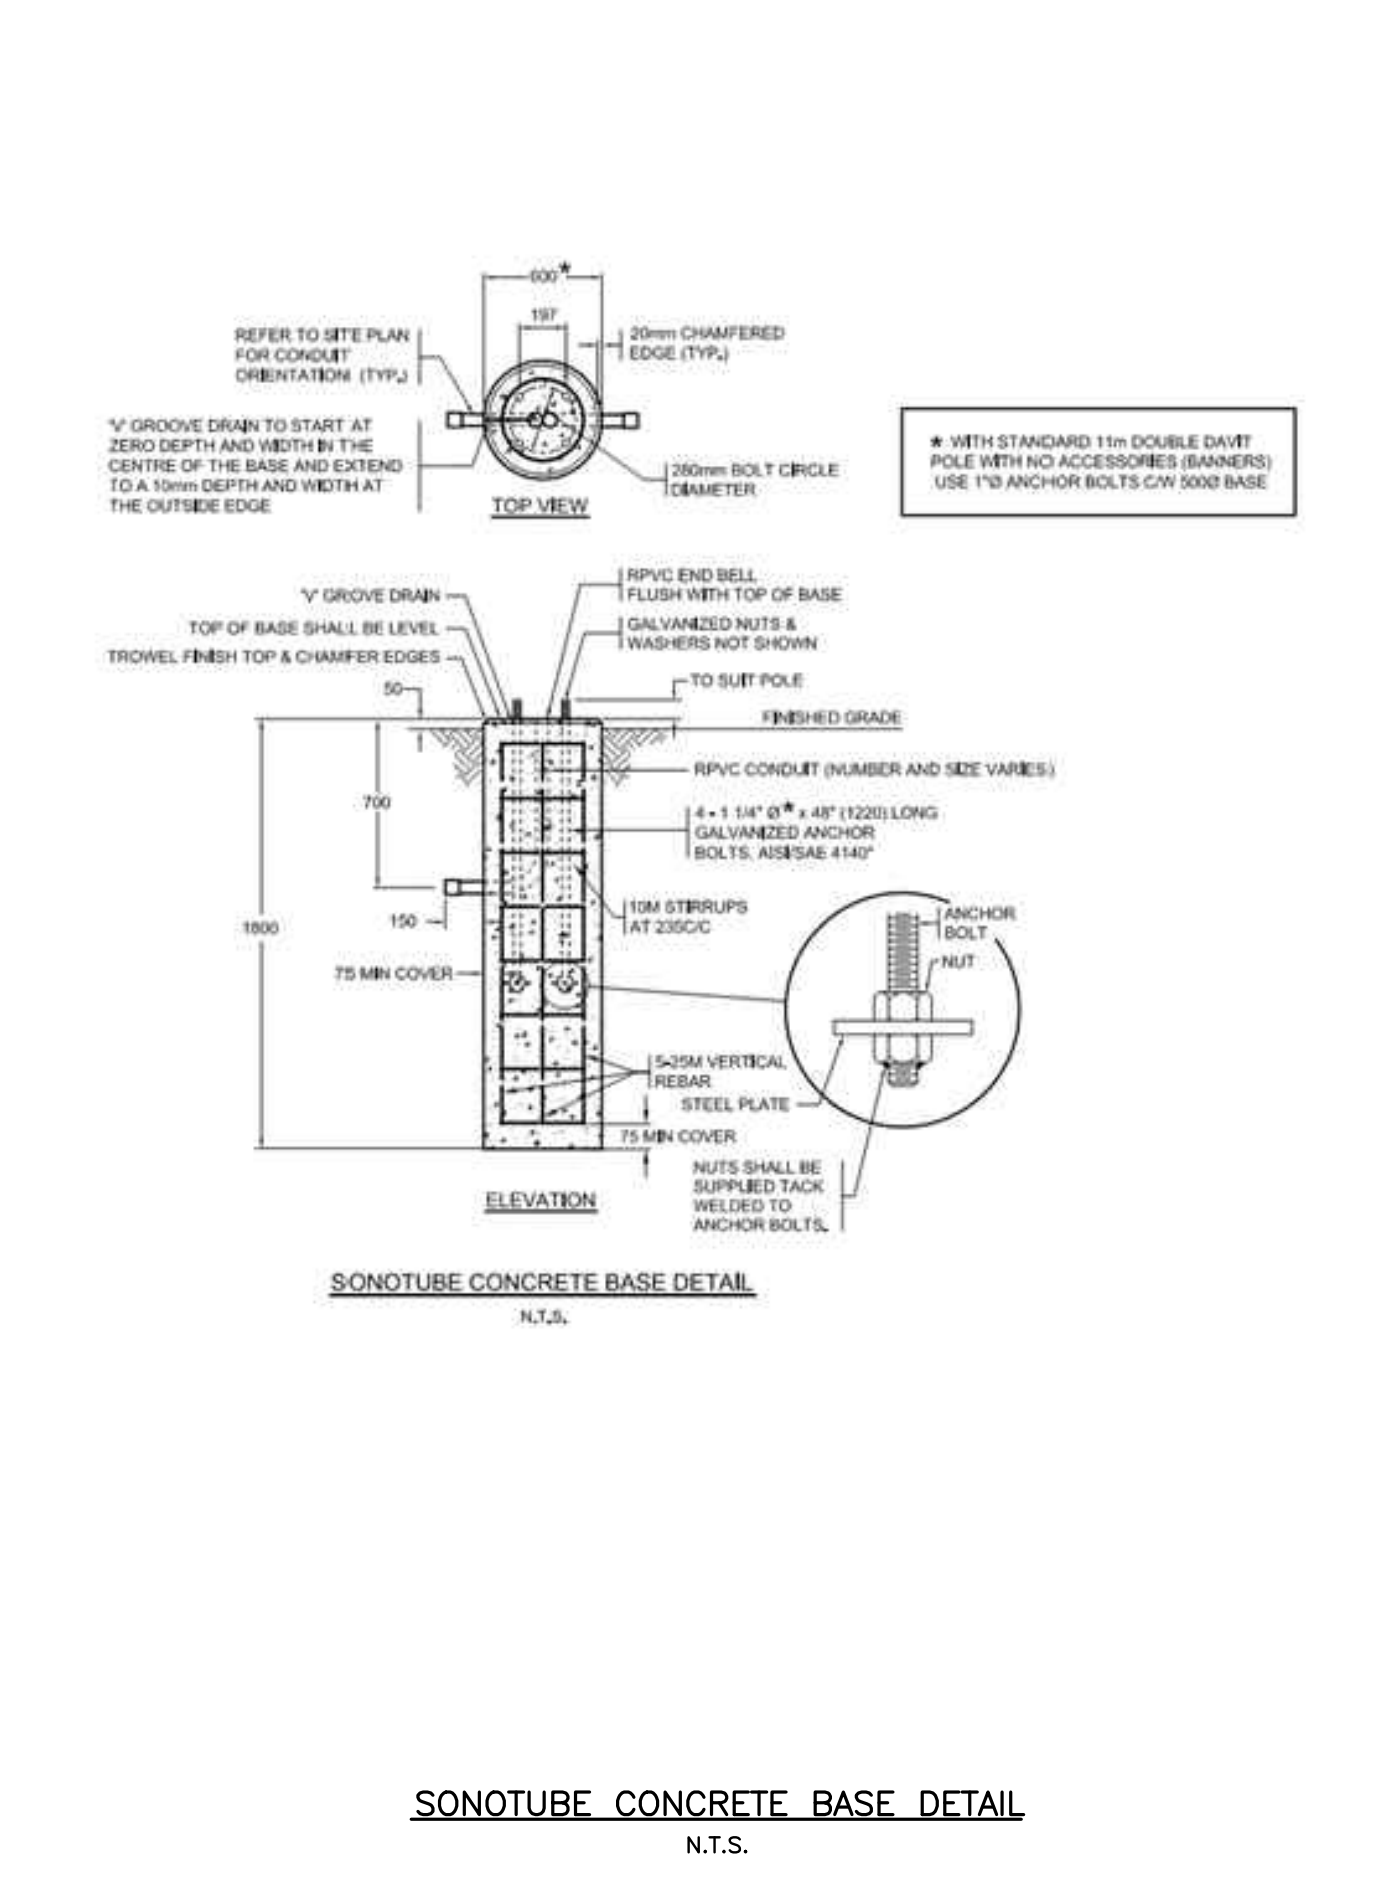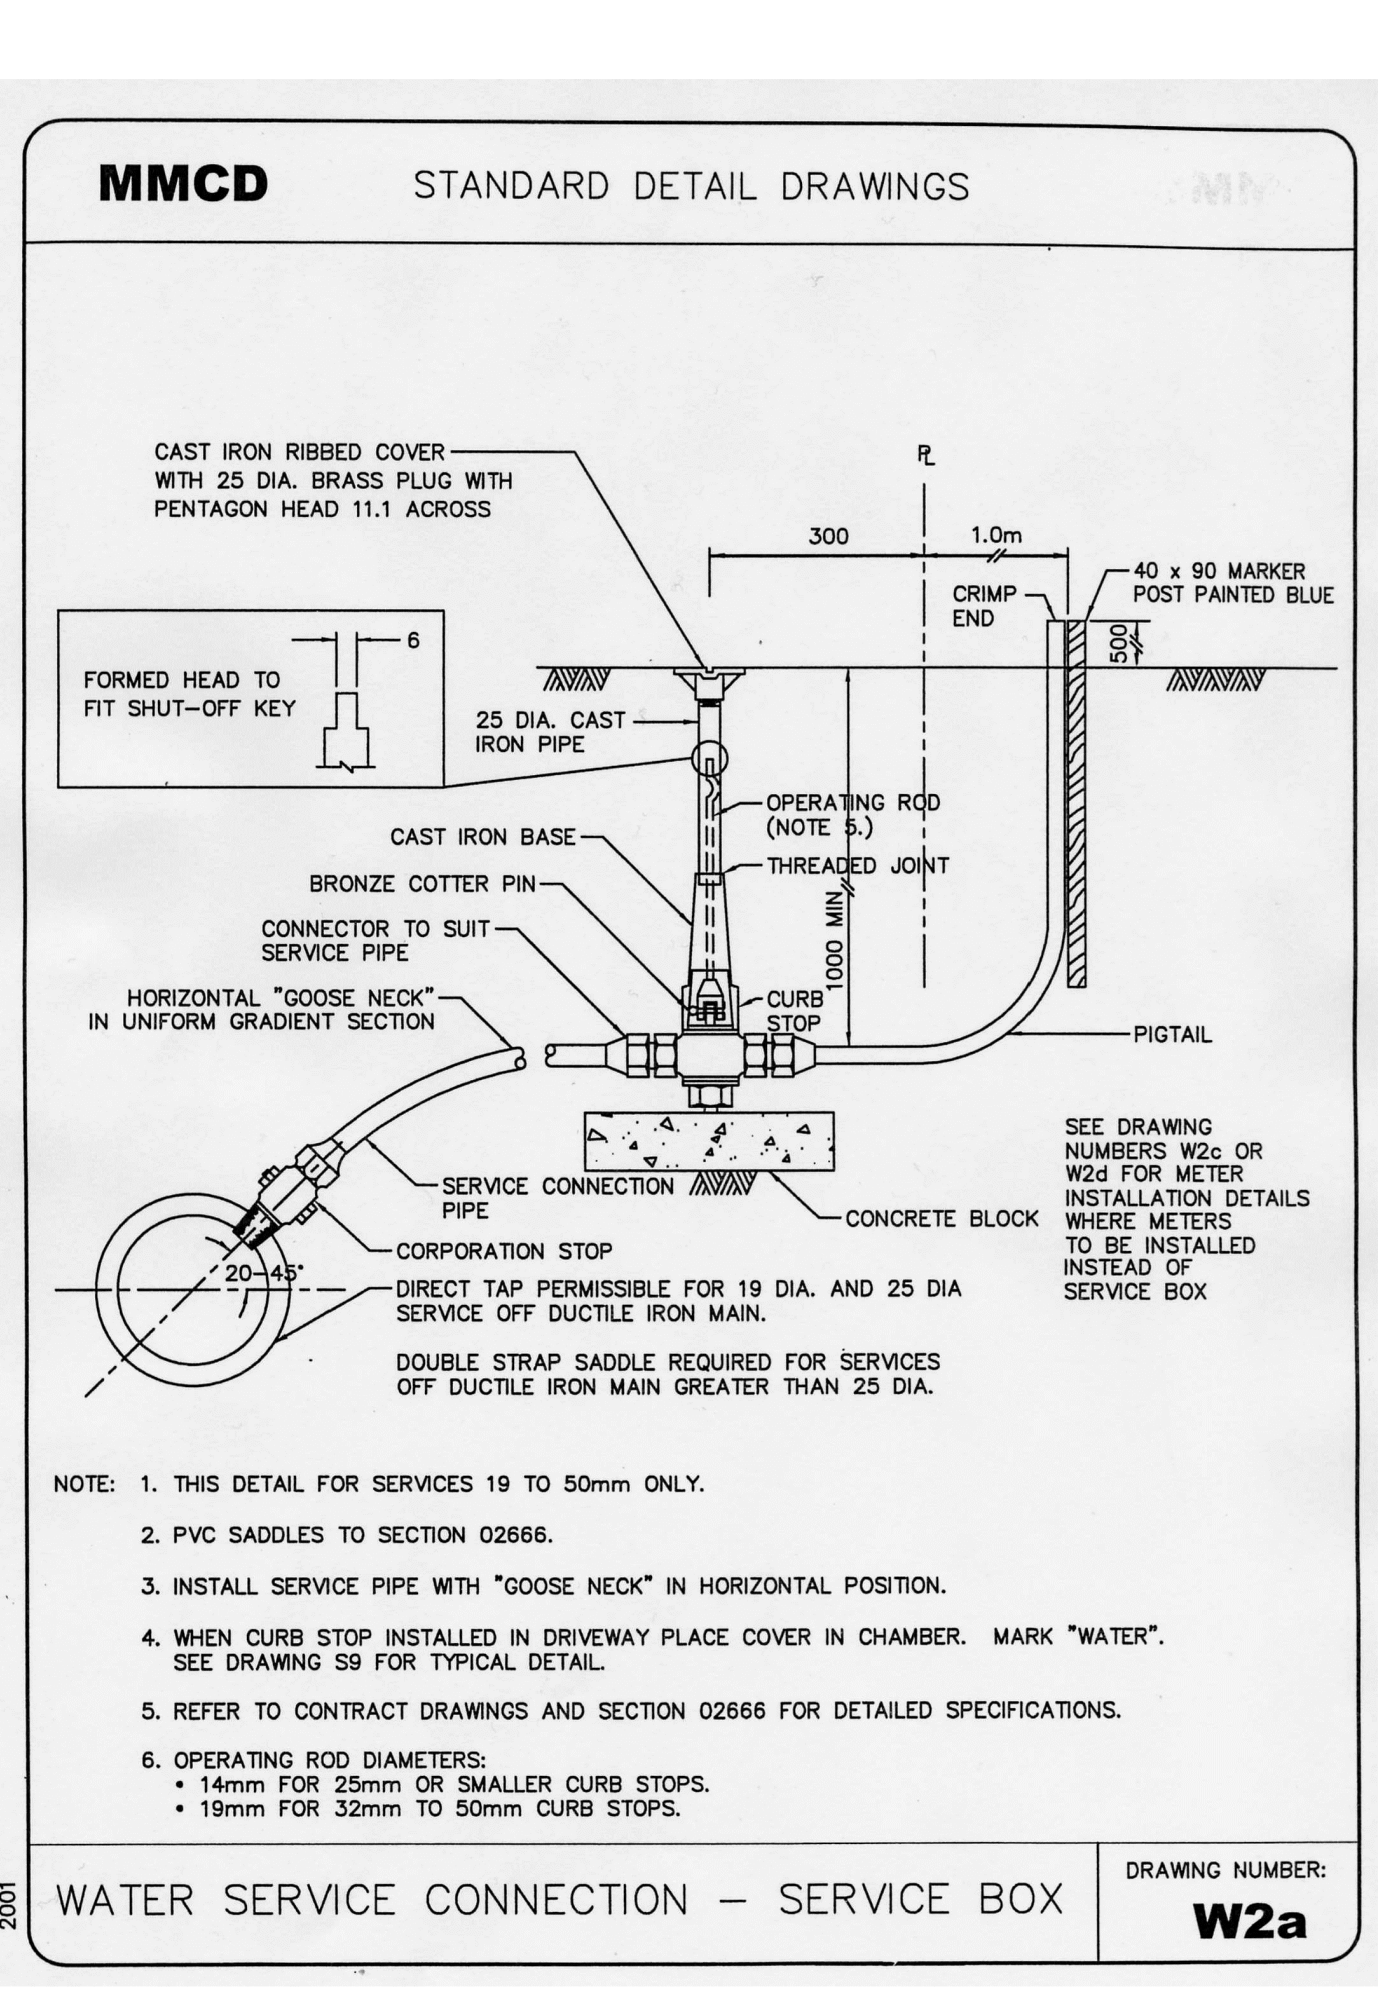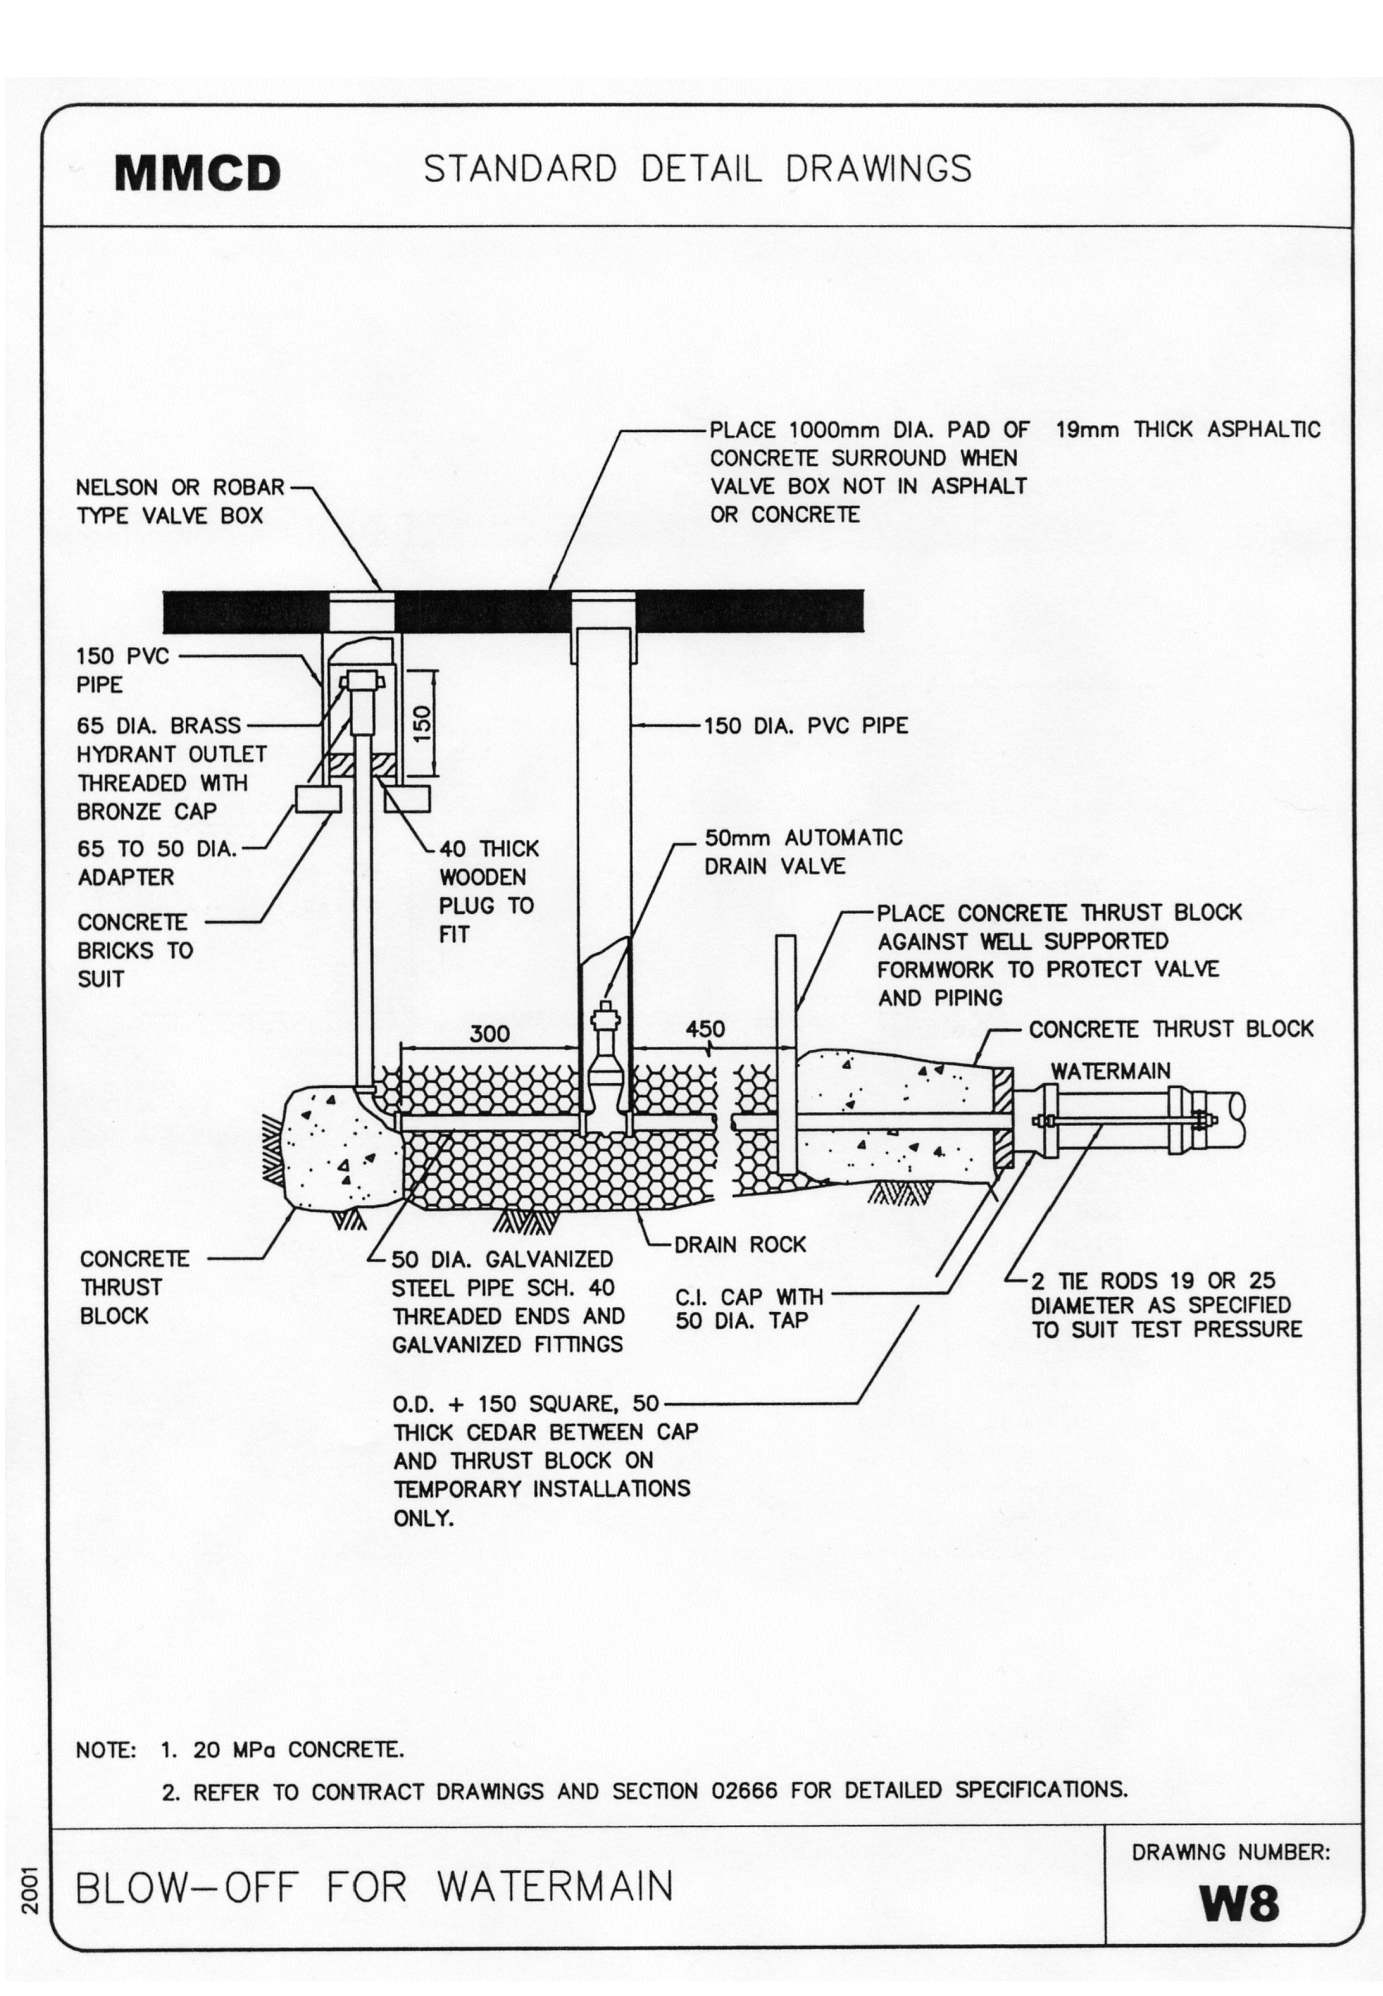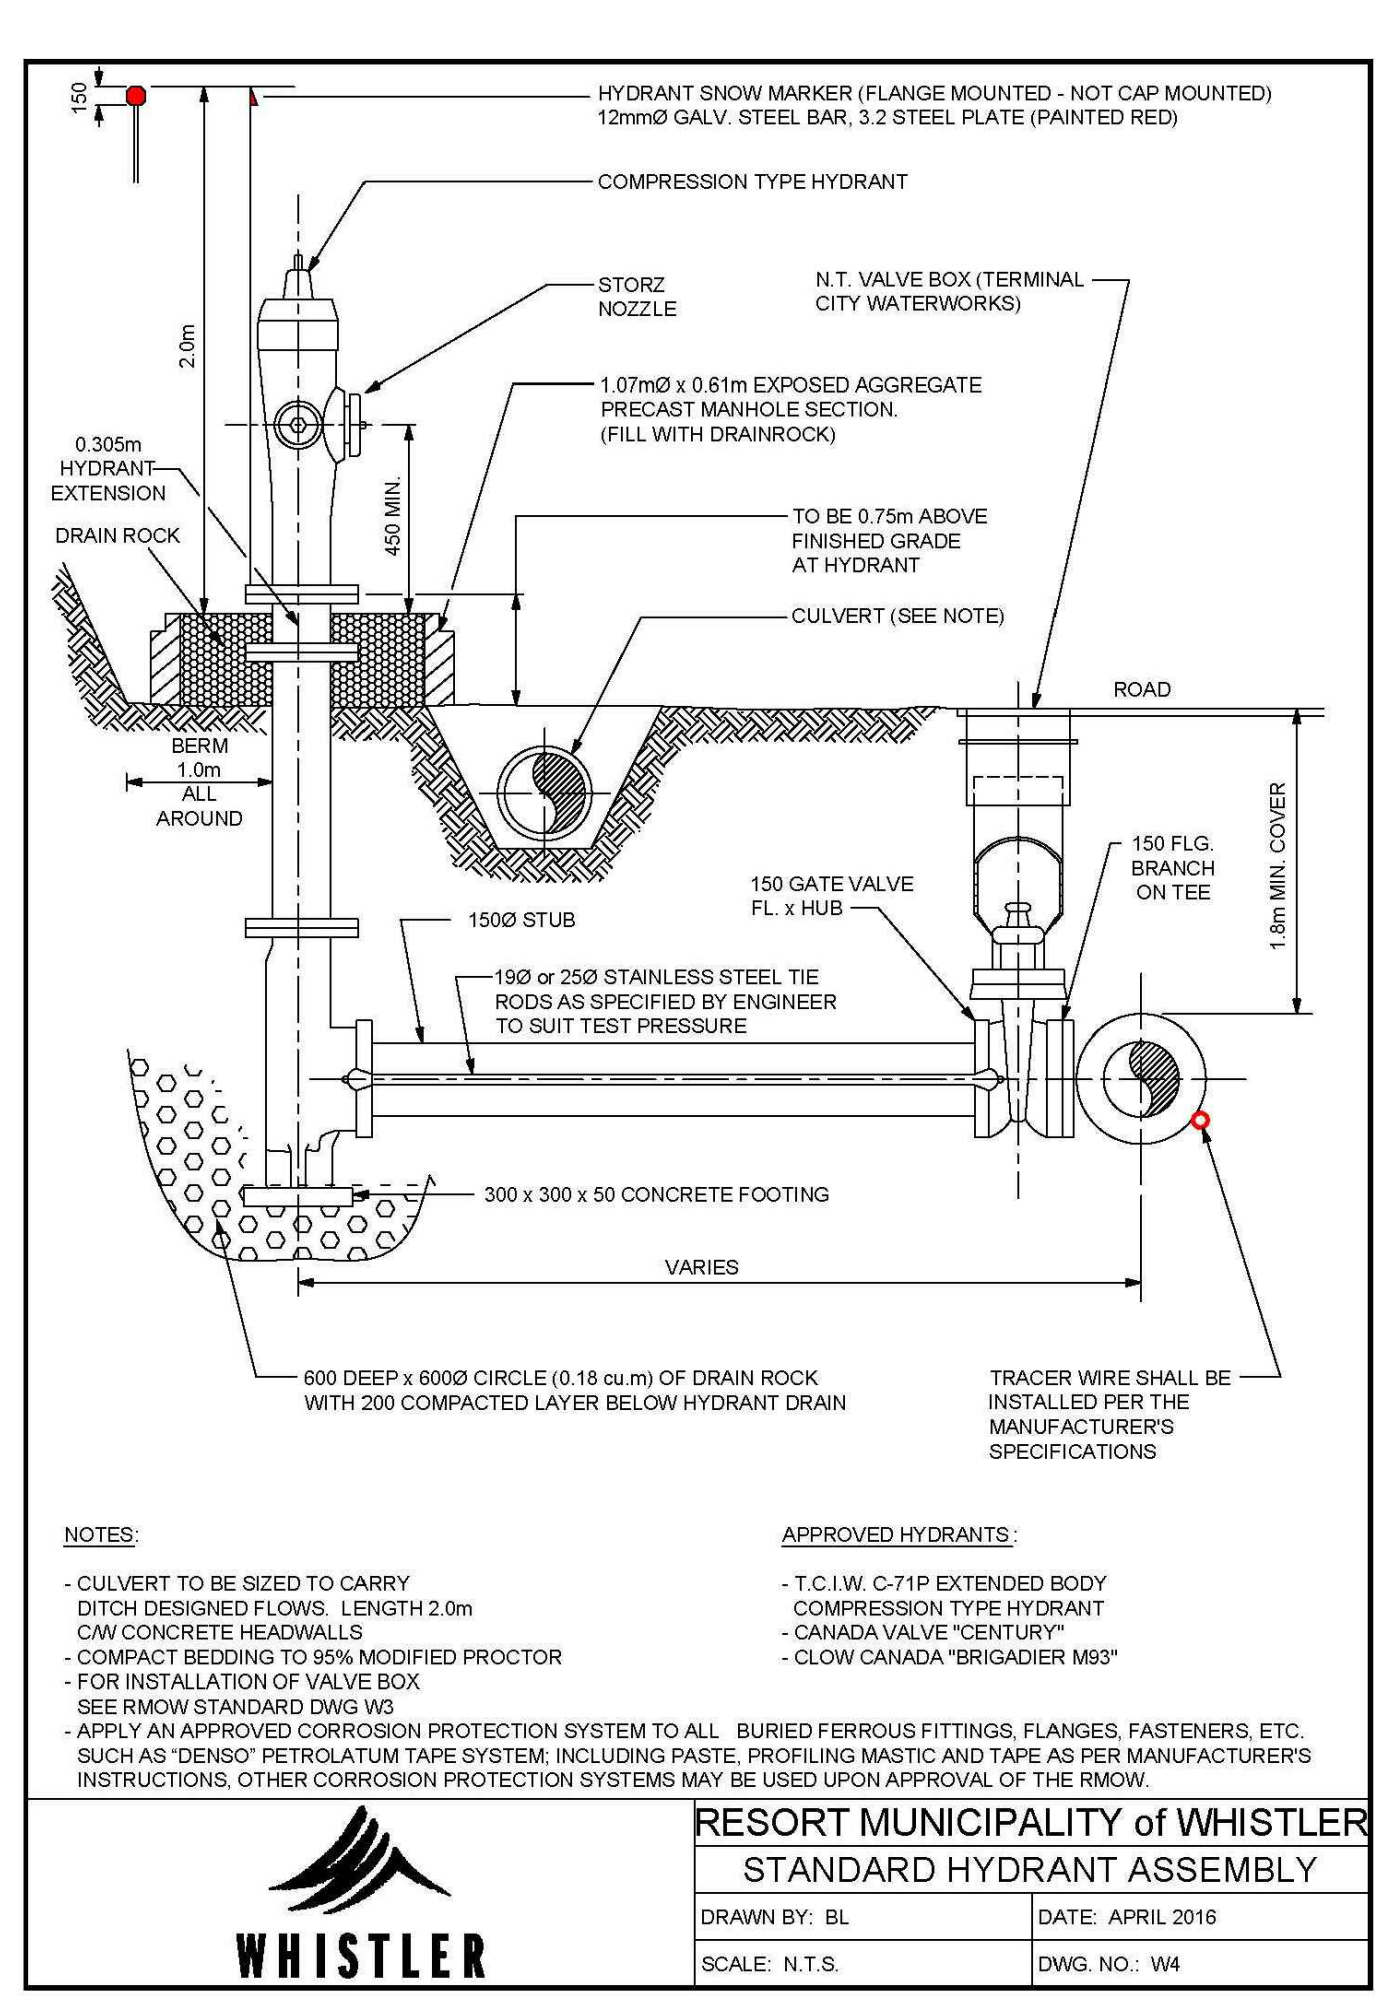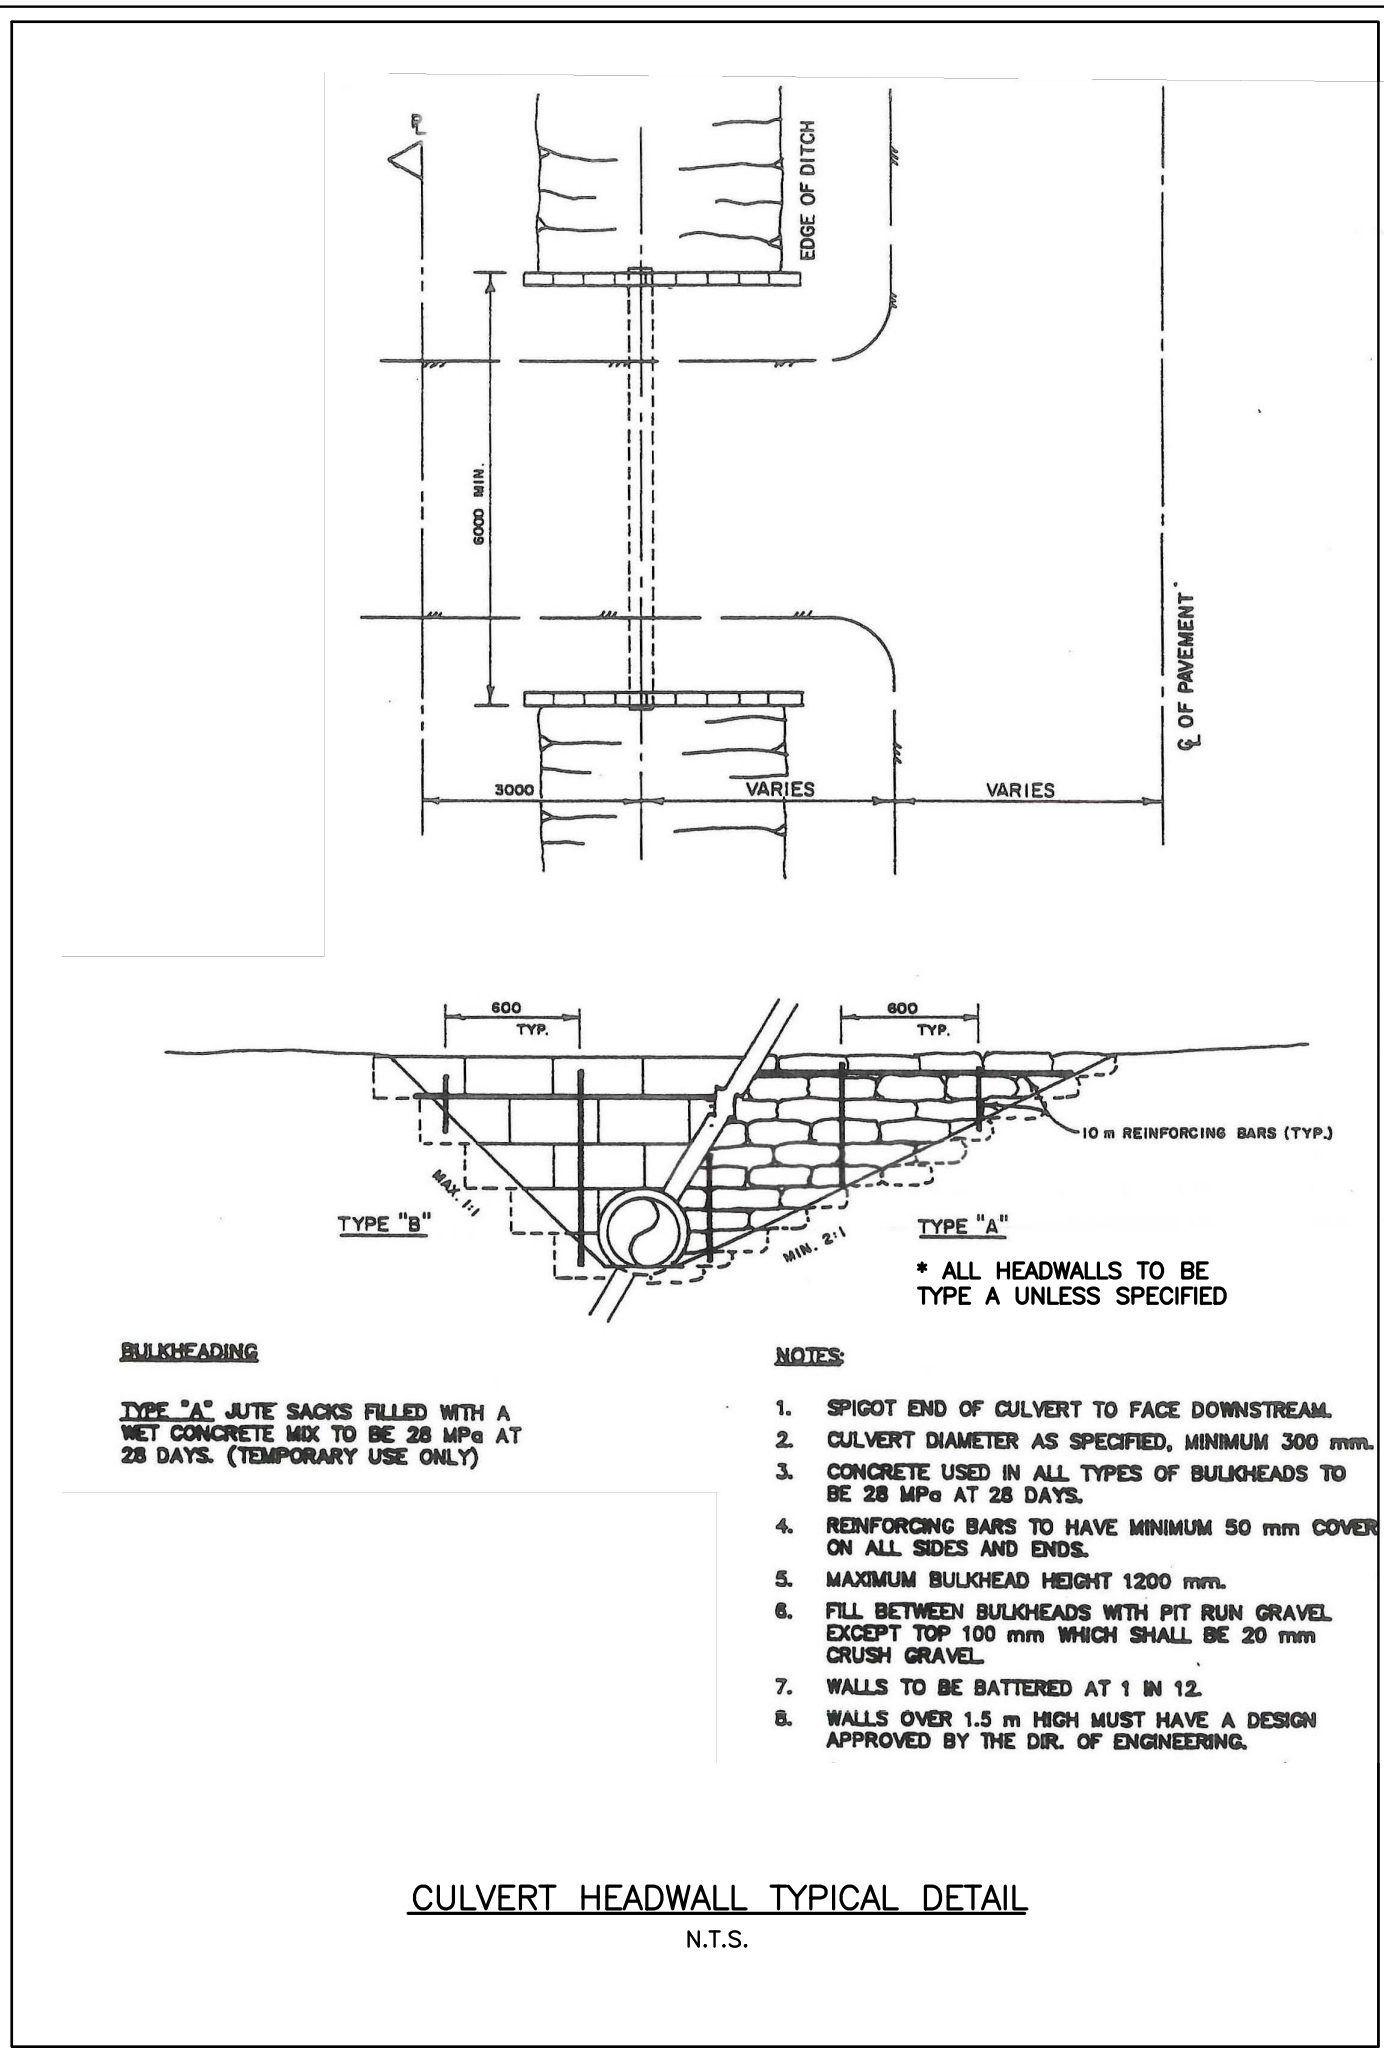

**CREUS Engineering**  
Civil Engineers & Project Managers  
SUITE 200-901 16TH ST WEST, NORTH VANCOUVER BC, V7P1R2  
PH: 604-987-0070 WEBSITE: www.creus.ca

**SITE MAP**

**DRAWING LEGEND**

LEGAL LINE	EXISTING	PROP.	TO BE REMOVED
EASMENT	---	---	---
WATERMAIN	---	---	---
SANITARY	---	---	---
STORM	---	---	---
HYDRO	---	---	---
TEL	---	---	---
STREETLIGHT	---	---	---
GAS	---	---	---

**FIRE HYDRANT**  
GATE VALVE  
AIR VALVE  
REDUCER  
INSPECTION CHAMBER  
CATCHBASIN (STDSI)  
CAP  
MANHOLE  
POWER POLE  
STREETLIGHT

approved

client

580049 BC LTD.

project

THE RIDGE AT PEMBERTON  
PHASE 1  
PEMBERTON, BC

title

DETAILS

no.	(y/m/d)	revision	ch/d
13	18-02-06	PROJECT RECORDS OFFSITE	KBH
12	18-02-06	PROJECT RECORDS ONSITE	KBH
11	17-10-17	PROJECT RECORDS OFFSITE	KBH
10	17-03-07	REISSUED FOR CONSTRUCTION OFFSITE	KBH
9	17-02-27	ISSUED FOR CONSTRUCTION ONSITE	KBH
8	17-01-18	REVISED FOR ADDENDA 1	KBH
7	16-11-09	REISSUED FOR CONSTRUCTION ONSITE	KBH
6	16-11-09	REISSUED FOR CONSTRUCTION OFFSITE	KBH

engineer of record: K.B.H. scales: hor: - vert: -  
designed by: N.G.B. file no.: 16159  
drawn by: M.S.T. drawing no.:  
date: 2016-05-13 DET-6

CREUS Engineering  
Civil Engineers & Project Managers  
SUITE 200-901 16TH ST WEST, NORTH VANCOUVER BC, V7P1R2  
PH: 604-987-0070 WEBSITE: www.creus.ca

drawn by: DW.C  
scale: N.T.S.  
drawing #: C001





copyright reserved. THIS DRAWING AND DESIGN ARE, AND AT ALL TIMES REMAIN THE EXCLUSIVE PROPERTY OF CREUS ENGINEERING LTD. AND CANNOT BE USED, REPRODUCED OR DISTRIBUTED WITHOUT WRITTEN CONSENT.  
©2016 CREUS ENGINEERING LTD.

current rev. #: 13



\* CN SURFACE CROSSING TO BE COMPLETED

Civil Engineers & Project Managers  
SUITE 200-901 16TH ST WEST, NORTH VANCOUVER BC, V7P1R2  
PH: 604-987-0070 WEBSITE: www.creus.ca

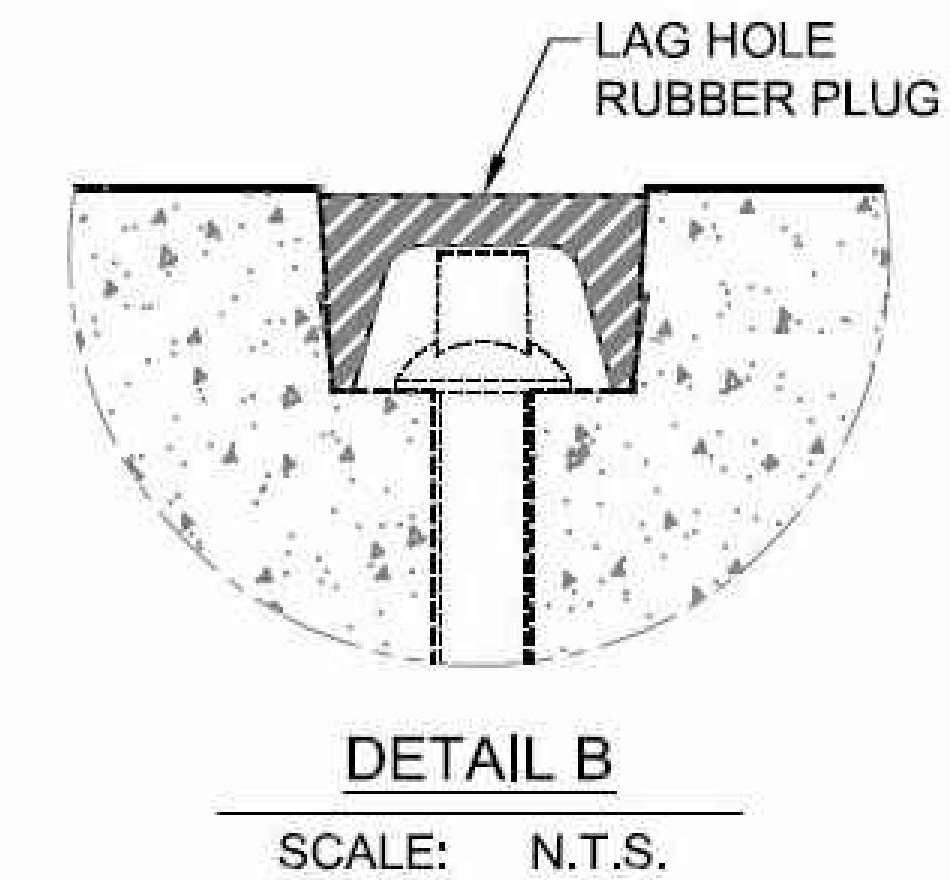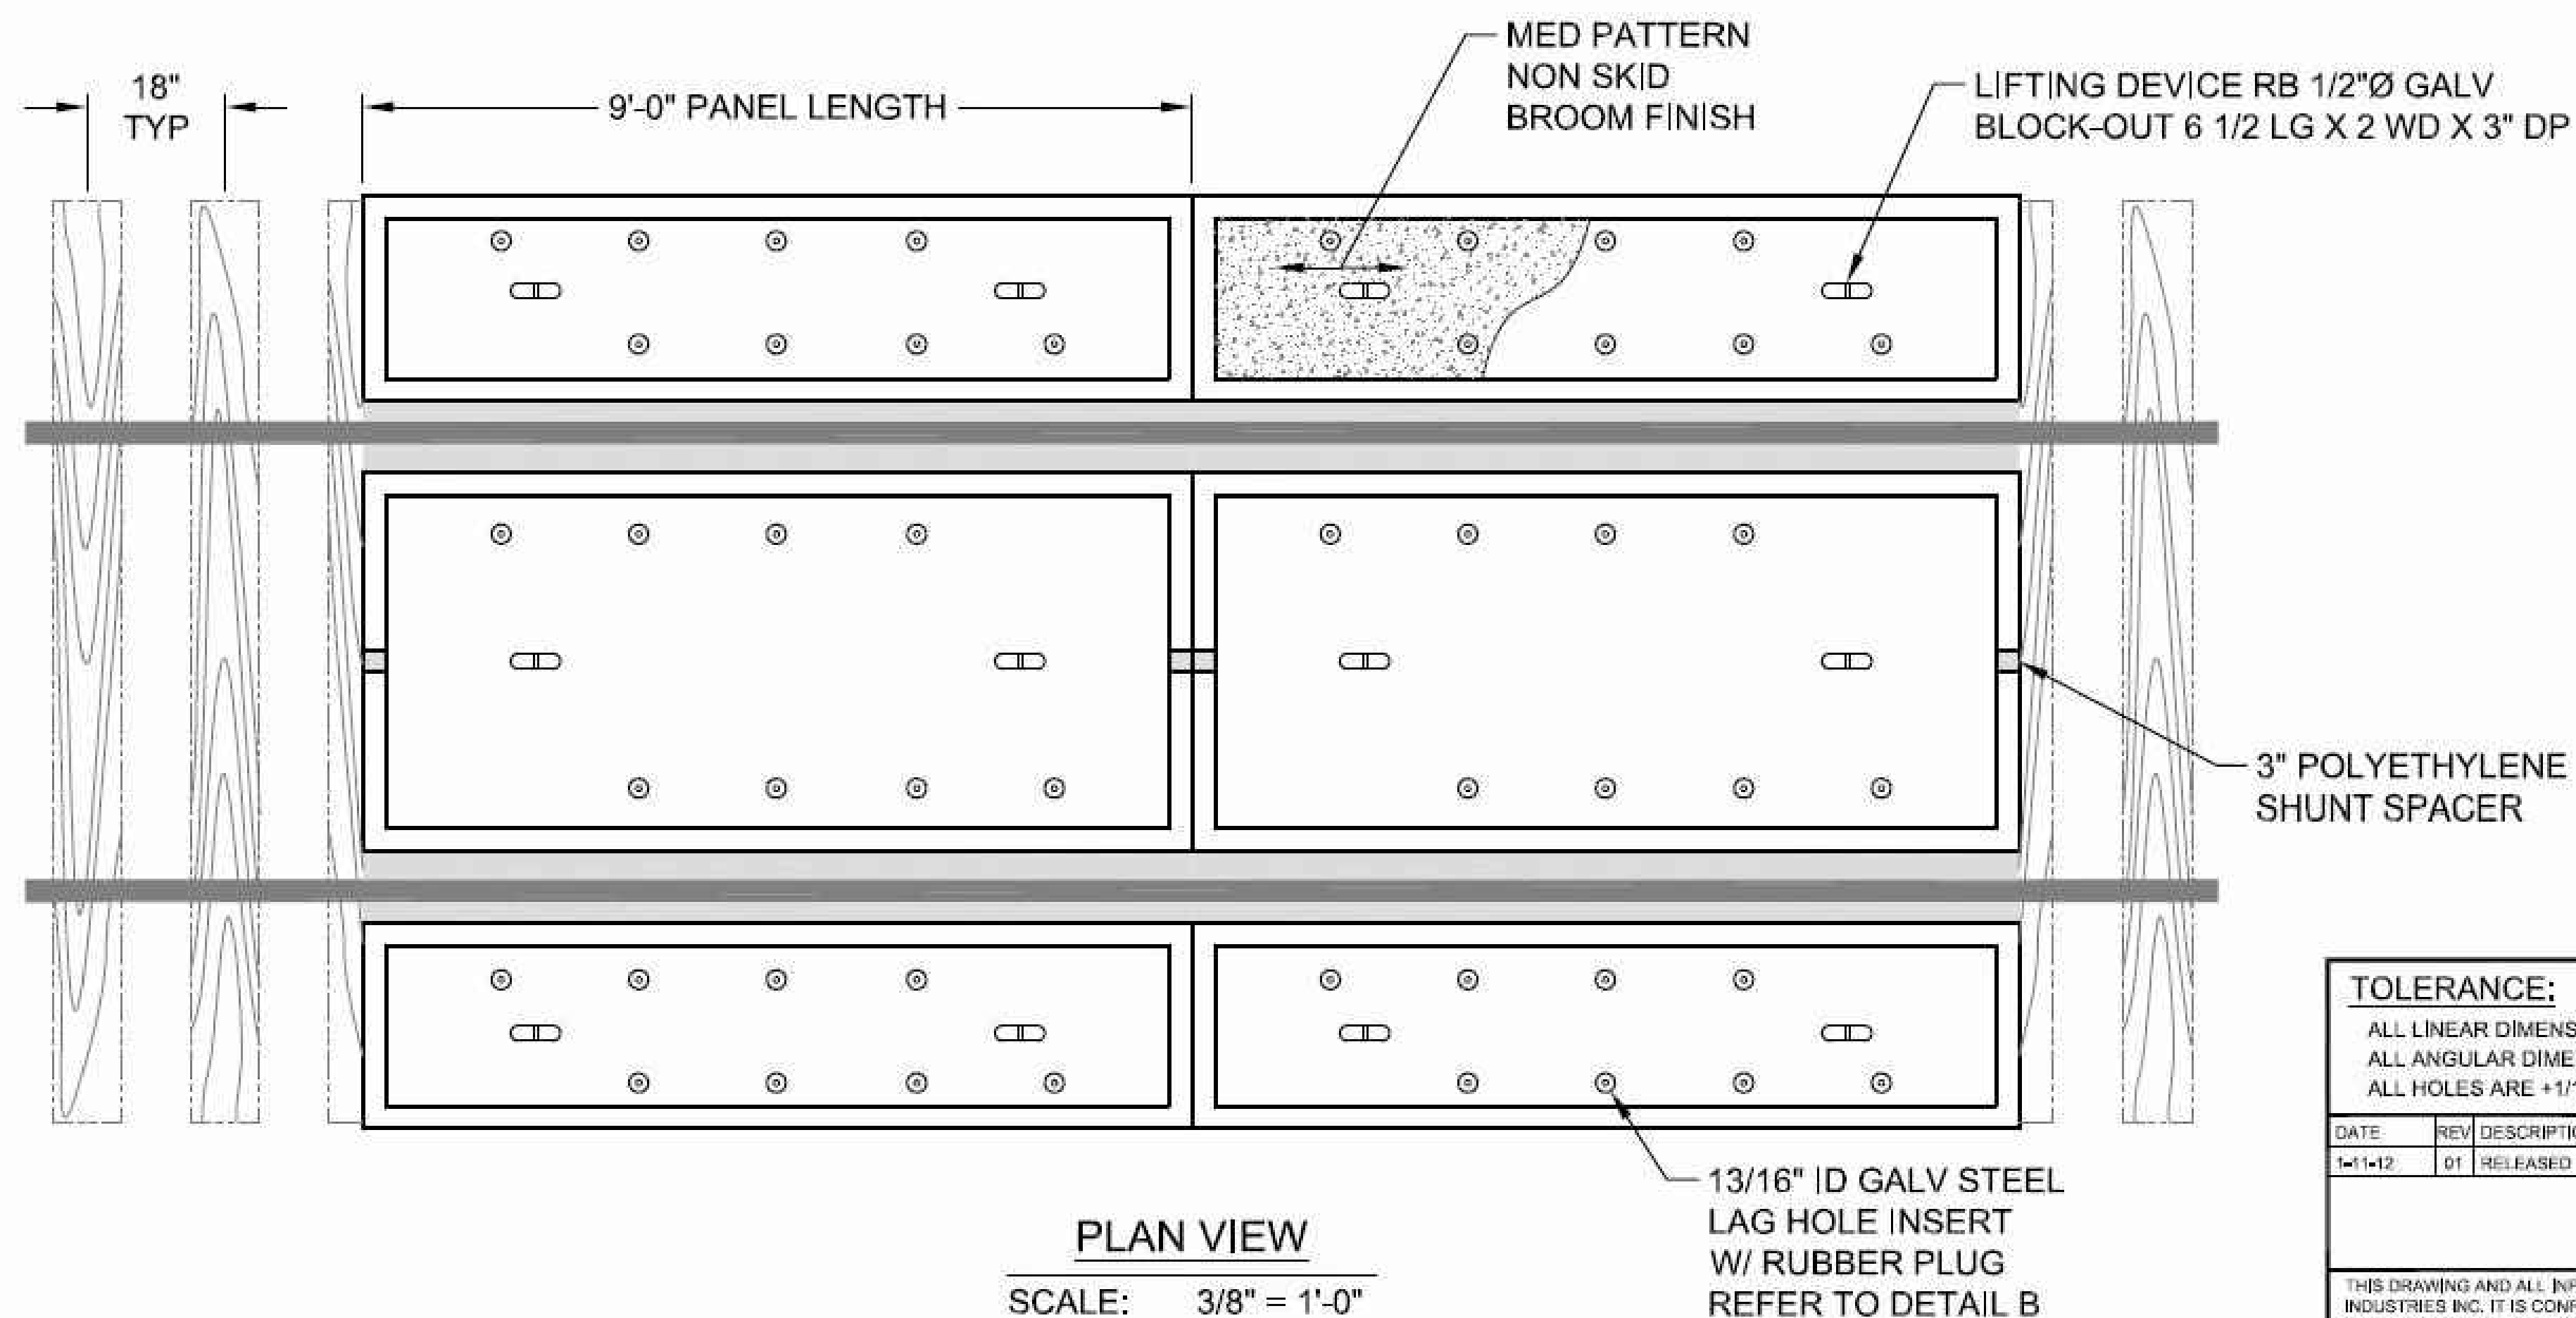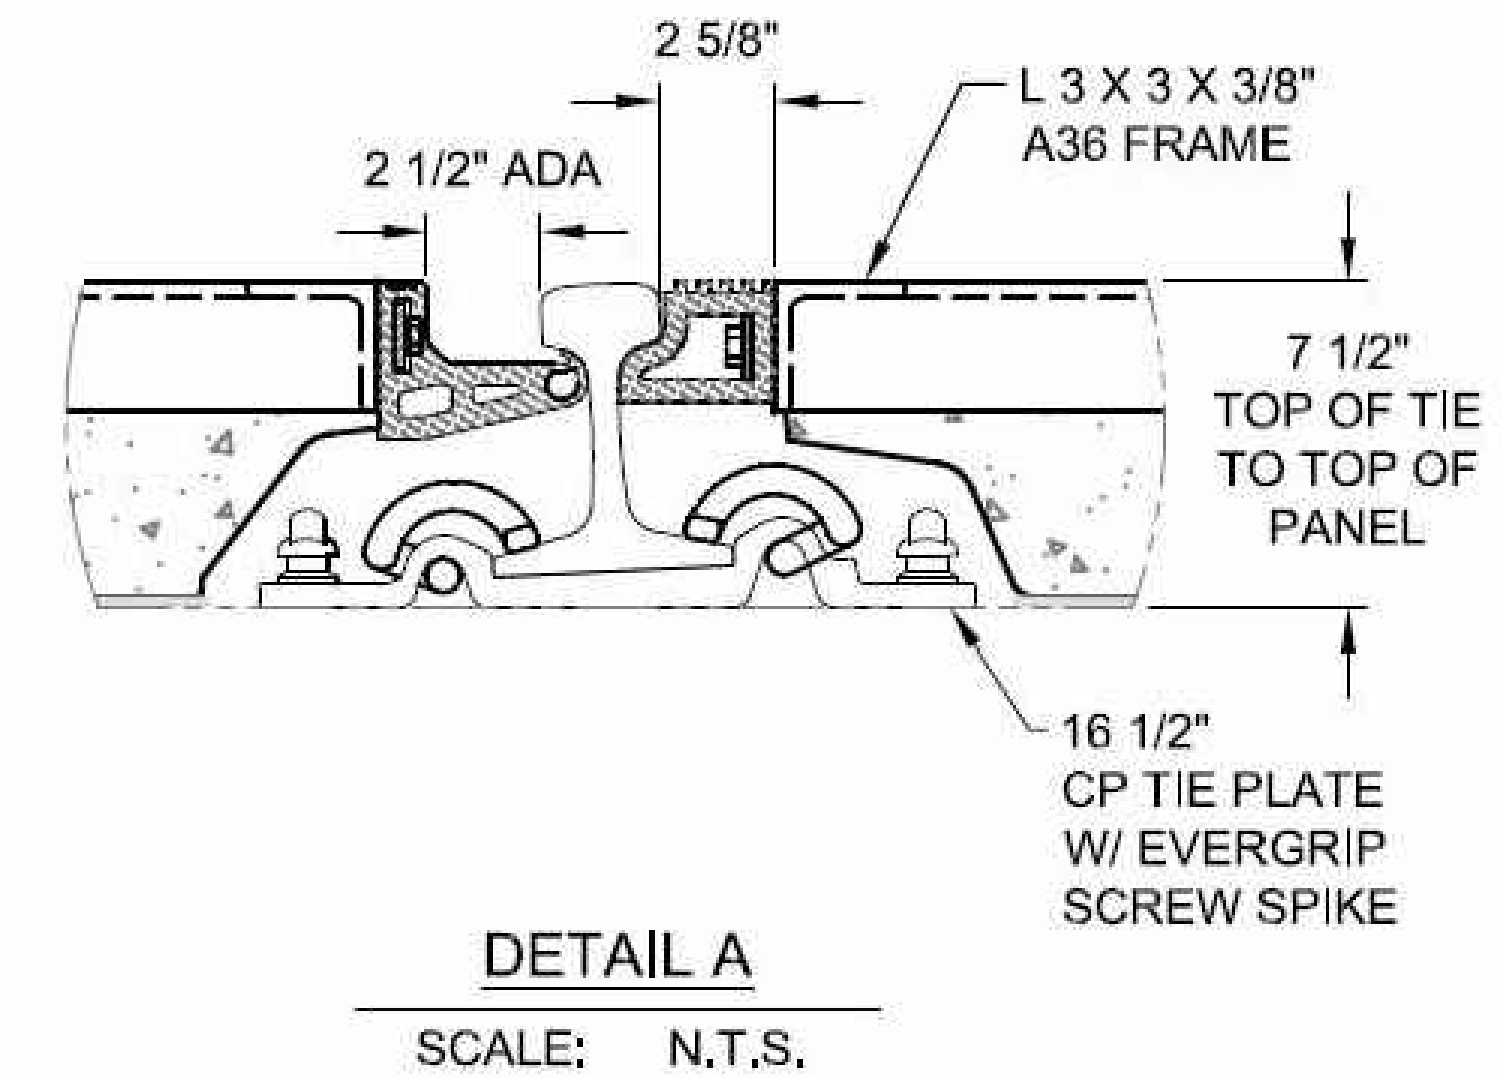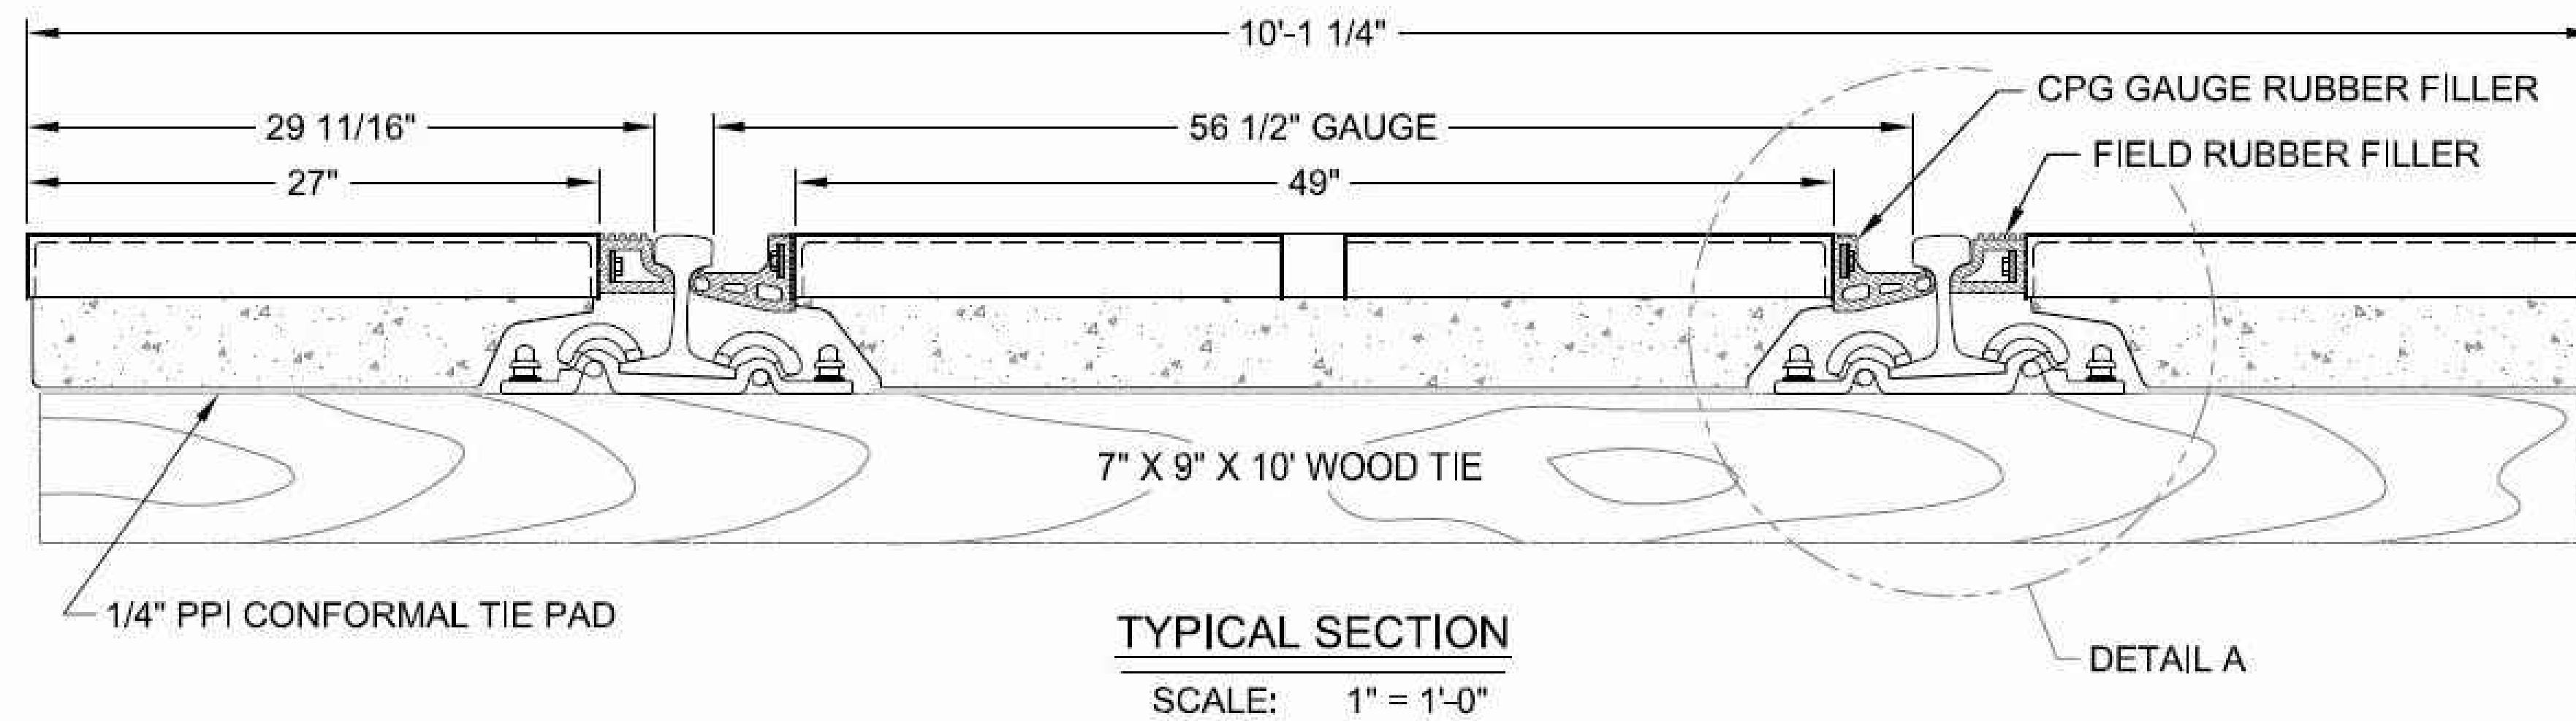

- NOTES:**
1. CONCRETE STRENGTH 6000 psi MINIMUM AT 28 DAYS.
  2. POLY FIBER REINFORCEMENT @ 2 LB. PER CU YD.
  3. SEE OMEGA'S MANUAL FOR INSTALLATION INSTRUCTIONS
  4. WEIGHTS: GAGE PANEL 3480 LBS, FIELD PANEL 1880 LBS

<b>TOLERANCE:</b> (UNLESS OTHERWISE SPECIFIED) ALL LINEAR DIMENSIONS ARE ±1/8" ALL ANGULAR DIMENSIONS ARE ±1 DEG ALL HOLES ARE +1/16, -0"		<b>OMEGA INDUSTRIES, INC.</b> 7304 N.E. ST. JOHNS RD VANCOUVER, WA 98665 <b>CANADIAN RAIL STANDARD</b> <b>9'-0" PRECAST CONCRETE PANELS ON 10' TIES</b> <b>115# RAIL, GENERAL ARRANGEMENT</b>	
DATE	REV DESCRIPTION		
1-1-12	01 RELEASED	VVK	
ENGINEER		DATE	SCALE
VK		1-11-12	NOTED
DRAWING #		DRAWN BY:	REVISION
1004156		VVK	01

SITE MAP  
DRAWING LEGEND

approved

client  
580049 BC LTD.



project  
THE RIDGE AT PEMBERTON  
PHASE 1  
PEMBERTON, BC

title  
DETAILS

no.	(y/m/d)	revision	chk'd
2	18-02-06	PROJECT RECORDS OFFSITE	KBH
1	17-10-17	PROJECT RECORDS OFFSITE	KBH

<small>COPYRIGHT RESERVED. THIS DRAWING AND DESIGN ARE, AND AT ALL TIMES REMAIN THE EXCLUSIVE PROPERTY OF CREUS ENGINEERING LTD. AND CANNOT BE USED, REPRODUCED OR DISTRIBUTED WITHOUT WRITTEN CONSENT. ©2016 CREUS ENGINEERING LTD.</small>			
engineer of record	K.B.H.	scales	hor: - vert: -
designed by	K.B.H.	file no.	16159
drawn by	Z.M.	drawing no.	DET-10
date	2016-05-13		



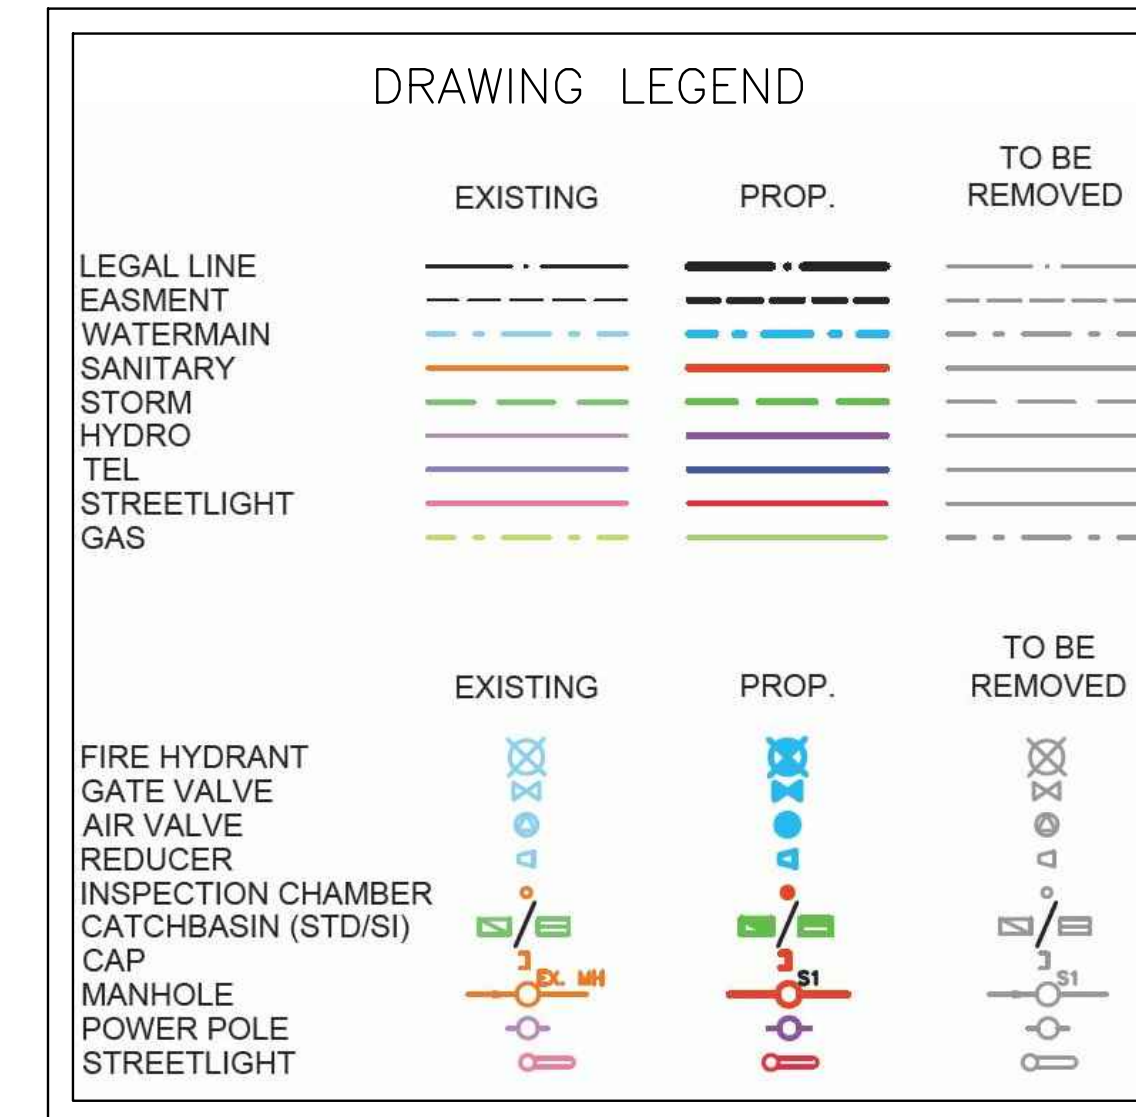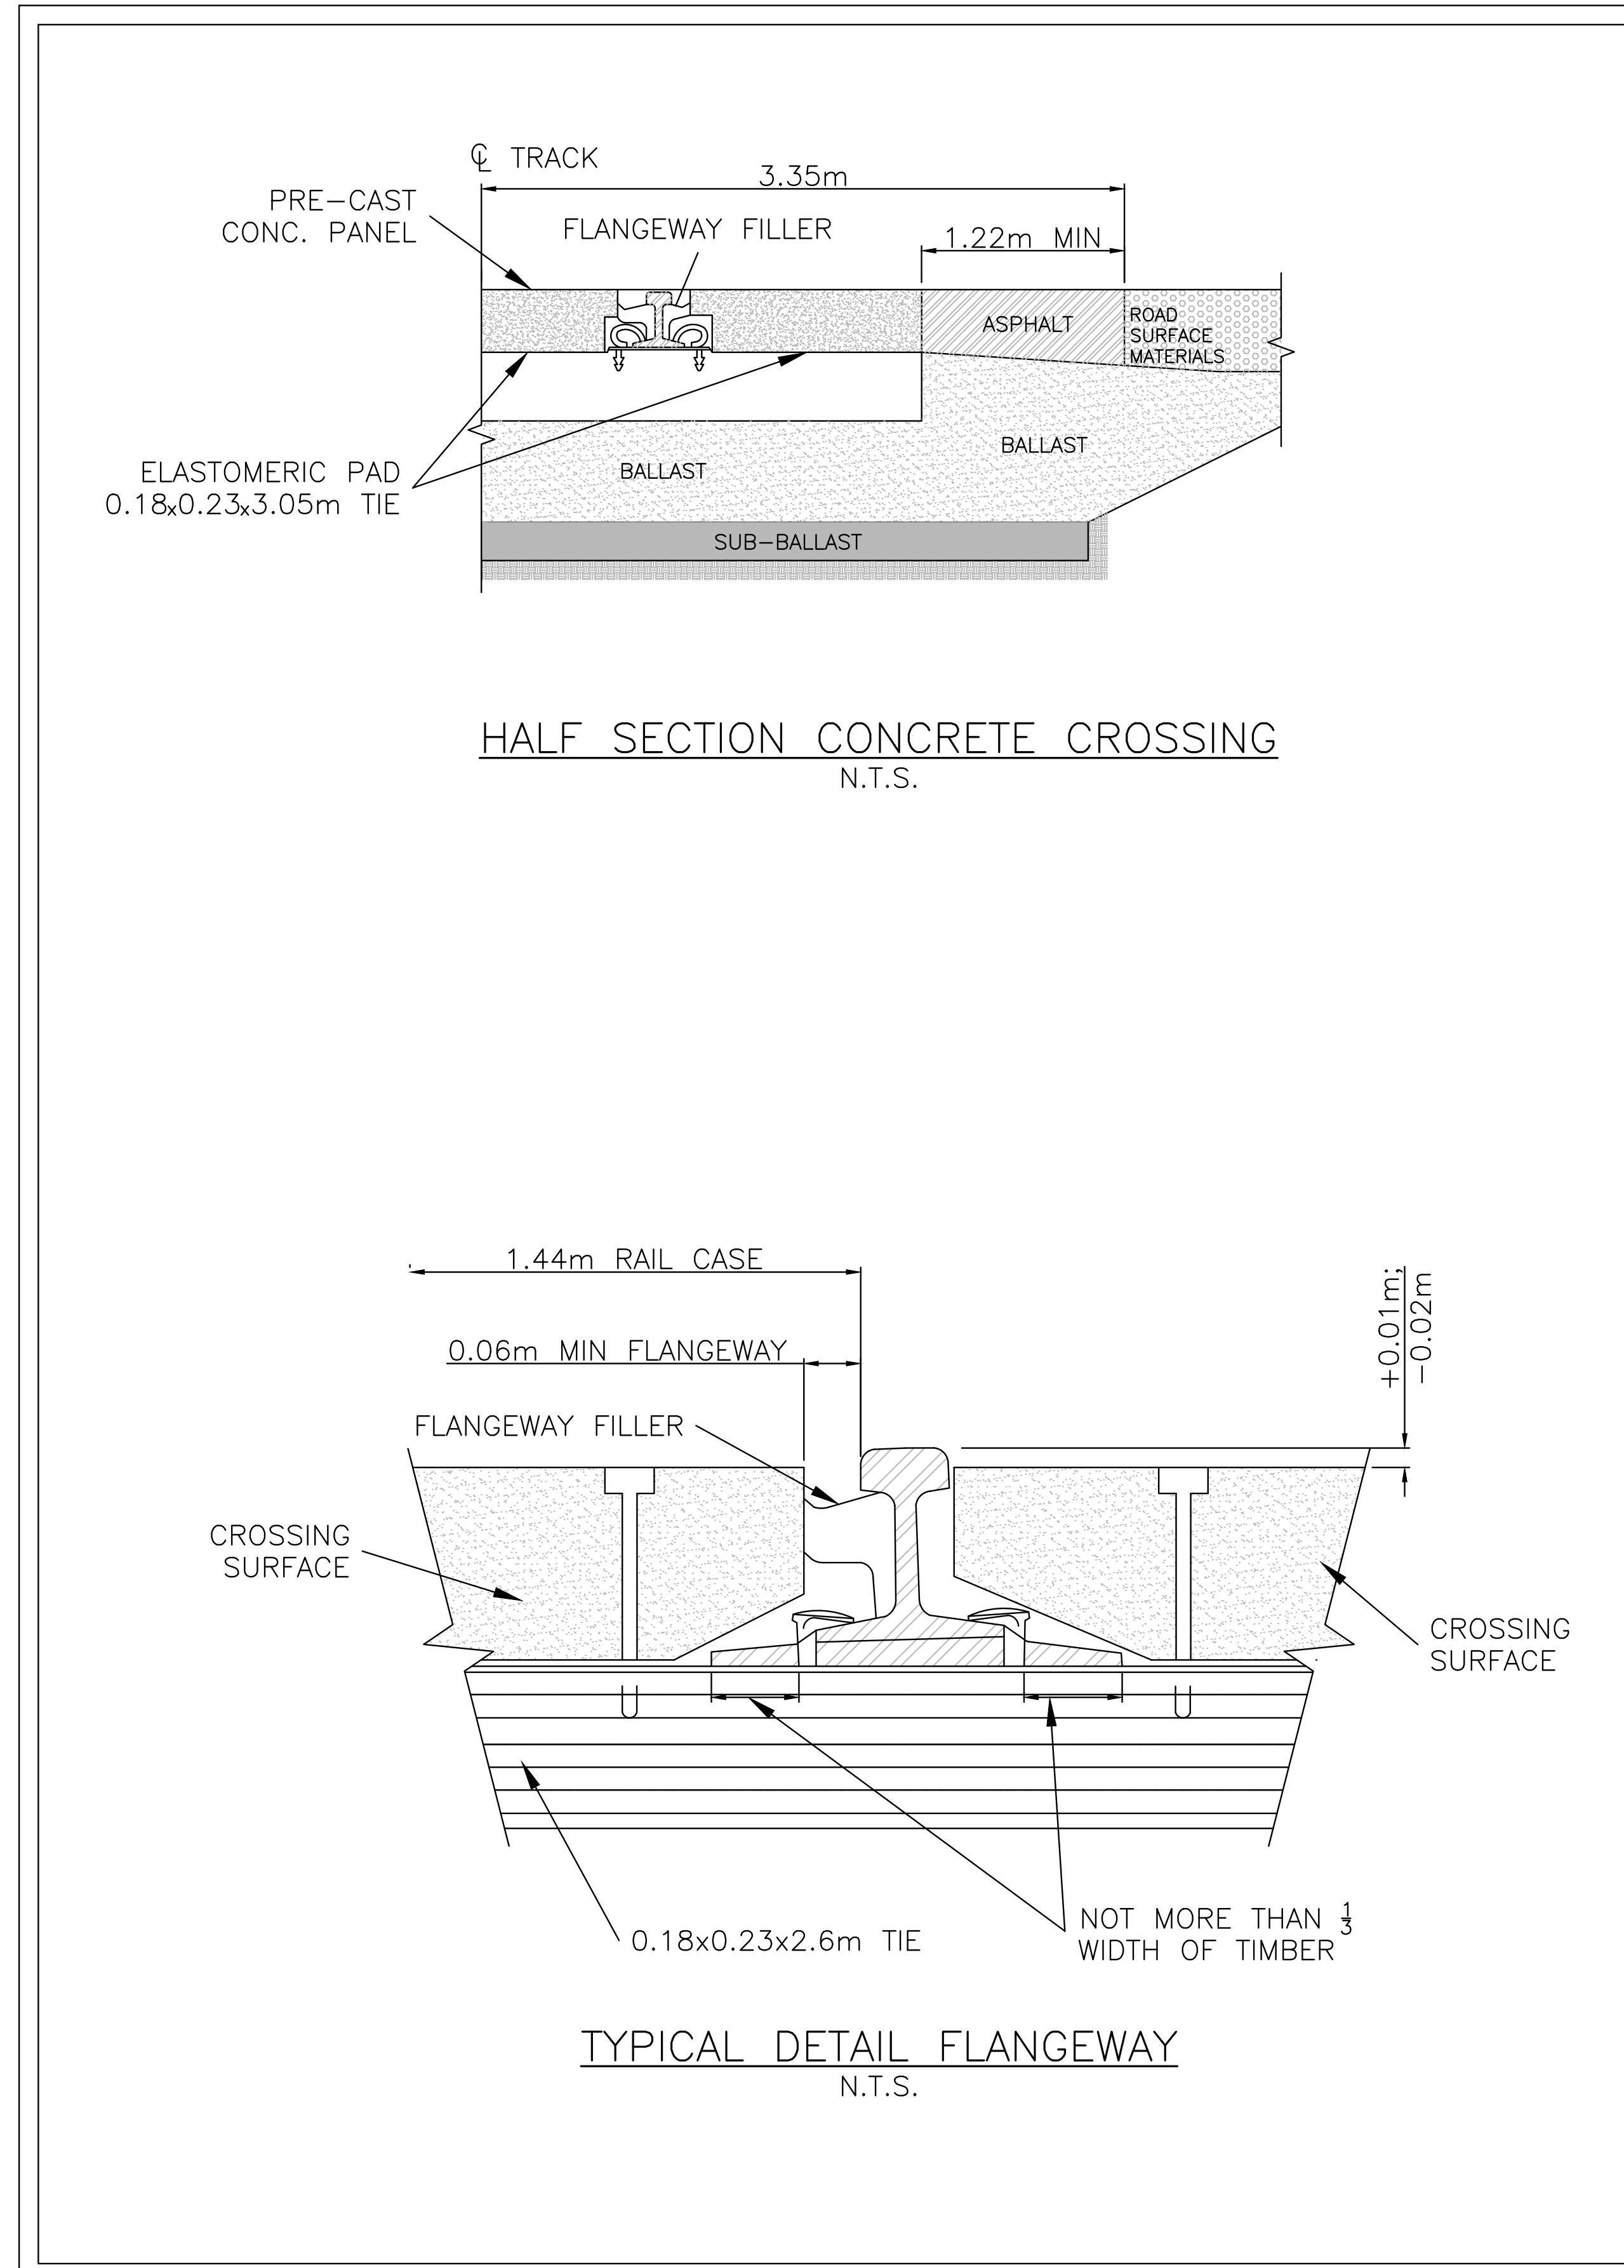

SITE MAP

DRAWING LEGEND

approved

client

580049 BC LTD.

project

THE RIDGE AT PEMBERTON  
PHASE 1  
PEMBERTON, BC

title

DETAILS

2	18-02-06	PROJECT RECORDS OFFSITE	KBH
1	17-10-17	PROJECT RECORDS OFFSITE	KBH

no.	(y/m/d)	revision	chk'd

COPYRIGHT RESERVED. THIS DRAWING AND DESIGN ARE, AND AT ALL TIMES REMAIN THE EXCLUSIVE PROPERTY OF CREUS ENGINEERING LTD. AND CANNOT BE USED, REPRODUCED OR DISTRIBUTED WITHOUT WRITTEN CONSENT.  
 © 2016 CREUS ENGINEERING LTD.

engineer of record	K.B.H.	scales	hor: -	vert: -
--------------------	--------	--------	--------	---------

designed by	K.B.H.	file no.	16159
-------------	--------	----------	-------

drawn by	Z.M.	drawing no.	DET-11
----------	------	-------------	--------

date	2016-05-13
------	------------